

O.D.O.T. DISTRICT 2 SURVEY OFFICE (USE ONLY)

PERSONNEL _____

REFERENCE NO. 35 A

SHEET 3 OF 17

NOTES N/A

DATE 6/12/74

ROUTE SR 163

H.C. _____

WEATHER FAIR

COUNTY OTTAWA

R.C. _____

TEMP. 65°

TOWNSHIP HARRIS

SECTION 1

DWG BY NIESE

PID _____

T 6 N R 14 E

TYPE MONUMENT R.R. SPIKE W/ PUNCH HOLE

ON SURFACE - ~~BELOW~~ ON

OFFSET \odot PAVEMENT _____ LT : RT

_____ TO _____ EDGE PAVEMENT


STATION: 592+96.93

HORZ. DATUM: _____


GEOID: _____

GRID: NORTHING: _____

EASTING: _____

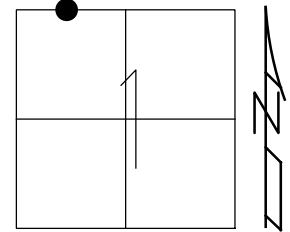

RECORD:
 STA 592+96.93
 FD R.R. SPIKE
 W/ PUNCH HOLE
 6/12/74

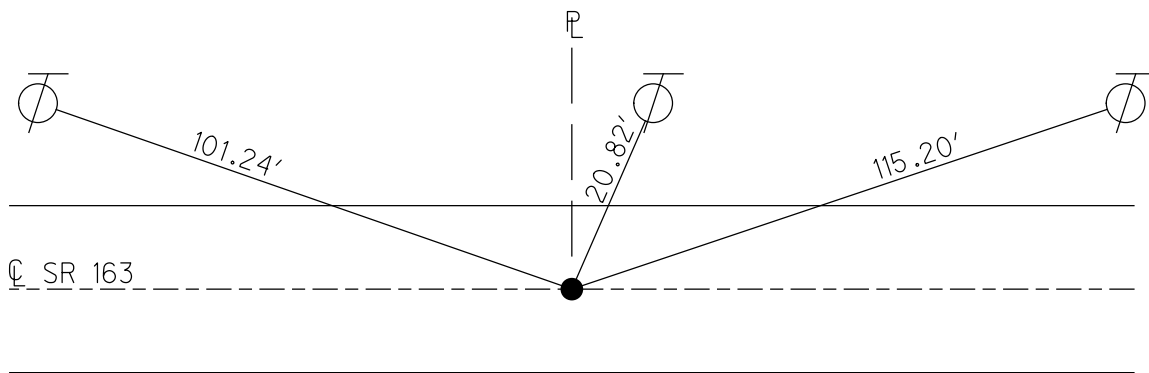

PERSONNEL	TITLE	PERSONNEL	TITLE	COUNTY	DATE
				<u>Ottawa</u>	<u>6-12-74</u>
				S. R. <u>163</u>	WEATHER <u>Fair</u>
				SEC. <u>8.22</u>	TEMP. <u>65</u>
DESCRIPTION <u>Salina Twp. sec 5</u>				JOB NO. _____	

