

O.D.O.T. DISTRICT 2 SURVEY OFFICE (USE ONLY)

PERSONNEL

REFERENCE NO. 36

SHEET 5 OF 17

NOTES CHENEY

DATE 6/17/73

ROUTE SR 163

H.C. RIPPLE

WEATHER FAIR

COUNTY OTTAWA

R.C. BARBOUR

TEMP. 80°

TOWNSHIP HARRIS

SECTION 1

DWG BY NIESE PID _____

T 6 N R 14 E

TYPE MONUMENT R.R. SPIKE

~~ON SURFACE~~ - BELOW 4.5"

OFFSET \odot PAVEMENT ON LT : RT

11.5' TO LT EDGE PAVEMENT


STATION: 601+70

HORZ.DATUM: _____


GEOID: _____

GRID: NORTHING: _____

EASTING: _____

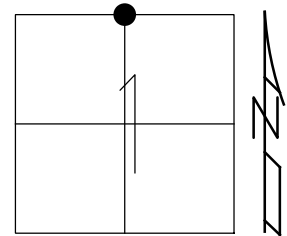

RECORD: P.I.
 STA. 600+23
 FD R.R. SPIKE
 4.5" DOWN
 6/17/73, CHENEY
 FD IPIN
 NE OF STONE
 2.0' RT OF \odot
 1.35' DOWN
 SET P.K. NAIL
 11/13/76
 SET P.K./WASHER
 9/27/93, RCC
 D.N.F.
 5/15/00

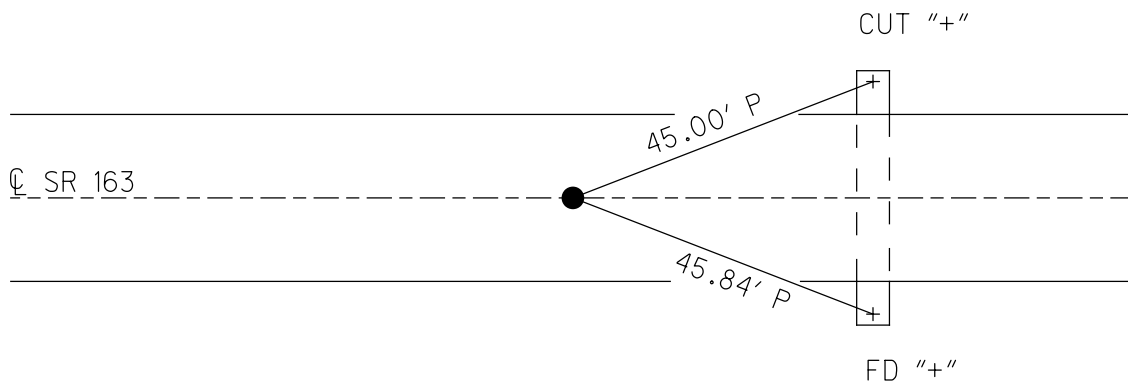

O.D.O.T. DISTRICT 2 SURVEY OFFICE

PERSONNEL

REFERENCE NO. 36 (?)

SHEET 17 OF 24

NOTES CHENEY

H.C. ZIPPLE

R.C. BARBOUR

DATE 6-17-1973

WEATHER FAIR

TEMP. 80°

ROUTE #163

COUNTY OTTAWA

TOWNSHIP HARRIS

SECTION 1

T. 6 N R. 14 E


TYPE MONUMENT R.R. SPK.

~~ON~~ SURFACE - BELOW 4.5"

~~LEFT - C~~ PAV'T. - ~~RIGHT~~ ON

11.5' TO LT. EDGE PAVEMENT

S.L.M. 601+70

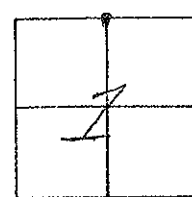

RECORDED: 11-13-1976

P.I. STA 600+23

FD. NIGGER HEAD WITH

IRON PIN N.E. OF STONE

2' RT. OF ϕ , 1.35' DOWN

RESET P.K. NAIL


* NOTE: MAY NOT BE REF. NO. 36
SEE REF. DATED: 11-13-76

SET P.K./WASHER


9-27-1993

RCC

5-15-00
D10 x 10" F 1/2"

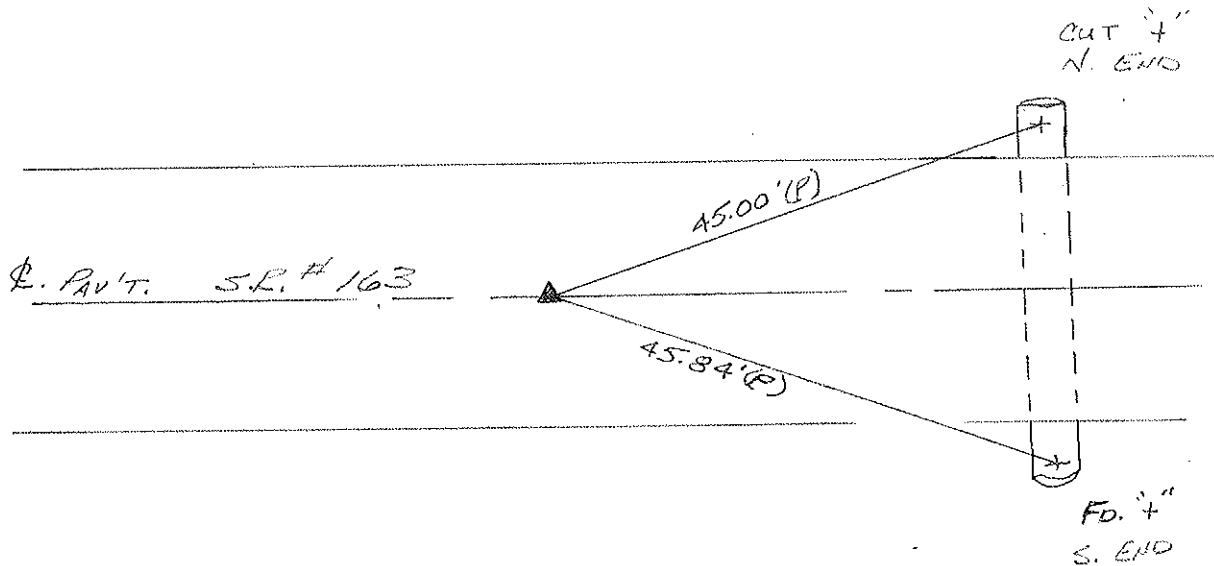

PERSONNEL	TITLE	PERSONNEL	TITLE	COUNTY	DATE
				<u>Ottawa</u>	<u>6-12-74</u>
				S. R. <u>163</u>	WEATHER <u>Fair</u>
				SEC. <u>8.22</u>	TEMP. <u>65</u>
DESCRIPTION <u>Salina Twp. sec 5</u>				JOB NO. _____	

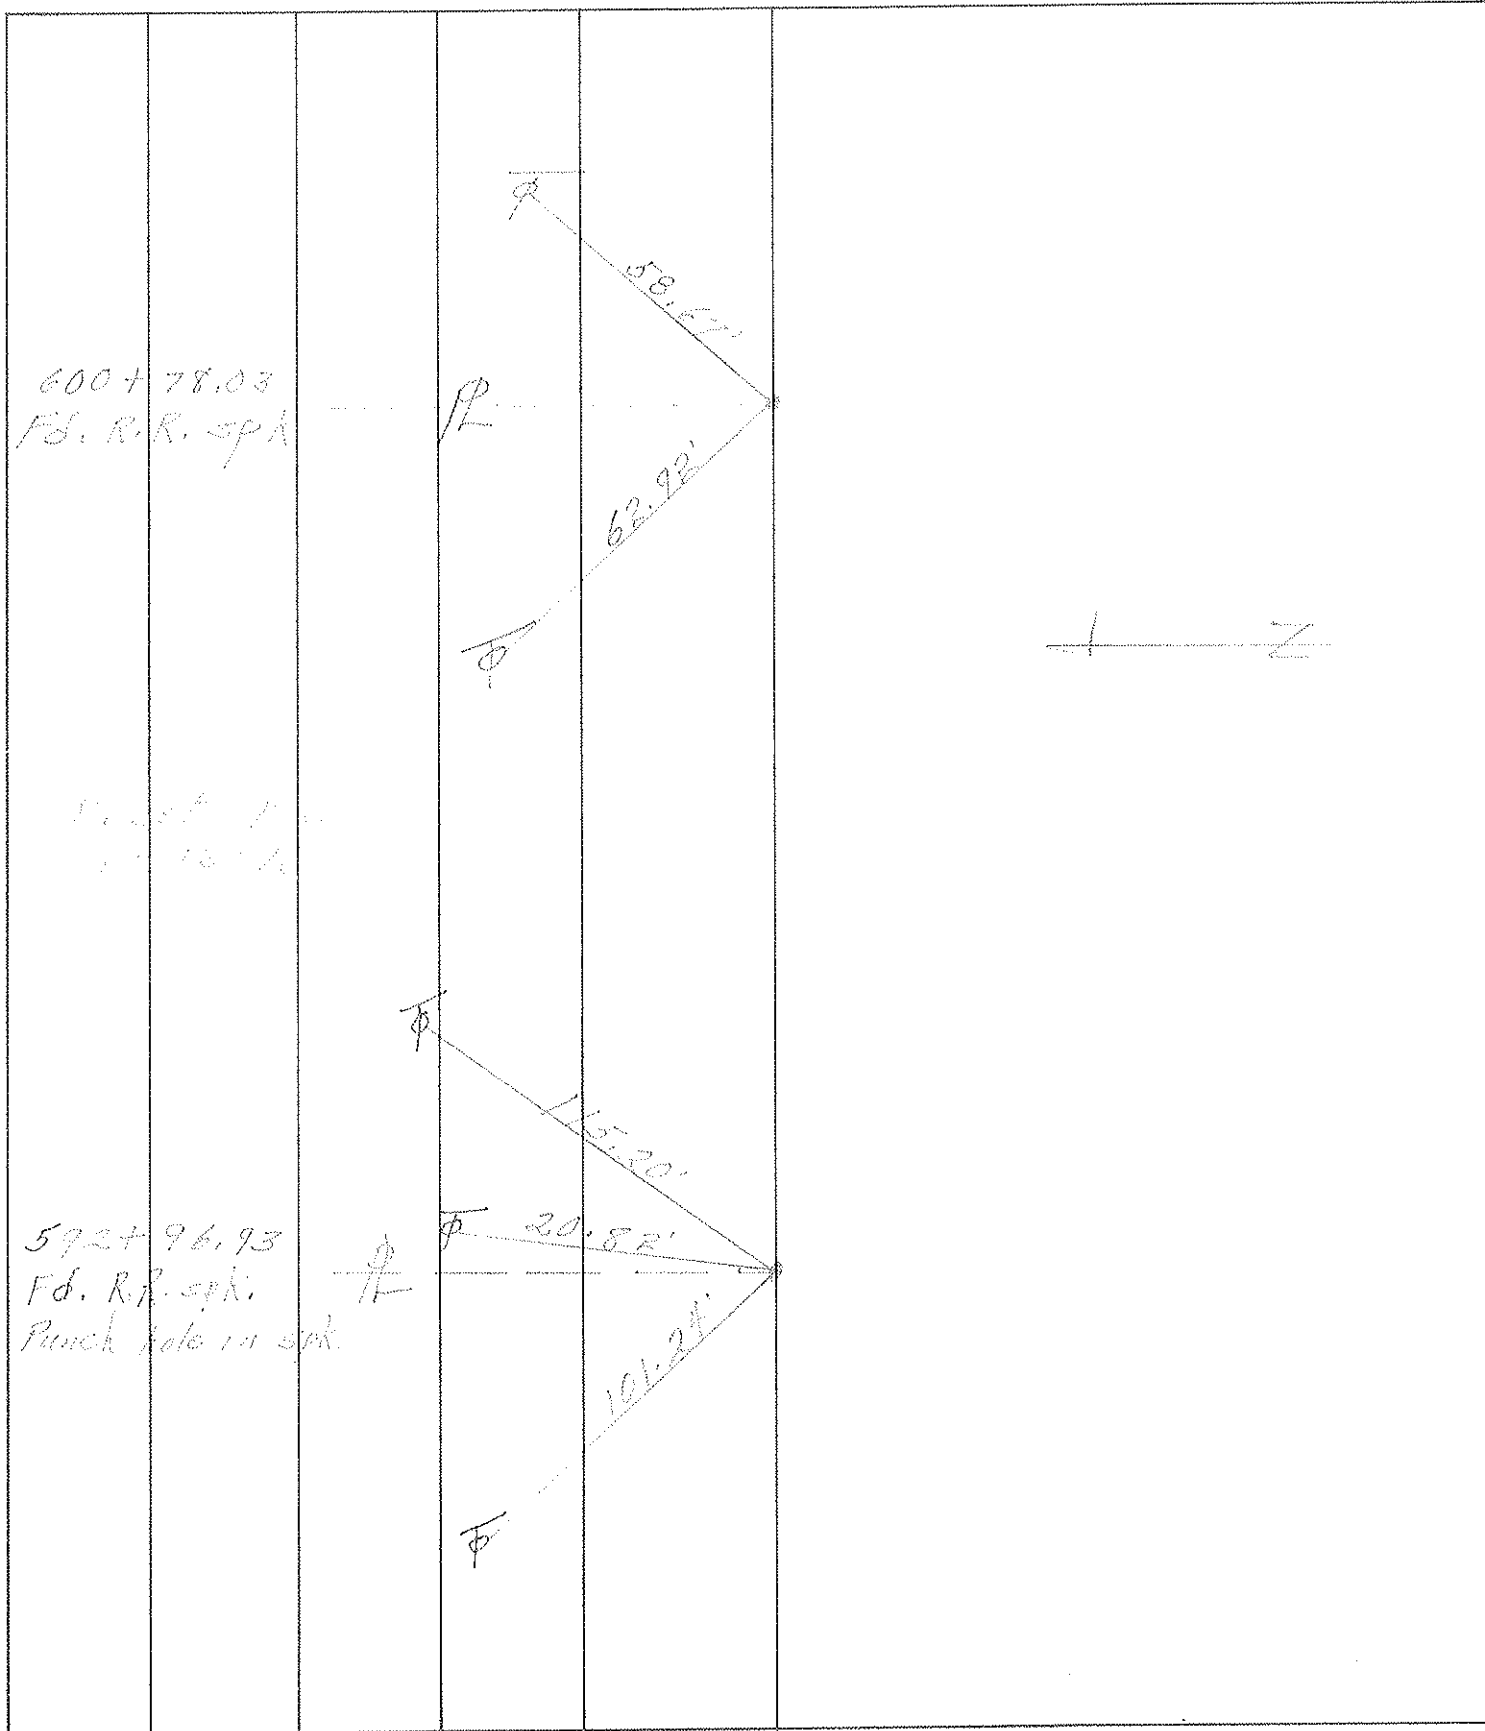


PERSONNEL TITLE PERSONNEL TITLE

COUNTY Ottawa DATE 3-3-66


S. R. 163 WEATHER

SEC. 9.98 TEMP. 60°

DESCRIPTION Control Points JOB NO.

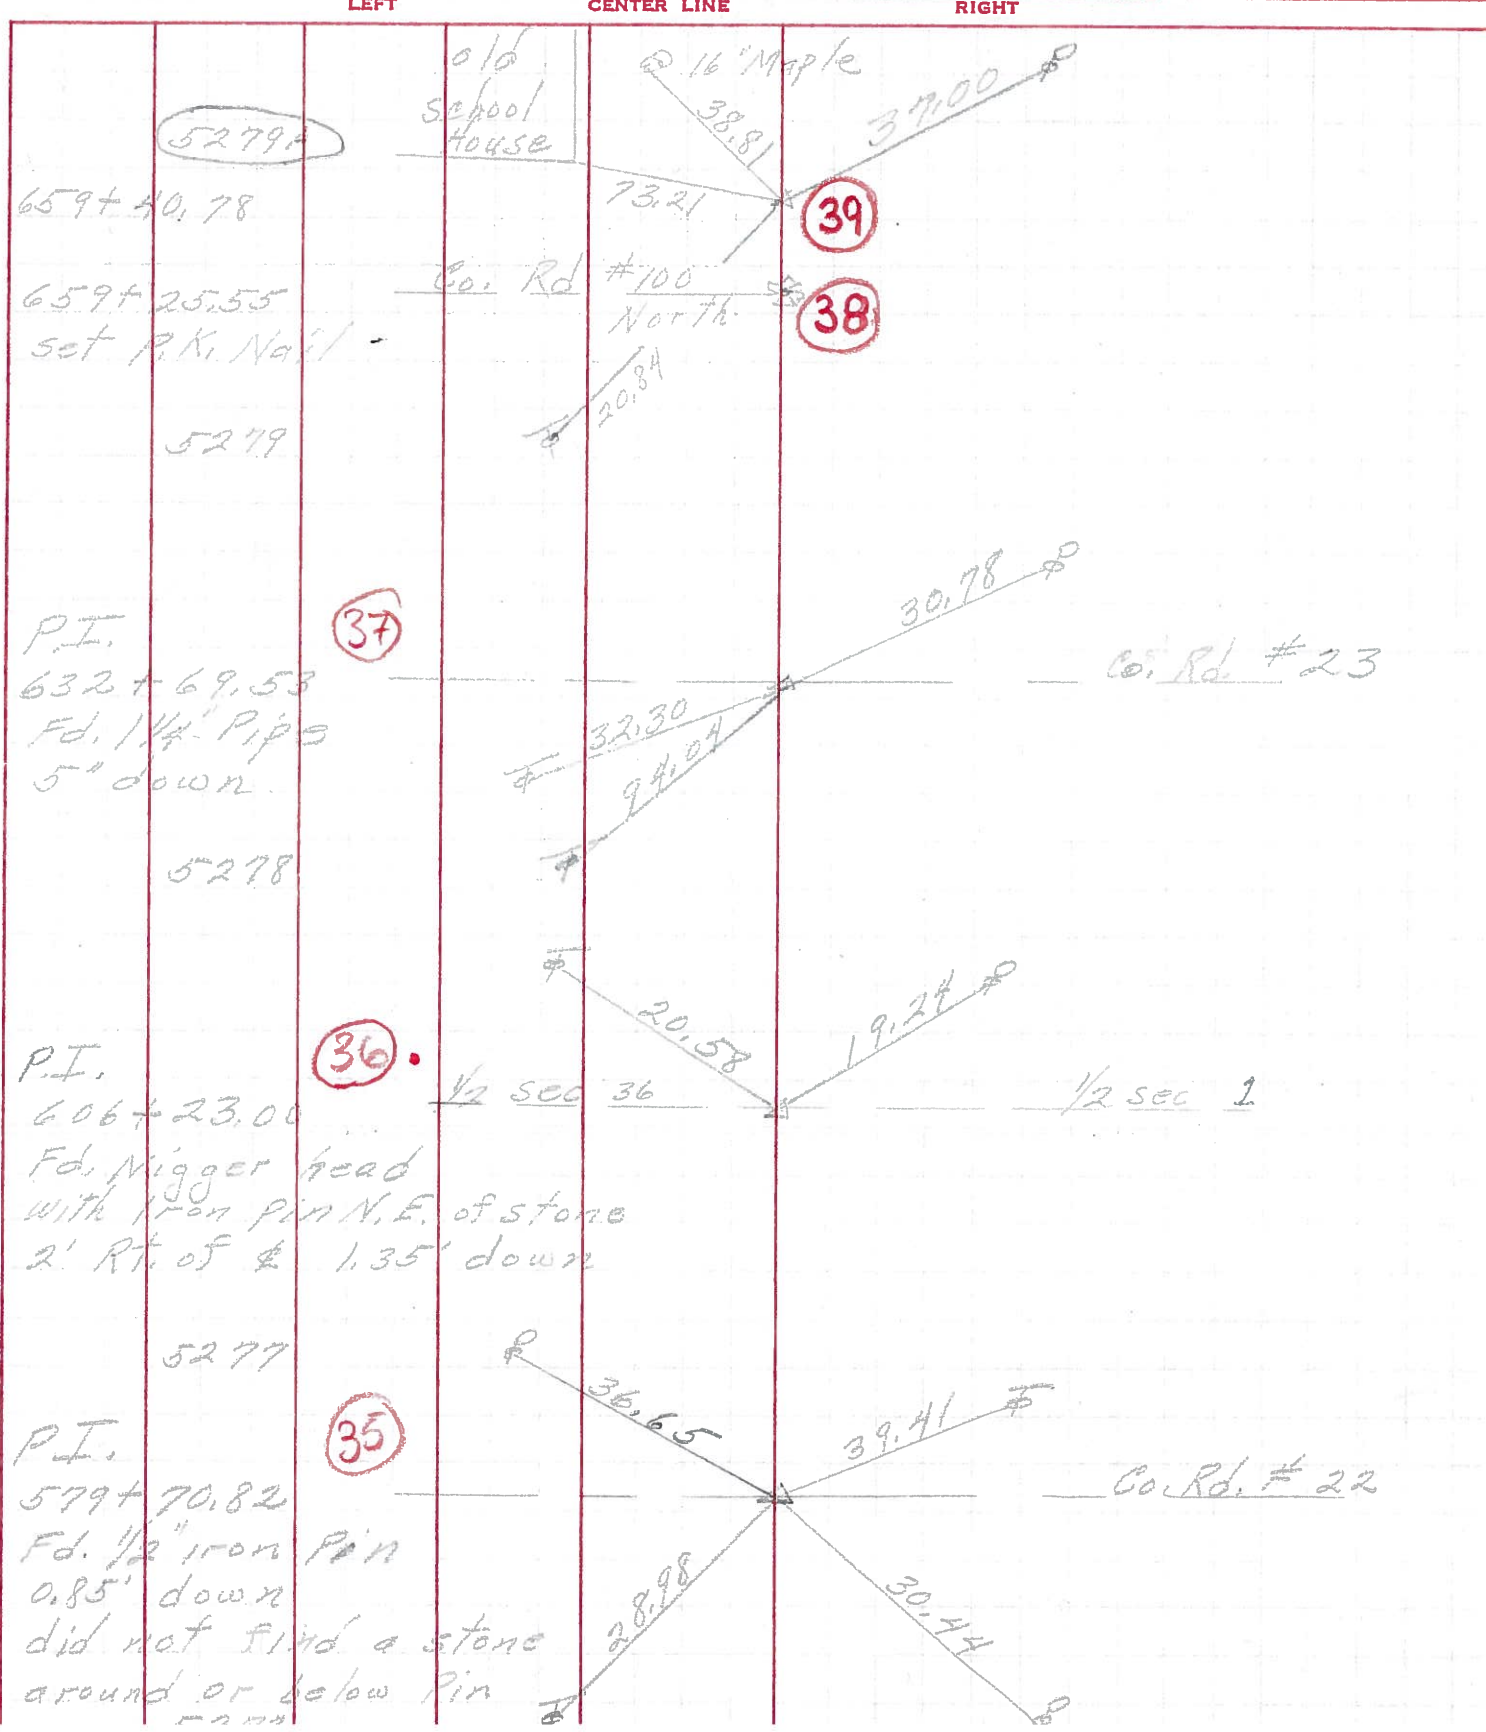

PERSONNEL	TITLE	PERSONNEL	TITLE
COUNTY <u>Ottawa</u> DATE <u>3-3-66</u>			
S. R. <u>163</u> WEATHER <u>Fair</u>			
SEC. <u>35-36 & 1-2</u> TEMP <u>60°</u>			
DESCRIPTION <u>Benton & Harris Twp.</u>			JOB NO.

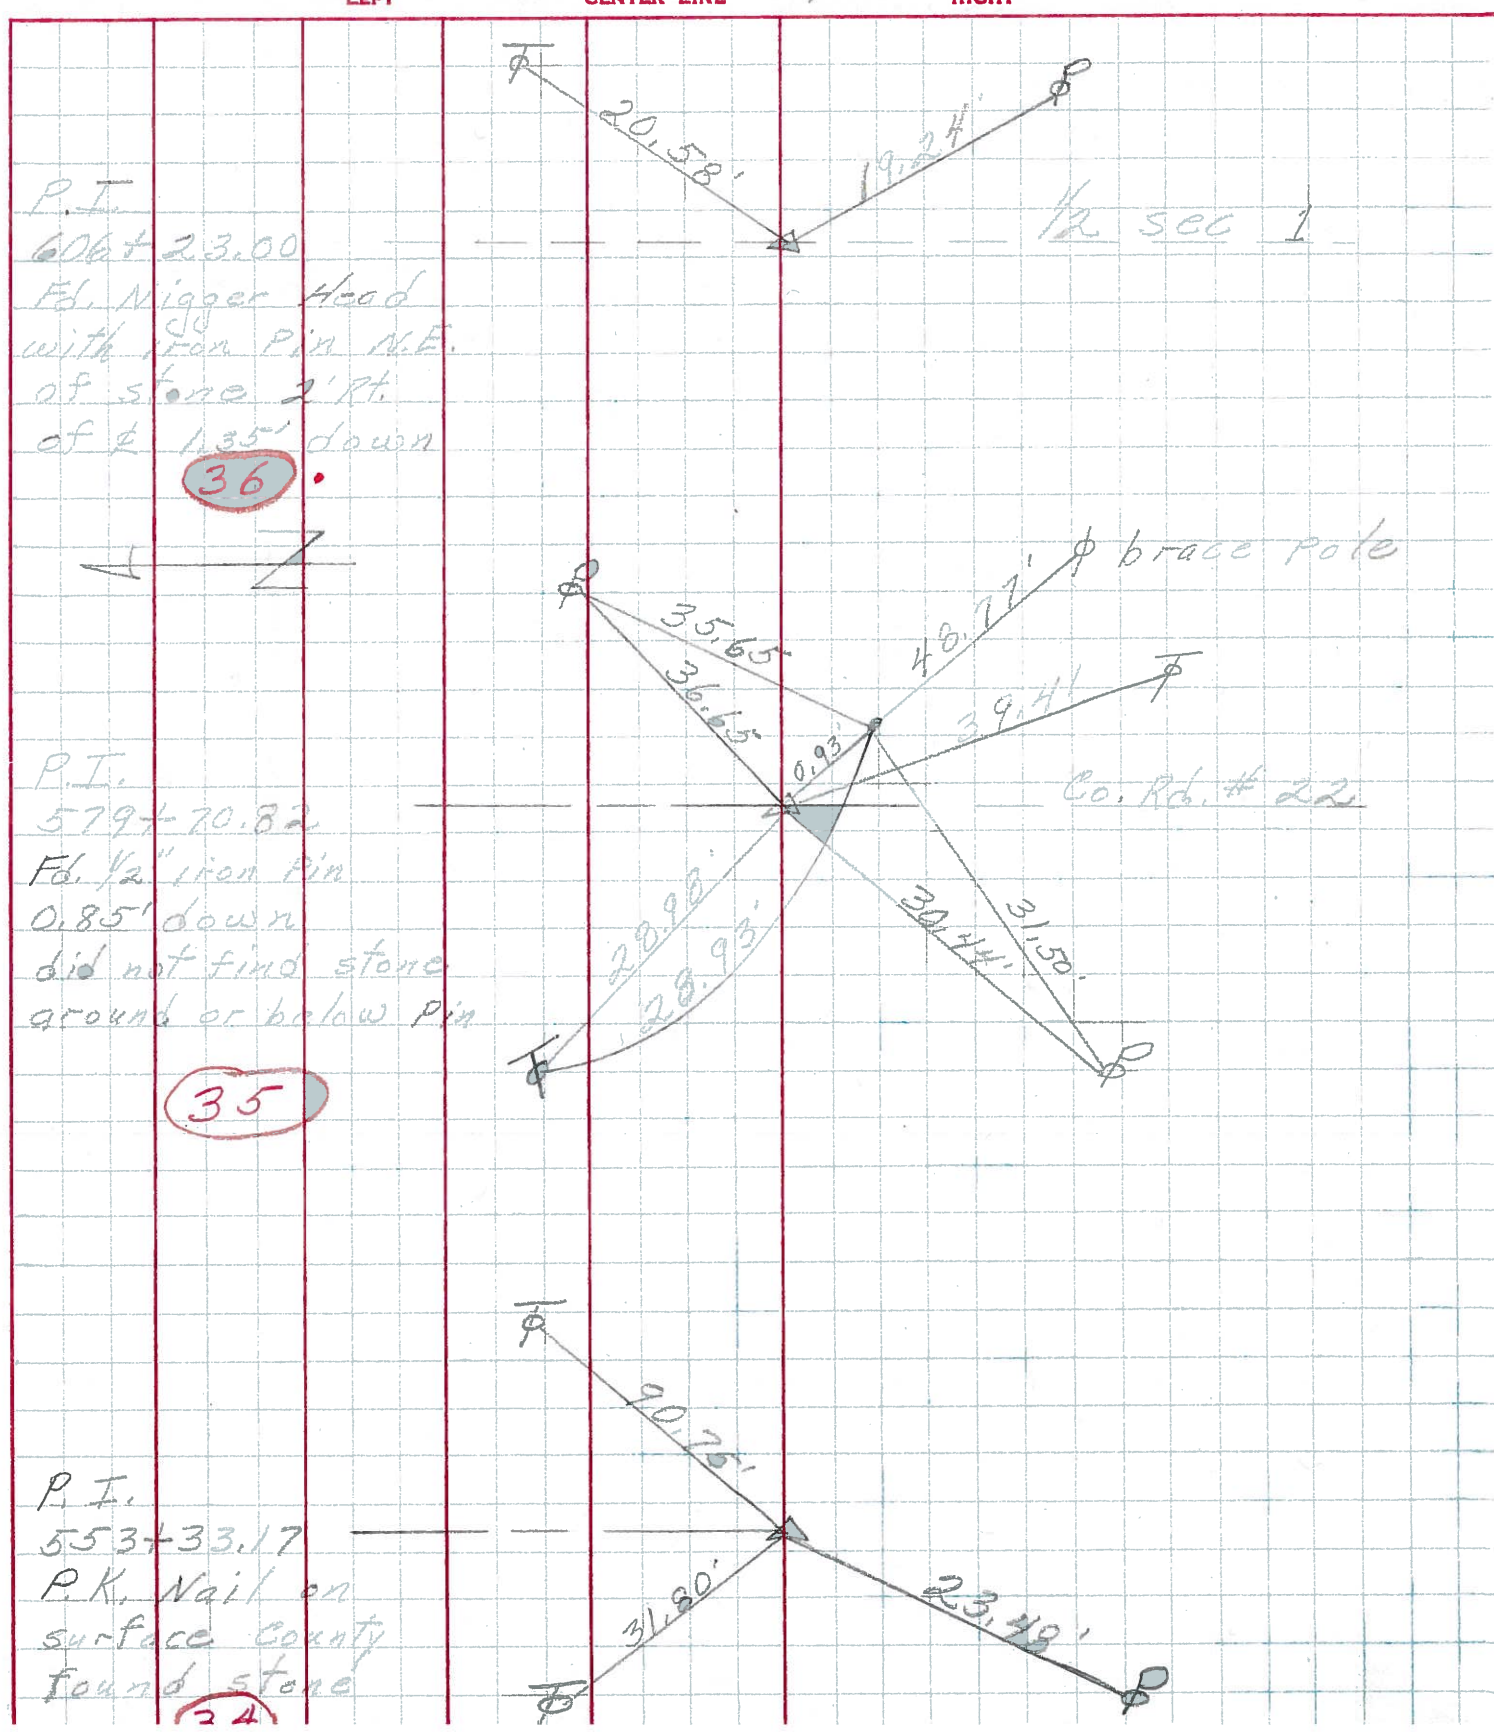

P.I.
606+23.00
Fd. Nigger Head
with iron pin N.E.
of stone 2' Pt.
of & 1.35' down
36

P.I.
579+70.82
Fd. 1/2" iron pin
0.85' down
did not find stone
ground or below pin
35

P.I.
553+33.17
P.K. Nail on
surface county
found stone
24