

O.D.O.T. DISTRICT 2 SURVEY OFFICE (USE ONLY)

PERSONNEL

REFERENCE NO. 38

SHEET 8 OF 17

NOTES CHENEY

DATE 8/13/76

ROUTE SR 163

H.C. RIPPLE

WEATHER FAIR

COUNTY OTTAWA

R.C. BARBOUR

TEMP. 80°

TOWNSHIP SALEM

SECTION 6

DWG BY NIESE PID _____

T 6 N R 15 E

TYPE MONUMENT MONBOX

ON SURFACE - ~~BELOW~~ ON

OFFSET ☉ PAVEMENT 23.0' LT : ~~RT~~

11' RT TO RT EDGE PAVEMENT


STATION: 659+25.55

HORIZ.DATUM: _____


GEOID: _____

GRID: NORTHING: _____

EASTING: _____

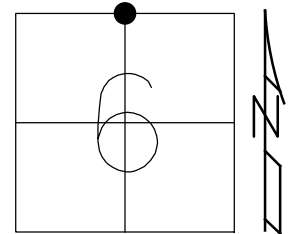

RECORD:
 STA 659+25.55
 SET P.K. NAIL
 8/13/76
 FD MONBOX
 6/17/93, CHENEY
 9/27/93, RCC
 5/15/00

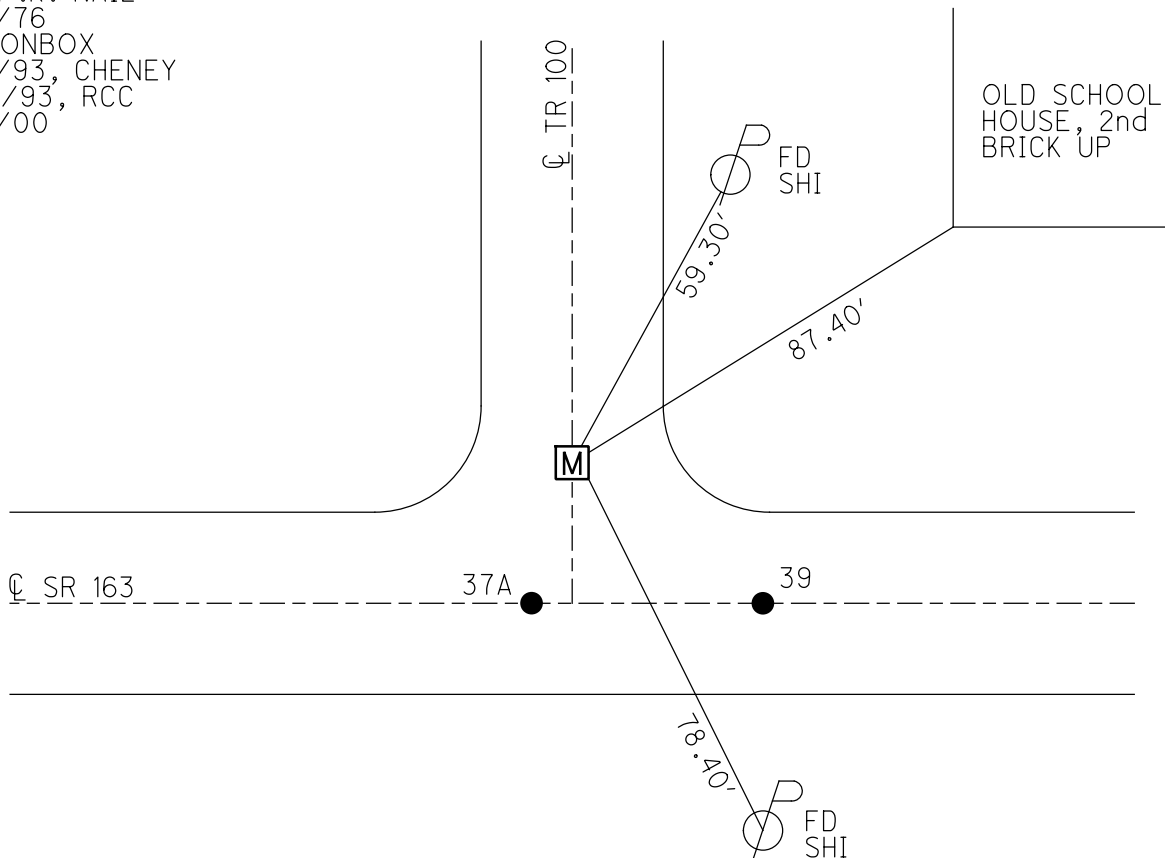

O.D.O.T. DISTRICT 2 SURVEY OFFICE

PERSONNEL

REFERENCE NO. 38-39

SHEET 19 OF 24

NOTES CHENEY

H.C. RIPPLE

R.C. BARBOUR

DATE 6-17-1993

WEATHER FAIR

TEMP. 80°


ROUTE #163

COUNTY OTAWA

TOWNSHIP SALEM

SECTION 6, 31

T 6 N R 15 E

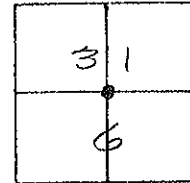

TYPE MONUMENT MONUMENT Box

ON SURFACE - ~~BELOW~~ ON

LEFT-~~☉~~ PAU'T. - ~~RIGHT~~ 23'

11' RT. TO RT. EDGE PAVEMENT

S.L.M. 660+40

RECORD: 8-13-1976

P.I. STA. 659+40.78 (DID NOT FIND 1993)

PK. NAIL

RESET PK. NAILS

659+25.55 (MON. Box 1993)

SET PK. NAIL

COUNTY SET RR. SPK.

ON SEC. LINE SOUTH

RESET SMALL SPK.


(DID NOT FIND 1993)

* NOTE: SEE SHEET No. 13
8-13-1976 REF.

Box 15 UP
9-27-1993
RCC

OLD SCHOOL
HOUSE

TOP OF
2ND. BLOCK

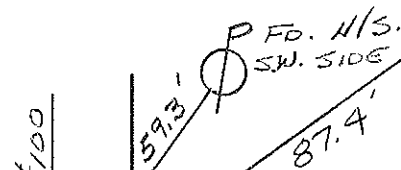


Fd Mon. Box

☉ PAU'T.

S.R. #163

78.4'

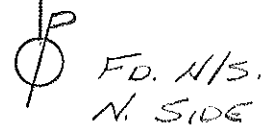

Preventive Maintenance
Microsurfaced 2000
Existing Point Uncovered
Date 5-15-00

PERSONNEL TITLE PERSONNEL TITLE


COUNTY Ottawa DATE 8-13-76

S. R. 163 WEATHER Fair

SEC. 36-31 1-6 TEMP. 80°

DESCRIPTION Beaton, Harris, Salem Townships JOB NO.

LEFT CENTER LINE RIGHT

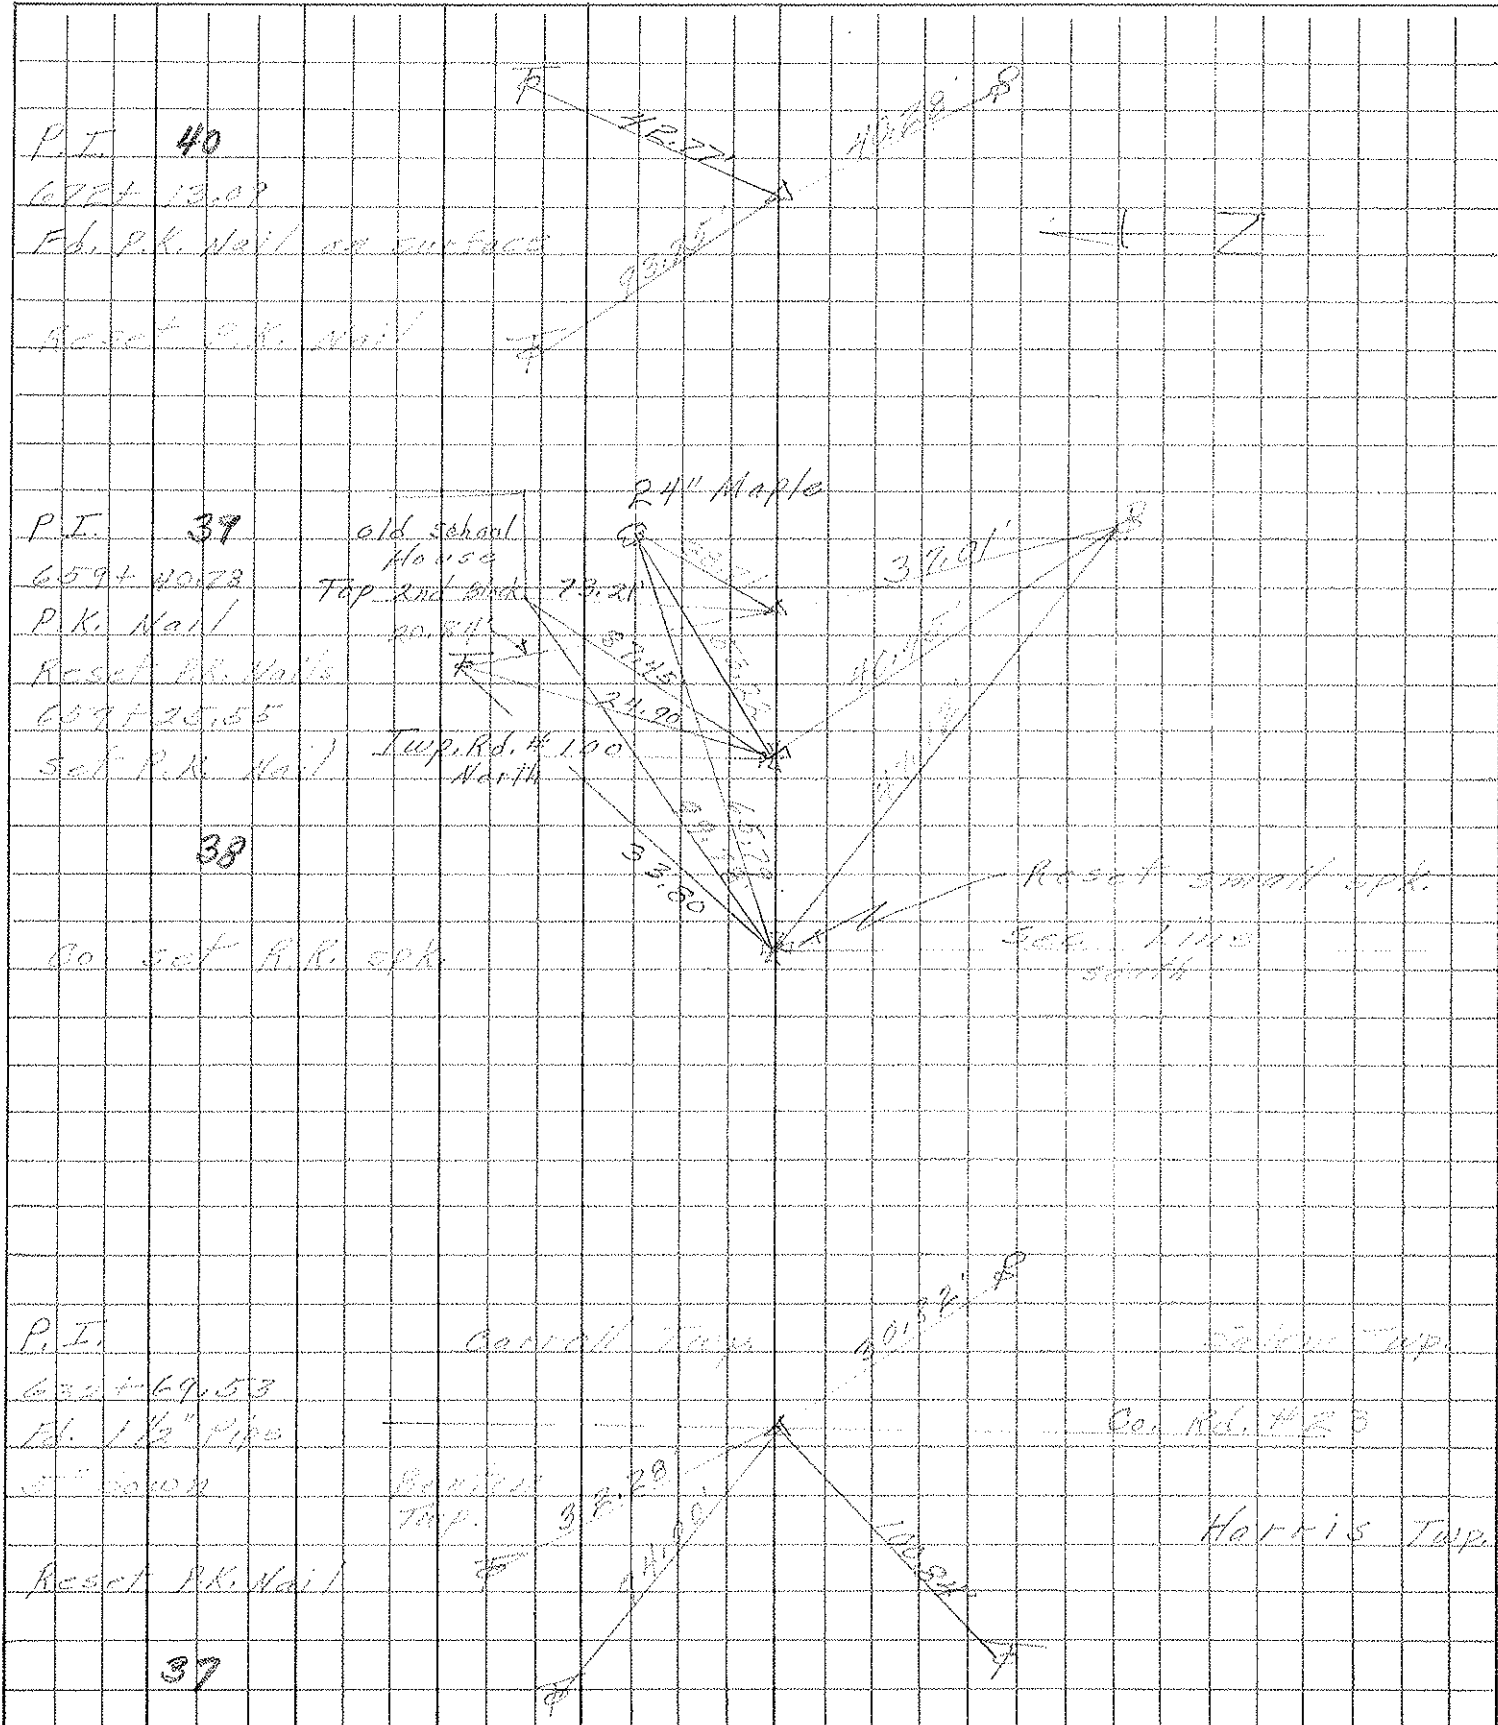


PERSONNEL TITLE PERSONNEL TITLE

COUNTY Ottawa DATE 3-3-66

S. R. 163 WEATHER

SEC. 9.98 TEMP. 60°

DESCRIPTION Control Points JOB NO.

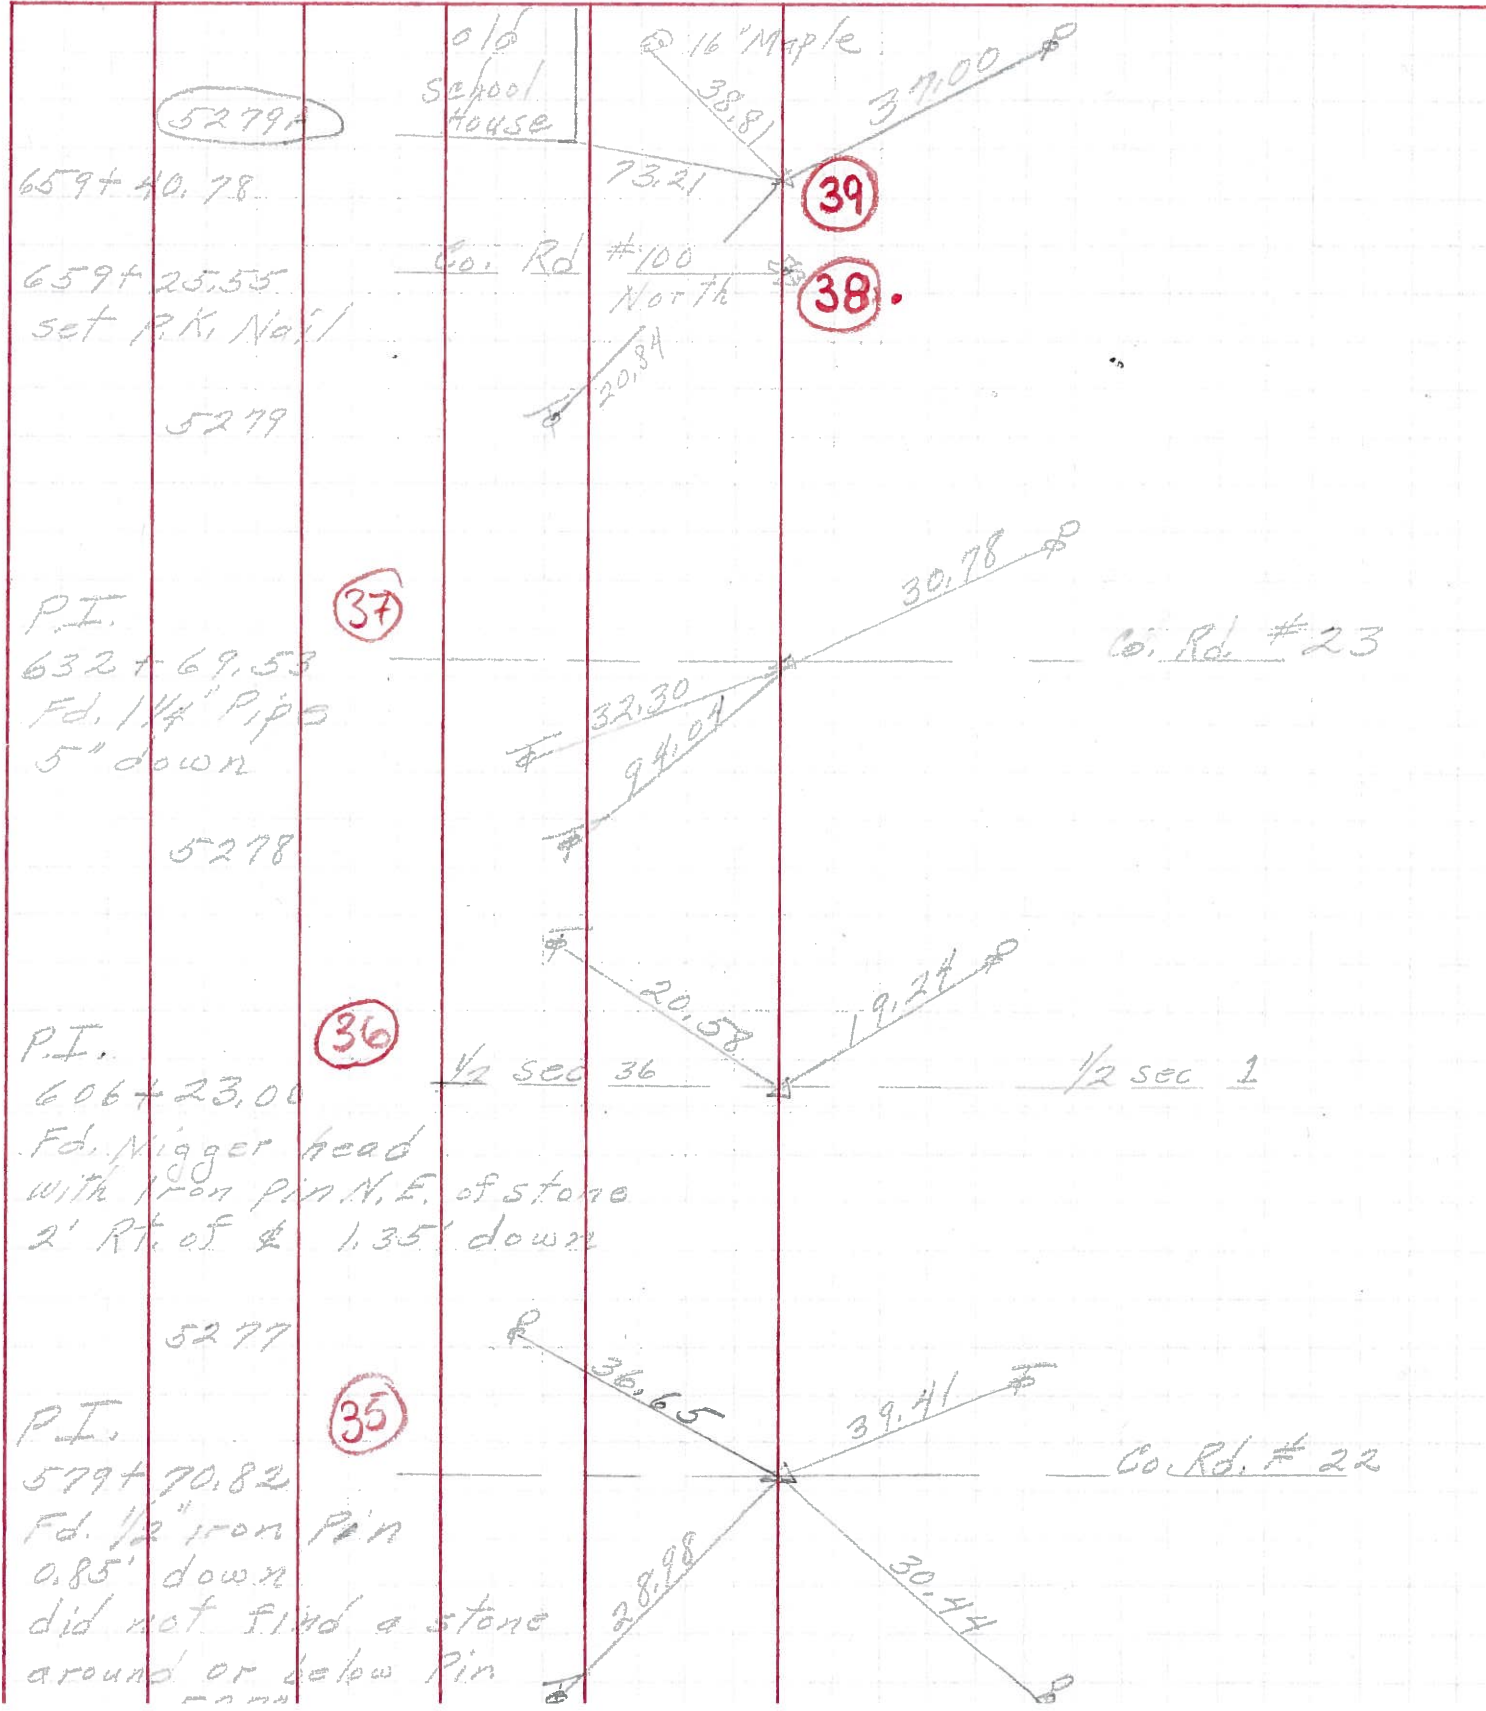

5279A

659+40.78

659+25.55
set P.K. Nail

5279

P.I.
632+69.53
Fd. 1/4" Pipe
5" down

5278

P.I.
606+23.00
Fd. Nigger head
with Iron pin N.E. of stone
2' Rt. of & 1.35' down

5277

P.I.
579+70.82
Fd. 1/2" iron Pin
0.85' down
did not find a stone
around or below Pin

PERSONNEL TITLE PERSONNEL TITLE


COUNTY Ottawa DATE 3-3-66

S. R. 163 WEATHER

SEC. 36-31 & 1-6 TEMP.

DESCRIPTION Benton, Harris, Salem & Carroll Twp. JOB NO.

LEFT CENTER LINE RIGHT

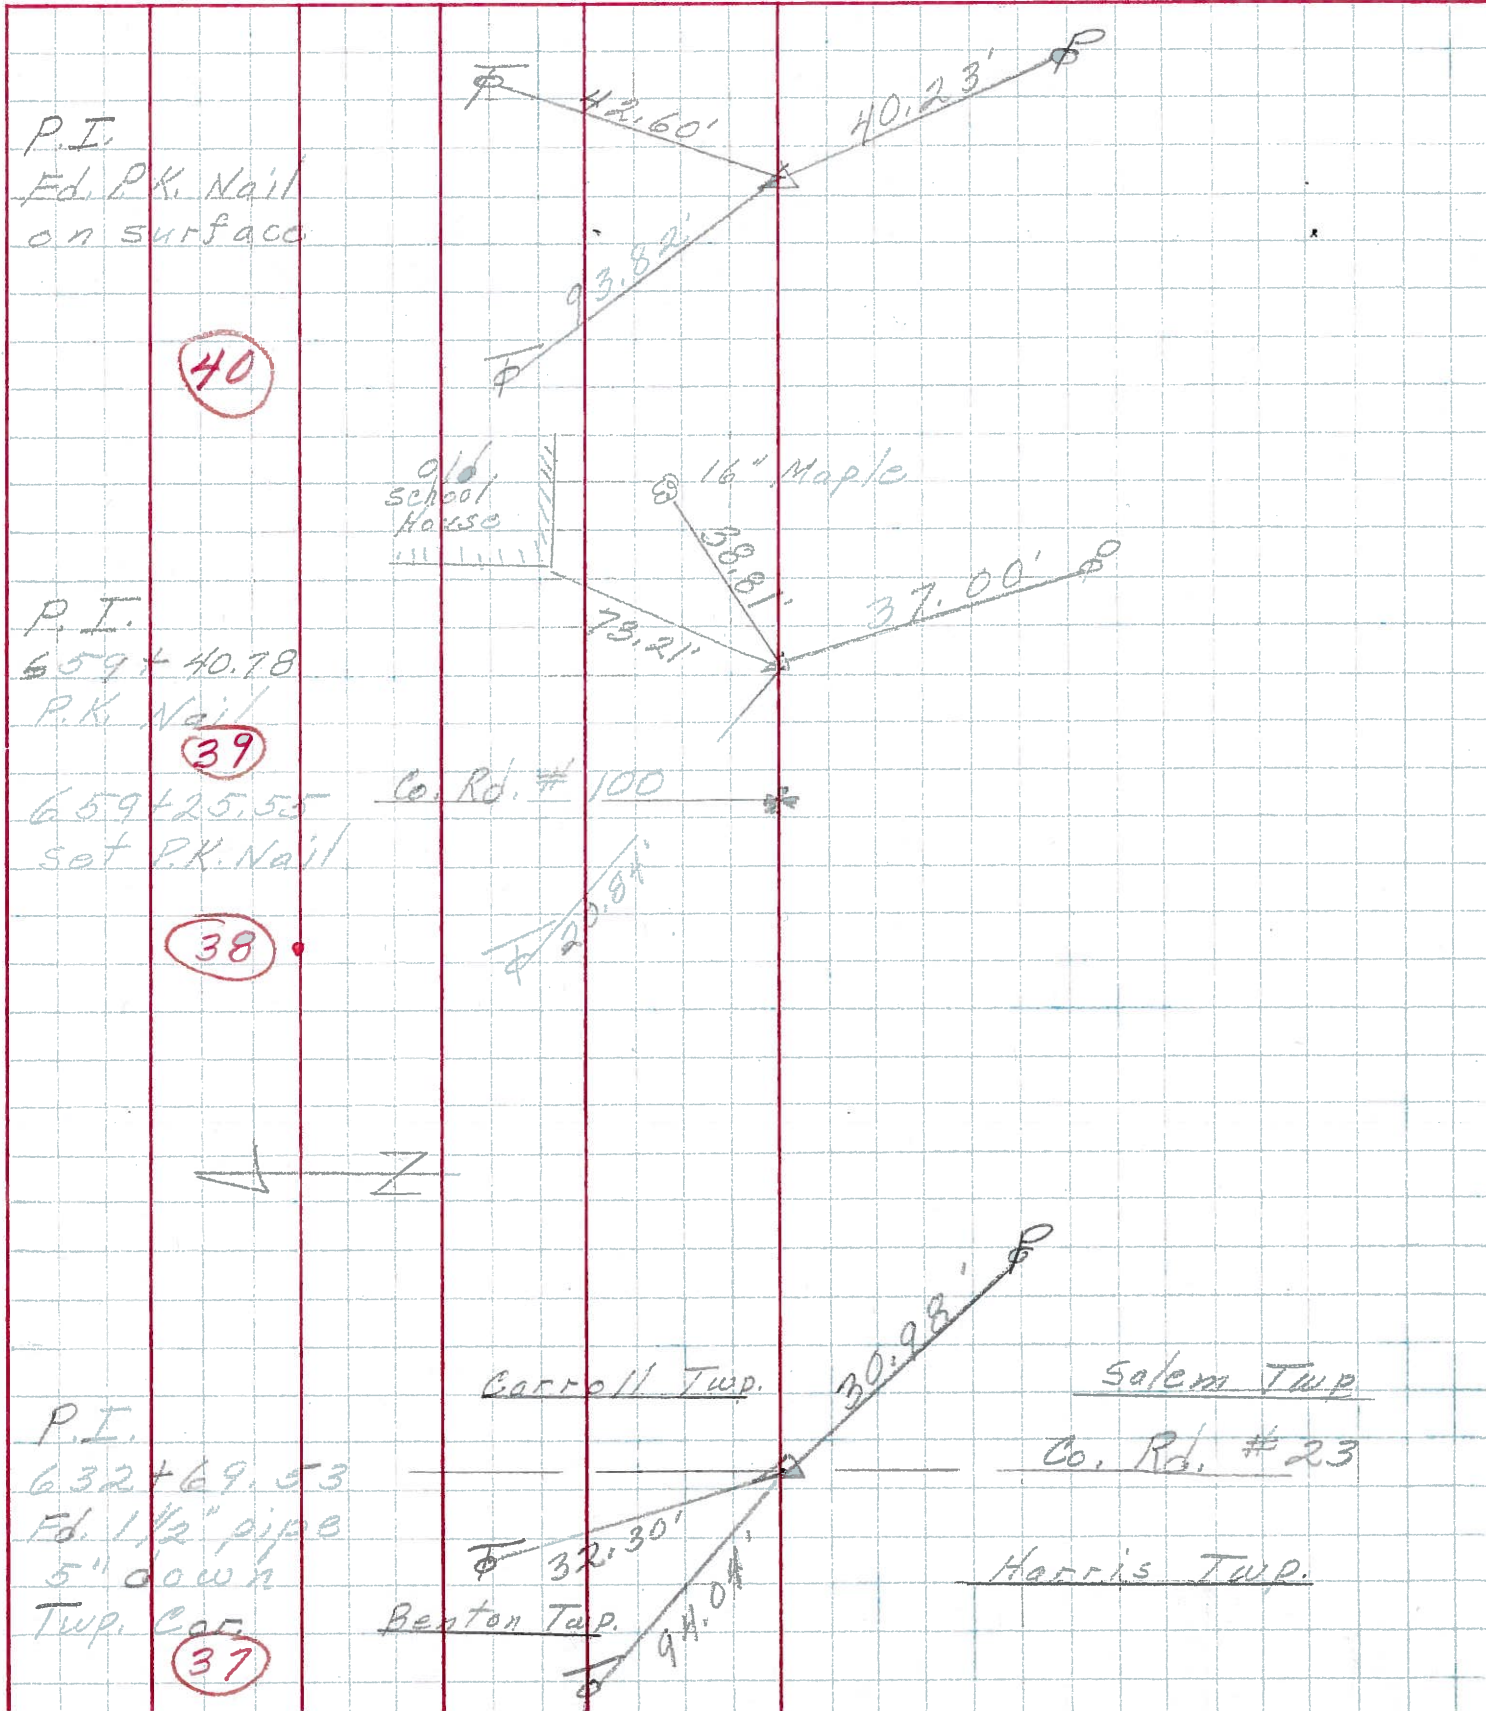

P.I.
Fd. PK. Nail
on surface

40

P.I.
659+40.78
P.K. Nail

39

659+25.55
set P.K. Nail

38

P.I.
632+69.53
Fd. 1 1/2" pipe
5" down
Twp. Cor.

37

Carroll Twp.

Salem Twp.

Co. Rd. # 23

Harris Twp.

Benton Twp.