

O.D.O.T. DISTRICT 2 SURVEY OFFICE (USE ONLY)

PERSONNEL _____

REFERENCE NO. 40 A

SHEET 11 OF 17

NOTES CHENEY DATE 8/16/76

H.C. RIPPLE WEATHER FAIR

R.C. BARBOUR TEMP. 75°

ROUTE SR 163

COUNTY OTTAWA

TOWNSHIP SALEM

SECTION 6

DWG BY NIESE PID _____

T 6 N R 15 E

TYPE MONUMENT P.K. NAIL

ON SURFACE - ~~BELOW~~ ON


OFFSET Q PAVEMENT _____ LT : RT

_____ TO _____ EDGE PAVEMENT


STATION: 687+27.41

HORZ. DATUM: _____ GEOID: _____

GRID: NORTHING: _____ EASTING: _____

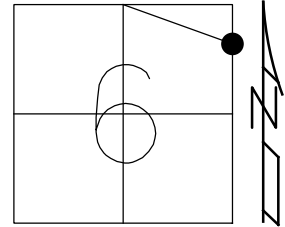

RECORD:
FD P.K. NAIL
1970 PLANS
SET P.K. NAIL
8/16/76

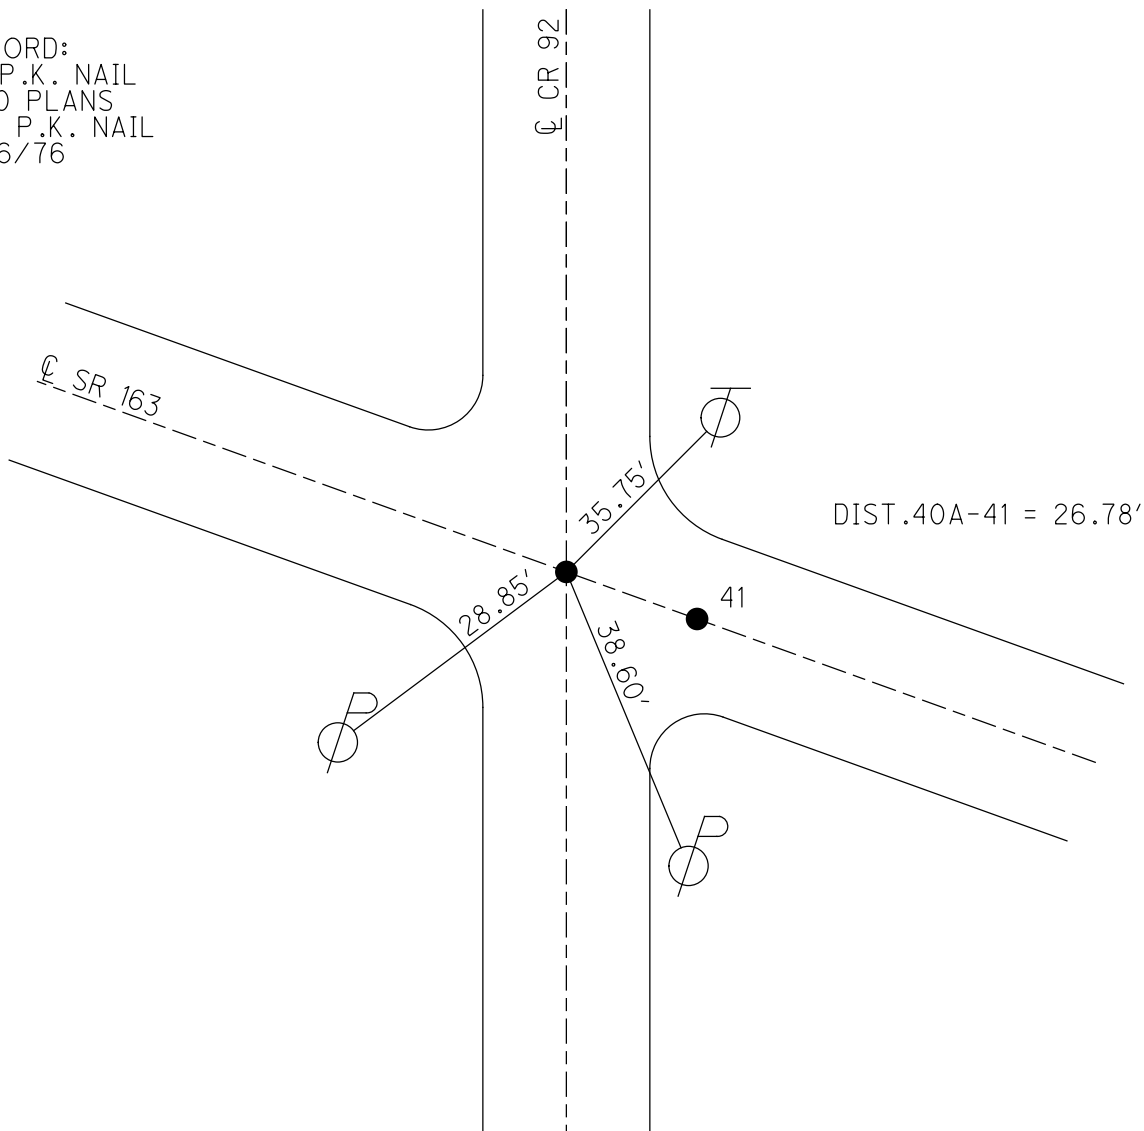

PERSONNEL TITLE PERSONNEL TITLE

COUNTY Ottawa DATE 8-16-76

S. R. 163 WEATHER Fair

SEC. 5 TEMP. 75°

DESCRIPTION Salem Twp. LEFT CENTER LINE RIGHT JOB NO.

P.L. R.R. S.P.K. (P)
Reset P.K. Nail

P.L. 43
2017 84.50
Iron Pin
10' Lt. of edge permit.

Broke 3/16"

T.S.
6964
11' Lt. of 4
Reset P.K. Nail

P.L. 42
6947 64.56
Ed. P.K. Nail

Reset P.K. Nail

P.L. # 41
6874 52.12
Ed. P.K. Nail on Top

Reset P.K. Nails

