

O.D.O.T. DISTRICT 2 SURVEY OFFICE (USE ONLY)

PERSONNEL \_\_\_\_\_

REFERENCE NO. 42 A

SHEET 14 OF 17

NOTES CHENEY DATE 8/16/76

ROUTE SR 163

H.C. RIPPLE WEATHER FAIR

COUNTY OTTAWA

R.C. BARBOUR TEMP. 75°

TOWNSHIP SALEM

SECTION 5

DWG BY NIESE PID \_\_\_\_\_

T 6 N R 15 E

TYPE MONUMENT P.K. NAIL

ON SURFACE - ~~BELOW~~ ON


OFFSET  $\varnothing$  PAVEMENT 1.0' LT : ~~RT~~

TO EDGE PAVEMENT


STATION: 696+39.8

HORZ. DATUM: \_\_\_\_\_ GEOID: \_\_\_\_\_

GRID: NORTHING: \_\_\_\_\_ EASTING: \_\_\_\_\_

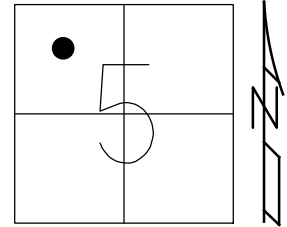

RECORD: T.S.  
STA 696+39.8  
SET P.K. NAIL  
8/16/76

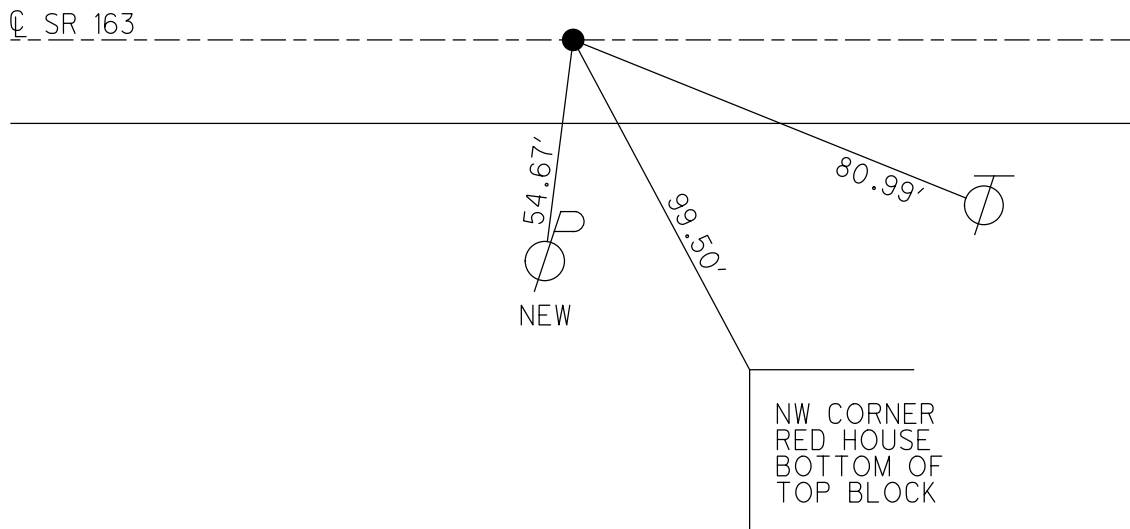

PERSONNEL TITLE PERSONNEL TITLE

COUNTY Ottawa DATE 8-16-76

S. R. 163 WEATHER Fair

SEC. 5 TEMP. 15°

DESCRIPTION Calum Twp. LEFT CENTER LINE RIGHT JOB NO.

