

O.D.O.T. DISTRICT 2 SURVEY OFFICE (USE ONLY)

PERSONNEL _____

REFERENCE NO. 43 A

SHEET 16 OF 17

NOTES CHENEY DATE 8/16/76

ROUTE SR 163

H.C. RIPPLE WEATHER FAIR

COUNTY OTTAWA

R.C. BARBOUR TEMP. 75°

TOWNSHIP SALEM

DWG BY NIESE PID _____

SECTION 5

T 6 N R 15 E

TYPE MONUMENT R.R. SPIKE

ON SURFACE - ~~BELOW~~ ON


OFFSET ☐ PAVEMENT on _____ LT : RT

_____ TO _____ EDGE PAVEMENT


STATION: 702+21 ±

HORZ. DATUM: _____ GEOID: _____

GRID: NORTHING: _____ EASTING: _____

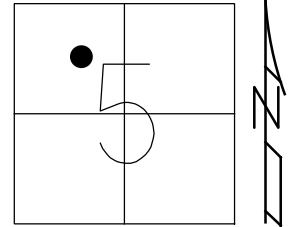

RECORD:
FD R.R. SPIKE
ON P
SET P.K. NAIL
8/16/76

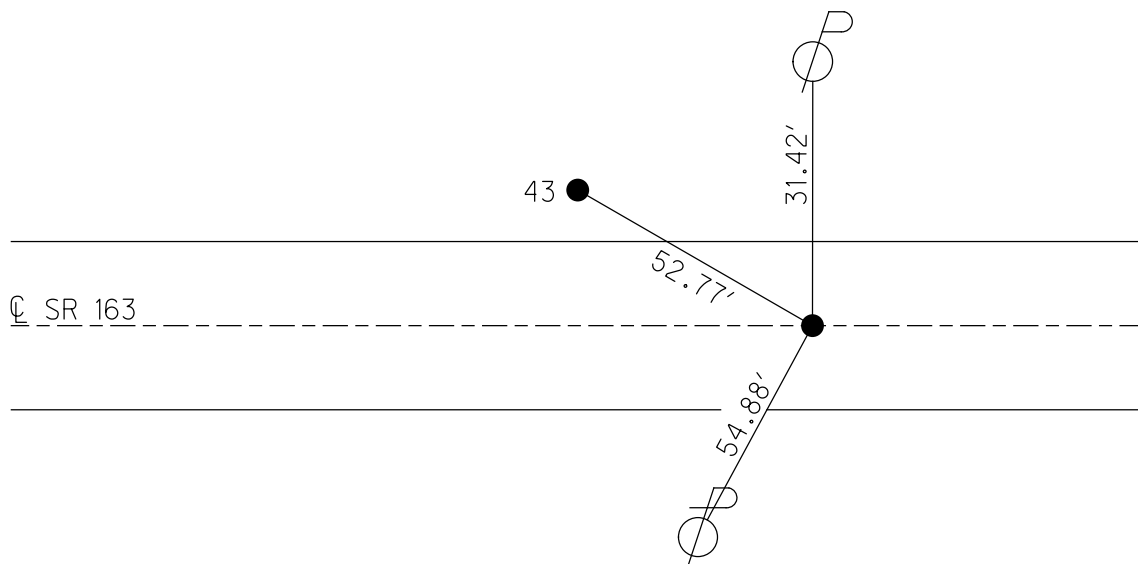

PERSONNEL _____ TITLE _____ PERSONNEL _____ TITLE _____
 COUNTY Chawa DATE 8-16-76
 S. R. 163 WEATHER Fair
 SEC. 5 TEMP. 15°

DESCRIPTION Calum Twp. LEFT _____ CENTER LINE _____ RIGHT _____ JOB NO. _____

