

O.D.O.T. DISTRICT 2 SURVEY OFFICE (USE ONLY)

PERSONNEL \_\_\_\_\_

REFERENCE NO. 45

SHEET 1 OF 74

NOTES RIPPLE DATE 6-18-93  
 H.C. BARBOUR WEATHER FAIR  
 R.C. GEYMAN TEMP. 90°

ROUTE SR 163  
 COUNTY OTTAWA  
 TOWNSHIP SALEM  
 SECTION 5

DWG BY JAMES PID 95757

T 6 N R 15 E

TYPE MONUMENT 1/2" IRON ROD

ON SURFACE - ~~BELOW~~ ON



OFFSET CL PAVEMENT ON LT : RT

11.7' TO RT EDGE PAVEMENT

STATION: 717+45

HORZ.DATUM: \_\_\_\_\_ GEOID: \_\_\_\_\_

GRID: NORTHING: \_\_\_\_\_ EASTING: \_\_\_\_\_

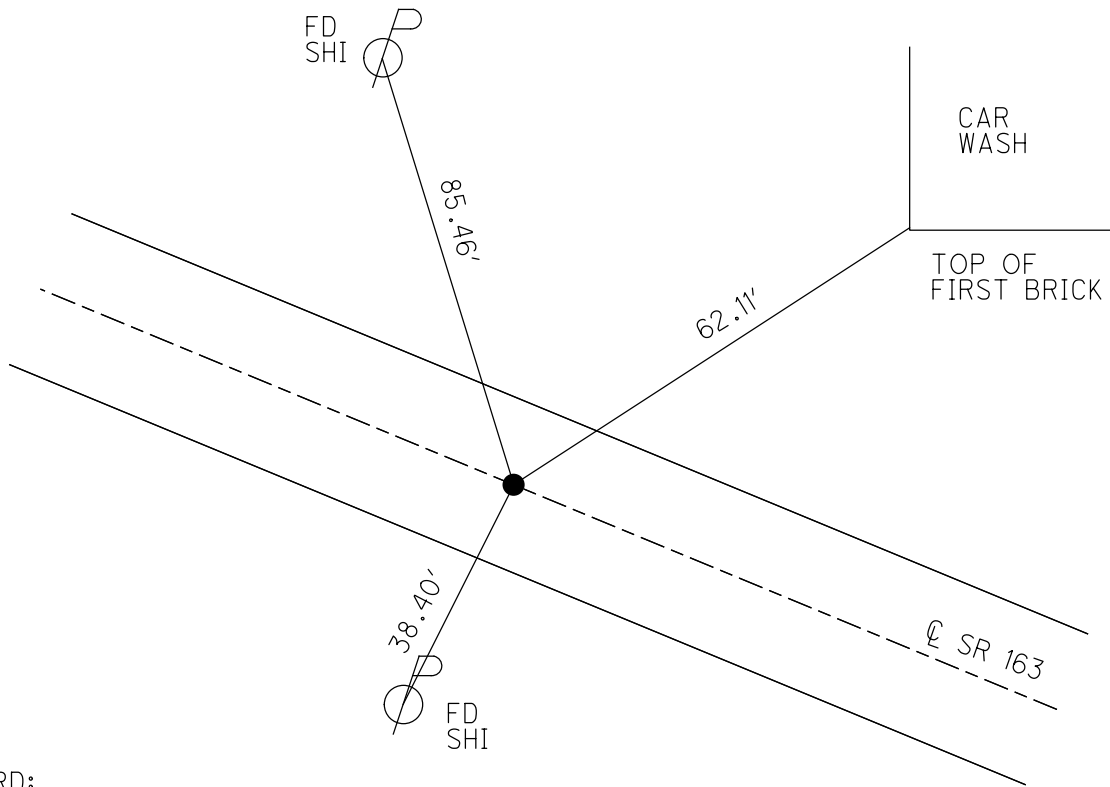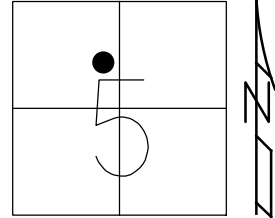

RECORD:  
 SET P.K./WASHER  
 8-16-76  
 FD 1/2" IRON ROD  
 6-18-93, BARBOUR  
 SET P.K./WASHER  
 7-27-93, RCC  
 DNF  
 6-28-17, JLL

O.D.O.T. DISTRICT 2 SURVEY OFFICE

PERSONNEL

REFERENCE NO. 45

SHEET 21 OF 24

NOTES RIPPLE

H.C. BARBOUR

R.C. GEYMAN

DATE 6-18-1993

WEATHER FAIR

TEMP. 90°

ROUTE #163

COUNTY OTTAWA

TOWNSHIP SALEM

SECTION 5-OAK HARBOR

T 6 N R 15 E


TYPE MONUMENT 1/2" IRON ROD

ON SURFACE - BELOW ON

~~LEFT~~ - C. PAV'T. - RIGHT ON

11.7' TO RT. EDGE PAVEMENT

S.L.M. 717+45

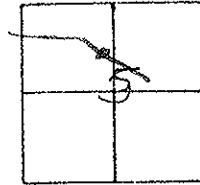


RECORD: 8-16-1976

STA. 715+97

RESET RR. NAIL

SET PK / WASHER  
7-27-1993  
RCC

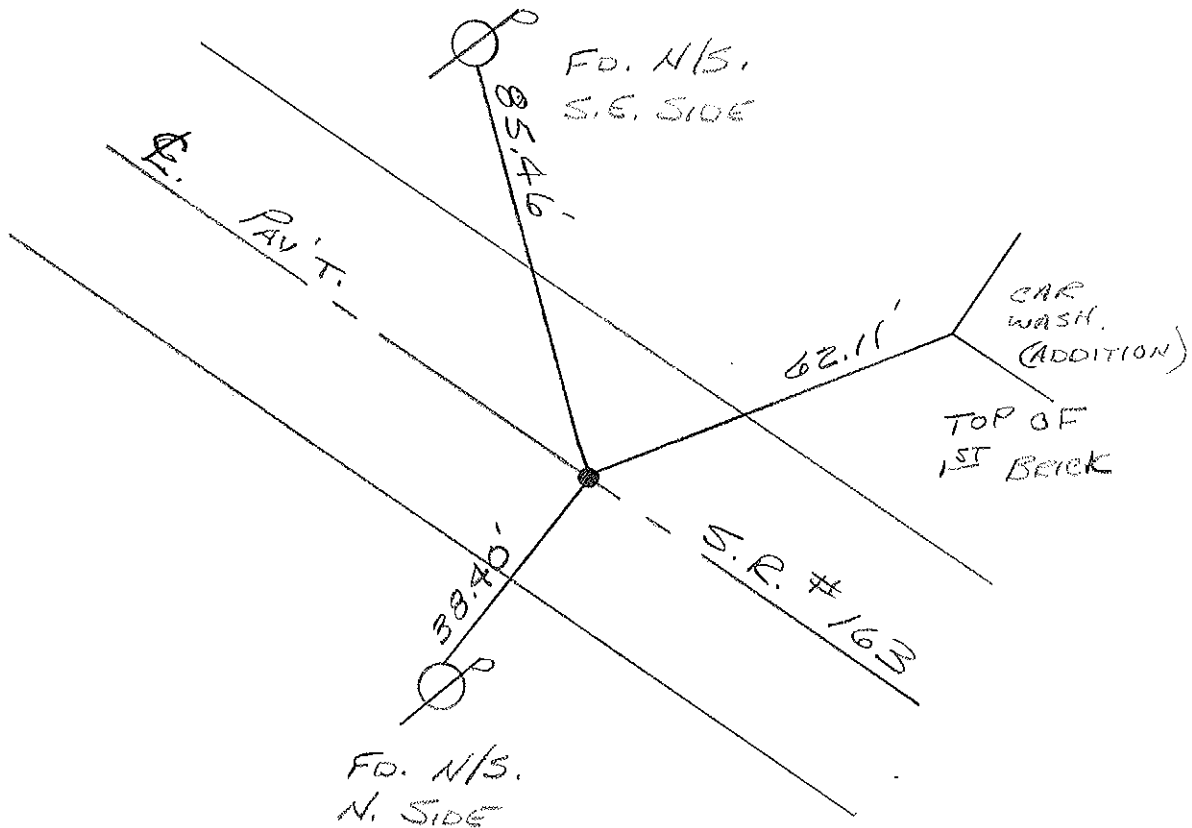


PERSONNEL TITLE PERSONNEL TITLE

COUNTY Ottawa DATE 8-16-76

S. R. 163 WEATHER Fair

SEC. 5 Water Twp. TEMP. 70°

DESCRIPTION Oak Harbor gas station JOB NO.

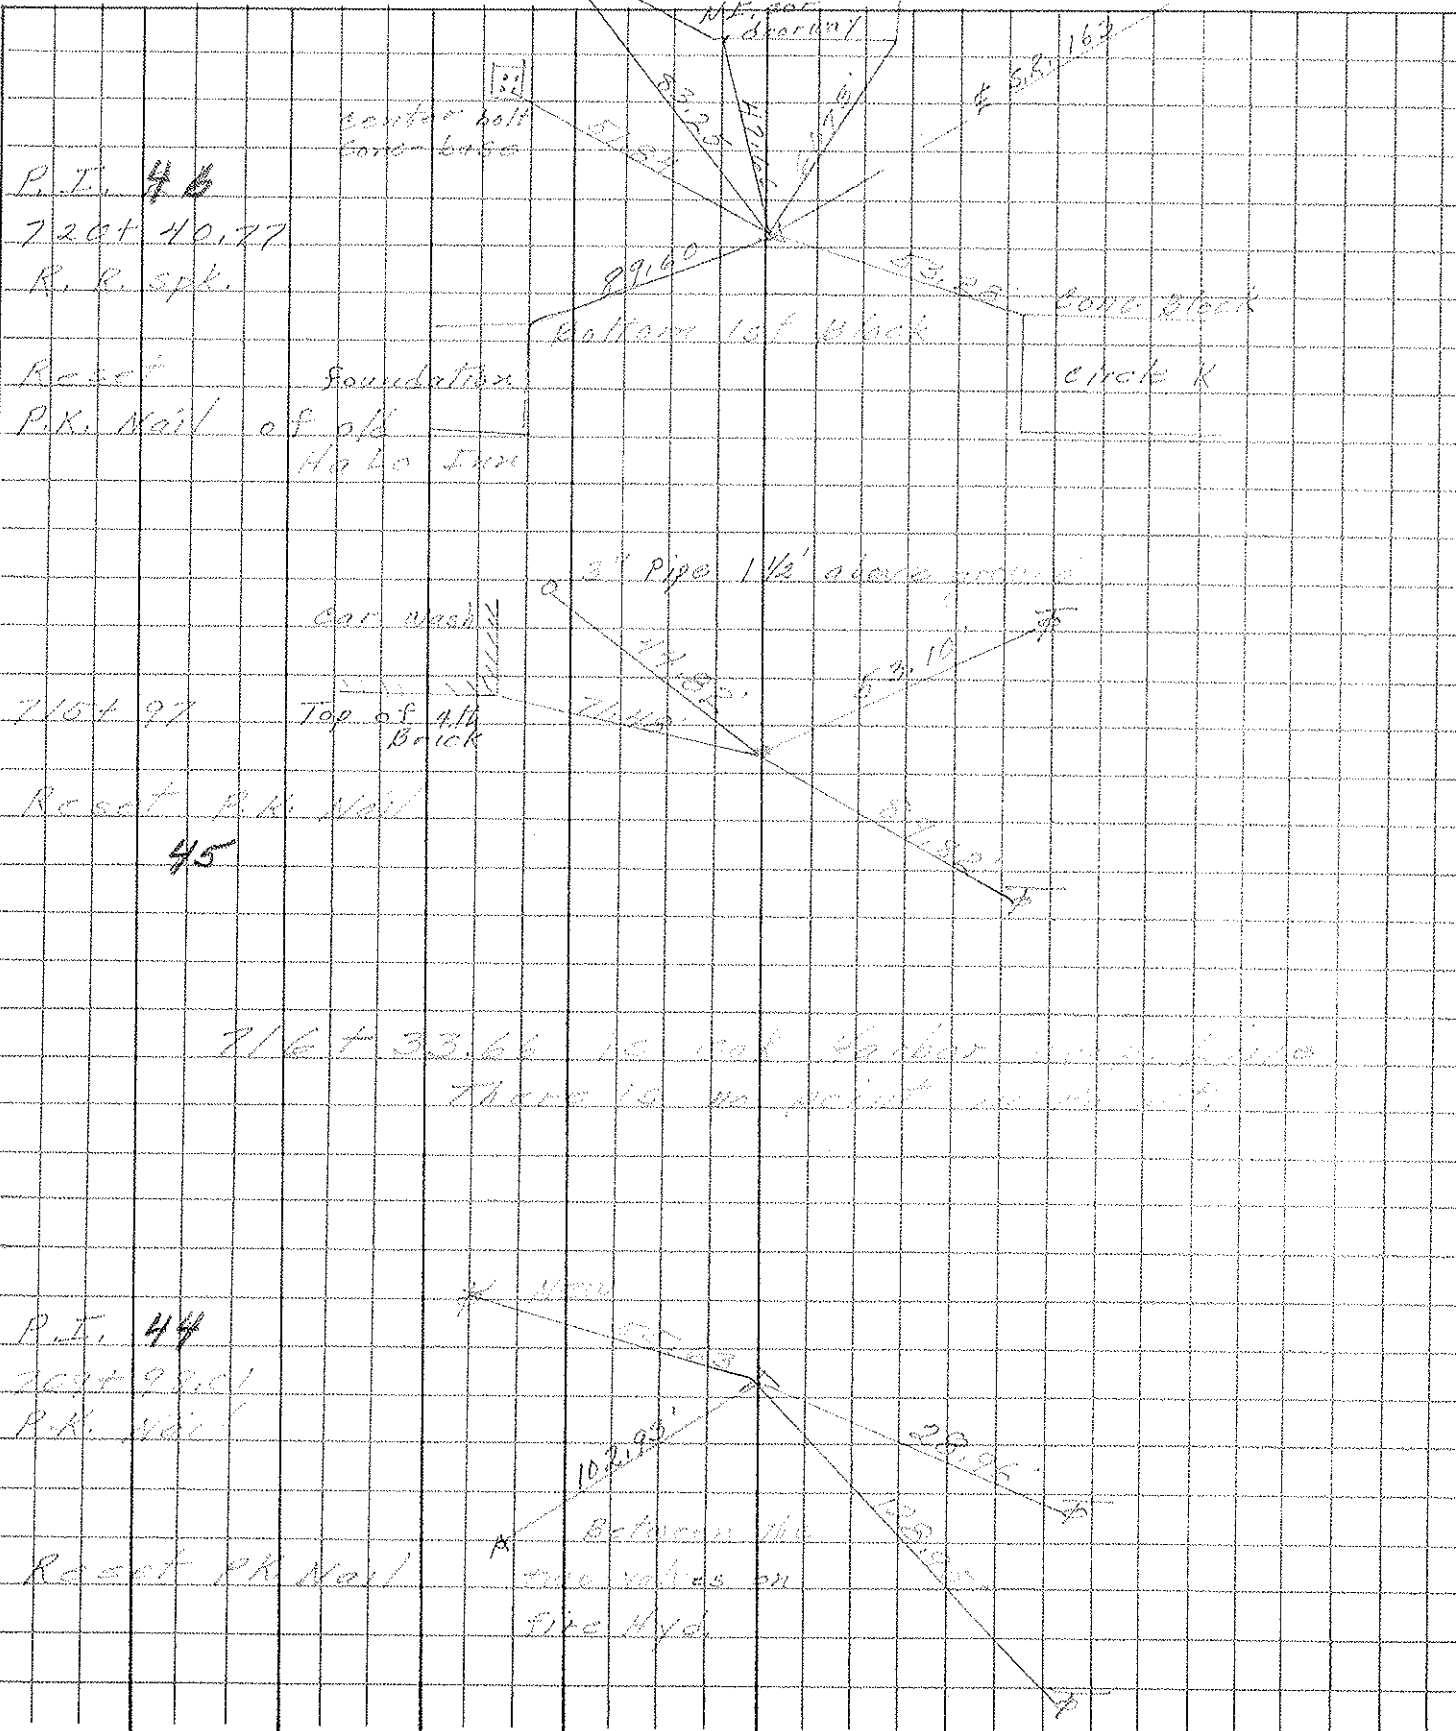

PERSONNEL TITLE PERSONNEL TITLE

COUNTY 163 DATE 11-17-66

S. R. Ottawa WEATHER

SEC. Oak Harbor TEMP. 60°

DESCRIPTION LEFT CENTER LINE RIGHT JOB NO.

DESCRIPTION	LEFT	CENTER LINE	RIGHT	JOB NO.
P.I. 720+40.97	5286	<p>N.E. cor. doorway</p> <p>N.E. cor. gas station</p> <p>83.25</p> <p>41.83</p> <p>89.57</p> <p>N.E. cor. of Foundation Restaurant</p>	<p>S.E. cor. gas station</p> <p>61.73</p> <p>S.R. 163</p> <p>5342.4</p>	
Oak Harbor Corp Limits (?)	5285	<p>1/2" above ground 2" Pipe</p> <p>44.92</p>	<p>89.84</p>	
P.I. 709+98.01 P.K. Nail	5284	<p>30.19</p>	<p>28.99</p> <p>128.89</p>	
P.I. 701+81.50 Iron Pin	5283	<p>73.97</p> <p>11.00'</p>	<p>101.63</p> <p>87.80</p> <p>N. &amp; S. in Permit</p>	

46

45

44

43

PERSONNEL	TITLE	PERSONNEL	TITLE
COUNTY		Ottawa	DATE
		163	11-17-66
S. R.		163	WEATHER
			Fair
SEC.		5 Salem Twp	TEMP.
			60°

DESCRIPTION Oak Harbor JOB NO. \_\_\_\_\_

