


O.D.O.T. DISTRICT 2 SURVEY OFFICE (USE ONLY)


PERSONNEL \_\_\_\_\_ REFERENCE NO. 51 SHEET 13 OF 74  
 NOTES MILLER DATE 1-3-19 ROUTE SR 163  
 H.C. LEU WEATHER CLOUDY COUNTY OTTAWA  
 R.C. MILLER TEMP. 32° TOWNSHIP SALEM  
 DWG BY JAMES PID 95757 SECTION 4  
 T 6 N R 15 E

TYPE MONUMENT MAG/WASHER  
 ON SURFACE - ~~BELOW~~ ON  
 OFFSET Q PAVEMENT ON LT : RT  
- TO - EDGE PAVEMENT  
 STATION: 756+81

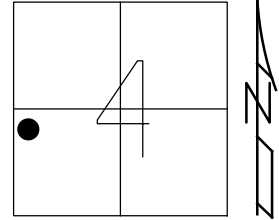

HORZ. DATUM: NAD83 2011 GEOID: NAVD88 2012A  
 GRID: NORTHING: 671369.136 EASTING: 1792268.357

RECORD:  
 FD P.K./WASHER  
 8-1-00, SAH  
 SET P.K./WASHER  
 11-29-00, SAH  
 FD P.K./WASHER  
 REF51  
 5-4-16, DCH  
 7-6-17, JLL  
 SET MAG/WASHER  
 1-3-19, JLL

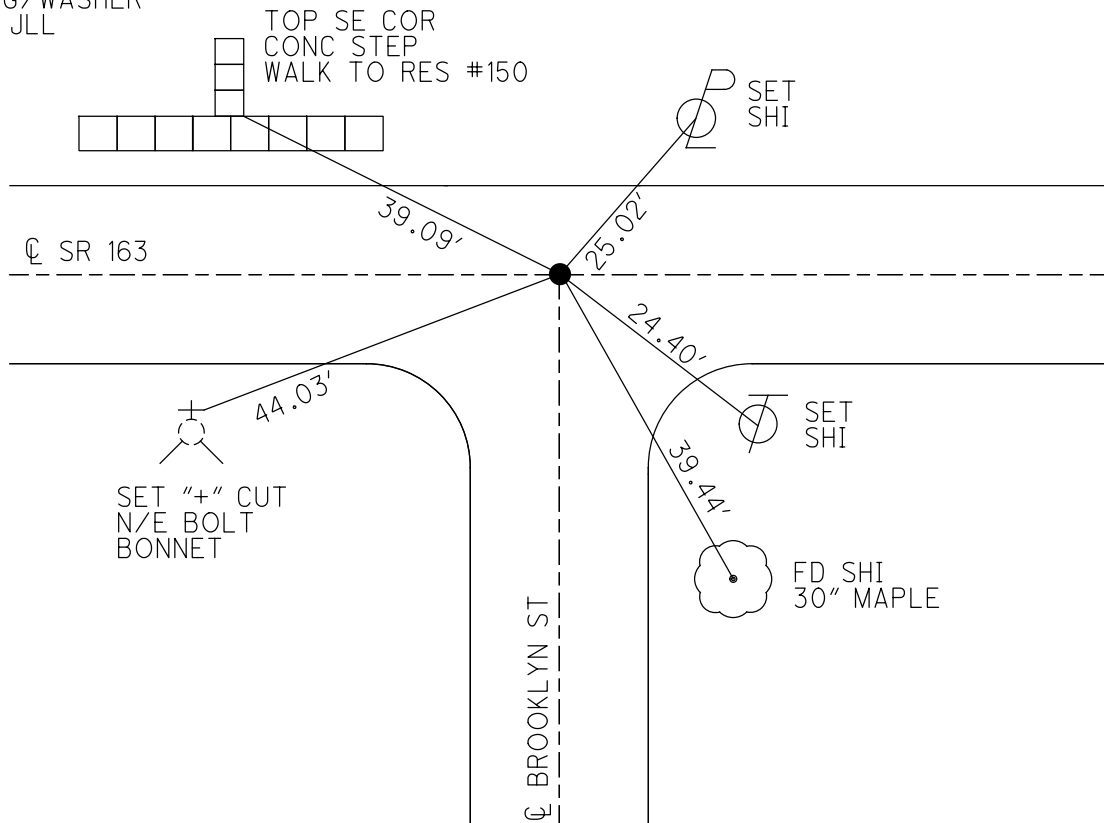

# O.D.O.T. DISTRICT 2 SURVEY OFFICE

PERSONNEL \_\_\_\_\_

REFERENCE NO. 51

SHEET 7 OF 63

NOTES Huss

H.C. Cardes

R.C. Huss

DATE 8-1-00

WEATHER Cldy-Fair

TEMP. +75°F

ROUTE SR.163

COUNTY OTTAWA

TOWNSHIP SALEM

SECTION 4

T.6 N R.15 E


TYPE MONUMENT PK/w

ON SURFACE - ~~BELOW~~ surf.


~~LEFT~~ - Q PAV'T - ~~RIGHT~~ ♀ Pav't.

TO EDGE PAVEMENT


S.L.M. 756+81

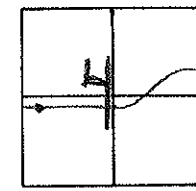

SET PK & WASHER  
 11-29-00  
 SAH

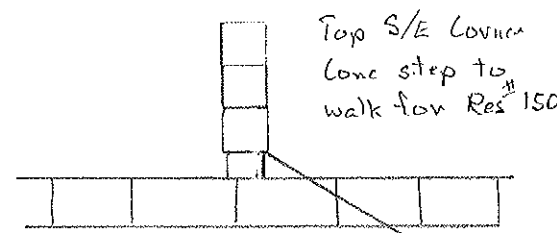

Set  
N/shi 30"  
Maple

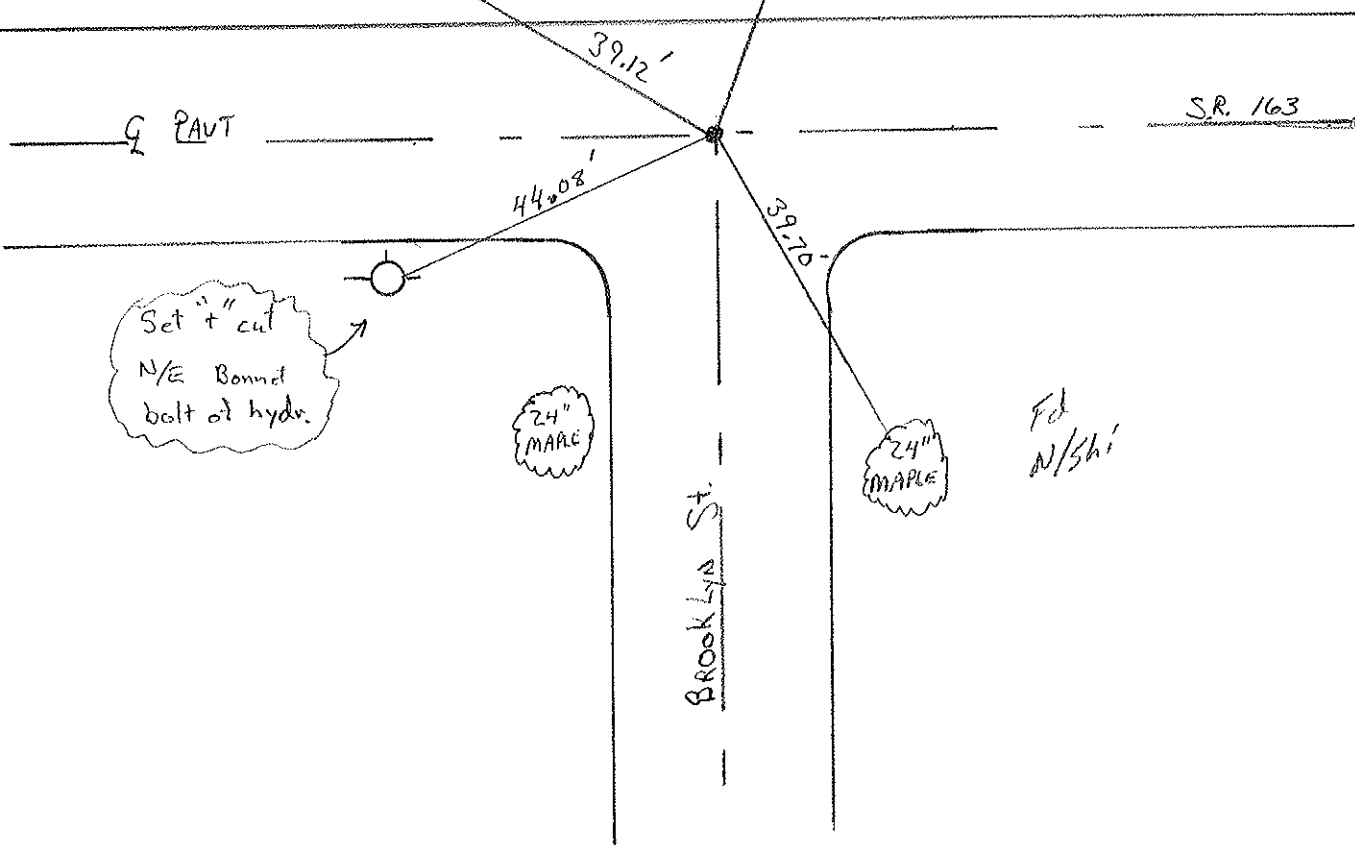

Set " cut  
 N/E Bonnet  
 bolt of hydr.

24"  
 MAPLE

24"  
 MAPLE

Ed  
N/shi

# O.D.O.T. DISTRICT 2 SURVEY OFFICE

PERSONNEL \_\_\_\_\_

REFERENCE NO. 51 SHEET 2 OF \_\_\_\_\_

NOTES Cronin

DRAWN 7/05/88

H.C. Ripple

DATE 5/24/90

R.C. BARBOUR

WEATHER Cloudy

Geyman

TEMP. 63°

ROUTE #163


COUNTY Ottawa

TOWNSHIP Salem

SECTION 4

T 6 N R 15 E

Village of Oak Harbor

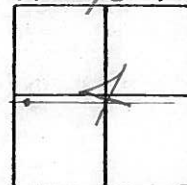


TYPE MONUMENT Set P.K. Washer

ON SURFACE - BELOW P.K. Nail

LEFT - PAV'T. - RIGHT PAV'T.

TO \_\_\_\_\_ EDGE PAVEMENT

S.L.M. \_\_\_\_\_

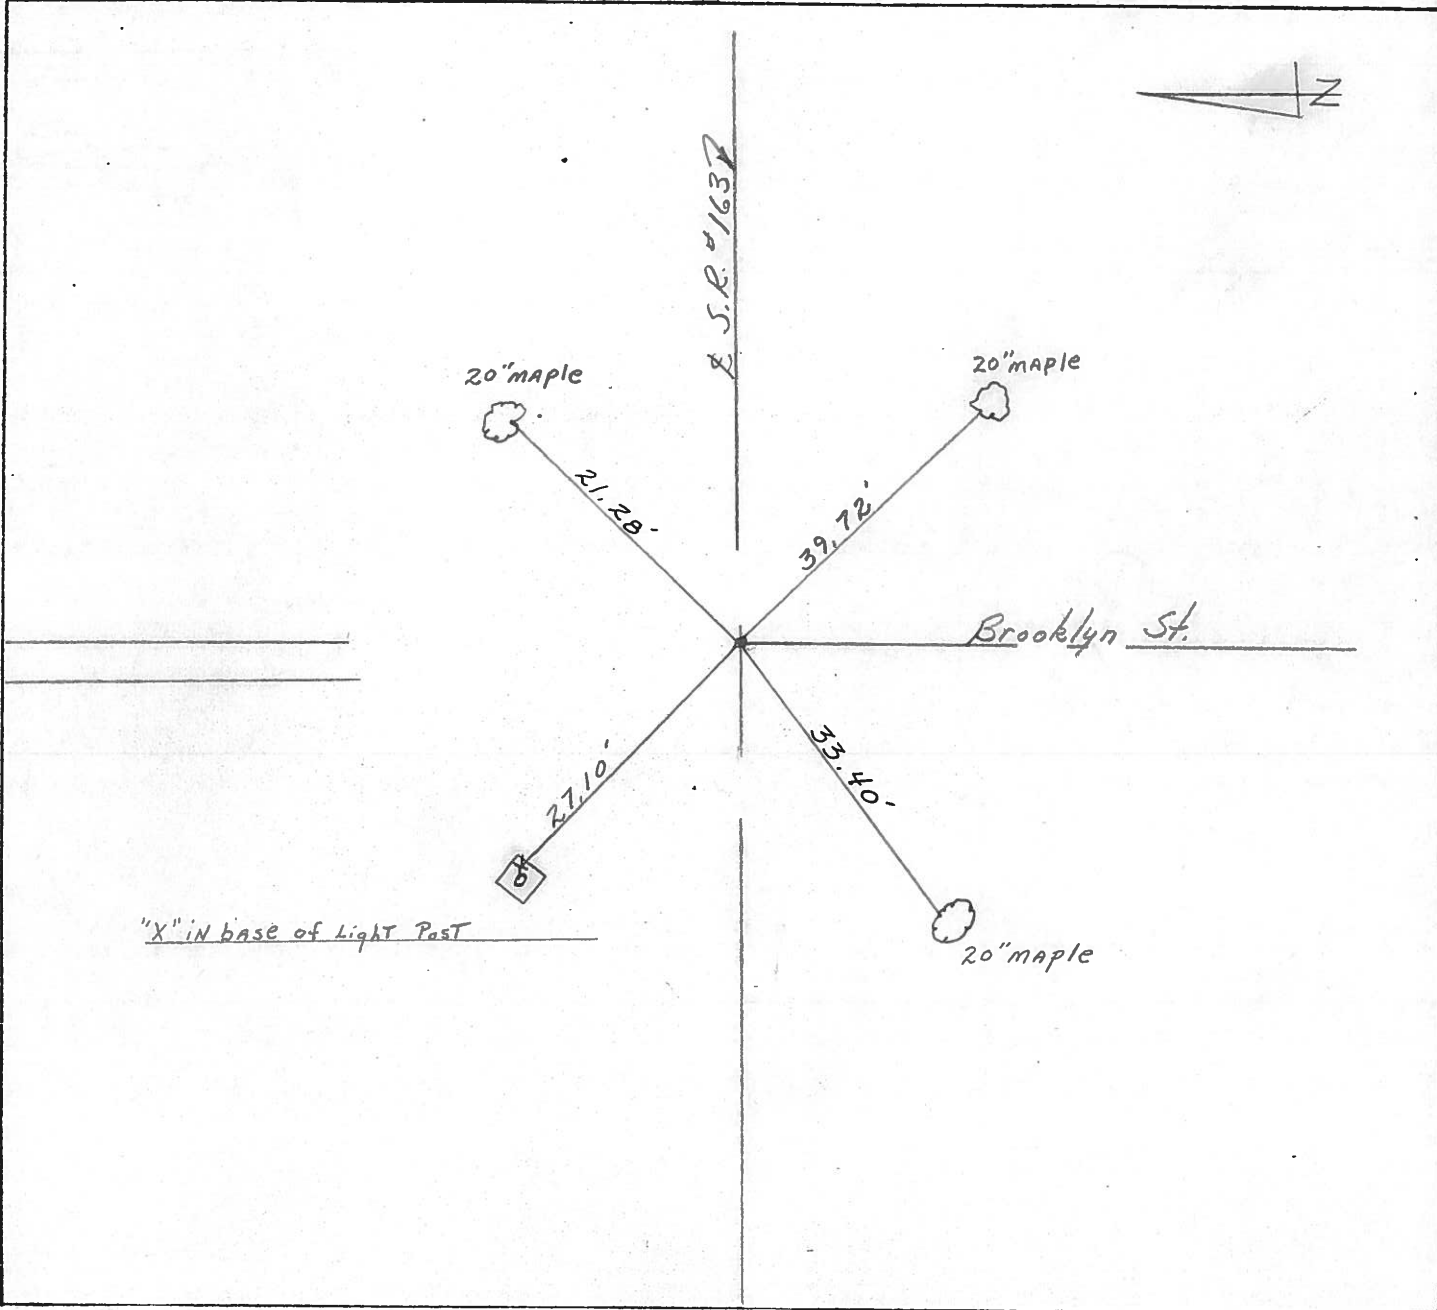

PERSONNEL TITLE PERSONNEL TITLE

COUNTY Ottawa

DATE Aug. 1968

S. R. 163

WEATHER

SEC. Oak Harbor

TEMP.


DESCRIPTION Sec 4 Salem Twp.

JOB NO.

LEFT

CENTER LINE

RIGHT

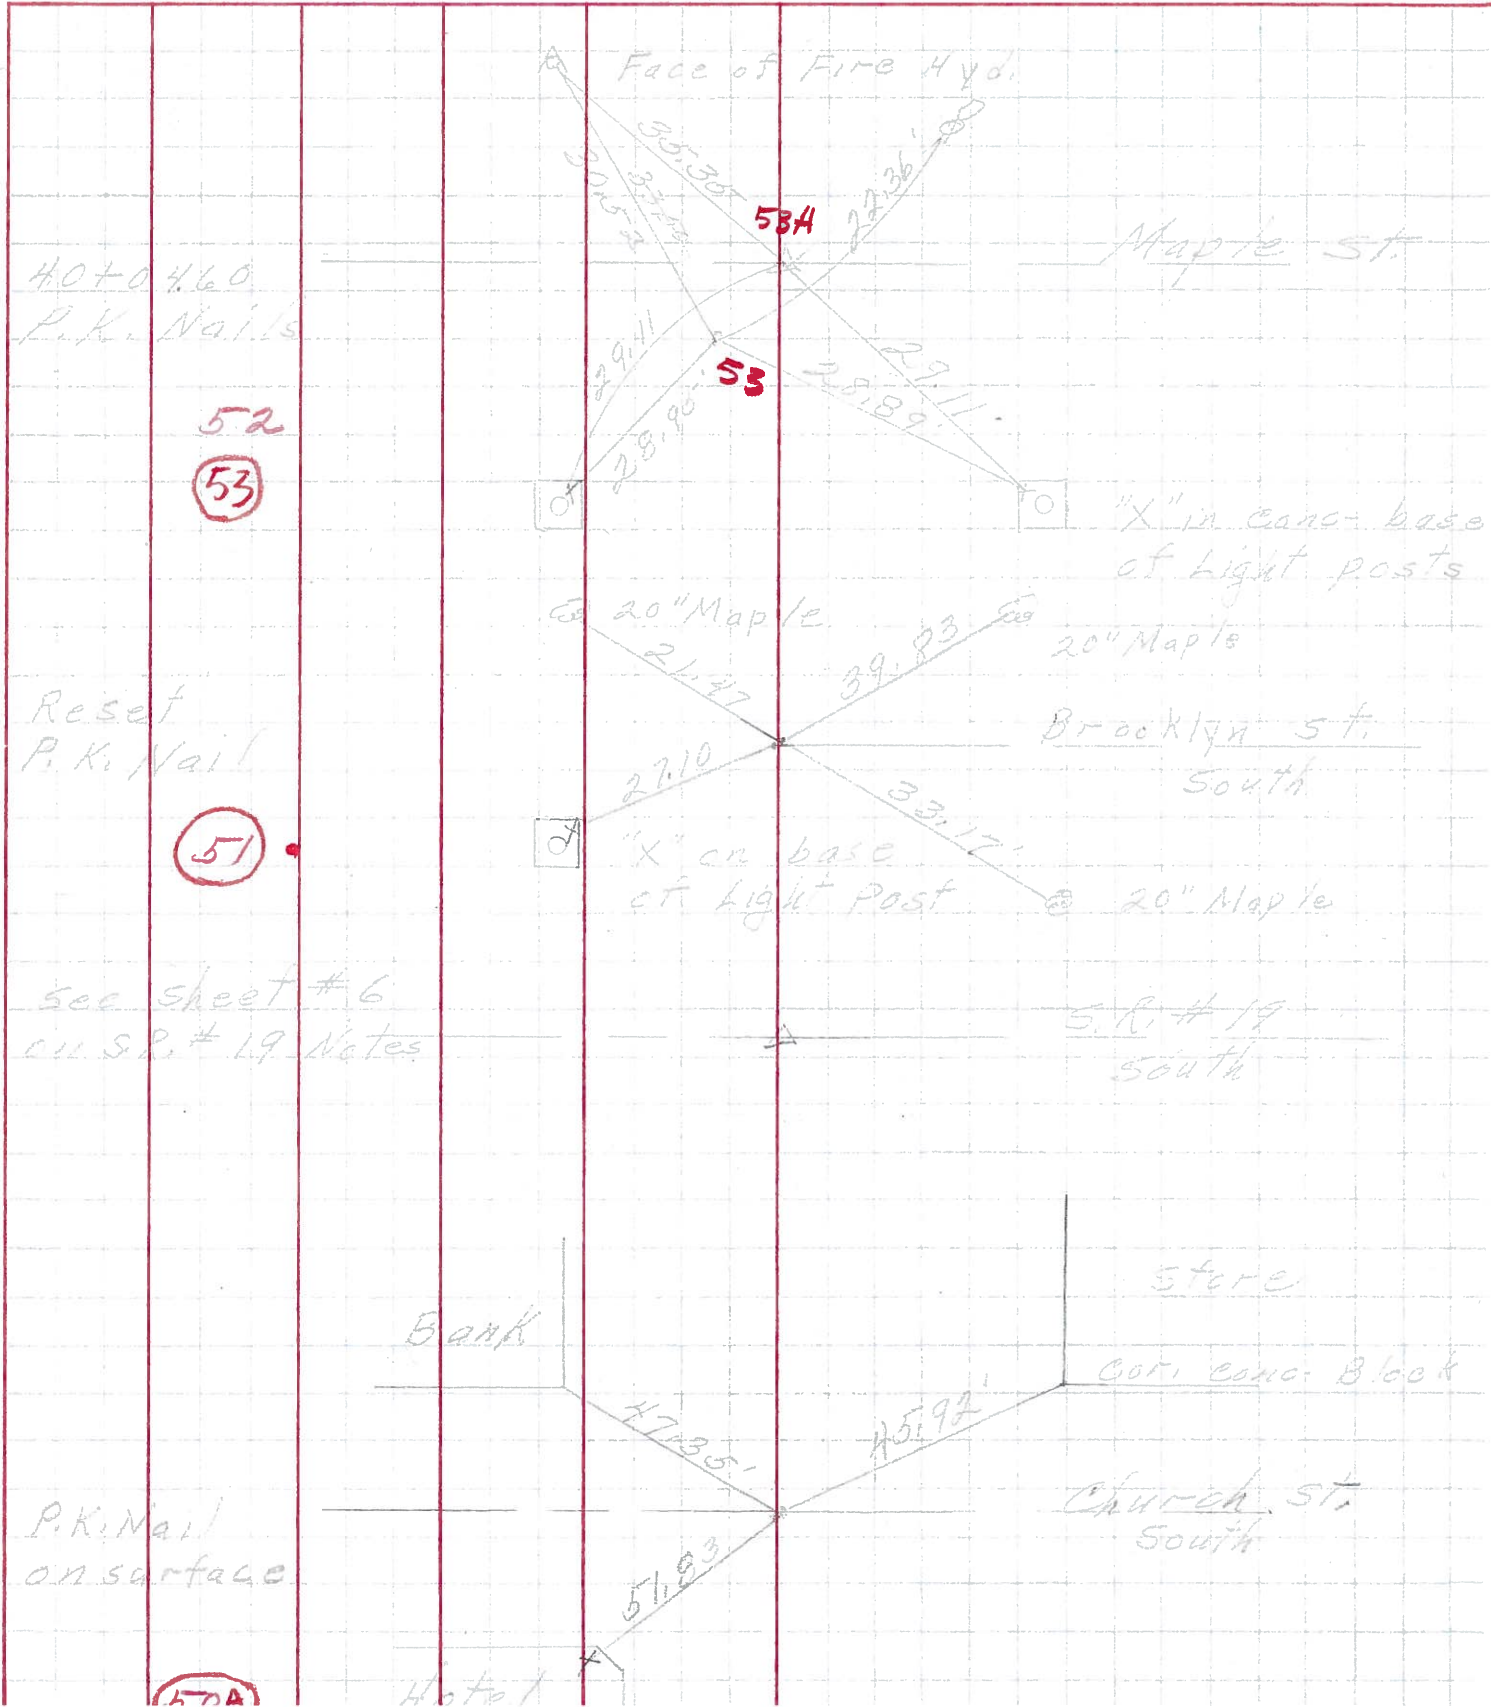

PERSONNEL TITLE PERSONNEL TITLE

COUNTY Ottawa DATE Aug. 1968

S. R. 163 WEATHER

SEC. Oak Harbor TEMP.

DESCRIPTION sec 4 Salem Twp. JOB NO.

LEFT CENTER LINE RIGHT

