

O.D.O.T. DISTRICT 2 SURVEY OFFICE

PERSONNEL _____

REFERENCE NO. 52

SHEET 8 OF 63

NOTES Huss

H.C. Cordes

R.C. Huss

DATE 8-1-00

WEATHER Cldy - Fair

TEMP. +75°F

ROUTE 163

COUNTY Ottawa

TOWNSHIP Salem

SECTION 4

T 6 N R 15 E


TYPE MONUMENT _____ PK/W

ON SURFACE - ~~BELOW~~ _____ Swf.


~~NEET~~ - Q. PAV'T. - ~~RIGHT~~ _____ Q

TO _____ EDGE PAVEMENT

S.L.M. _____ 761425

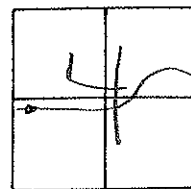

Set PK/W
11-29-00
SAH

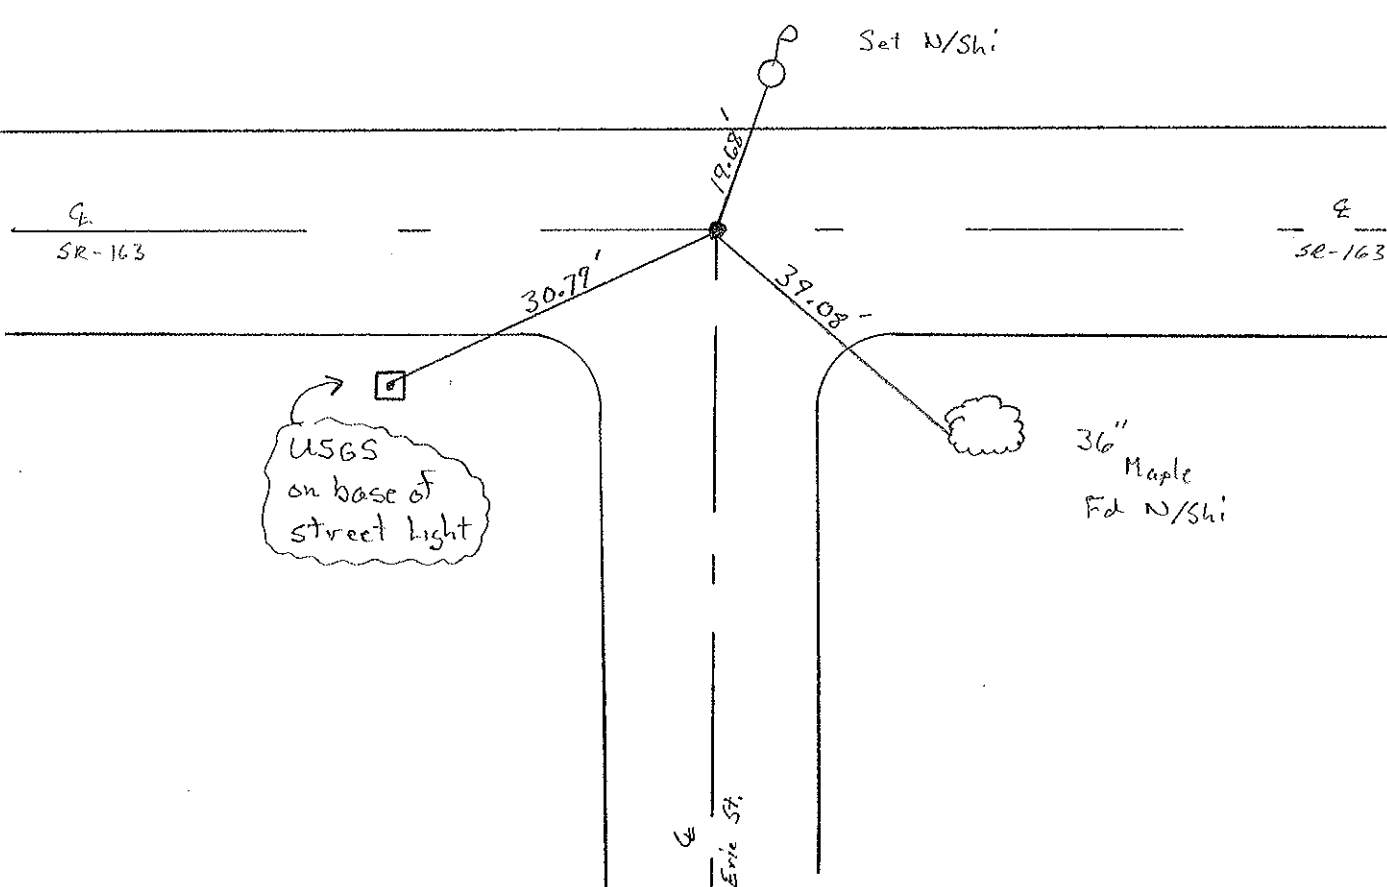

O.D.O.T. DISTRICT 2 SURVEY OFFICE

PERSONNEL _____

REFERENCE NO. 53

SHEET 3 OF _____

NOTES Cronin

DRAWN 7/05/88

H.C. Ripple

DATE 5-24-90

ROUTE #163

R.C. BARBOUR

WEATHER Cloudy

COUNTY Ottawa

GEYMAN

TEMP. 63°

TOWNSHIP Salem

SECTION 4

T 6 N R 15 6

VILLAGE OF OLK HARBOR

TYPE MONUMENT set PK + Washer



ON SURFACE - BELOW _____

LEFT - & PAV'T. - RIGHT &

_____ TO _____ EDGE PAVEMENT

S.L.M. _____

52

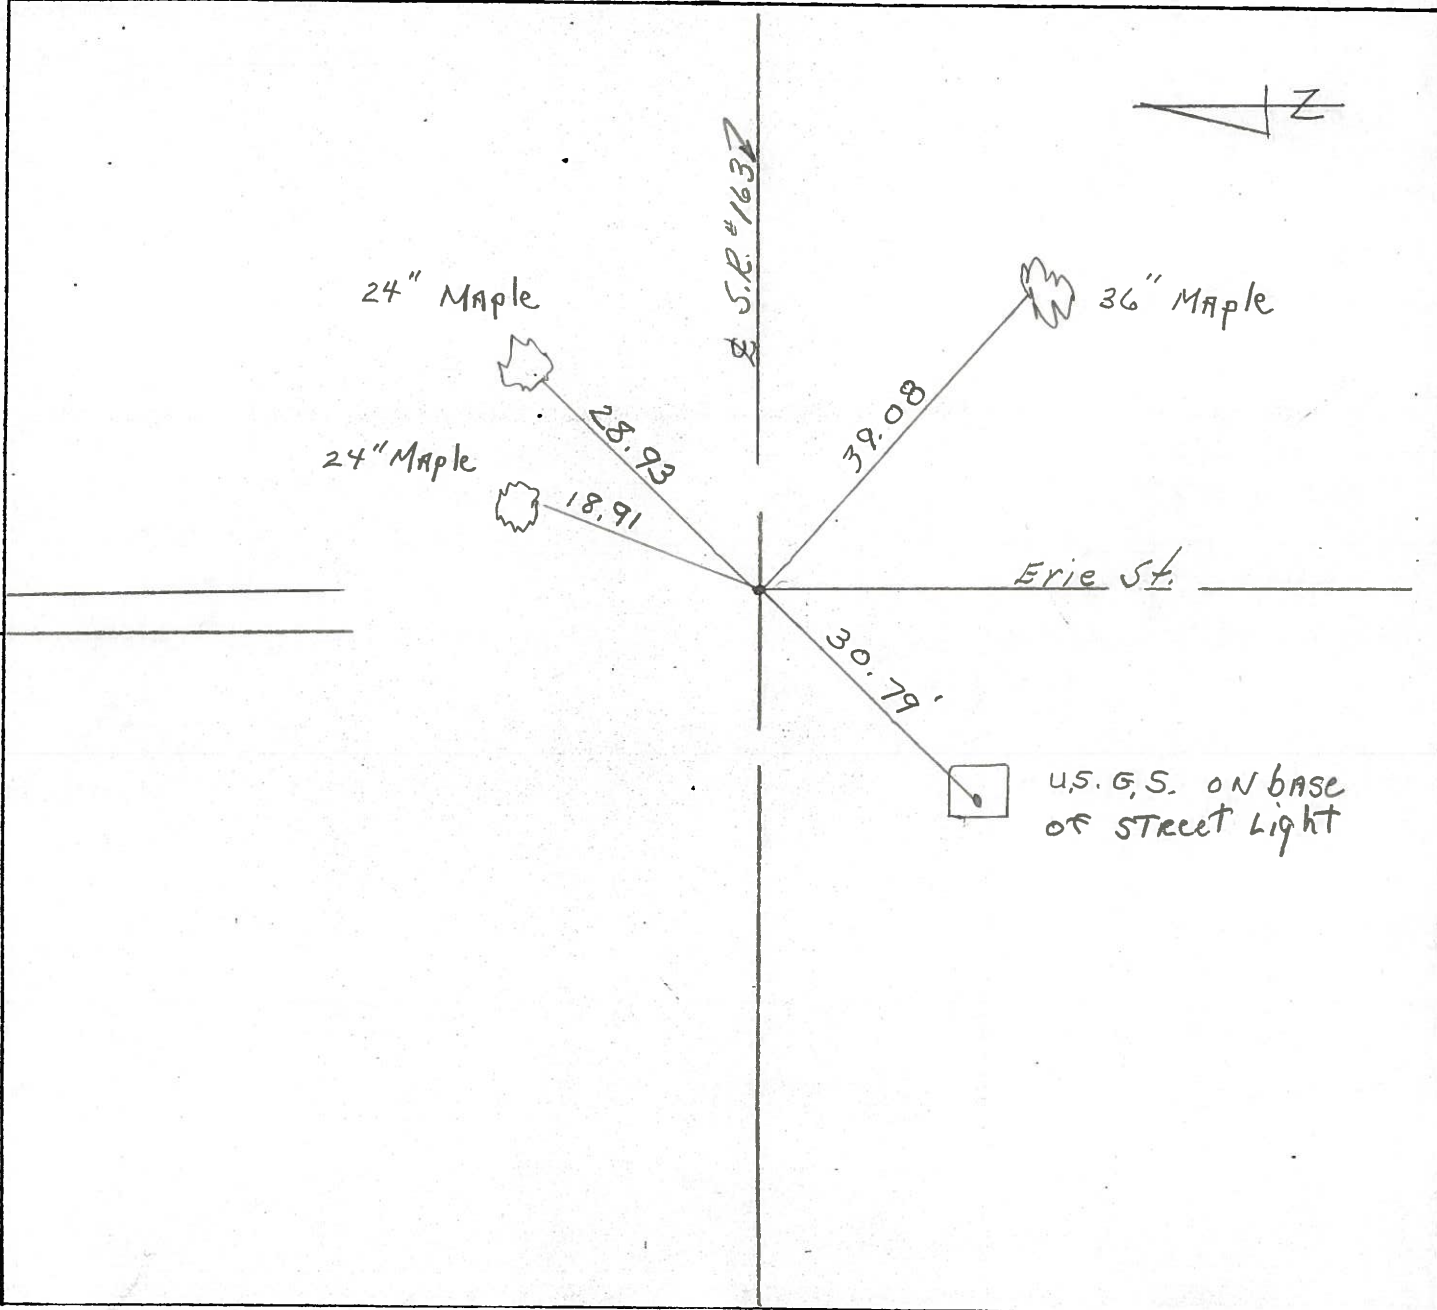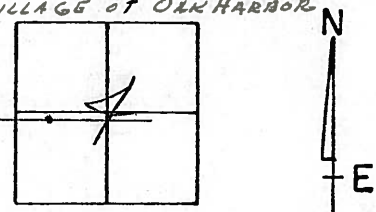

PERSONNEL TITLE PERSONNEL TITLE

COUNTY Ottawa DATE 3-11-70

S. R. 163 WEATHER Fair

SEC. Oak Harbor TEMP. 35°

DESCRIPTION Sec 4 Salem Twp. JOB NO. _____

