

O.D.O.T. DISTRICT 2 SURVEY OFFICE (USE ONLY)

PERSONNEL

REFERENCE NO. 57 A

SHEET 22 OF 74

NOTES HOMAN

DATE 7-7-17

ROUTE SR 163

H.C. LEU

WEATHER CLOUDY

COUNTY OTTAWA

R.C. CARSON

TEMP. 77°

TOWNSHIP SALEM

POORE

DWG BY JAMES

PID 95757

SECTION 4

T 6 N R 15 E

TYPE MONUMENT P.K. SHANK

ON SURFACE - ~~BELOW~~ ON

OFFSET \odot PAVEMENT 3' ~~RT~~ : RT

9.4' TO RT EDGE PAVEMENT


STATION: 781+50

HORIZ.DATUM: NAD83 2011


GEOID: NAVD88 2012A

GRID: NORTHING: 671322.456

EASTING: 1794730.55

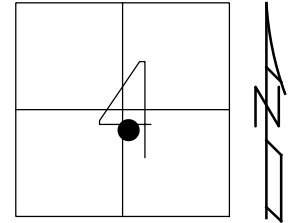

RECORD:
 FD P.K. SHANK
 8-2-00, TMR
 SET P.K./WASHER
 11-29-00, SAH
 FD P.K. SHANK
 REFB57
 5-5-16, DCH
 7-7-17, JLL
 SET MAG/WASHER
 1-4-19, JLL

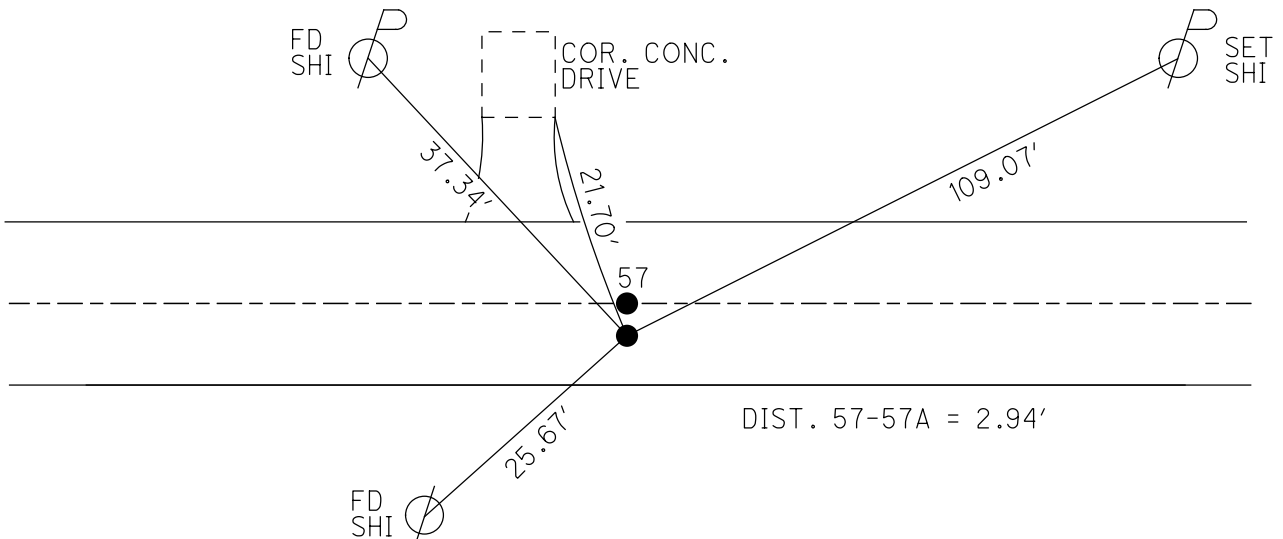

O.D.O.T. DISTRICT 2 SURVEY OFFICE

PERSONNEL _____

REFERENCE NO. 57

SHEET 13 OF 63

NOTES Cord es

H.C. Rousos

R.C. Kangren

DATE 8-2-00

WEATHER Sunny

TEMP. 78°

ROUTE 163

COUNTY Ottawa

TOWNSHIP Salem

SECTION 4

T 6 N R 15 E


TYPE MONUMENT (A) PK/W (B) PK-Shank

(ON SURFACE) - BELOW Surf.

LEFT - ⊖ PAV'T. - RIGHT (A) ⊕ (B) -3' RT


(A) 12.9 TO RT. EDGE PAVEMENT (B) 9.4' to RT EOP

S.L.M. 781+50

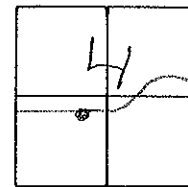

Record: PI - Sta 55+78.66
 & Survey (6-1-47 R/W Plan)

Set PK/W
 11-29-00
 SAH
 both points

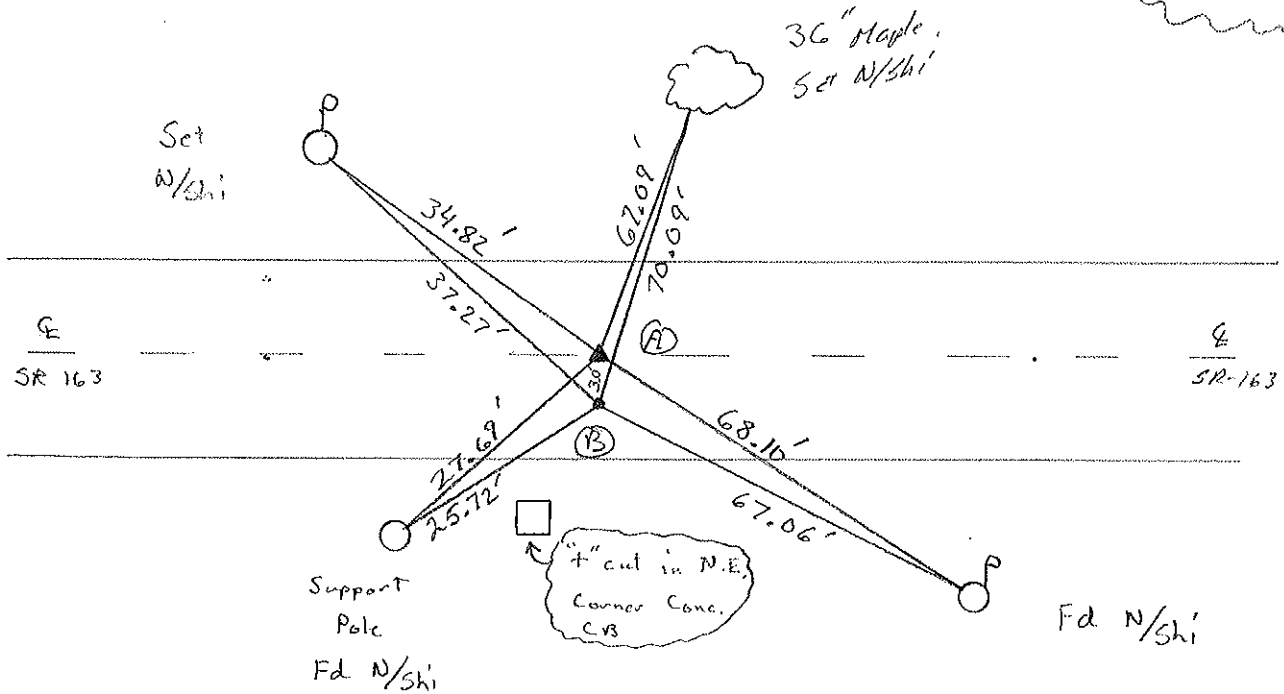

Distance
 between
 Points A-B
 3.0'

O.D.O.T. DISTRICT 2 SURVEY OFFICE

PERSONNEL _____

REFERENCE NO. _____

SHEET 1 OF 5

NOTES CHEKIEY

H.C. RIPPLE

DATE 11-23-1992

ROUTE 163

R.C. BARBOUR

WEATHER CLOUDY

COUNTY OTAWA

GEYMAN

TEMP. 40°

TOWNSHIP SALEM

SECTION 4

T. 6 N. R. 15 E

TYPE MONUMENT PK / WASHER


ON SURFACE - BELOW

~~LEFT~~ - PAV'T. - RIGHT

TO EDGE PAVEMENT

S.L.M. _____

57

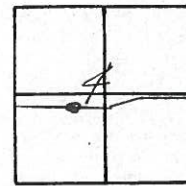

REF. STA. 55+78.66 E. SURVEY (6-1-1947 R/W PLAN)

SET ATOP 4" FOUND IN OLD BRICK PAV'T. 0.8'± BELOW SURFACE

