

O.D.O.T. DISTRICT 2 SURVEY OFFICE (USE ONLY)

PERSONNEL

REFERENCE NO. 95

SHEET 65 OF 74

NOTES HOMAN

DATE 7-27-17

ROUTE SR 163

H.C. LEU

WEATHER CLOUDY, FAIR

COUNTY OTTAWA

R.C. CARSON

TEMP. 78°

TOWNSHIP ERIE

SECTION 5

DWG BY JAMES PID 95757

T 7 N R 16 E

TYPE MONUMENT P.K./WASHER

~~ON SURFACE~~ - BELOW 4"

OFFSET  $\odot$  PAVEMENT 5.3' LT : ~~RT~~

5.7' TO LT EDGE PAVEMENT


STATION: 1015+19

HORZ.DATUM: NAD83 2011


GEOID: NAVD88 2012A

GRID: NORTHING: 674202.460

EASTING: 1817277.063

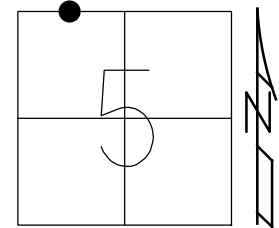

RECORD:  
 FD P.K./WASHER  
 8-9-00, SAH  
 SET P.K./WASHER  
 6-7-01, SAH  
 FD P.K./WASHER  
 4" DOWN  
 REF95  
 7-27-17, JLL  
 SET MAG/WASHER  
 1-15-19, JLL

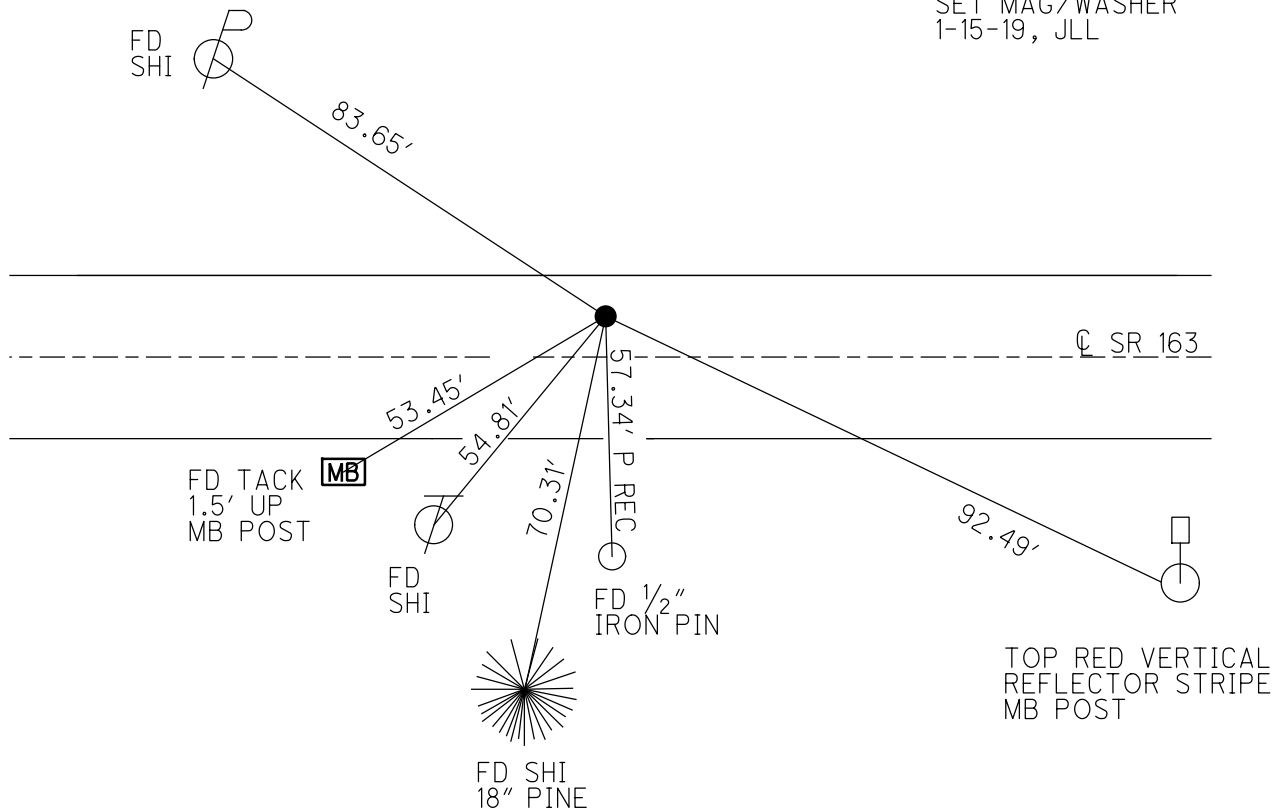

# O.D.O.T. DISTRICT 2 SURVEY OFFICE

PERSONNEL

REFERENCE NO. 95

SHEET 54 OF 63

NOTES Huss

H.C. Condes

R.C. Karger

DATE 8-9-00

WEATHER Clay-Fair

TEMP. +77°F

ROUTE SR-163

COUNTY OHawa

TOWNSHIP Eric

SECTION 5

T 7 N R 16 E


TYPE MONUMENT PK/W

~~ON SURFACE~~ - BELOW 4" below

LEFT - ~~RIGHT~~ 5.3 Lt.


5.7 TO Lt. EDGE PAVEMENT

S.L.M. 1015 + 19

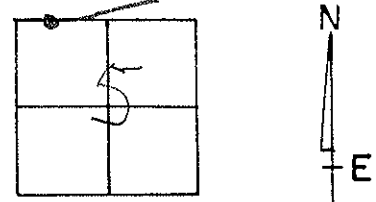

REWARD:  
959 +

SET PR& WASHER  
6-7-01  
SAH

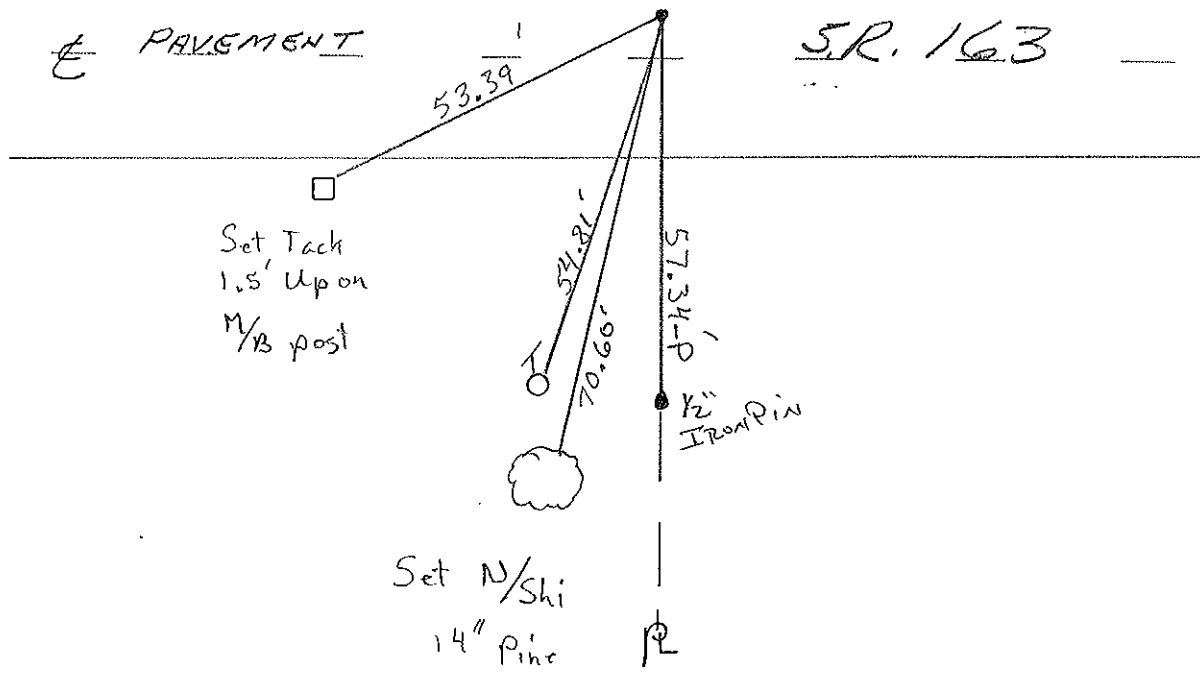

O.D.O.T. DISTRICT 2 SURVEY OFFICE

PERSONNEL

REFERENCE NO. 95

SHEET 46 OF     

NOTES Ripple

H.C. BARBOUR

DATE 9/28/90 <sup>DRAWN</sup> 12/07/90

ROUTE SR#163

R.C. Geyman

WEATHER Cloudy

COUNTY OTTAWA

TEMP. 65°

TOWNSHIP ERIE

SECTION 5

T. 7 N. R. 16 E.



TYPE MONUMENT Dig when needed

ON SURFACE - BELOW P.K. Nail

LEFT - & PAV'T. - RIGHT 5.7' LT. & Pavm't.

     TO      EDGE PAVEMENT

S.L.M. 959+-

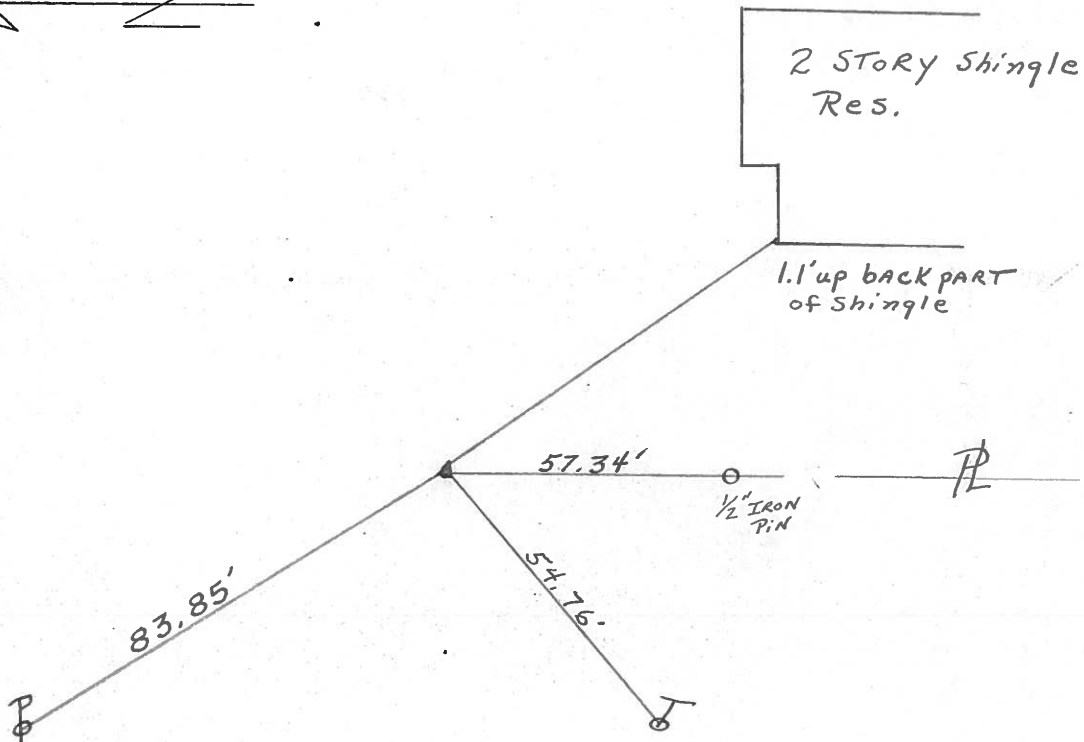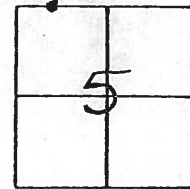

PERSONNEL TITLE PERSONNEL TITLE


COUNTY Ottawa DATE March 1972

S. R. 163 WEATHER \_\_\_\_\_

SEC. Oak Harbor East TEMP. \_\_\_\_\_

DESCRIPTION Sec 5 Erie Twp. JOB NO. \_\_\_\_\_

LEFT CENTER LINE RIGHT

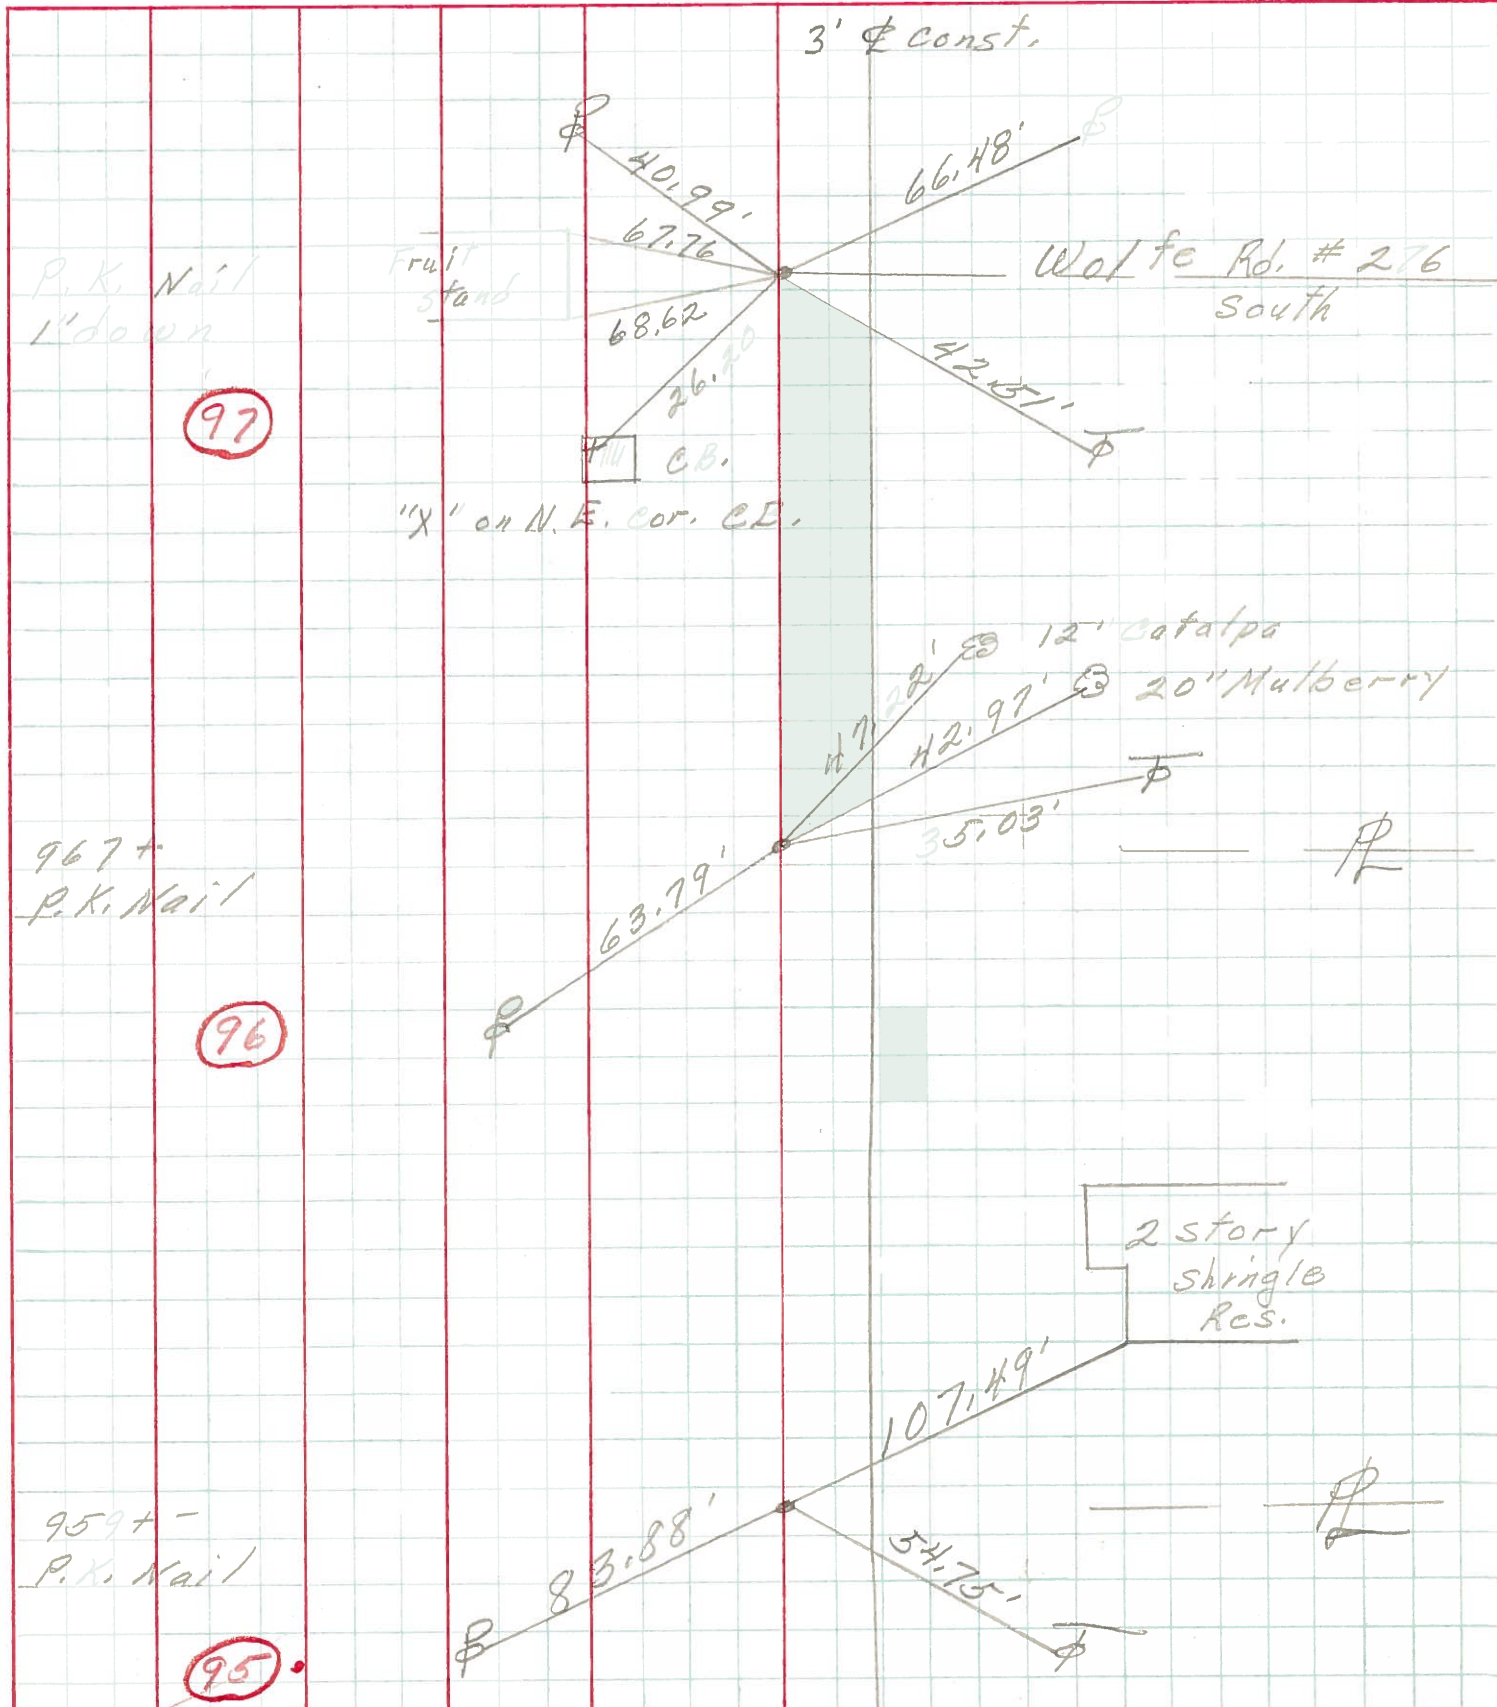

PERSONNEL TITLE PERSONNEL TITLE COUNTY Ottawa DATE 9-3-68  
Schneider Potts  
Masser  
Barbour S. R. 163 WEATHER Fair  
Redding SEC. Oak Harbor-East TEMP. 72°

DESCRIPTION Ties for Control Points 12" cat. log RIGHT JOB NO.

