


O.D.O.T. DISTRICT 2 SURVEY OFFICE (USE ONLY)


PERSONNEL \_\_\_\_\_ REFERENCE NO. 110 SHEET 3 OF 14  
 NOTES CANTERBURY DATE 6/16/09 ROUTE SR 163  
 H.C. HUSS WEATHER FAIR COUNTY OTTAWA  
 R.C. CANTERBURY TEMP. 77° TOWNSHIP ERIE  
 \_\_\_\_\_ SECTION 34  
 \_\_\_\_\_ T 7 N R 16 E

TYPE MONUMENT MON BOX  
 ON SURFACE - ~~BELOW~~ ON  
 LEFT - ☉ PAV'T - ~~RIGHT~~ 2.2'  
7.5' TO LT EDGE PAVEMENT  
 S.L.M. 1152+90  
 GRID: NORTHING: 675052.719 EASTING: 1831069.702

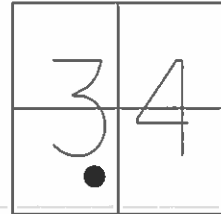

FD MON.BOX  
 STA. 161+86 PLAN  
 GPS, SV110  
 6/16/09, SAH


NOTE:  
 DID NOT OPEN LID.  
 DIST. TO CTR. OF LID.

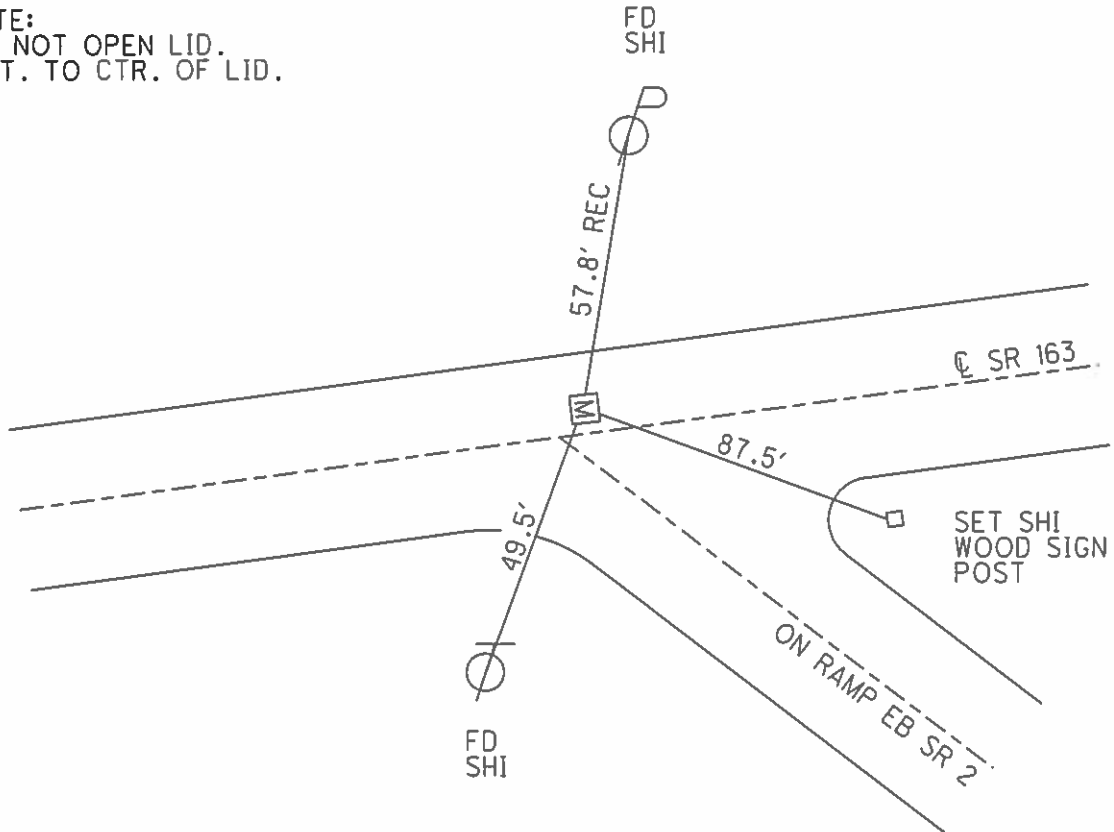

O.D.O.T. DISTRICT 2 SURVEY OFFICE (USE ONLY)


PERSONNEL \_\_\_\_\_ REFERENCE NO. 110 SHEET 3 OF 14  
 NOTES CANTERBURY DATE 6/16/09 ROUTE SR 163  
 H.C. HUSS WEATHER FAIR COUNTY OTTAWA  
 R.C. CANTERBURY TEMP. 77° TOWNSHIP ERIE  
 \_\_\_\_\_ SECTION 34  
 \_\_\_\_\_ T 7 N R 16 E

TYPE MONUMENT MON.BOX  
 ON SURFACE - ~~BELOW~~ ON \_\_\_\_\_  
 LEFT - ☉ PAV'T - ~~RIGHT~~ 2.2'  
7.5' TO LT EDGE PAVEMENT  
 S.L.M. 1152+90, (161+86 PLAN)  
 Grid: Northing: 675052.719 Easting: 1831069.702

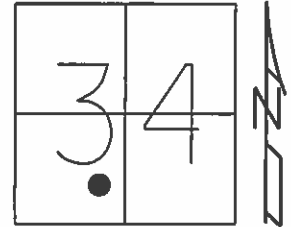

FD MON.BOX  
 GPS, SV110  
 6/16/09, SAH

NOTE:  
 DID NOT OPEN LID.  
 DIST. TO CTR. OF LID.

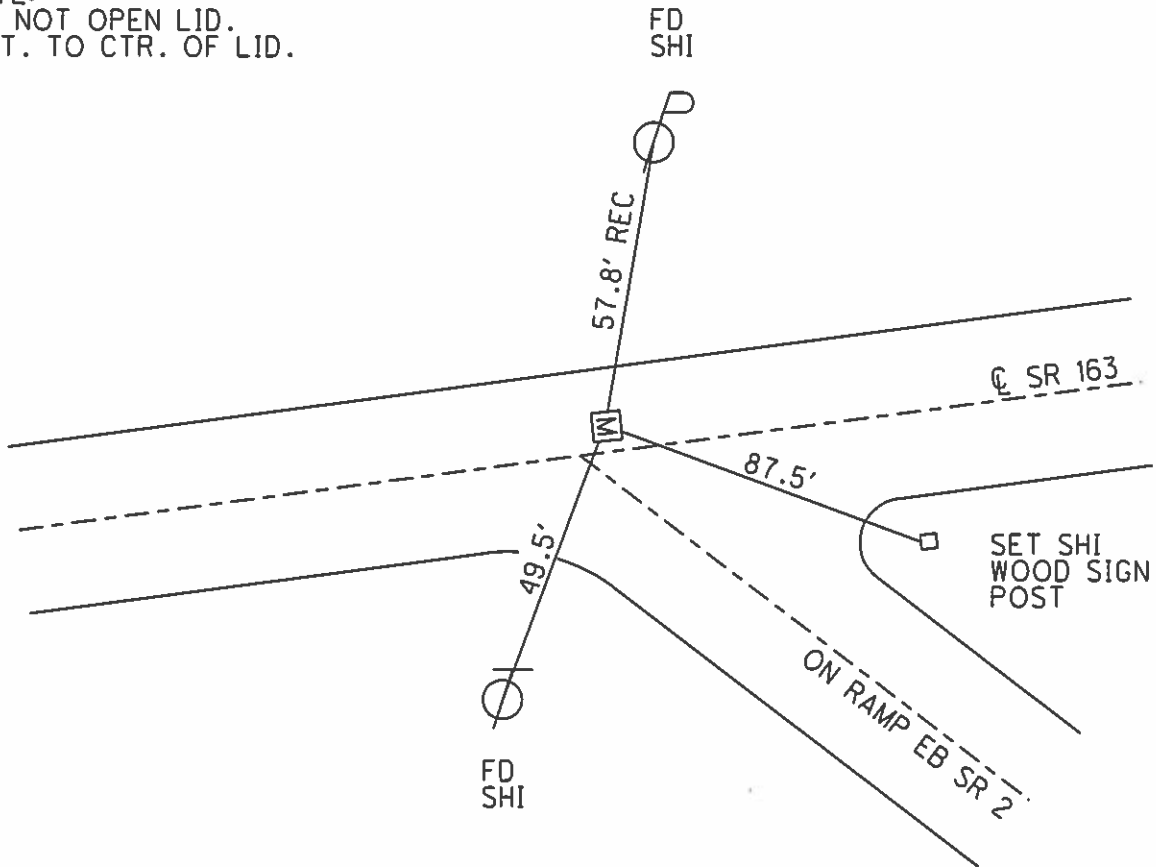

O.D.O.T. DISTRICT 2 SURVEY OFFICE

PERSONNEL

REFERENCE NO. 110

SHEET 3 OF 16

NOTES LOEHRKE

H.C. RAISOS

R.C. CANTERBURY

DATE 9-2-95

WEATHER FAIR

TEMP. +85

ROUTE S.R. 163

COUNTY OTTAWA

TOWNSHIP ERIC

SECTION 34

T 7 N R 16 E

TYPE MONUMENT MON BOX



RAISED 7-8-96

~~ON SURFACE~~ - BELOW 4"

LEFT - C PAV'T. - RIGHT 2.2'

7.9 TO LT EDGE PAVEMENT

S.L.M. 1152+90

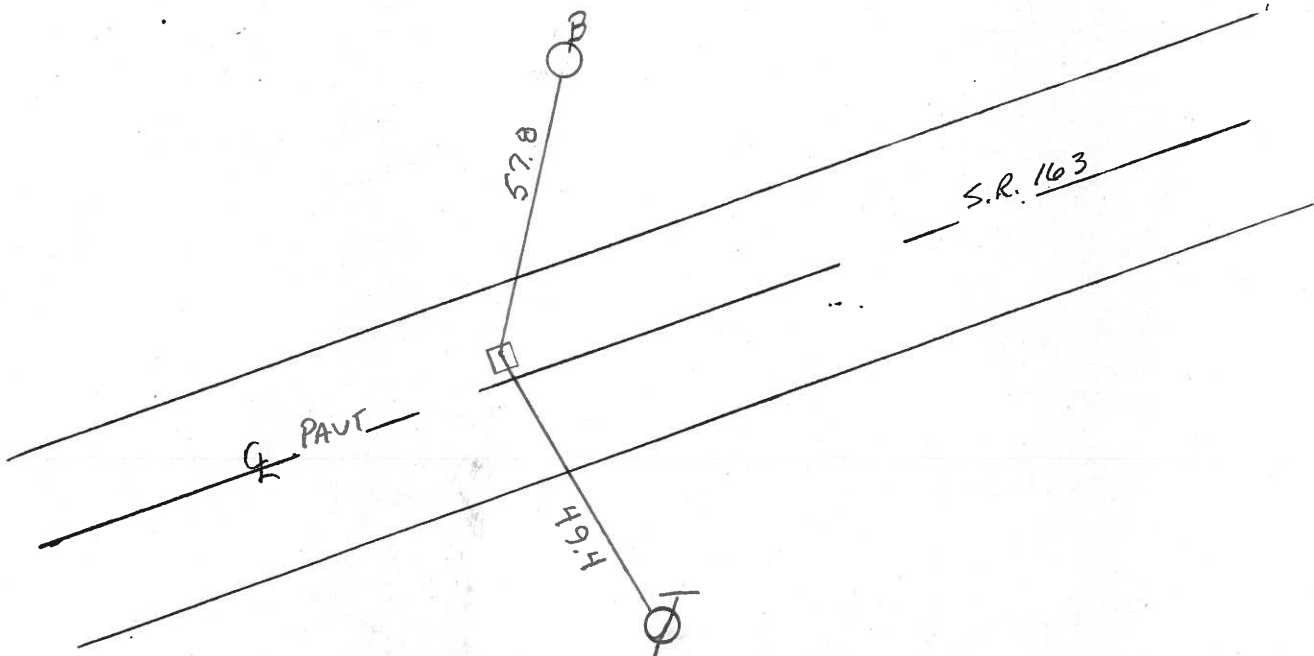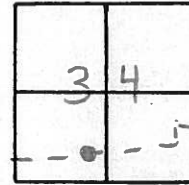

O.D.O.T. DISTRICT 2 SURVEY OFFICE

PERSONNEL

REFERENCE NO. 110

SHEET \_\_\_ OF \_\_\_

NOTES CROWIN

H.C. RIPPLE

R.C. BARBOUR

GEYMAN

DATE 9/11/85

WEATHER SUNNY

TEMP. 65°

ROUTE #163

COUNTY OTTAWA

TOWNSHIP ERIE

SECTION 34

T 7 N R 16 E


TYPE MONUMENT Mon. Box

ON SURFACE - BELOW BELOW SURFACE


LEFT - Q PAV'T. - RIGHT 3' LT. & PAVT

TO EDGE PAVEMENT

S.L.M. \_\_\_\_\_

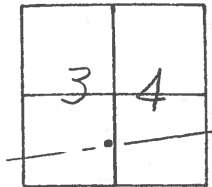

1153+03?  
ctr. of Mon. Box

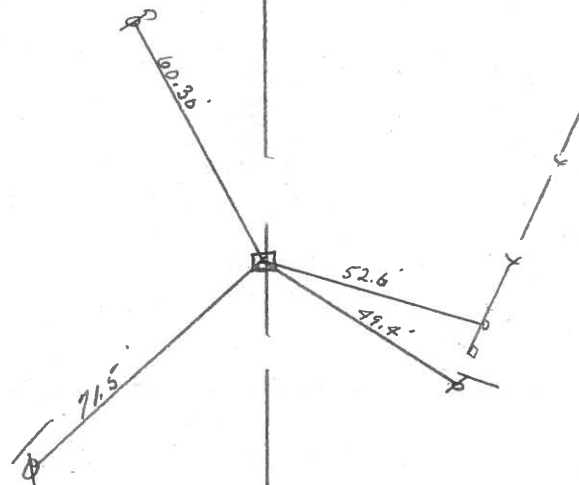

| PERSONNEL | TITLE | PERSONNEL | TITLE |
|-----------|-------|-----------|-------|
|           |       |           |       |
|           |       |           |       |
|           |       |           |       |

COUNTY Ottawa DATE 5-8-69  
 S. R. 163 WEATHER Cloudy-windy  
 SEC. 34 TEMP. 60°

DESCRIPTION Erie Twp. JOB NO. \_\_\_\_\_

