


O.D.O.T. DISTRICT 2 SURVEY OFFICE (USE ONLY)


PERSONNEL _____ REFERENCE NO. 111 SHEET 4 OF 14
 NOTES CANTERBURY DATE 6/16/09 ROUTE SR 163
 H.C. HUSS WEATHER FAIR COUNTY OTTAWA
 R.C. CANTERBURY TEMP. 78° TOWNSHIP ERIE
 _____ SECTION 34
 _____ T 7 N R 16 E

TYPE MONUMENT MON BOX
 ON SURFACE - ~~BELOW~~ ON
 LEFT - ☉ PAV'T - ~~RIGHT~~ 4.8'
5.8' TO LT EDGE PAVEMENT
 S.L.M. 1155+40

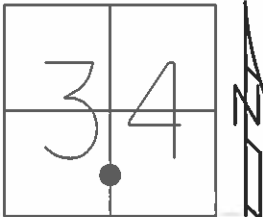

GRID: NORTHING: 675081.833 EASTING: 1831323.345


FD MON.BOX
 STA. 164+42 PLAN
 GPS, SV111
 6/16/09, SAH

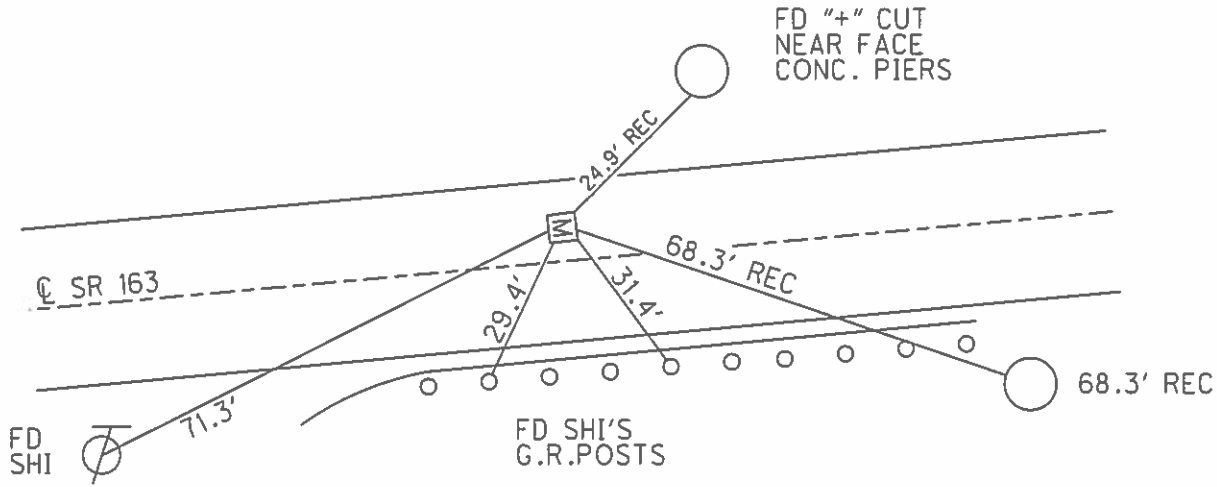


O.D.O.T. DISTRICT 2 SURVEY OFFICE (USE ONLY)

PERSONNEL _____ REFERENCE NO. 111 SHEET 4 OF 14
 NOTES CANTERBURY DATE 6/16/09 ROUTE SR 163
 H.C. HUSS WEATHER FAIR COUNTY OTTAWA
 R.C. CANTERBURY TEMP. 78° TOWNSHIP ERIE
 _____ SECTION 34
 _____ T 7 N R 16 E

TYPE MONUMENT MON.BOX
 ON SURFACE - ~~BELOW~~ ON _____
 LEFT - ☉ PAV'T - ~~RIGHT~~ 4.8'
5.8' TO LT EDGE PAVEMENT
 S.L.M. 1155+40, (164+42 PLAN)
 Grid: Northing: 675081.833 Easting: 1831323.345

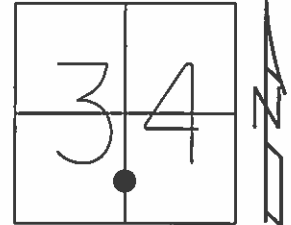

FD MON.BOX
 GPS, SV111
 6/16/09, SAH

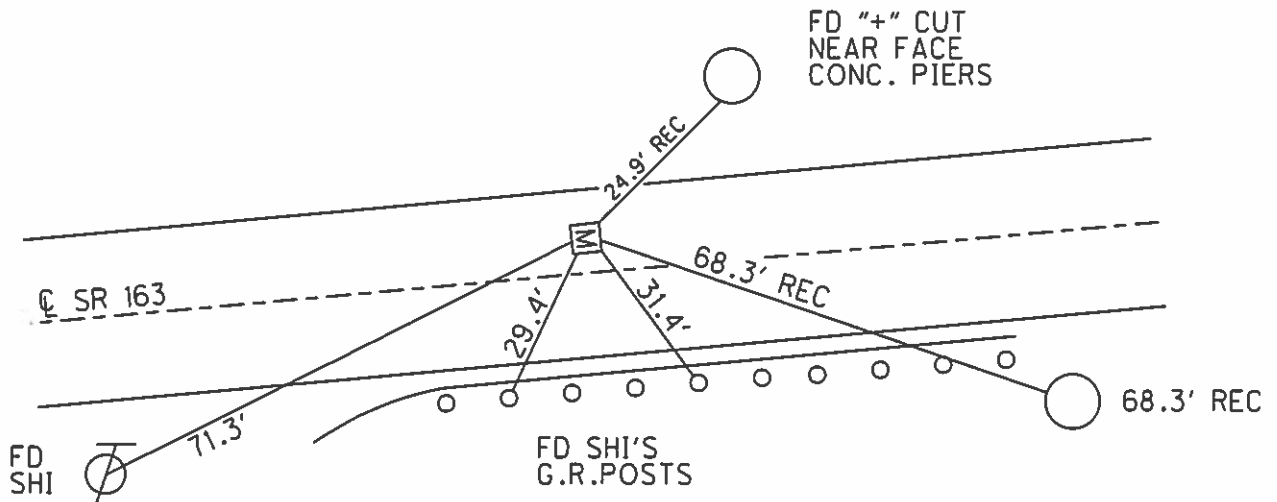

O.D.O.T. DISTRICT 2 SURVEY OFFICE

PERSONNEL _____

REFERENCE NO. 111 & 112

SHEET 4 OF 16

NOTES Loehrke

H.C. Rausos

R.C. CANTERBURY

DATE 9-2-95

WEATHER FAIR

TEMP. + 85°

ROUTE S.R. 163

COUNTY OTTAWA

TOWNSHIP ERIC

SECTION 34

T 7 N R 16 E

TYPE MONUMENT A - Mon Boxes



ON SURFACE - BELOW 4"

LEFT - & PAVT. - RIGHT 4.8' Lt / 3' Lt

S.B. TO Lt EDGE PAVEMENT

S.L.M. 1155+40 / 1156+30

A - RAISED
B - Set 3/4" Rod in Concrete
7-8-96

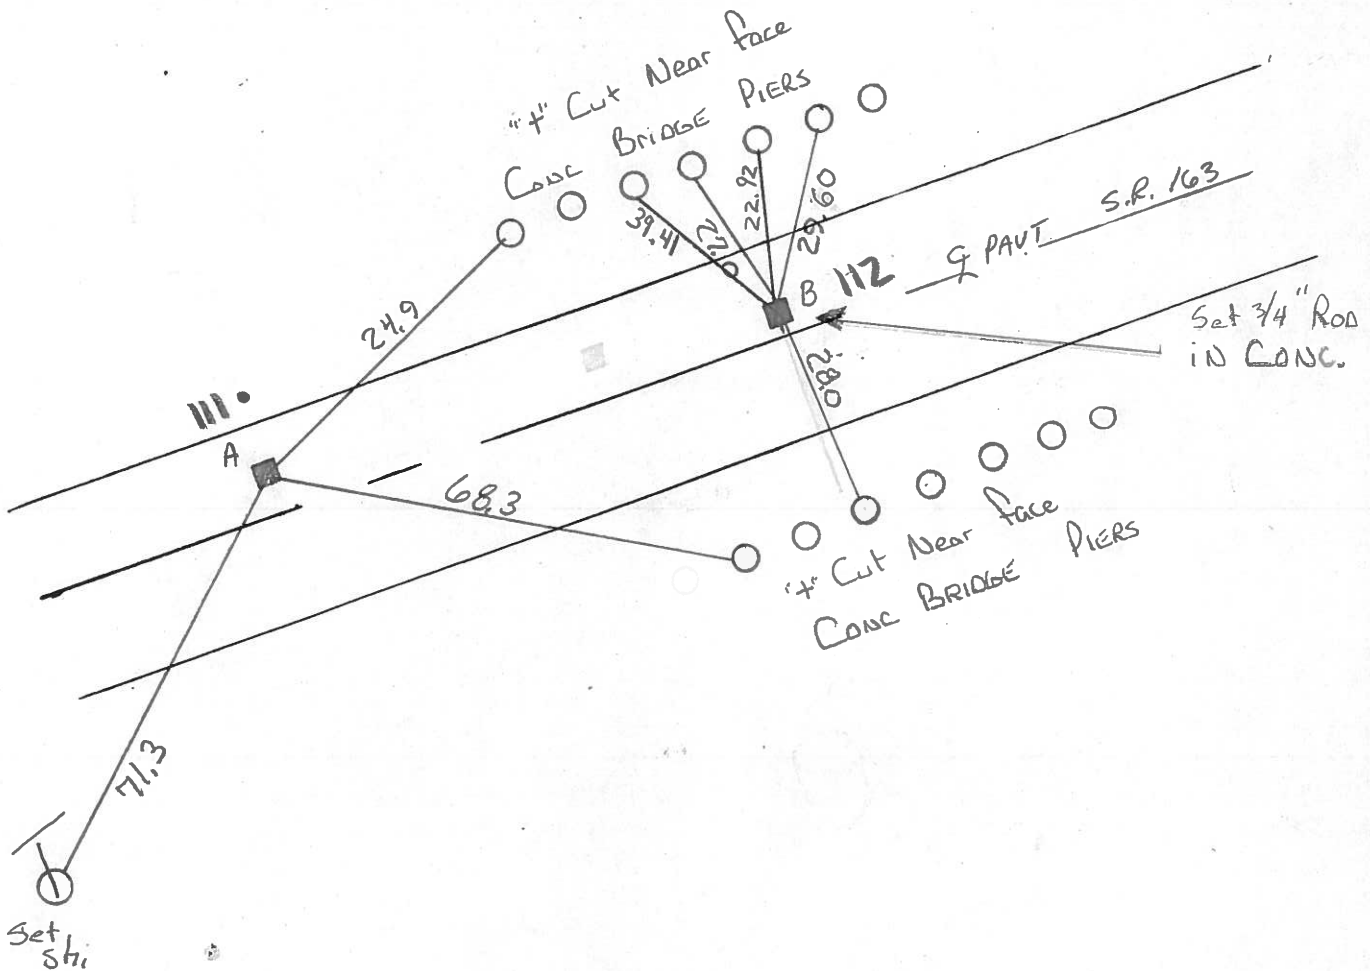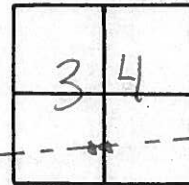

O.D.O.T. DISTRICT 2 SURVEY OFFICE

PERSONNEL

REFERENCE NO. 111

SHEET OF

NOTES CROWN

H.C. RIPPLE

R.C. BARBOUR

GEYMAN

DATE 9/11/85

WEATHER SUNNY

TEMP. 65°

ROUTE #163

COUNTY OTTAWA

TOWNSHIP ERIE

SECTION 34

T 7 N R 16 E


TYPE MONUMENT Mon. Box

ON SURFACE - BELOW BELOW SURFACE


LEFT - CL PAV'T. - RIGHT 5' LT. & PAV'T.

 TO EDGE PAVEMENT


S.L.M.

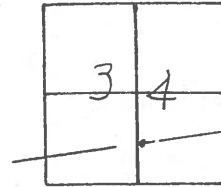

1155+58
ctr. of Box

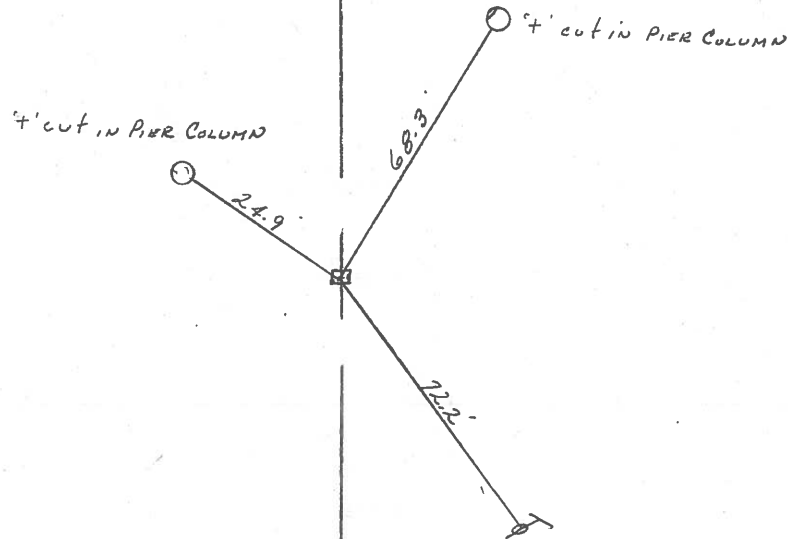

PERSONNEL	TITLE	PERSONNEL	TITLE	COUNTY	DATE
				Ottawa	5-8-69
				S. R. 163	WEATHER Cloudy-windy
				SEC. 34	TEMP. 60°
DESCRIPTION Erie Twp.				JOB NO.	
LEFT		CENTER LINE		RIGHT	

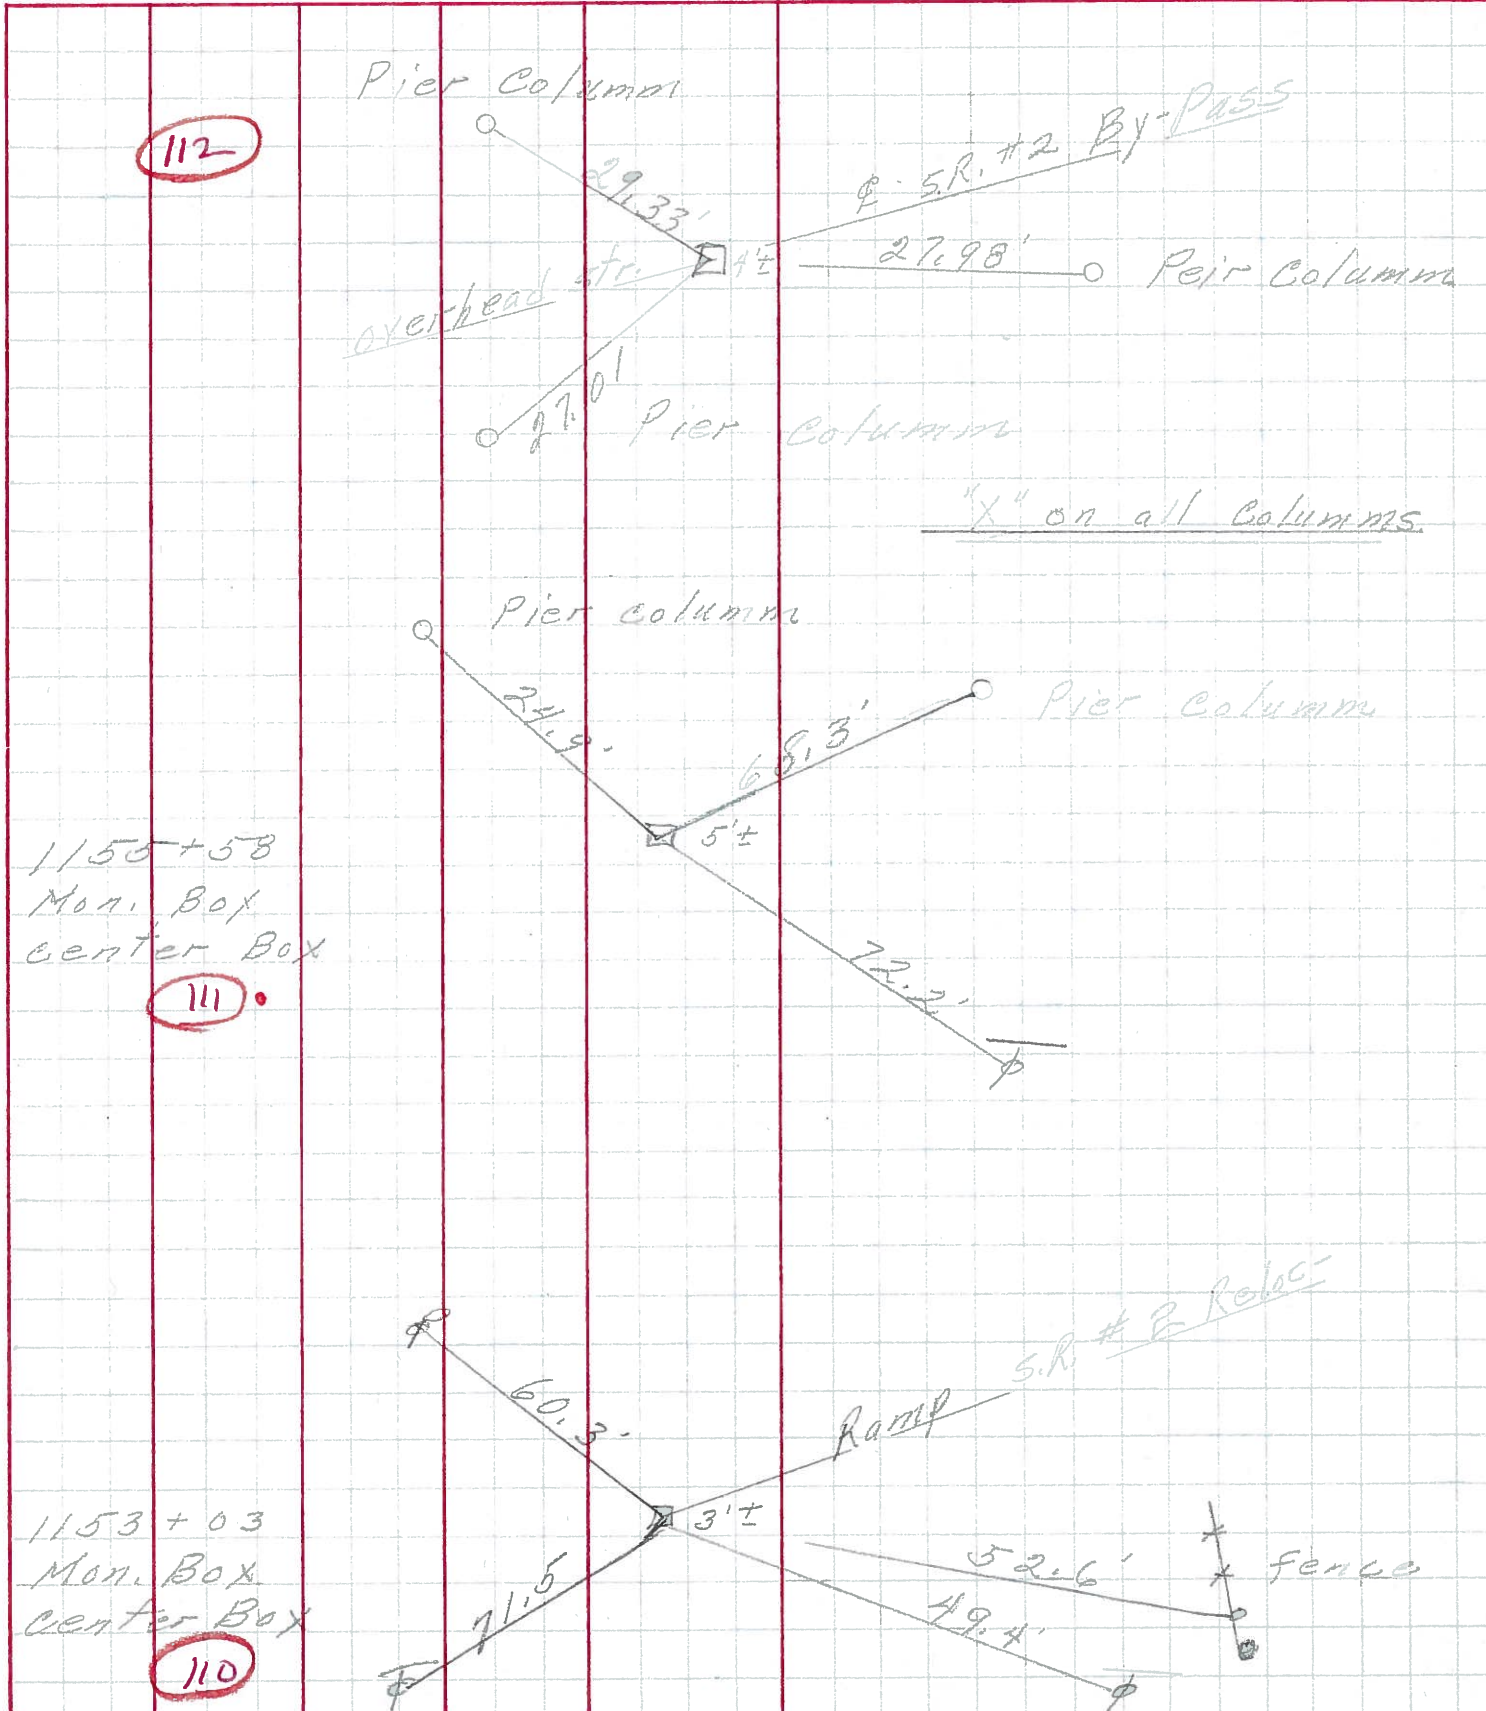

PERSONNEL TITLE PERSONNEL TITLE

COUNTY _____ DATE _____

S. R. P.I. S.R.#2 WEATHER _____

SEC. _____ TEMP. _____

DESCRIPTION _____ JOB NO. _____

LEFT

CENTER LINE

RIGHT

