


O.D.O.T. DISTRICT 2 SURVEY OFFICE (USE ONLY)


PERSONNEL _____ REFERENCE NO. 113 SHEET 6 OF 14
 NOTES CANTERBURY DATE 6/16/09 ROUTE SR 163
 H.C. HUSS WEATHER FAIR COUNTY OTTAWA
 R.C. CANTERBURY TEMP. 78° TOWNSHIP ERIE
 _____ SECTION 34
 _____ T 7 N R 16 E

TYPE MONUMENT MON BOX
 ON SURFACE - ~~BELOW~~ ON
 LEFT - ☉ PAV'T - ~~RIGHT~~ 4.2'
7.2' TO LT EDGE PAVEMENT
 S.L.M. 1159+78

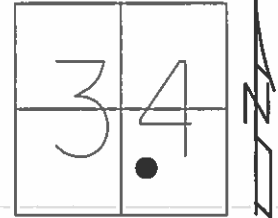

GRID: NORTHING: 675120.906 EASTING: 1831771.074


RECORD:
 STA. 168+91 PLAN
 FD MON.BOX
 GPS, SV123
 6/16/09, SAH

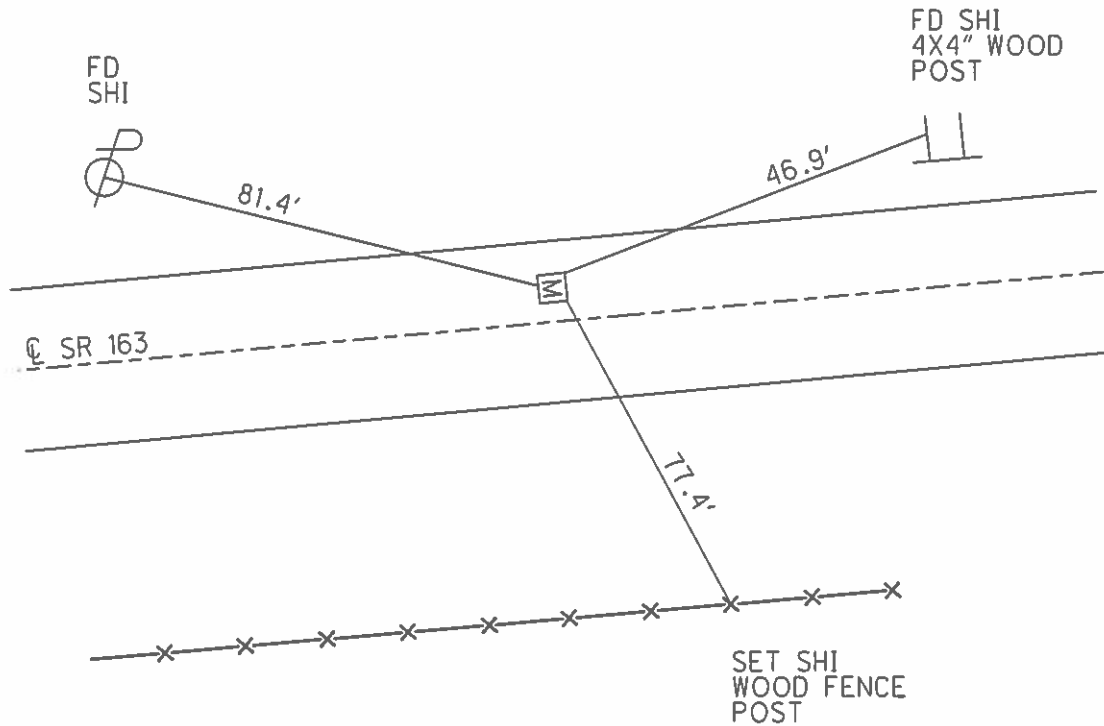

O.D.O.T. DISTRICT 2 SURVEY OFFICE (USE ONLY)


PERSONNEL _____ REFERENCE NO. 113 SHEET 6 OF 14
NOTES CANTERBURY DATE 6/16/09 ROUTE SR 163
H.C. HUSS WEATHER FAIR COUNTY OTTAWA
R.C. CANTERBURY TEMP. 78° TOWNSHIP ERIE
SECTION 34
T 7 N R 16 E

TYPE MONUMENT MON.BOX
ON SURFACE - ~~BELOW~~ ON _____
LEFT - ☉ PAV'T - ~~RIGHT~~ 4.2'
7.2' TO LT EDGE PAVEMENT
S.L.M. 1159+78, (168+91 PLAN)

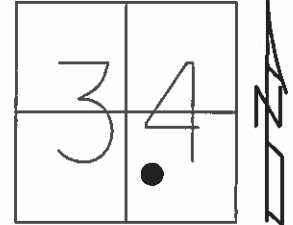

Grid: Northing: 675120.906 Easting: 1831771.074

FD MON.BOX
GPS, SV123
6/16/09, SAH

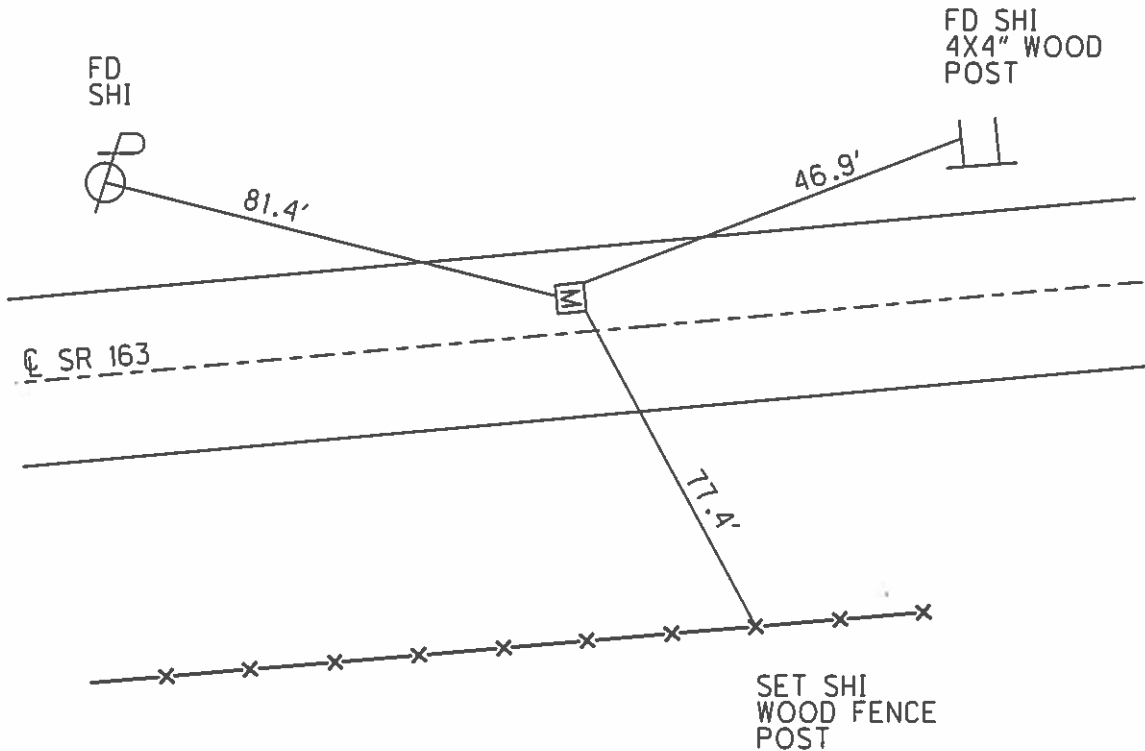

O.D.O.T. DISTRICT 2 SURVEY OFFICE

PERSONNEL

REFERENCE NO. 113

SHEET 5 OF 16

NOTES LoENKE

H.C. Rausos

DATE 9-2-95

ROUTE S.R. 163

R.C. CANTERBURY

WEATHER FAIR

COUNTY OTTAWA

TEMP. +85

TOWNSHIP ERIE

SECTION 34

RAISED 7-8-96

T 7 N R 16 E



TYPE MONUMENT Man Box

ON SURFACE - BELOW 4"

LEFT - CL PAV'T. - RIGHT 3.7 Lt

7.9 TO Lt EDGE PAVEMENT

S.L.M. 1159 + 78

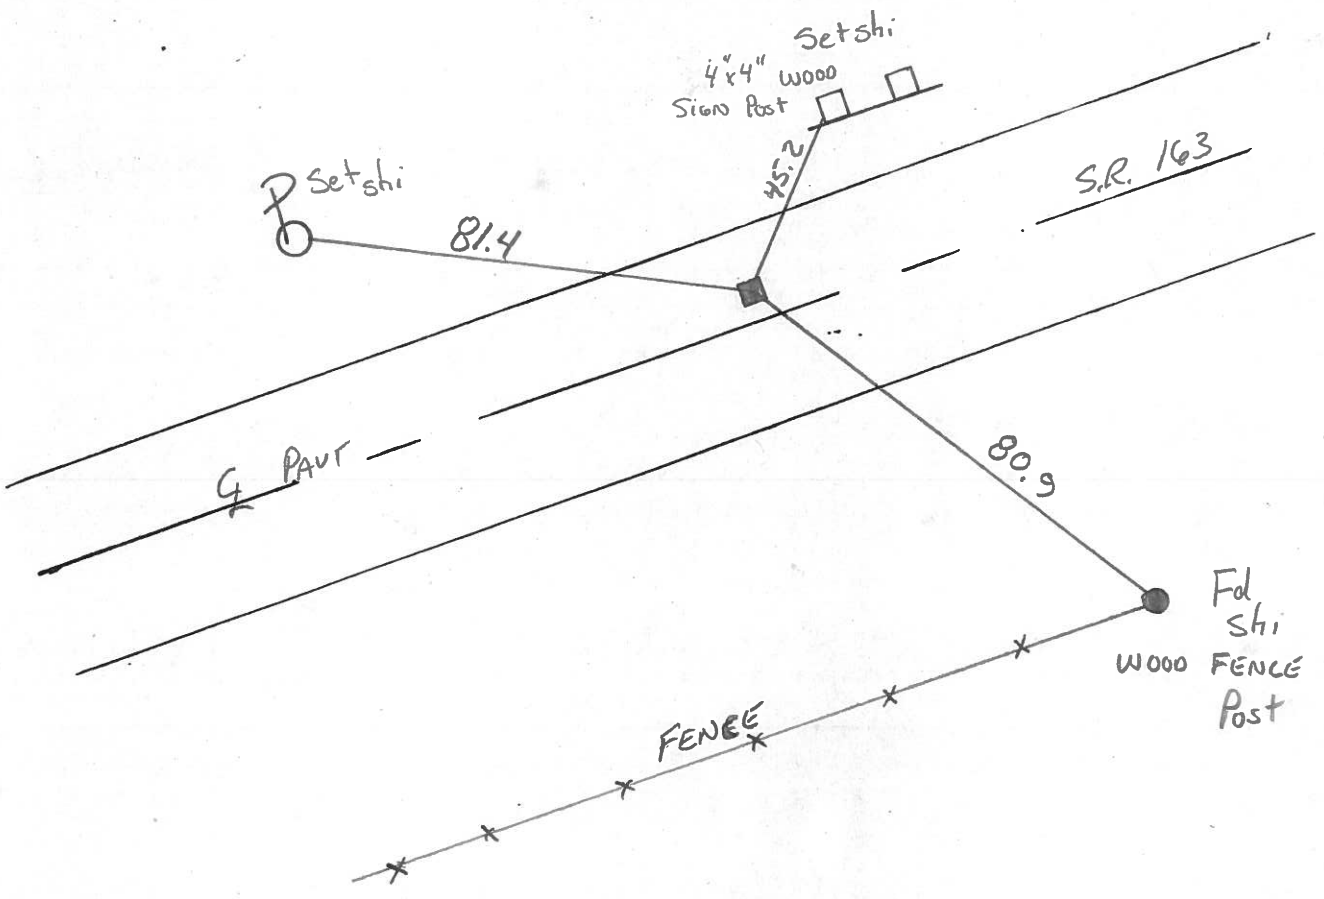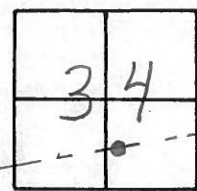

O.D.O.T. DISTRICT 2 SURVEY OFFICE

PERSONNEL _____

REFERENCE NO. 113

SHEET ① OF _____

NOTES CRONIN

H.C. RIPPLE

R.C. BARBOUR

GEYMAN

DATE 9/11/85

WEATHER SUNNY

TEMP. 65°

ROUTE #163

COUNTY OTTAWA

TOWNSHIP ERIE

SECTION 34

T 7 N R 16 E


TYPE MONUMENT Mon. Box

ON SURFACE - BELOW BELOW SURFACE


LEFT - ☉ PAV'T. - RIGHT 4' LT. & PAVT.

TO _____ EDGE PAVEMENT

S.L.M. _____

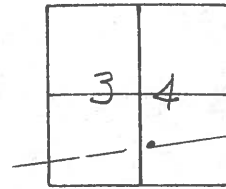

1160+07
ctr. of Mon Box

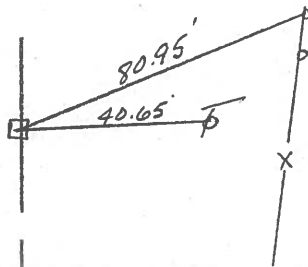


PERSONNEL TITLE PERSONNEL TITLE

COUNTY Ottawa DATE 5-8-69

S. R. 163 WEATHER Cloudy-Wind

SEC. 34 TEMP. 60°

DESCRIPTION Erie Twp. JOB NO.

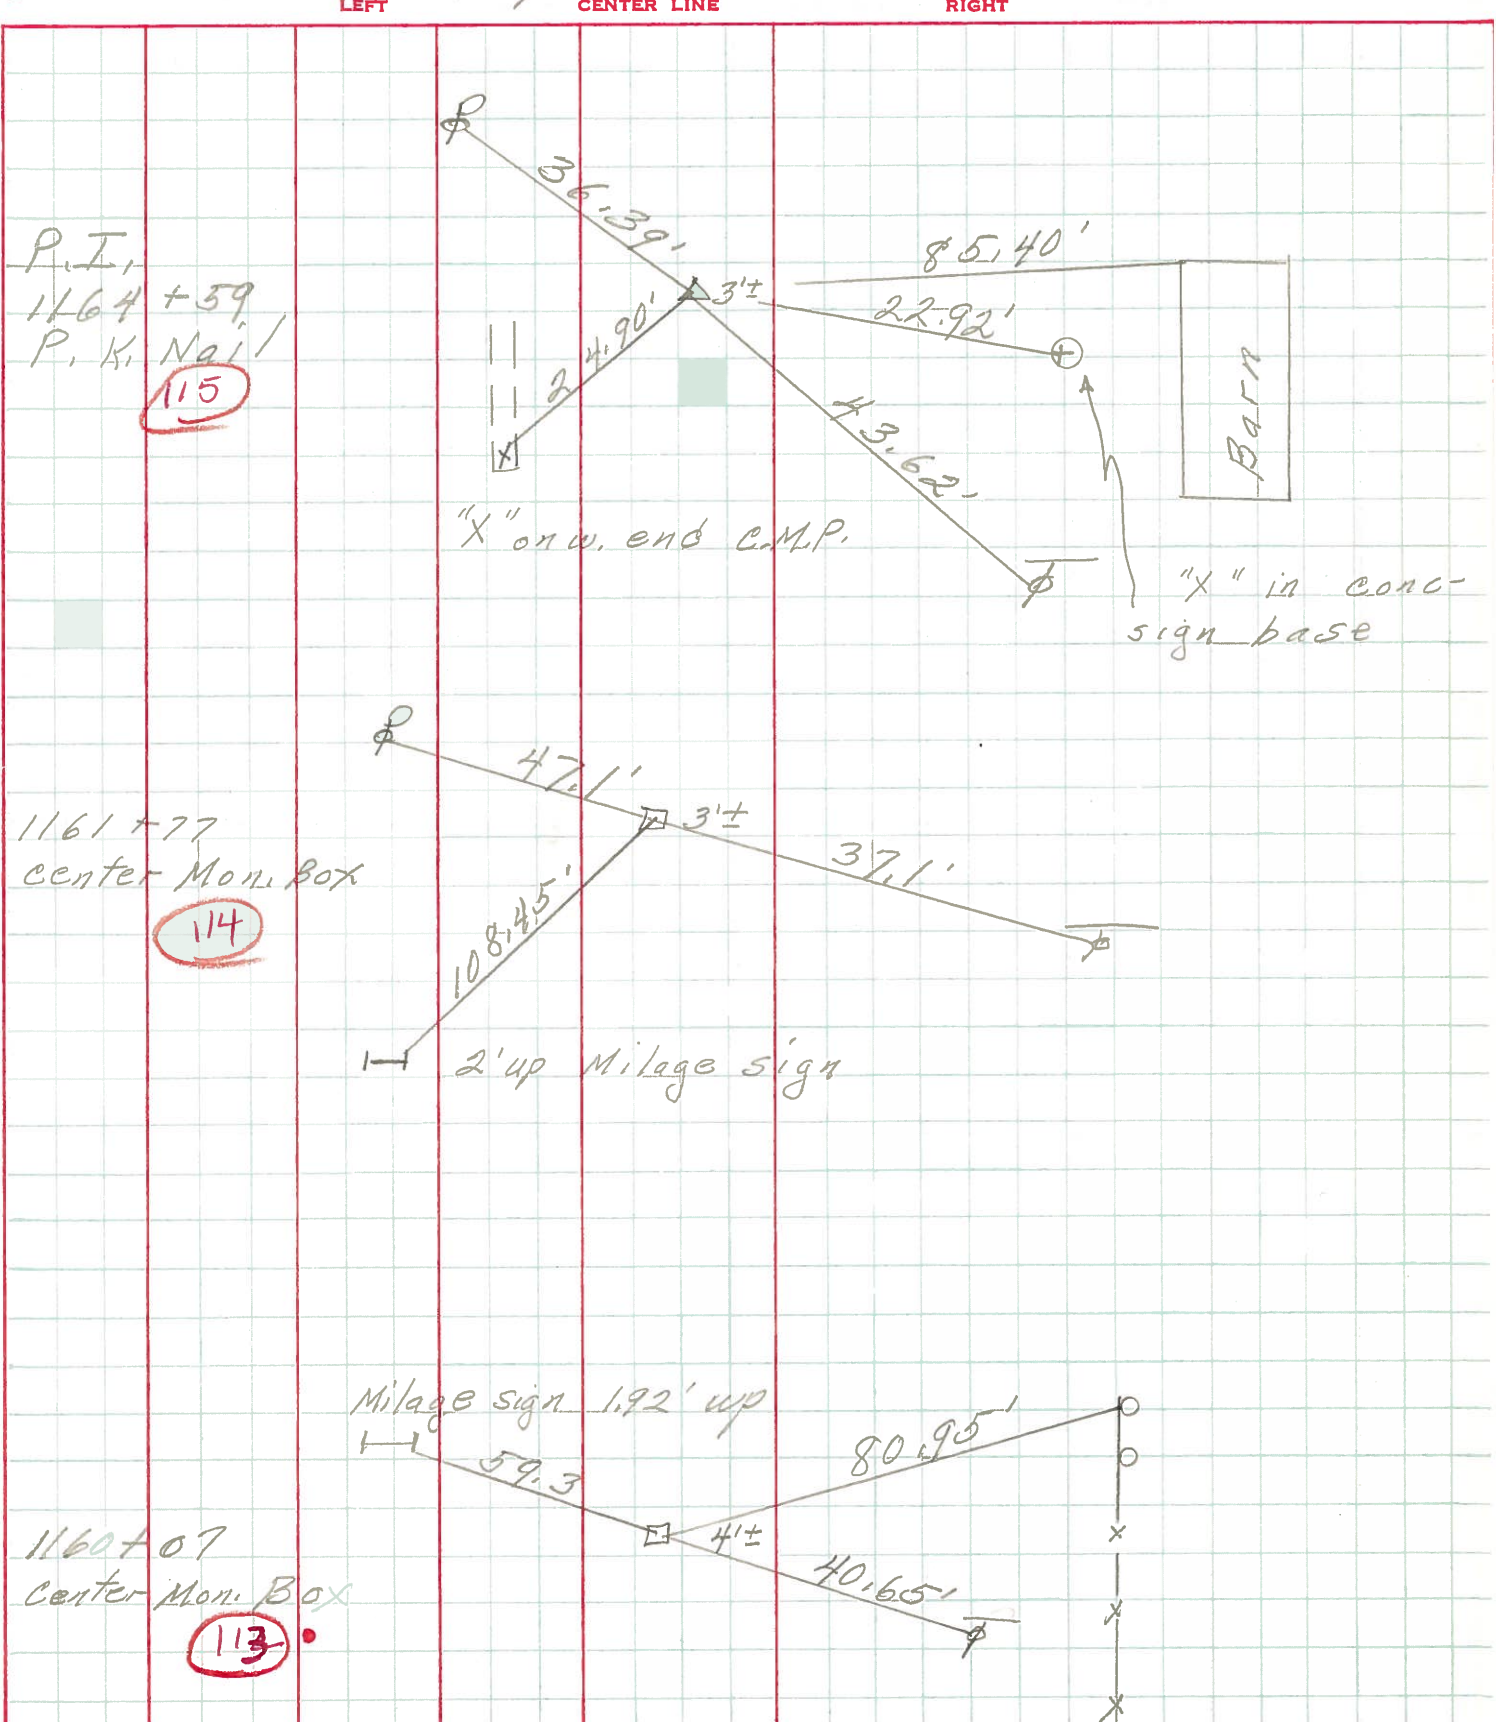

P.I.,
1164 + 59
P. K. Nail
115

1161 + 77
center Mon. Box
114

1160 + 07
center Mon. Box
113