



O.D.O.T. DISTRICT 2 SURVEY OFFICE (USE ONLY)

PERSONNEL _____ REFERENCE NO. 115 SHEET 8 OF 14
 NOTES CANTERBURY DATE 6/16/09 ROUTE SR 163
 H.C. HUSS WEATHER FAIR COUNTY OTTAWA
 R.C. CANTERBURY TEMP. 78° TOWNSHIP ERIE
 _____ SECTION 34
 _____ T 7 N R 16 E

TYPE MONUMENT P.K./WASHER
 ON SURFACE - ~~BELOW~~ ON _____
 LEFT - ☉ PAV'T - ~~RIGHT~~ 2.5'
8.2' TO LT EDGE PAVEMENT
 S.L.M. _____ 1164+28

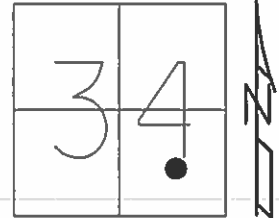

GRID: NORTHING: 675157.725 EASTING: 1832221.380

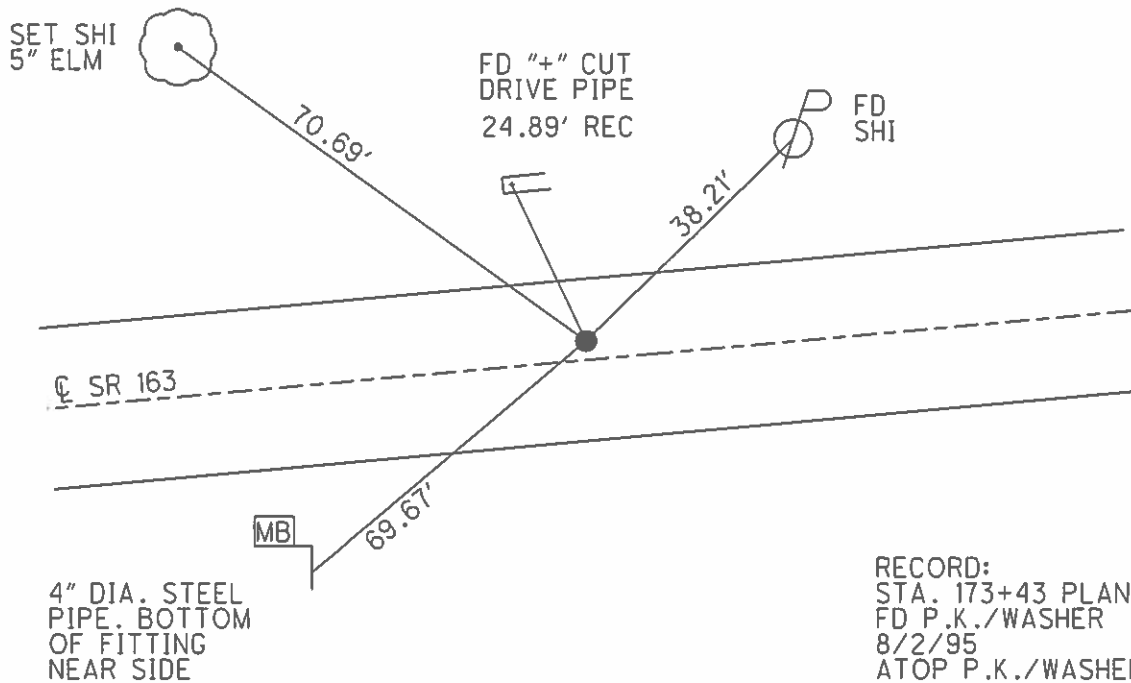

RECORD:
 STA. 173+43 PLAN
 FD P.K./WASHER
 8/2/95
 ATOP P.K./WASHER

SET P.K./WASHER
 6/18/96


FD P.K./WASHER
 GPS, SV125
 6/16/09, MC

SET MAG/WASHER
 10/22/09, SAH


O.D.O.T. DISTRICT 2 SURVEY OFFICE (USE ONLY)

PERSONNEL _____ REFERENCE NO. 115 SHEET 8 OF 14
 NOTES CANTERBURY DATE 6/16/09 ROUTE SR 163
 H.C. HUSS WEATHER FAIR COUNTY OTTAWA
 R.C. CANTERBURY TEMP. 78° TOWNSHIP ERIE
 _____ SECTION 34
 _____ T 7 N R 16 E

TYPE MONUMENT P.K./WASHER
 ON SURFACE - ~~BELOW~~ ON _____
 LEFT - ☉ PAV'T - ~~RIGHT~~ 2.5'
8.2' TO LT EDGE PAVEMENT
 S.L.M. 1164+28, (173+43 PLAN)

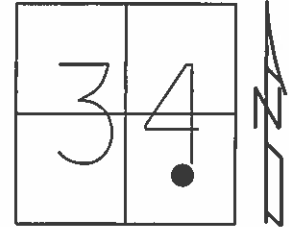

Grid: Northing: 675157.725 Easting: 1832221.380

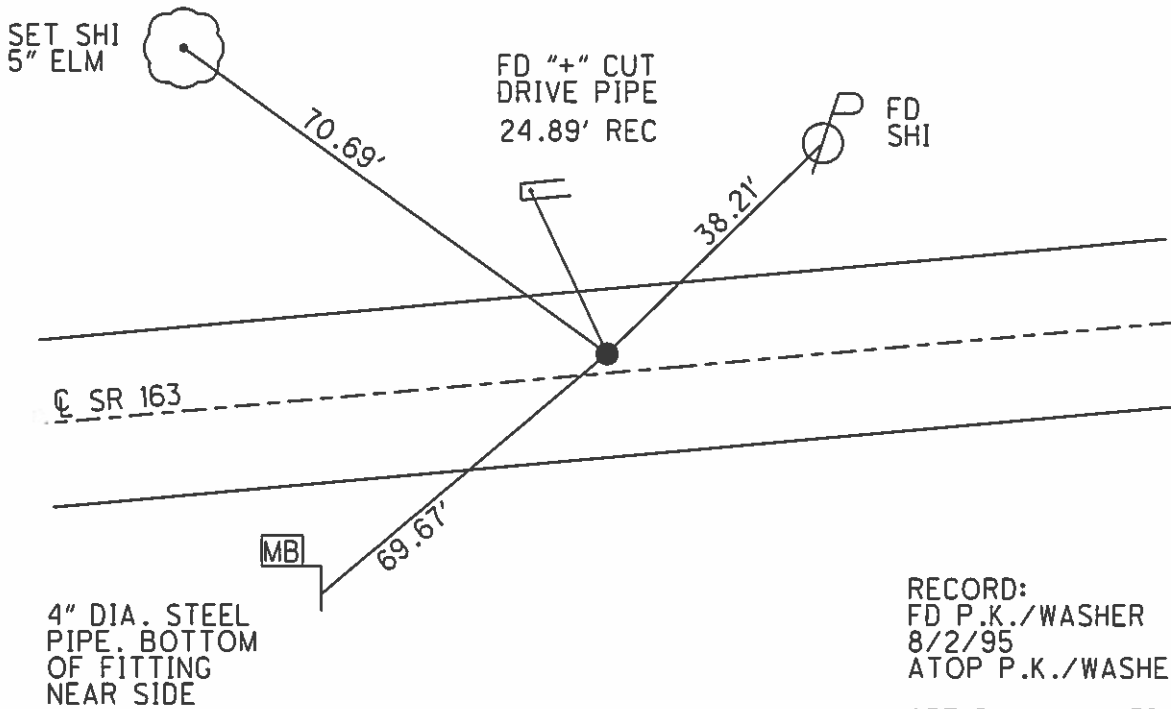

RECORD:
 FD P.K./WASHER
 8/2/95
 ATOP P.K./WASHER
 SET P.K./WASHER
 6/18/96
 FD P.K./WASHER
 GPS, SV125
 6/16/09, MC
 SET MAG/WASHER
 10/22/09, SAH

O.D.O.T. DISTRICT 2 SURVEY OFFICE

PERSONNEL _____

REFERENCE NO. 115

SHEET 7 OF 16

NOTES Revised

H.C. Slovak

DATE 8-2-95

ROUTE SR 163

R.C. Centerbury

WEATHER HOT

COUNTY OTTAWA

TEMP. 89°

TOWNSHIP ERIE

SECTION 34

T 2 N R 16 E

Reset 6-18-96


TYPE MONUMENT ~~PK/WASHER~~ PK/WASHER A TOP PK/WASHER

ON SURFACE - ~~BELOW~~ ON SURFACE


LEFT - ~~CL~~ PAV'T. - RIGHT 2.3' LT & PYMT

8.7' TO LT EDGE PAVEMENT

S.L.M. 1164 +28

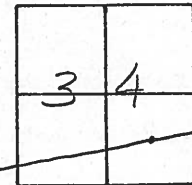

P.I.
STA 1164.28

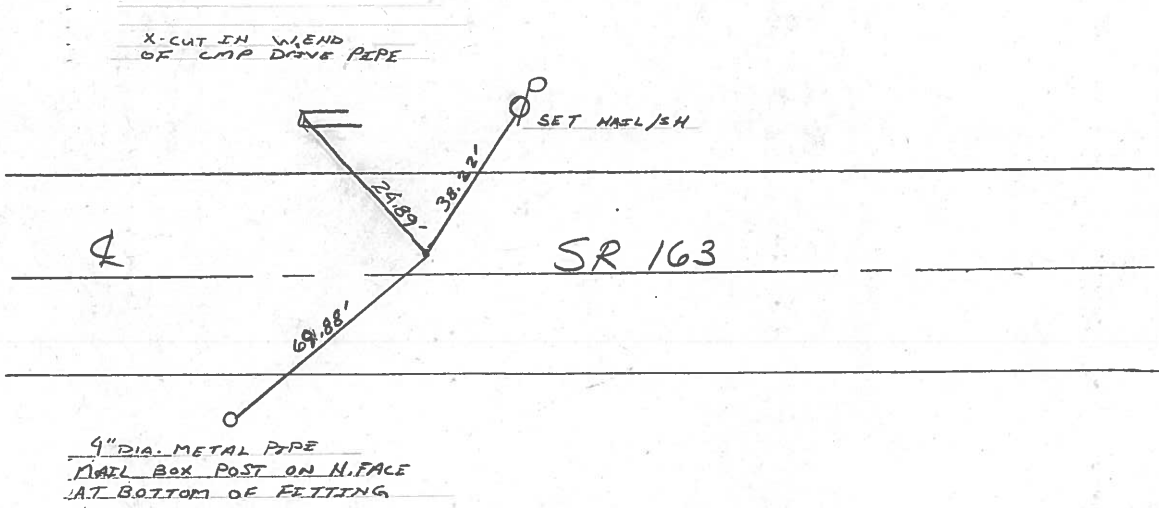

O.D.O.T. DISTRICT 2 SURVEY OFFICE ①

PERSONNEL



REFERENCE NO. 115 SHEET 1 OF

NOTES CRONIN
 H.C. RIPPLE
 R.C. GEYMAN
BARBOUR


DATE 9/11/85
 WEATHER SUNNY-WINDY
 TEMP. 63°

ROUTE #163
 COUNTY OTTAWA
 TOWNSHIP ERIE
 SECTION 34
T 7 N R 16 E

TYPE MONUMENT P.K. WASHER ATOP P.K. WASHER
 ON SURFACE - BELOW ON SURFACE
 LEFT - ℄ PAV'T. - RIGHT 3' LT. & PAVT
TO EDGE PAVEMENT
 S.L.M.

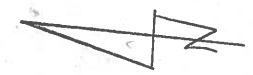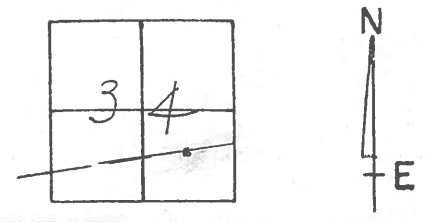

P.I.
1162159?

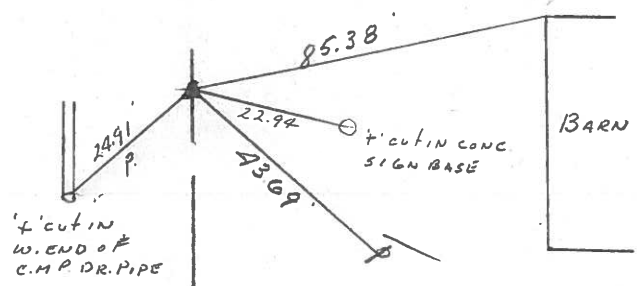

PERSONNEL TITLE PERSONNEL TITLE

COUNTY Ottawa

DATE 5-8-69

S. R. 163

WEATHER Cloudy-Wind

SEC. 34

TEMP. 60°


DESCRIPTION Erie Twp.

JOB NO.

LEFT

CENTER LINE

RIGHT

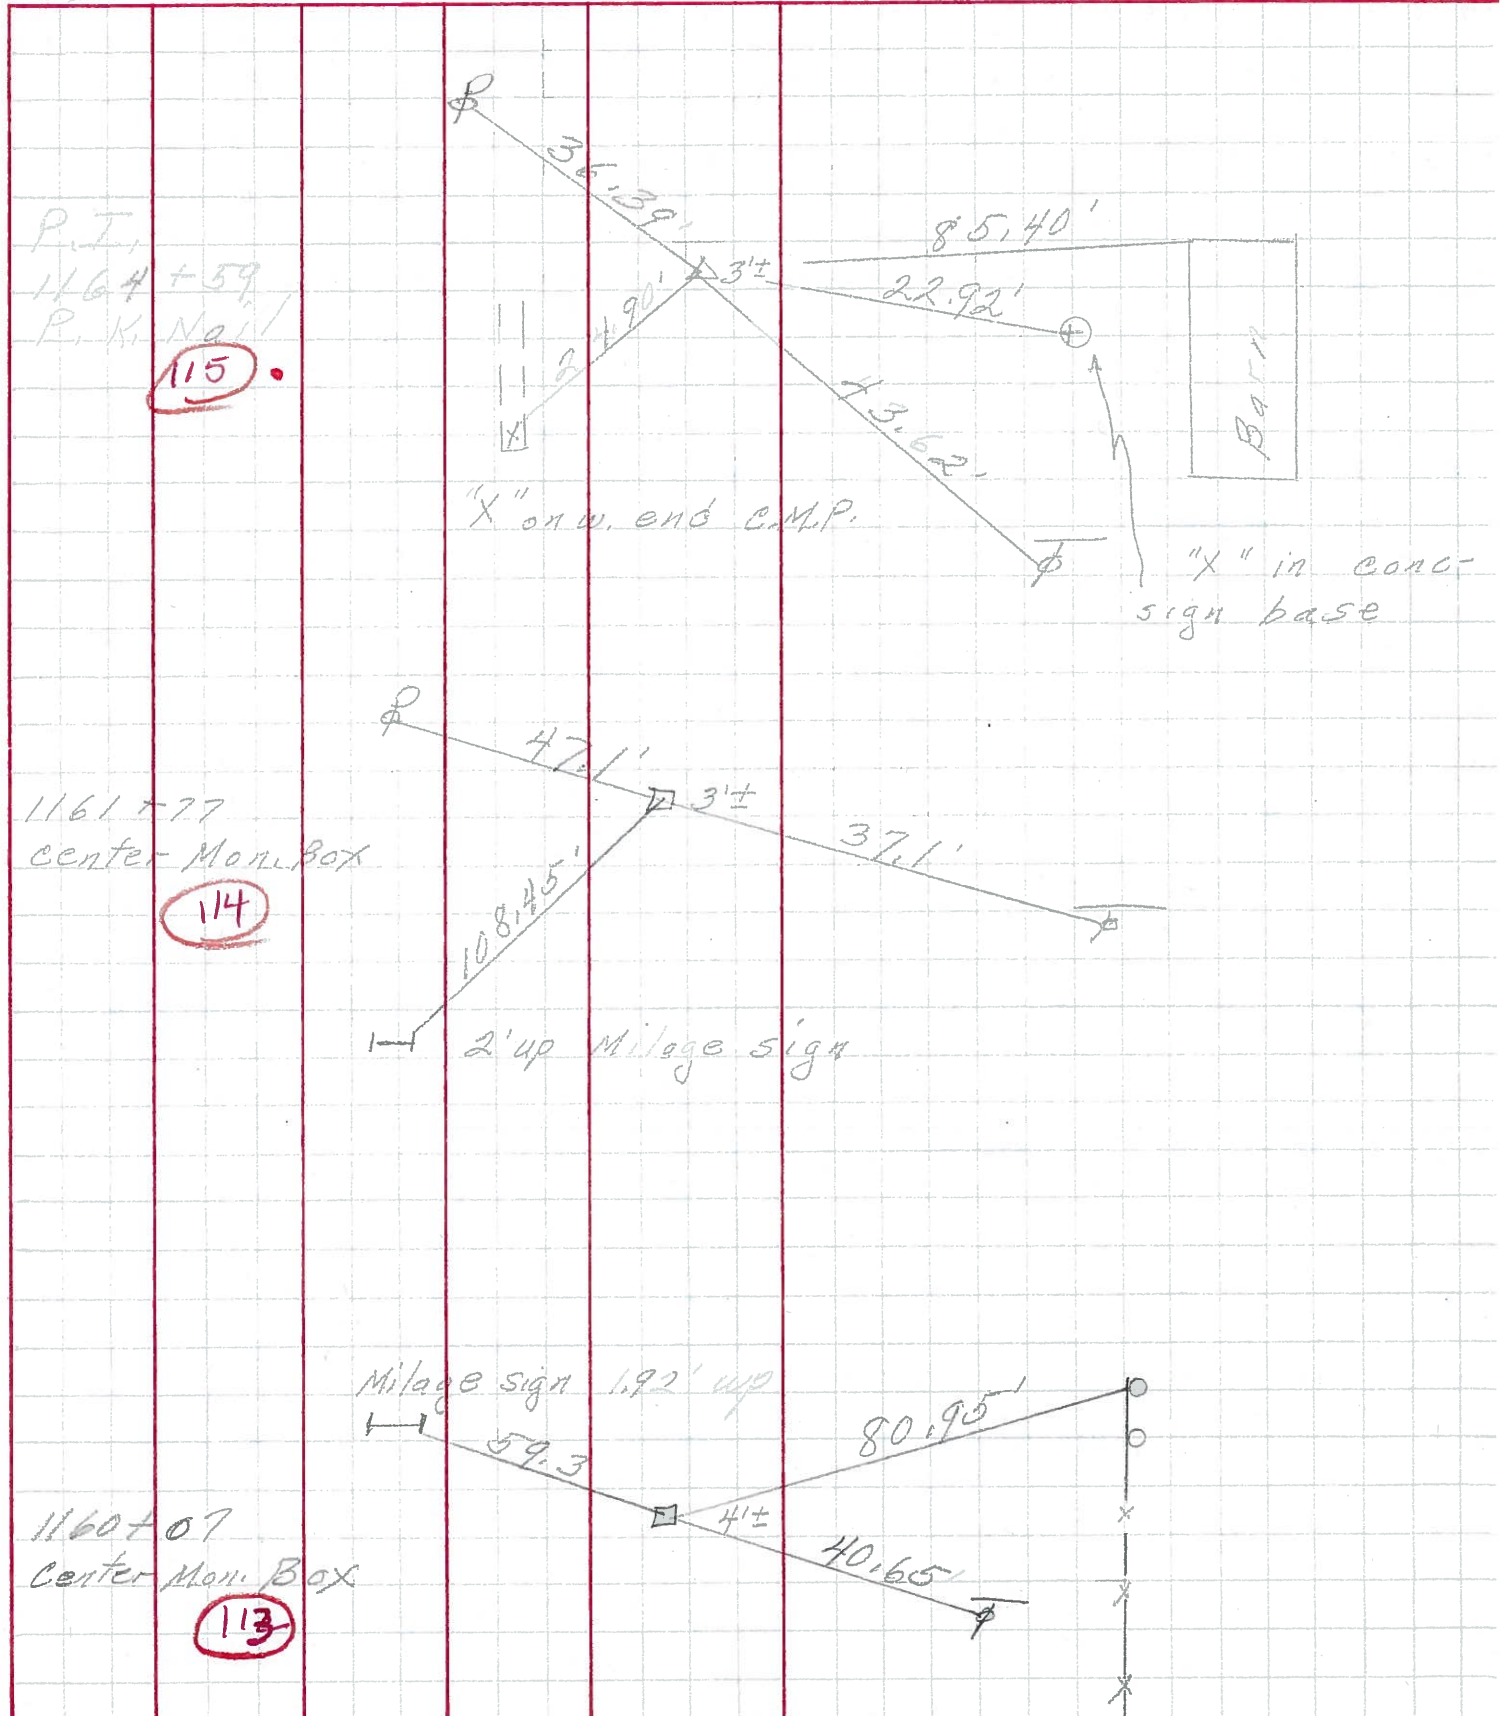

P.T.
1164 + 59
P. K. Nail
115

1161 + 77
center Mon. Box
114

1160 + 07
Center Mon. Box
113