



O.D.O.T. DISTRICT 2 SURVEY OFFICE (USE ONLY)

PERSONNEL _____ REFERENCE NO. 115 A SHEET 9 OF 14
 NOTES CANTERBURY DATE 6/16/09 ROUTE SR 163
 H.C. HUSS WEATHER FAIR COUNTY OTTAWA
 R.C. _____ TEMP. 77° TOWNSHIP ERIE
 _____ CANTERBURY SECTION 34
 _____ T 7 N R 16 E

TYPE MONUMENT P.K./WASHER
 ON SURFACE - ~~BELOW~~ ON
 LEFT - ☉ PAV'T - ~~RIGHT~~ 3.5'
7.3' TO LT EDGE PAVEMENT
 S.L.M. _____ 1167+26

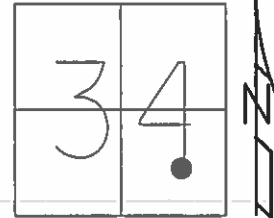

GRID: NORTHING: 675191.582 EASTING: 1832503.650

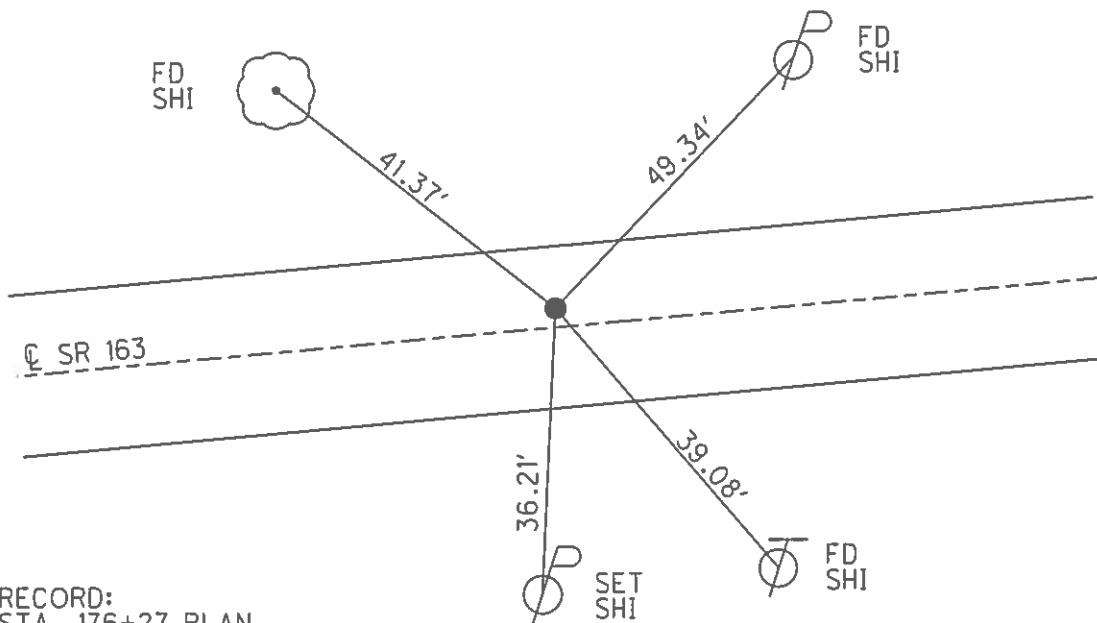

RECORD:
 STA. 176+27 PLAN
 FD P.K.NAIL
 ORIGIN UNKNOWN
 5/23/96, CL

SET P.K.NAIL
 6/19/96, CL


FD P.K.NAIL
 GPS, SVA125
 6/16/09, MC

SET MAG/WASHER
 10/22/09, SAH


O.D.O.T. DISTRICT 2 SURVEY OFFICE (USE ONLY)

PERSONNEL _____ REFERENCE NO. 115 A SHEET 9 OF 14
 NOTES CANTERBURY DATE 6/16/09 ROUTE SR 163
 H.C. HUSS WEATHER FAIR COUNTY OTTAWA
 R.C. CANTERBURY TEMP. 77° TOWNSHIP ERIE
 SECTION 34
 T 7 N R 16 E

TYPE MONUMENT P.K./WASHER
 ON SURFACE - ~~BELOW~~ ON
 LEFT - ☉ PAV'T - ~~RIGHT~~ 3.5'
7.3' TO LT EDGE PAVEMENT
 S.L.M. 1167+26, (176+27 PLAN)

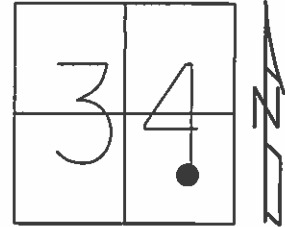

Grid: Northing: 675191.582 Easting: 1832503.650

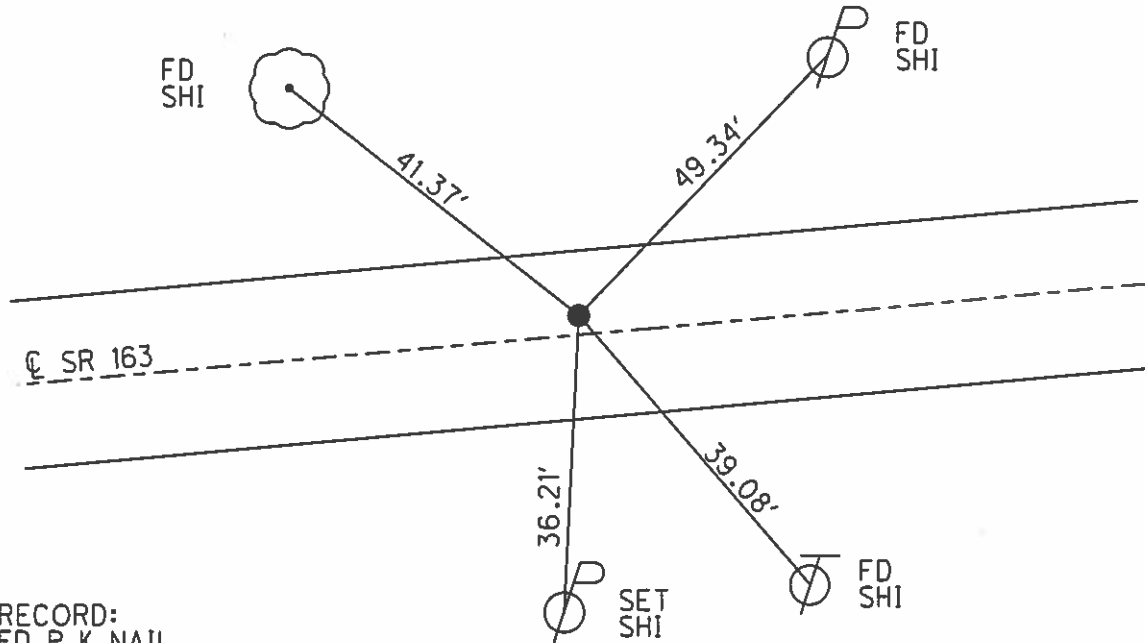

RECORD:
 FD P.K.NAIL
 ORIGIN UNKNOWN
 5/23/96, CL

SET P.K.NAIL
 6/19/96, CL

FD P.K.NAIL
 GPS, SVA125
 6/16/09, MC

SET MAG/WASHER
 10/22/09, SAH

O.D.O.T. DISTRICT 2 SURVEY OFFICE

PERSONNEL

REFERENCE NO. 115-A

SHEET 8 OF 16

NOTES LOENRKE

H.C. ROUSS

R.C. CANTERBURY

DATE 5-23-96

WEATHER FAIR

TEMP. +70

ROUTE S.R. 163

COUNTY OTTAWA

TOWNSHIP ERIE

SECTION 34

T 7 N R 16 E

TYPE MONUMENT P.K. NAIL - ORIGIN UNK Reset 6-19-96

ON SURFACE - BELOW Yes

LEFT - PAV'T. - RIGHT 3.0 Lt

7.9 TO Lt EDGE PAVEMENT

S.L.M. 1167+26

