


O.D.O.T. DISTRICT 2 SURVEY OFFICE (USE ONLY)

PERSONNEL \_\_\_\_\_ REFERENCE NO. 125 A SHEET 2 OF 22


NOTES LOEHRKE DATE 3/21/00 ROUTE SR 163  
 H.C. HUSS WEATHER FAIR COUNTY OTTAWA  
 R.C. LOEHRKE TEMP. 44° TOWNSHIP PORTAGE  
 \_\_\_\_\_ SECTION 6  
 \_\_\_\_\_ T 6 N R 17 E

TYPE MONUMENT \_\_\_\_\_ POINT ON S/EDGE OF MH  
 ON SURFACE - BELOW \_\_\_\_\_ ON \_\_\_\_\_  
 LEFT - CL PAV'T - RIGHT \_\_\_\_\_  
 \_\_\_\_\_ TO \_\_\_\_\_ EDGE PAVEMENT  
 S.L.M. 1339+00

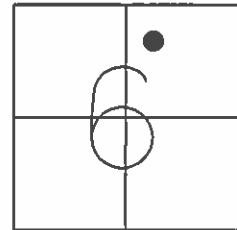

GRID: NORTHING: 673091.150 EASTING: 1847679.445

RECORD:  
 STA. 5+08.85  
 SET P.K.NAIL  
 2/27/58  
 FD P.K./WASHER  
 4/27/78  
 SET P.K./WASHER  
 6/6/79  
 RECORD TIES FROM 1958  
 PUT POINT ON MANHOLE  
 LID, NEAR SOUTHERLY  
 EDGE OF LID  
 3/21/00, CL  
 FD DRILLHOLE  
 GPS, SV202  
 6/21/10

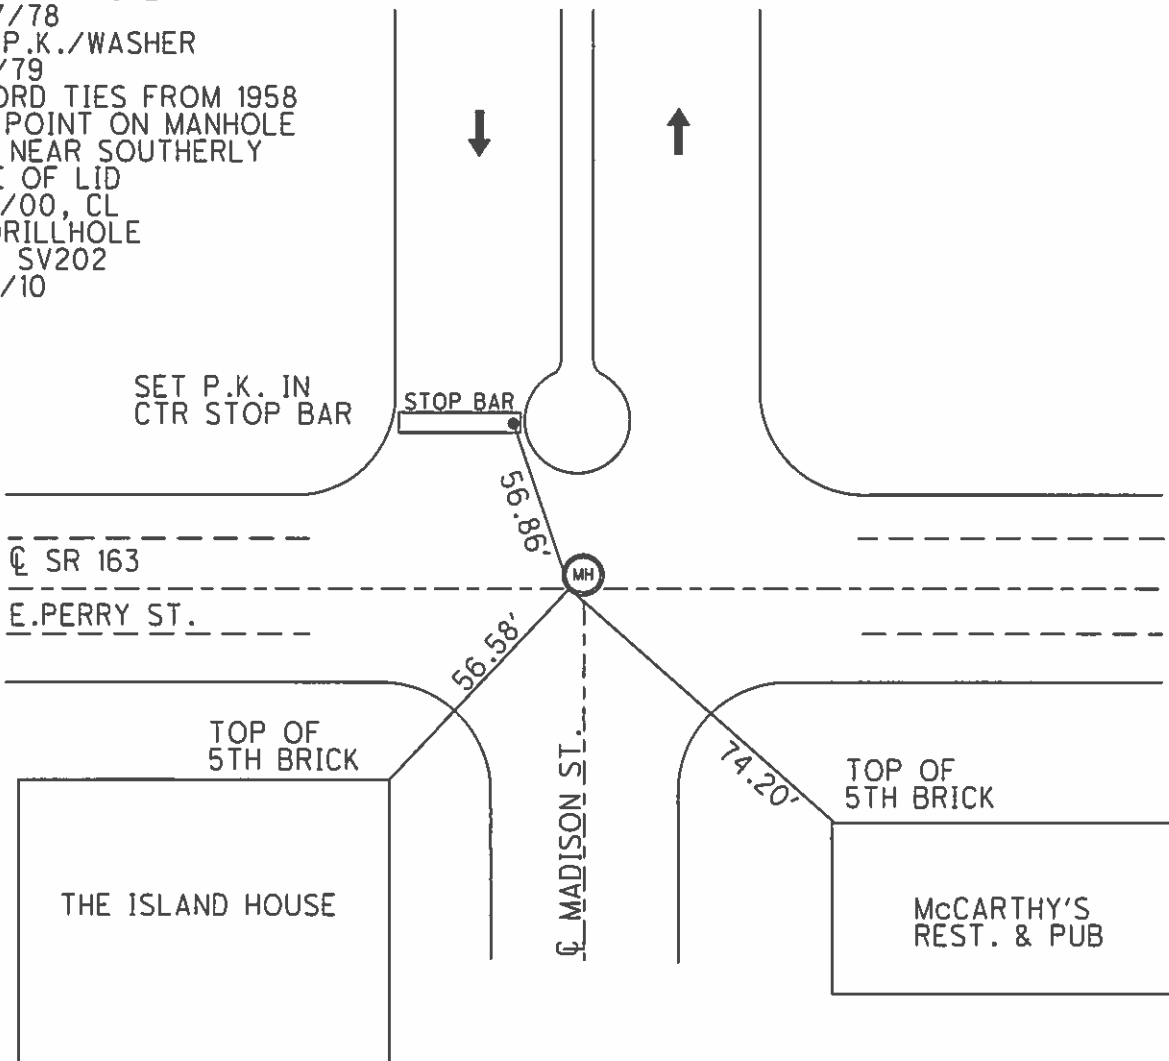

PERSONNEL TITLE PERSONNEL TITLE

COUNTY OTTAWA

DATE 2/27/58

S. R. SR #2 - SR 53

WEATHER

W. PERRY + MARISON ST

SEC. PORT CLINTON

TEMP.

DESCRIPTION

LEFT

CENTER LINE

RIGHT

JOB NO.

checked 4/27/78

sunny

Fd. P.K. Nail & Washer

125A

Good ties

Fd set P.K. Nail

5+08.85

Reset P.K. Washer

6/6/79

Ties good

56.53

57.95

58.0

\* IN WALK

56.38

5th BRICK UP

TOP OF

Madison ST.

IN END OF METER CURB

55.24

55.40

57.27

NAIL

56.23

56.27

NEAR SIDE

LITTLE POLE

X in ↘

TOP OF 5TH

PIZZA HUT



SB

P.I.

10+30.80

Δ = 5° 45' 11"

Jefferson St.

Δ

did not find

P.I.

20+70.00

Δ = 6° 59' RT.

Δ

" " "

P.I.

36+22.58

Δ = 10° LT.

Δ

" " "