


O.D.O.T. DISTRICT 2 SURVEY OFFICE (USE ONLY)

PERSONNEL	REFERENCE NO.	125 B	SHEET	3	OF	22
NOTES	LOEHRKE	DATE	3/21/00	ROUTE	SR 163	
H.C.	HUSS	WEATHER	FAIR	COUNTY	OTTAWA	
R.C.	LOEHRKE	TEMP.	44°	TOWNSHIP	PORTAGE	
				SECTION	6	
				T	6	N
				R	17	E

TYPE MONUMENT P.K.NAIL
 ON SURFACE - ~~BELOW~~ ON
 LEFT - CL PAV'T - RIGHT ON
- TO - EDGE PAVEMENT
 S.L.M. 1344+81.60
 GRID: NORTHING: 673096.027 EASTING: 1848199.514

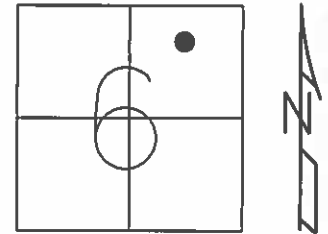

RECORD: P.C.

