

PERSONNEL TITLE PERSONNEL TITLE

COUNTY Ottawa

DATE 2/26/58

S. R. #2

WEATHER

SEC. Port Clinton

TEMP.

DESCRIPTION


LEFT

CENTER LINE


RIGHT

JOB NO.


§ S.R. #2 § 163 § Lincoln St.  
34+91.80 Mon. Box.

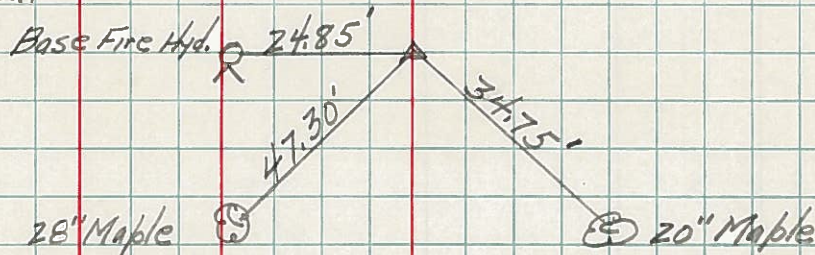

§ S.R. #2 § 163 § Hayes St. "X" conc. base st. sign  
39+81.80 Mon. Box

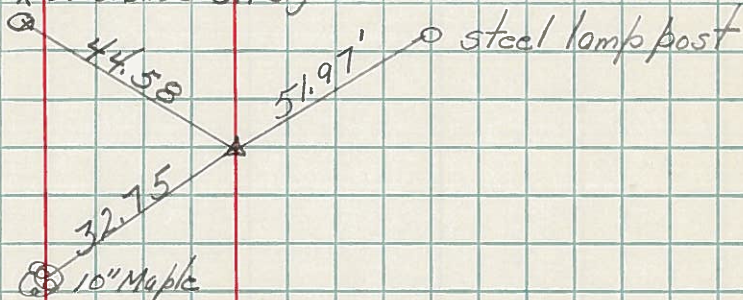

§ S.R. #2 § 163 § Elm St.  
42+42.40 Mon. Box

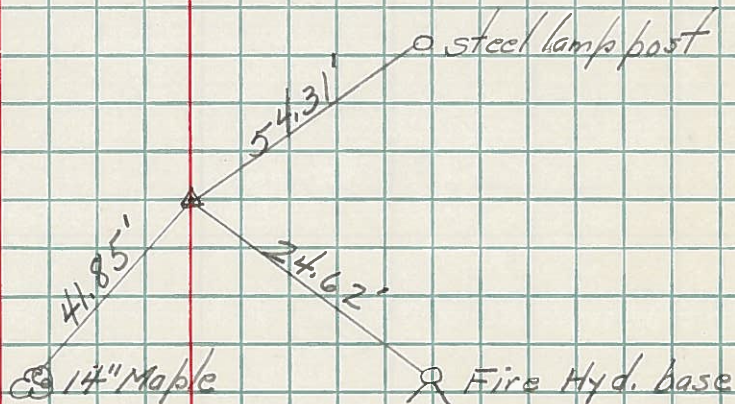



PERSONNEL TITLE PERSONNEL TITLE

COUNTY Ottawa

DATE 5/27/54

SAMP

S. R. SR # 2

WEATHER Clear

SEC. CITY of PT Clinton

TEMP.

DESCRIPTION

MONUMENT LOCATION

JOB NO.

LEFT

CENTER LINE

RIGHT

