

PERSONNEL TITLE PERSONNEL TITLE


COUNTY Ottawa DATE 2/26/58

S. R. #2 WEATHER


SEC. Port Clinton TEMP.

DESCRIPTION LEFT CENTER LINE RIGHT JOB NO.


⊥ S.R.#2 ⊥ 163 ⊥ Lincoln St.
34+91.80 Mon. Box.

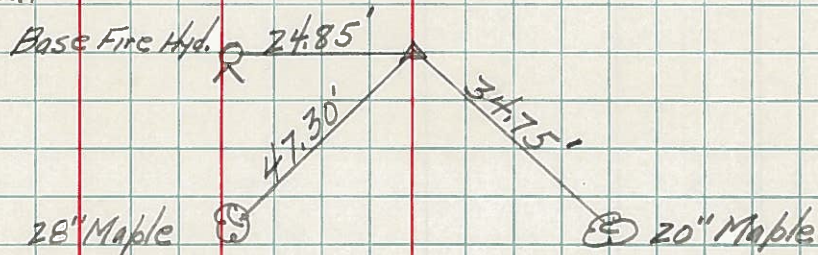

⊥ S.R.#2 ⊥ 163 ⊥ Hayes St. "X" conc. base st. sign
39+81.80 Mon. Box

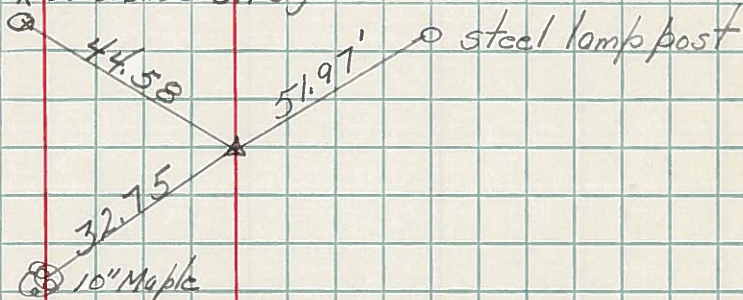

⊥ S.R.#2 ⊥ 163 ⊥ Elm St.
42+42.40 Mon. Box

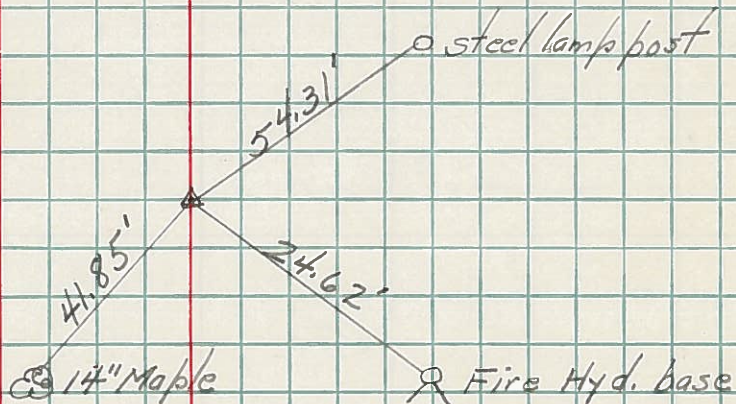

PERSONNEL TITLE PERSONNEL TITLE
 Scott _____
 Kowalski _____
 Peltier _____

COUNTY Ottawa DATE 5/27/54

S. R. #5 163 WEATHER Clear

SEC. City of Pt. Clinton TEMP. _____


DESCRIPTION LEFT CENTER LINE RIGHT JOB NO.

Checked & Entered in book (OTT)

Pages 27-28

6/29/55 Scott.


NORTH SR#2
OK 2/26/58

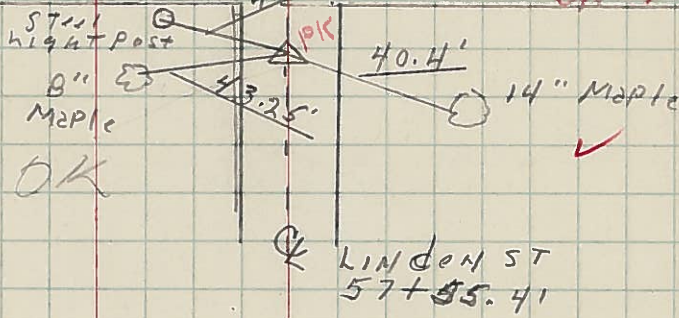

29

OK


SR#2
OK 2/26/58

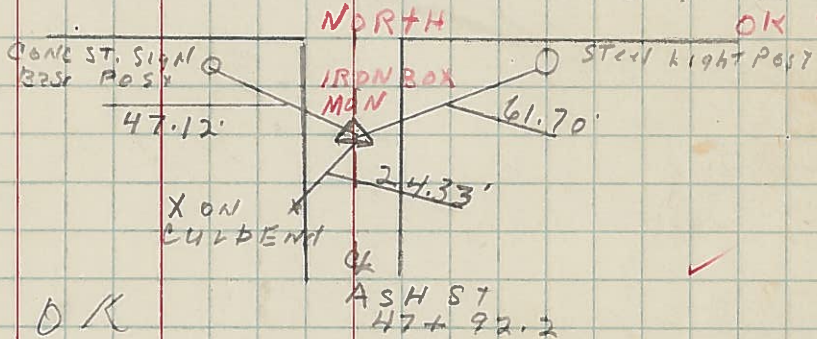

28

OK

SR#2
Steel lamp Post OK 2/26/58

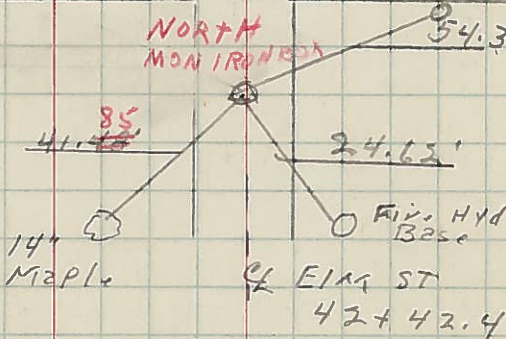

27

OK

not in book

