

PERSONNEL TITLE PERSONNEL TITLE


COUNTY Ottawa DATE 2/26/58

S. R. #2 WEATHER


SEC. Port Clinton TEMP.

DESCRIPTION LEFT CENTER LINE RIGHT JOB NO.

± S.R. #2 ± 163 ± Ash St.
47+92.20 Mon. Box.

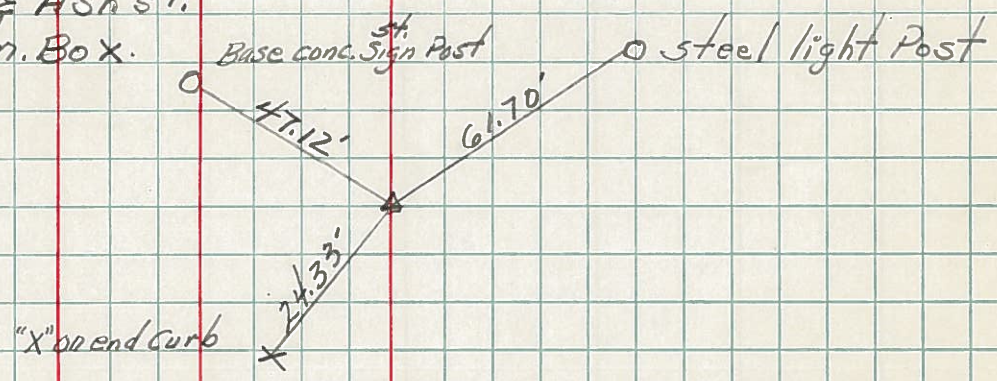


± S.R. #2 ± 163 ± Linden St.
57+55.41

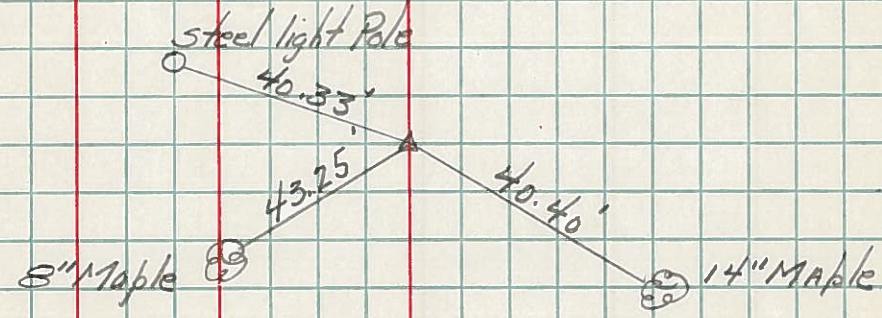

P.I. ± S.R. #163 ± S.R. #2
P.K. NAIL ± shiner

C.B.
"X" on S.E. COR.
Parapet Block.

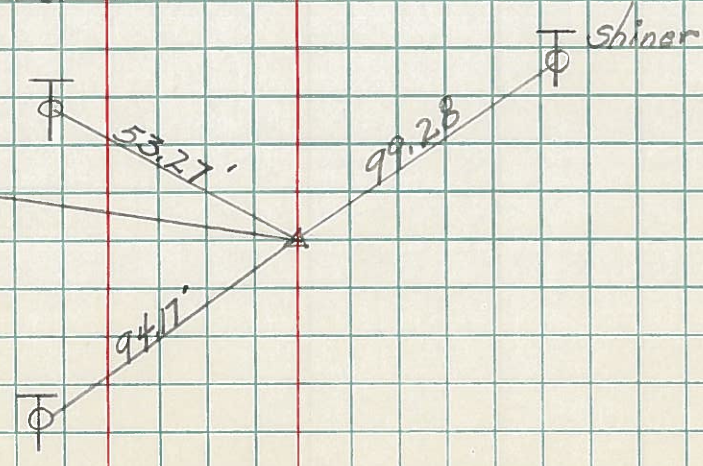

PERSONNEL TITLE PERSONNEL TITLE
 Scott _____
 Kowalski _____
 Peltier _____


COUNTY Ottawa DATE 5/27/54
 S. R. #5 163 WEATHER Clear
 SEC. City of Pt. Clinton TEMP. _____

DESCRIPTION LEFT CENTER LINE RIGHT JOB NO.

Checked & Entered in book (OTT)

Pages 27-28
 6/29/55 Scott.


NORTH
 SR#2
 OK 2/26/58

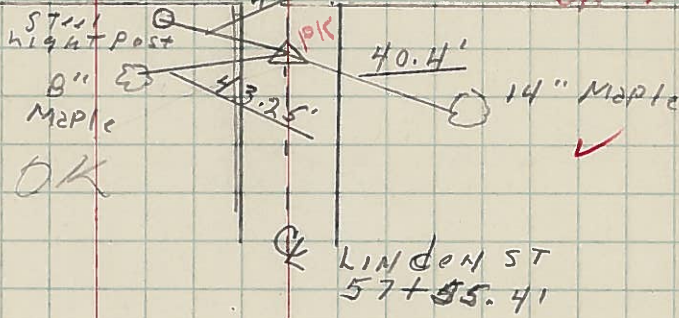

29

OK


SR#2
 OK 2/26/58

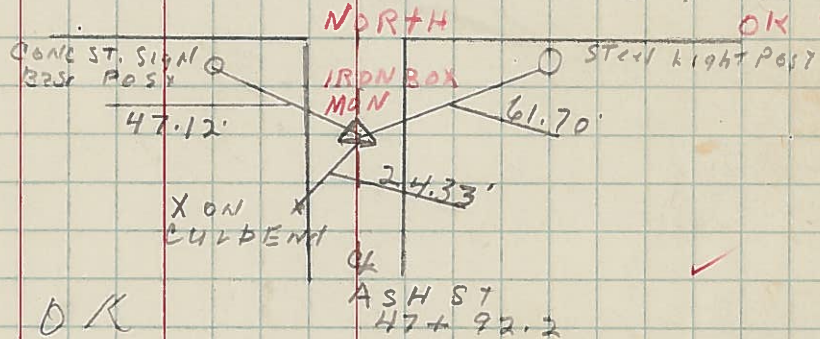

28

OK

SR#2
 Steel lamp Post OK 2/26/58

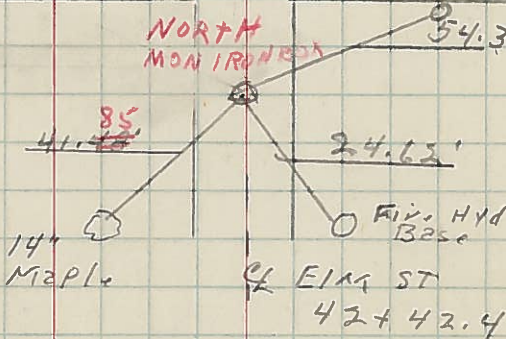

27

OK

