

PERSONNEL TITLE PERSONNEL TITLE


COUNTY Ottawa DATE 2/26/58

S. R. #2 WEATHER


SEC. Port Clinton TEMP.

DESCRIPTION LEFT CENTER LINE RIGHT JOB NO.

± S.R. #2 ± 163 ± Ash St.  
47+92.20 Mon. Box.

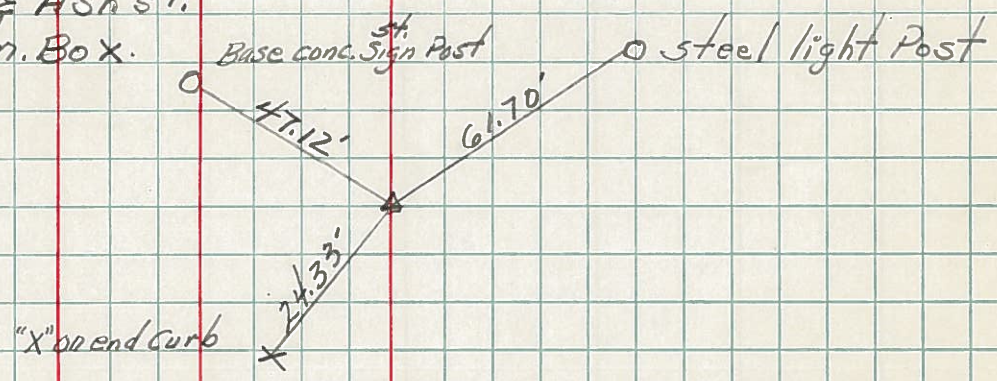


± S.R. #2 ± 163 ± Linden St.  
57+55.41

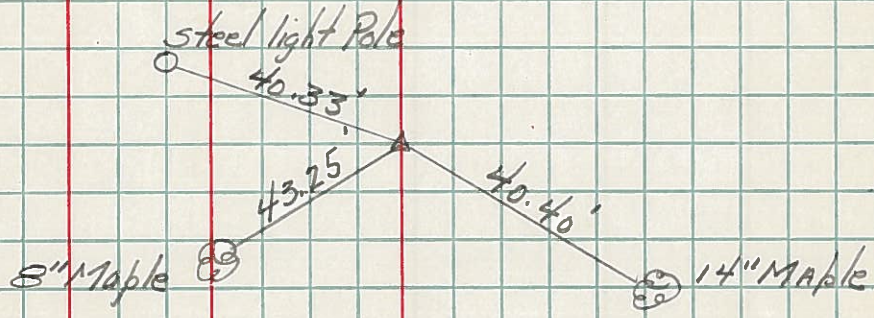

P.I. ± S.R. #163 ± S.R. #2  
P.K. NAIL ± shiner

C.B. [ ]  
"X" on S.E. COR. [ ]  
Parapet Block.

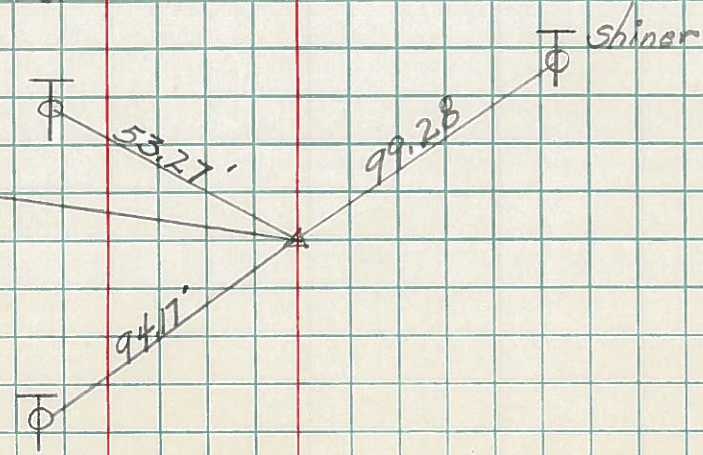

PERSONNEL TITLE PERSONNEL TITLE  
 Scott \_\_\_\_\_  
 Kowalski \_\_\_\_\_  
 Peltier \_\_\_\_\_


COUNTY Ottawa DATE 5/27/54  
 S. R. #5 163 WEATHER Clear  
 SEC. City of Pt. Clinton TEMP. \_\_\_\_\_

DESCRIPTION LEFT CENTER LINE RIGHT JOB NO.

Checked & Entered in book (OTT)

Pages 27-28  
 6/29/55 Scott.


NORTH  
 SR#2  
 OK 2/26/58

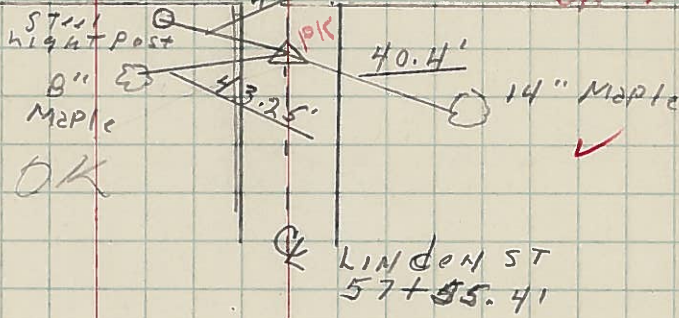

29

OK


SR#2  
 OK 2/26/58

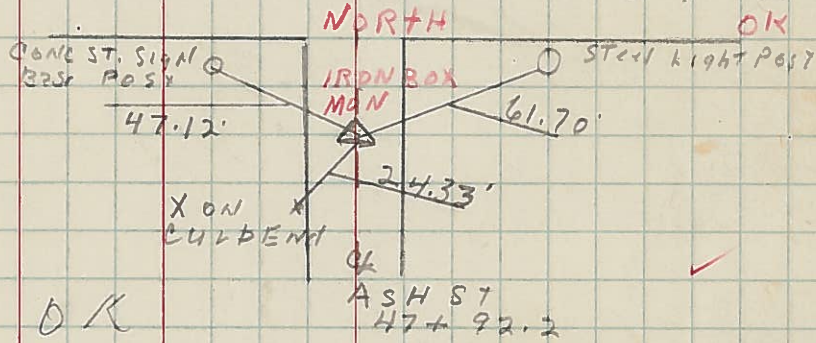

28

OK

SR#2  
 OK 2/26/58

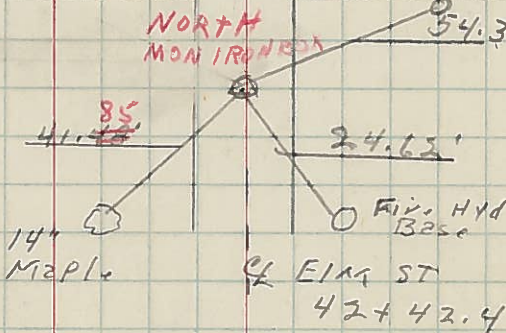

27

OK