



O.D.O.T. DISTRICT 2 SURVEY OFFICE (USE ONLY)

PERSONNEL	REFERENCE NO.	126 GA	SHEET	12	OF	22
NOTES	DATE	1968	ROUTE	SR 163		
H.C.	WEATHER	-	COUNTY	OTTAWA		
R.C.	TEMP.	-	TOWNSHIP	PORTAGE		
			SECTION	5		
			T	6 N	R	17 E

TYPE MONUMENT CNPT  
 ON SURFACE - ~~BELOW~~ ON  
 LEFT - Q PAV'T - ~~RIGHT~~ 1.42'  
 - TO - EDGE PAVEMENT  
 S.L.M. 76+09.34 = OTT.2 22.36 PLANS  
 GRID: NORTHING: - EASTING: -

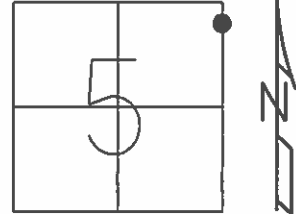

RECORD: P.C.  
 STA. 1+00  
 1968 OTT.2 22.36 PLANS  
 Q CURVE FOR BUCKEYE BLVD.

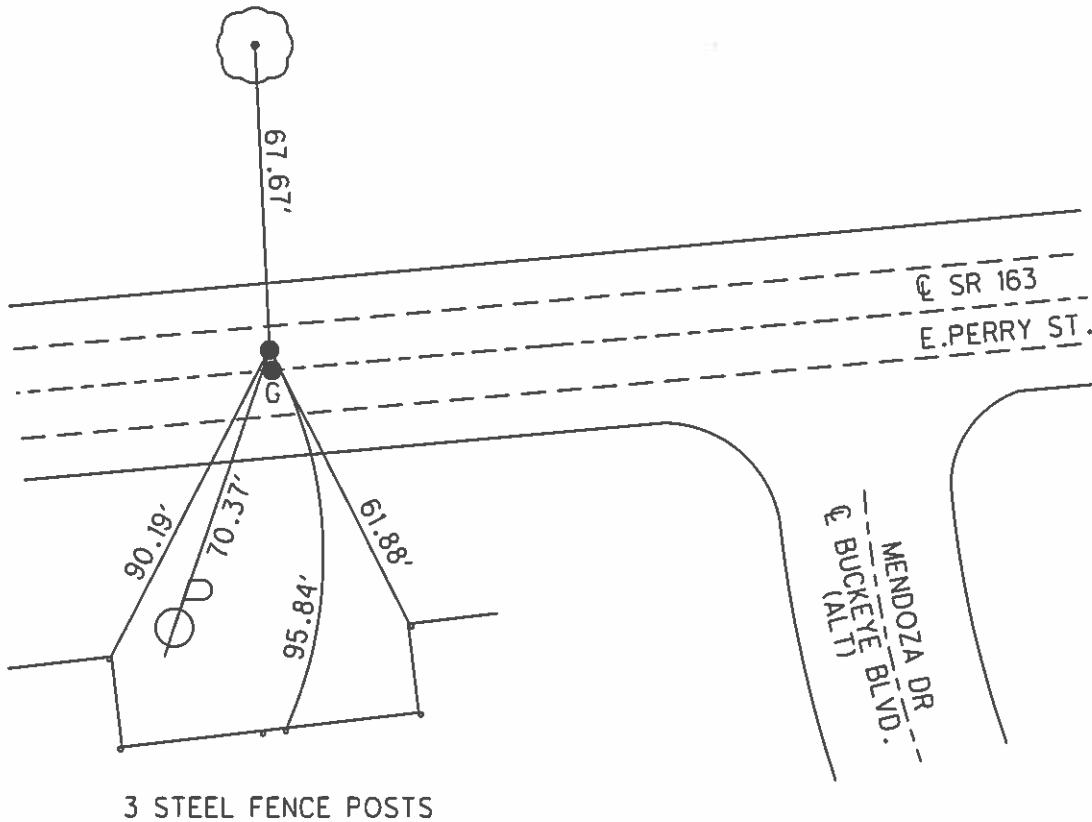

PERSONNEL TITLE PERSONNEL TITLE

COUNTY Ottawa DATE 1968

S. R. 163 WEATHER

SEC. 2236 26.77/26.82 TEMP.

DESCRIPTION Port Clinton LEFT CENTER LINE RIGHT JOB NO.

