
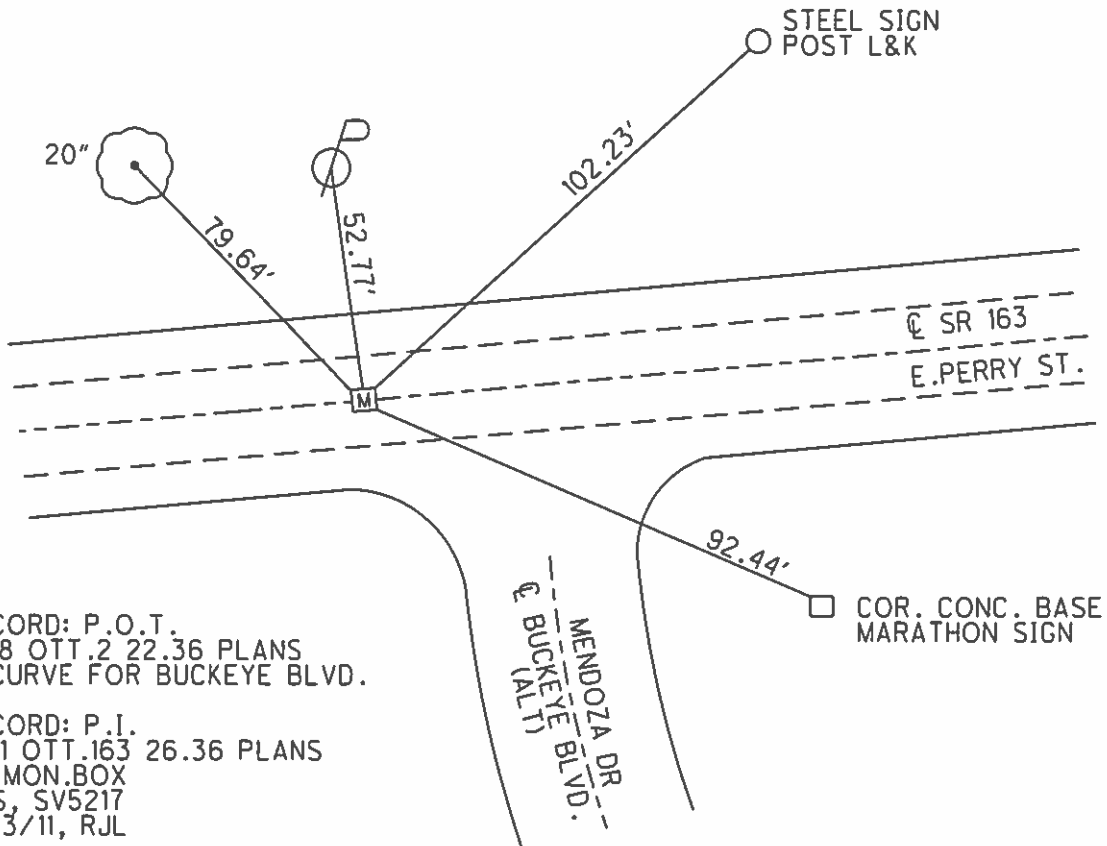


O.D.O.T. DISTRICT 2 SURVEY OFFICE (USE ONLY)

PERSONNEL	REFERENCE NO.	126 H	SHEET	13	OF	22
NOTES	DATE	1968	ROUTE	SR 163		
H.C.	WEATHER	-	COUNTY	OTTAWA		
R.C.	TEMP.	-	TOWNSHIP	PORTAGE		
			SECTION	5		
			T	6	N	R
						17
						E

TYPE MONUMENT MON.BOX
 ON SURFACE - ~~BELOW~~ ON
 LEFT - Q PAV'T - RIGHT ON
- TO - EDGE PAVEMENT
 S.L.M. 1413+18.41, 78+82.61 = OTT.2 22.36 PLANS
 GRID: NORTHING: 673563.334 EASTING: 1855023.089

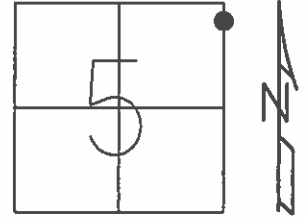

RECORD: P.O.T.
 1968 OTT.2 22.36 PLANS
 Q CURVE FOR BUCKEYE BLVD.

RECORD: P.I.
 2011 OTT.163 26.36 PLANS
 FD MON.BOX
 GPS, SV5217
 10/3/11, RJL


PERSONNEL TITLE PERSONNEL TITLE

COUNTY Ottawa DATE 1968

S. R. 163 WEATHER

SEC. 22.36 26.77/26.82 TEMP.

DESCRIPTION Port Clinton LEFT CENTER LINE RIGHT JOB NO.

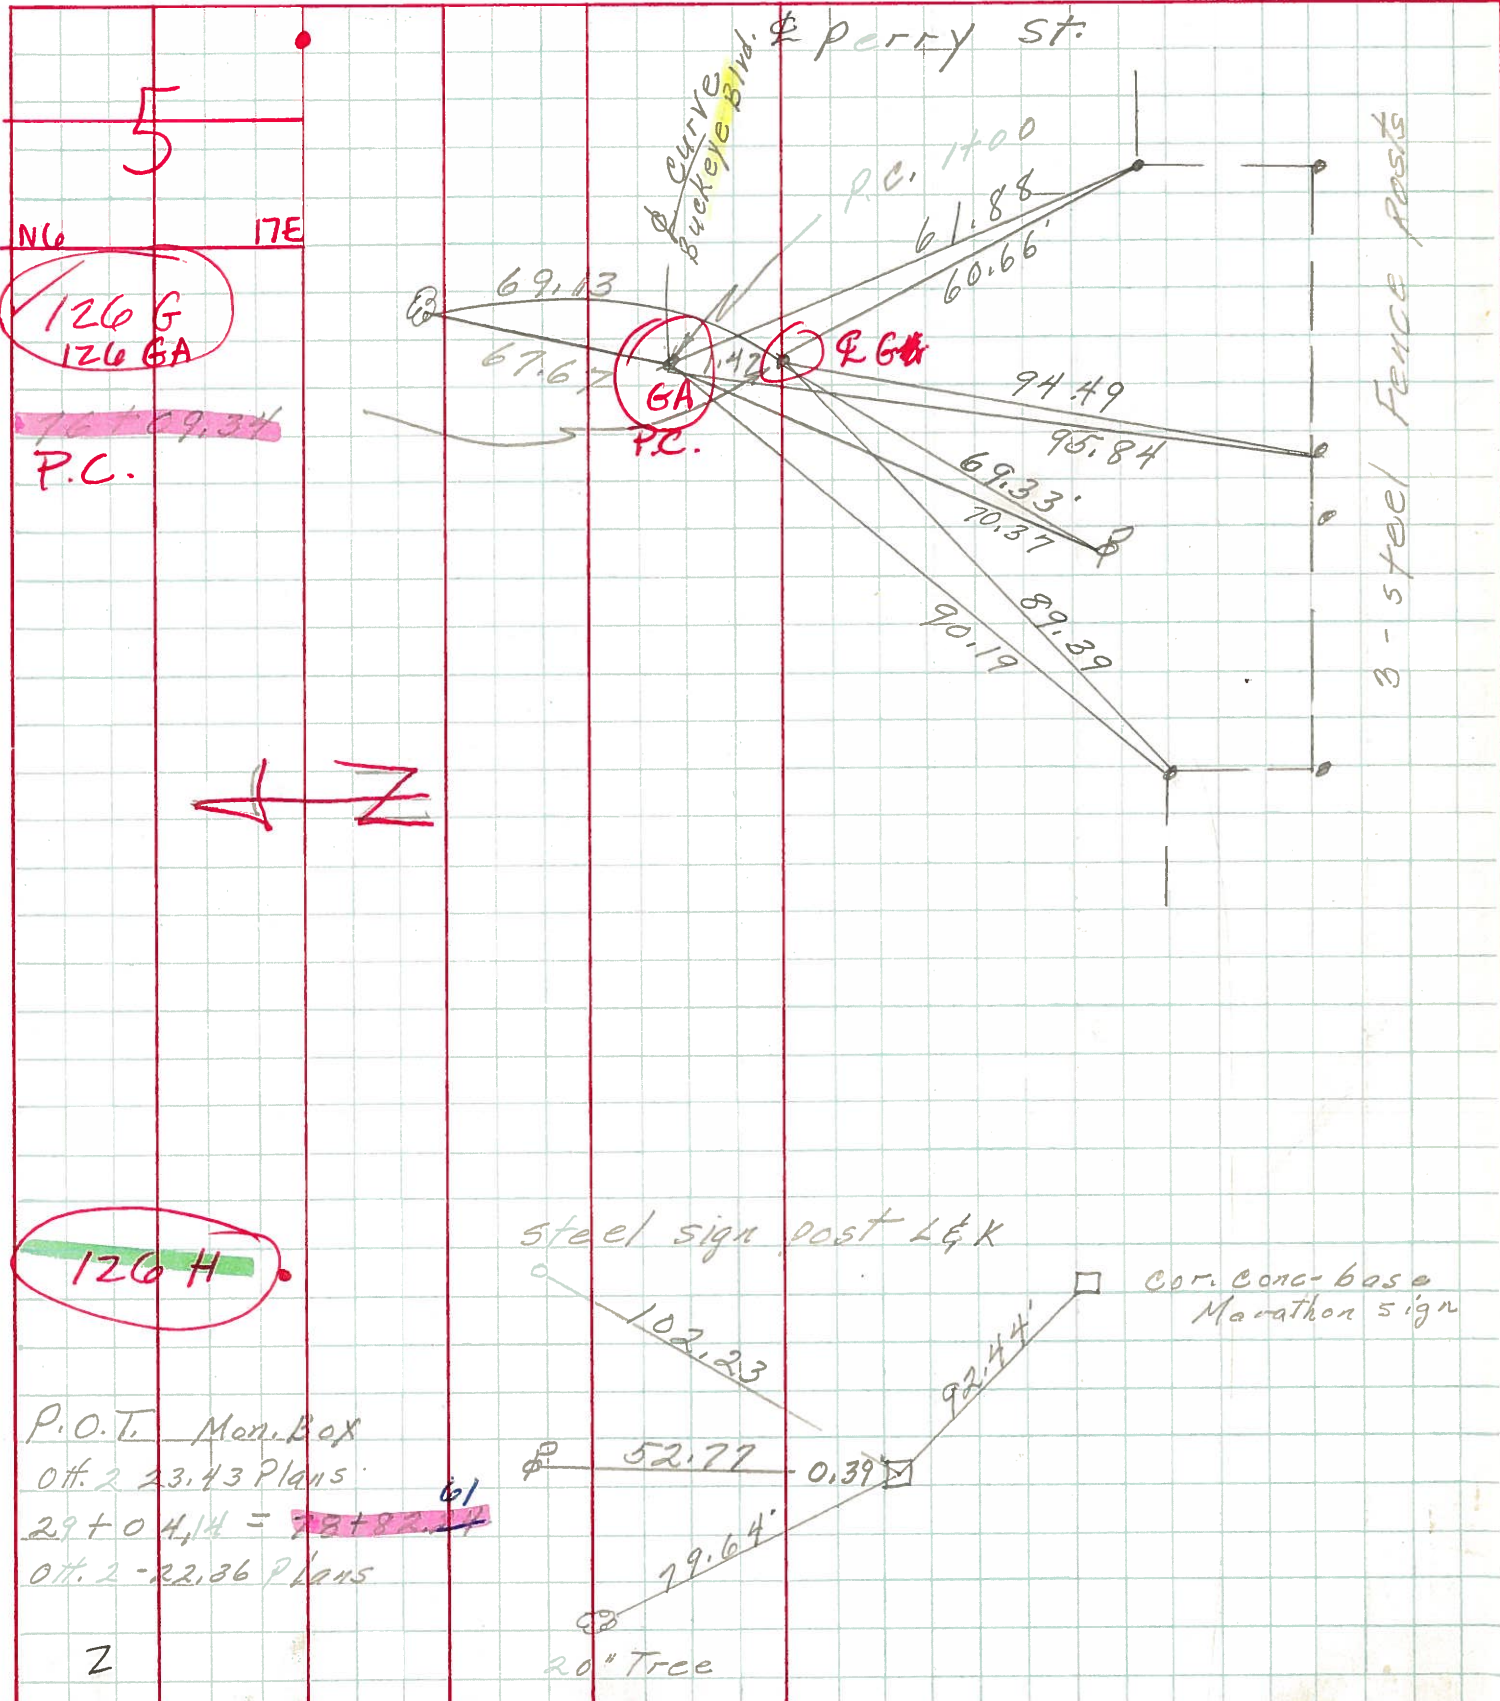

5

126 G
126 GA

~~69.34~~

P.C.



126 H

P.O.T. Man. Box
Off. 2 23.43 Plans
29+04.14 = ~~28+82.14~~
Off. 2-22.36 Plans

Z

steel sign post L&K

102.23

92.44'

52.77

0.39

79.64'

20" Tree

Cor. Conc. base
Marathon sign

3-steel fence posts