
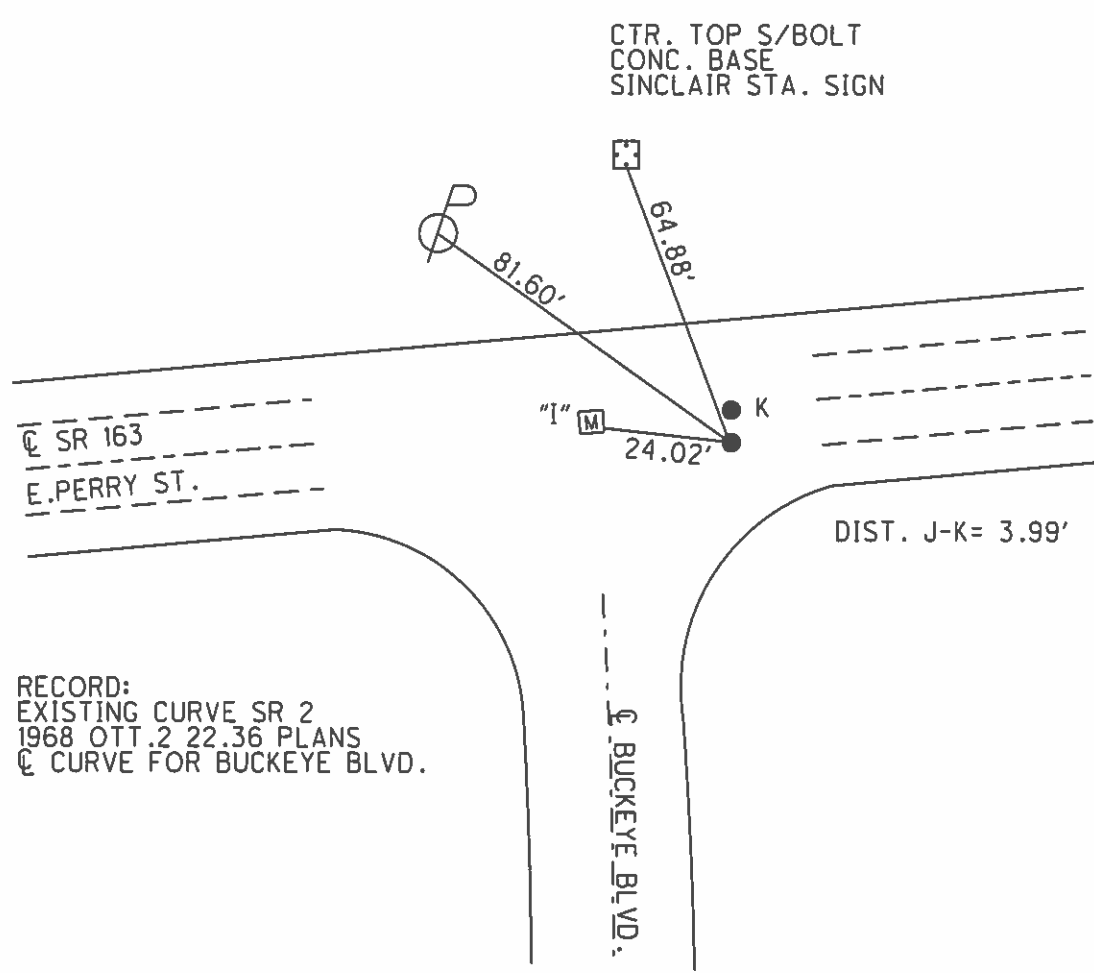


O.D.O.T. DISTRICT 2 SURVEY OFFICE (USE ONLY)

PERSONNEL _____	REFERENCE NO. <u>126 J</u>	SHEET <u>15</u> OF <u>22</u>
NOTES - _____	DATE <u>1968</u>	ROUTE <u>SR 163</u>
H.C. - _____	WEATHER <u>-</u>	COUNTY <u>OTTAWA</u>
R.C. - _____	TEMP. <u>-</u>	TOWNSHIP <u>PORTAGE</u>
_____	_____	SECTION <u>4</u>
_____	_____	T <u>6</u> N R <u>17</u> E

TYPE MONUMENT CNPT
 ON SURFACE - ~~BELOW~~ ON
~~LEFT~~ - Q PAV'T - RIGHT 3.99'
- TO - EDGE PAVEMENT
 S.L.M. 82+49.99 = OTT.2 22.36 PLANS
 GRID: NORTHING: - EASTING: -

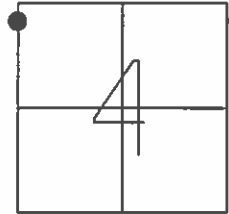

CTR. TOP S/BOLT
 CONC. BASE
 SINCLAIR STA. SIGN

Q SR 163
E. PERRY ST.

DIST. J-K = 3.99'

RECORD:
 EXISTING CURVE SR 2
 1968 OTT.2 22.36 PLANS
Q CURVE FOR BUCKEYE BLVD.

Q BUCKEYE BLVD.

PERSONNEL TITLE PERSONNEL TITLE

COUNTY Ottawa DATE 1968

S. R. 163 WEATHER

SEC. 22.36 TEMP.

DESCRIPTION Port Clinton JOB NO.

LEFT CENTER LINE RIGHT

