

O.D.O.T. DISTRICT 2 SURVEY OFFICE (USE ONLY)

PERSONNEL

REFERENCE NO. 128 B

SHEET 6 OF 17

NOTES CHENEY

DATE 6/11/93

ROUTE SR 163

H.C. RIPPLE

WEATHER SUNNY

COUNTY OTTAWA

R.C. BARBOUR

TEMP. 75°

TOWNSHIP PORTAGE

GEYMAN

SECTION 34

DWG BY NIESE PID 107919

T 7 N R 17 E

TYPE MONUMENT D.N.F.

ON SURFACE - BELOW -


OFFSET \odot PAVEMENT - LT : RT

- TO - EDGE PAVEMENT


STATION: 1501+92.15

HORZ.DATUM: _____ GEOID: _____

GRID: NORTHING: _____ EASTING: _____

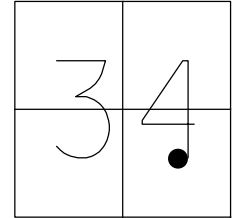


RECORD: P.I.
 $\Delta = 25^\circ 59' LT$
STA. 99+00.70
POINT WAS NEVER RESET
6/11/93, JLR
D.N.F.
9/17/18, JFO

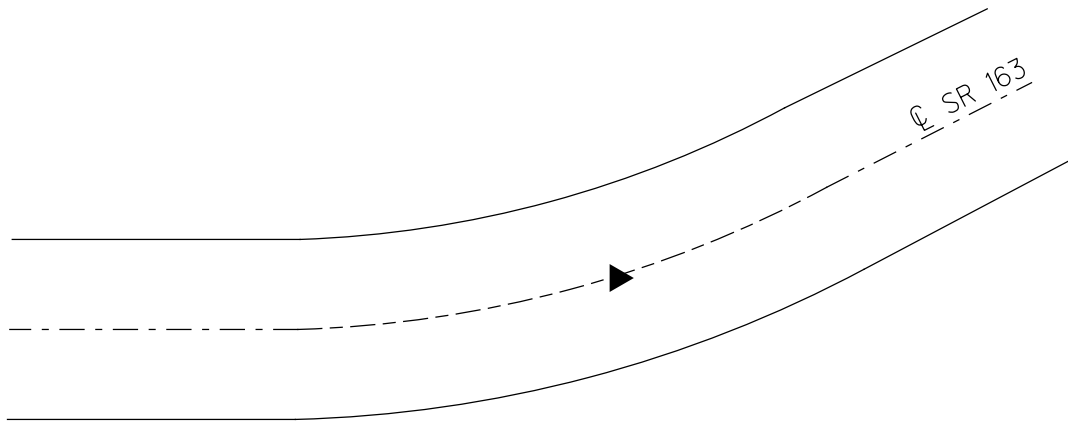

O.D.O.T. DISTRICT 2 SURVEY OFFICE (USE ONLY)


PERSONNEL _____ REFERENCE NO. 128 B SHEET 6 OF 18
NOTES CHENEY DATE 6/11/93 ROUTE SR 163
H.C. RIPPLE WEATHER SUNNY COUNTY OTTAWA
R.C. BARBOUR TEMP. 75° TOWNSHIP PORTAGE
GEYMAN SECTION 34
T 7 N R 17 E

TYPE MONUMENT D.N.F.
ON SURFACE - BELOW -
LEFT - ☉ PAV'T - RIGHT -
- TO - EDGE PAVEMENT
S.L.M. 1501+92 .15

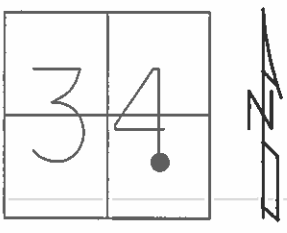

GRID: NORTHING: _____ EASTING: _____

RECORD: P.I.
 $\Delta = 25^\circ 59' \text{ LT}$
STA. 99+00.70
POINT WAS NEVER RESET
6/11/93, JLR

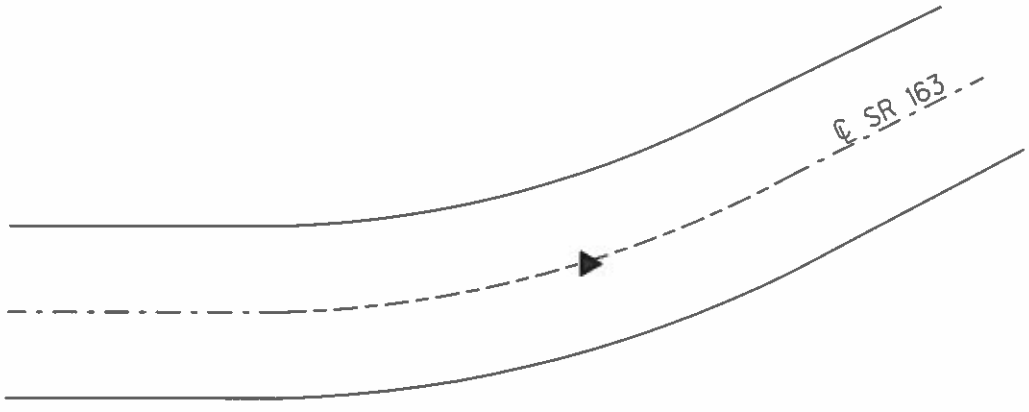

O.D.O.T. DISTRICT 2 SURVEY OFFICE (Use Only)

PERSONNEL

REFERENCE NO. 128 B

SHEET 6 OF 18

NOTES Cheney

DATE 6-11-1993

ROUTE SR 163

H.C. Ripple

WEATHER Sunny

COUNTY OTTAWA

R.C. Barbour

TEMP. 75°

TOWNSHIP PORTAGE

Geyman

SECTION 34

T 7 N R 17 E

TYPE MONUMENT Out


ON SURFACE - BELOW _____

LEFT - CL PAV'T - RIGHT _____

_____ TO _____ EDGE PAVEMENT


S.L.M. 1501+92 .15

Grid: Northing: _____ Easting: _____

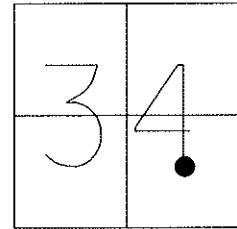

Record: 9-16-1985
P.I. Δ = 25° 59' LT.
99+00.70
Will Set When Time Permits

Note: Point was never reset.
6-11-1993 J.L.R.

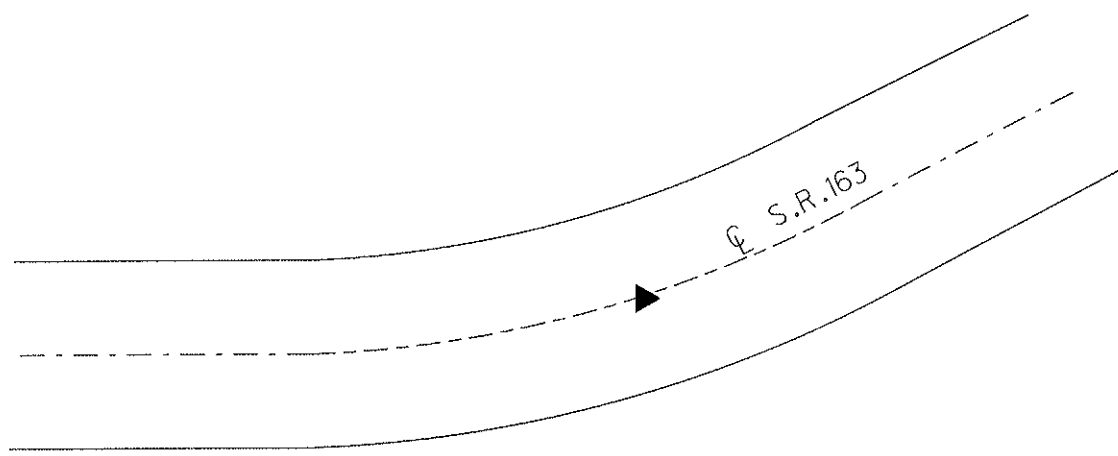

Research Old Ties
and Plans

O.D.O.T. DISTRICT 2 SURVEY OFFICE

PERSONNEL

REFERENCE NO. 128 B
~~10~~

SHEET 10 OF 23

NOTES CHENEY

H.C. RIPPLE

R.C. BARBOUR

Geyman

DATE 6-11-1993

WEATHER SUNNY

TEMP. 75°

ROUTE SR#163

COUNTY OTTAWA

TOWNSHIP PORTAGE

SECTION 34

T 7 N R 17 E


TYPE MONUMENT OUT

ON SURFACE - BELOW _____

LEFT - & PAV'T. - RIGHT _____

_____ TO _____ EDGE PAVEMENT

S.L.M. 1501+92.15

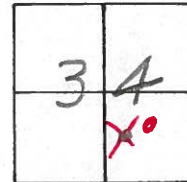


Record: 9-16-1985

P.I. Δ = 25° 59' LT.

99+00.70

Will Set when Time Permits

Note: Paint was never
Reset, 6-11-1993 J.L.R.

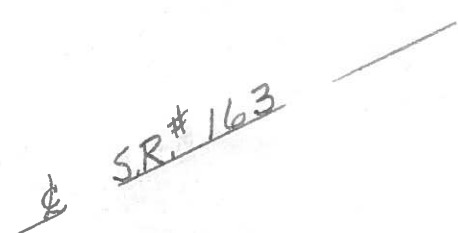

Research old tie
and plans.

O.D.O.T. DISTRICT 2 SURVEY OFFICE

PERSONNEL

NOTES CROWN
H.C. RIPPLE
R.C. BARBOUR
GEYMAN


REFERENCE NO. 10

DATE 9/16/85
WEATHER SUNNY
TEMP. 65°


SHEET 10 OF

ROUTE #163
COUNTY OTTAWA
TOWNSHIP PORTAGE
SECTION
T 7 N R 17 E

TYPE MONUMENT OUT
ON SURFACE - BELOW
LEFT- & PAV'T. - RIGHT
 TO EDGE PAVEMENT
S.L.M.

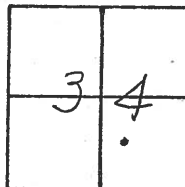

1288

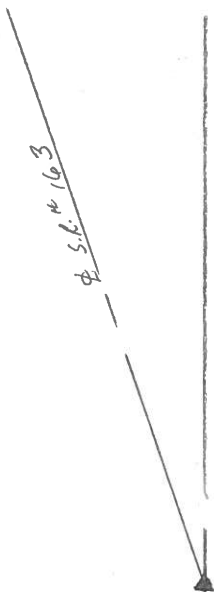


P.I. $\Delta = 25^{\circ} 59' \text{ Lt.}$

99+00.70

Will SET WHEN TIME PERMITS

PERSONNEL TITLE PERSONNEL TITLE COUNTY Ottawa DATE 3-2-70
Schneider _____
Mosser _____ S. R. 163 WEATHER Cloudy
Potts _____
 SEC Port Clinton-East TEMP. 35°

DESCRIPTION Ties for Control Points JOB NO. _____

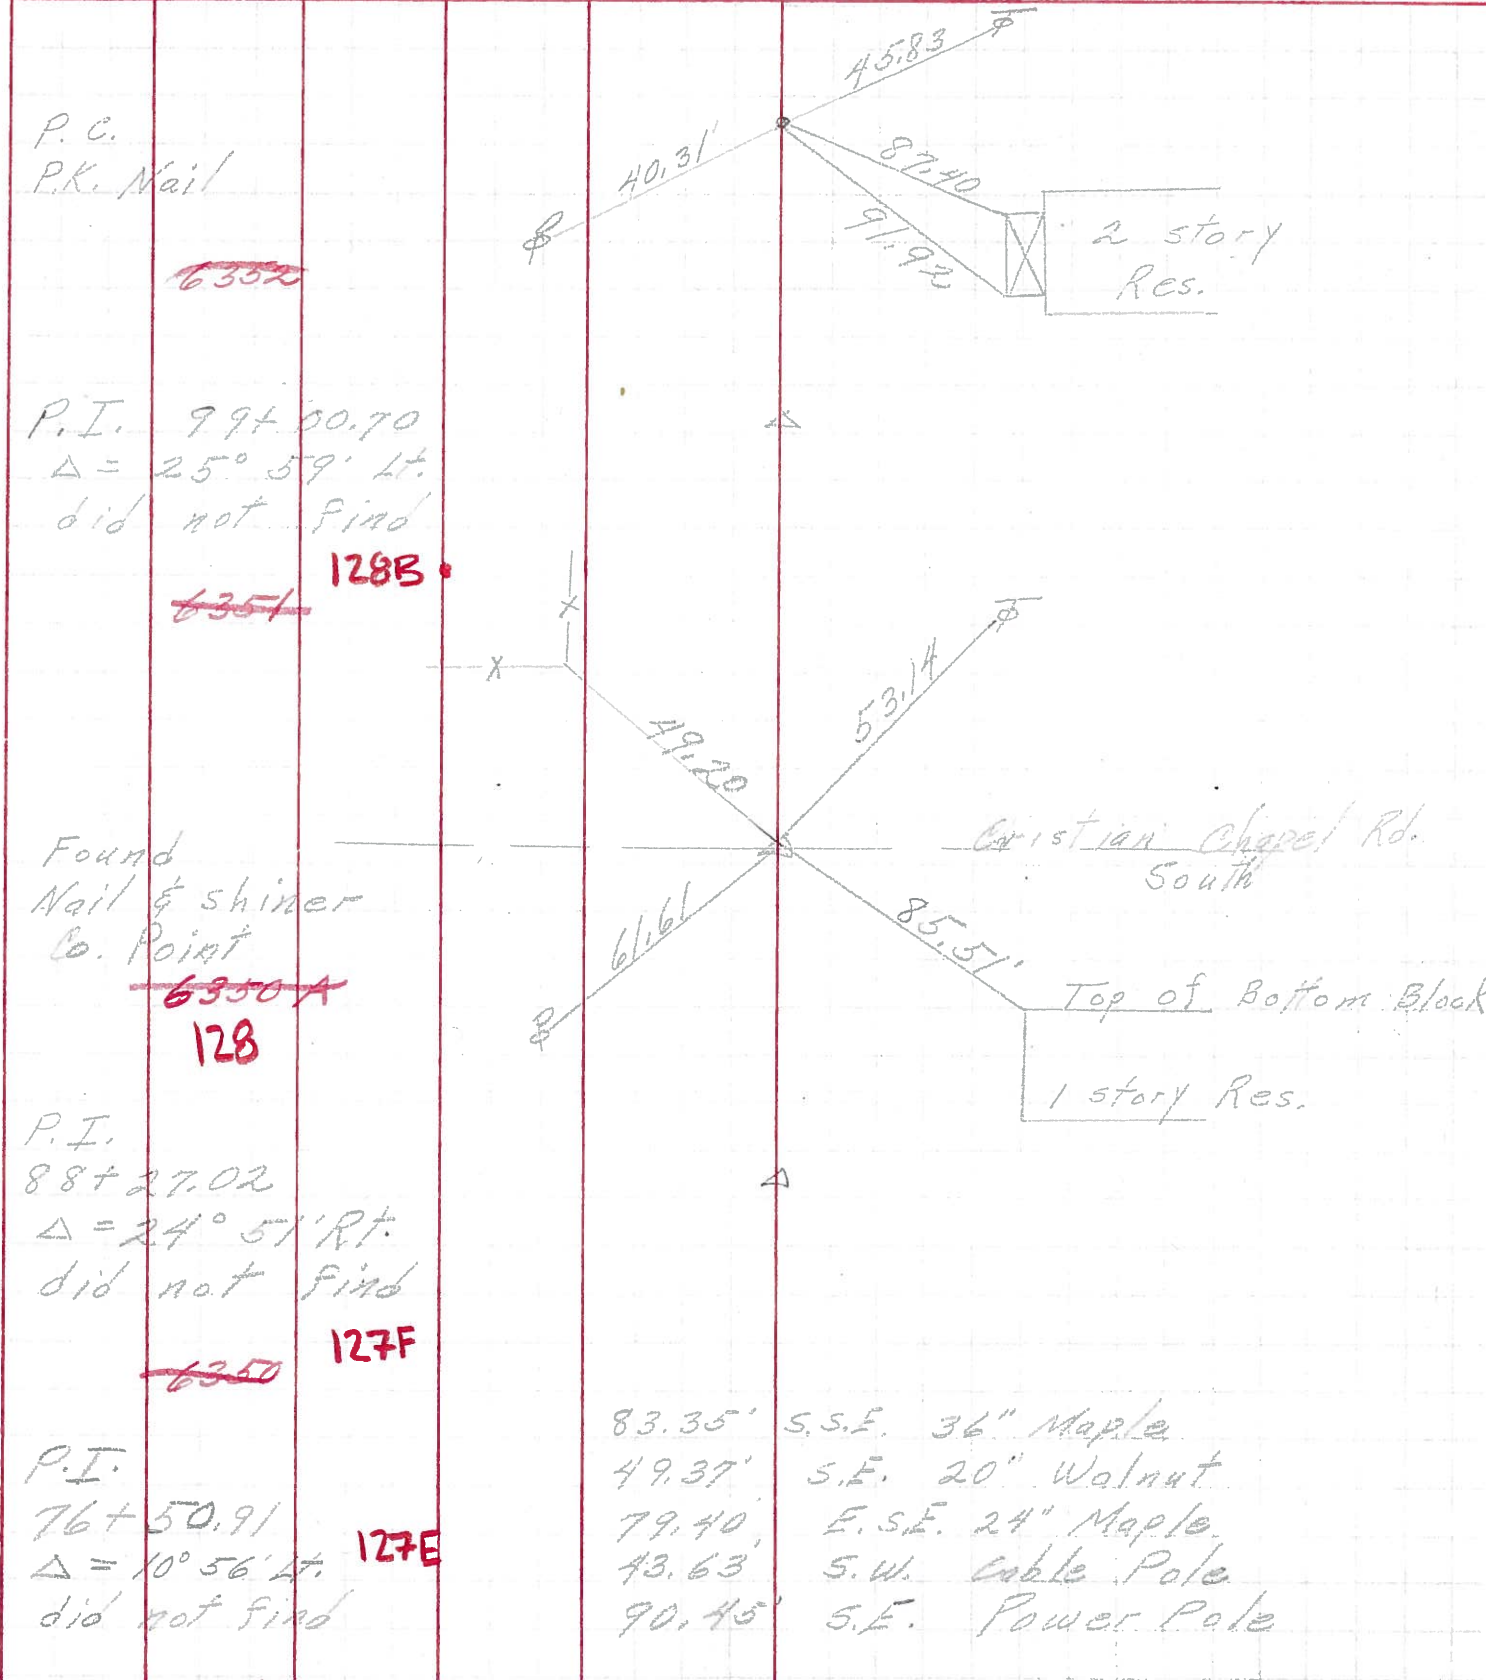

PERSONNEL	TITLE	PERSONNEL	TITLE	COUNTY	DATE	S. R.	WEATHER	TEMP.
Schneider		Potts		Ottawa	9-4-68	163	75°	Fair
Mosser								
Barbour								
Redding								

DESCRIPTION Ties for Control Points JOB NO. _____

