

O.D.O.T. DISTRICT 2 SURVEY OFFICE (USE ONLY)

PERSONNEL

REFERENCE NO. 129 A

SHEET 13 OF 17

NOTES CHENEY DATE 6/10/93
 H.C. RIPPLE WEATHER CLOUDY
 R.C. BARBOUR TEMP. 80°
GEYMAN

ROUTE SR 163
 COUNTY OTTAWA
 TOWNSHIP PORTAGE
 SECTION 35

DWG BY NIESE PID 107060

T 7 N R 17 E

TYPE MONUMENT MONBOX W/PUNCH HOLE IN "+"

ON SURFACE - ~~BELOW~~ ON


OFFSET ☐ PAVEMENT ON _____ LT : RT

28.0' TO LT EDGE PAVEMENT


STATION: 1574+21

HORZ. DATUM: _____ - _____ GEOID: _____ - _____

GRID: NORTHING: _____ - _____ EASTING: _____ - _____

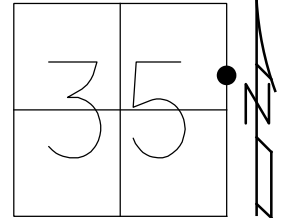

RECORD: P.C.
 STA. 171+22.05
 FD MONBOX
 W/PUNCH HOLE IN "+"
 ON LID
 9/16/85, CRONIN
 6/10/93, CHENEY

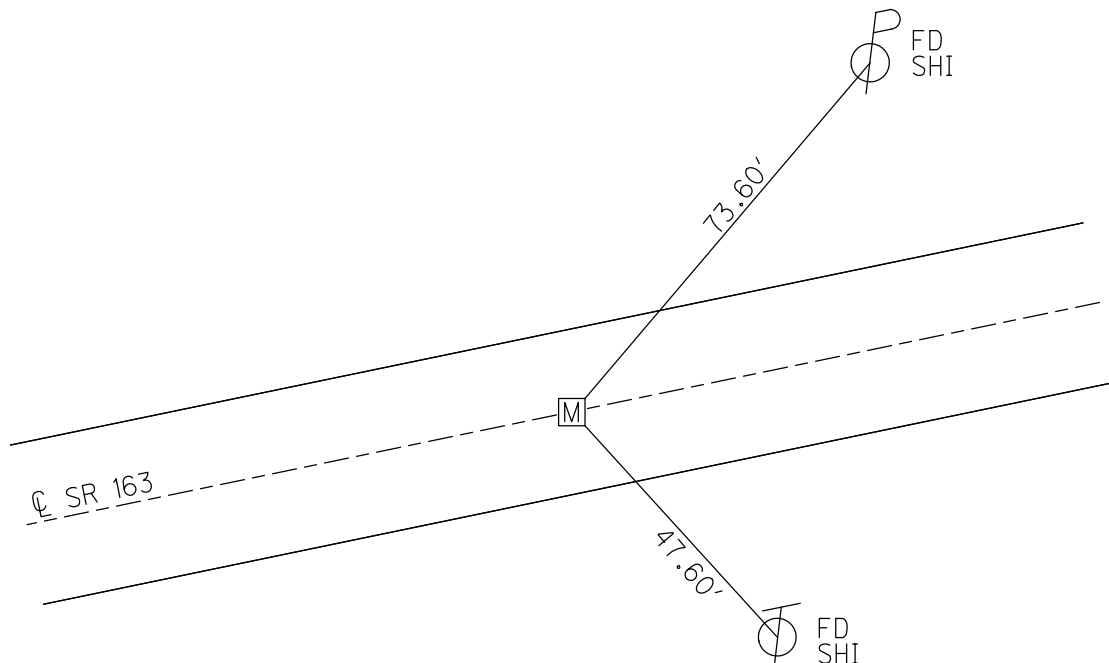

O.D.O.T. DISTRICT 2 SURVEY OFFICE (USE ONLY)

PERSONNEL _____ REFERENCE NO. 129 A SHEET 14 OF 18
NOTES CHENEY DATE 6/10/93 ROUTE SR 163
H.C. RIPPLE WEATHER CLOUDY COUNTY OTTAWA
R.C. BARBOUR TEMP. 80° TOWNSHIP PORTAGE
GEYMAN SECTION 35
T 7 N R 17 E

TYPE MONUMENT MON BOX W/PUNCH HOLE IN "+"


ON SURFACE - ~~BELOW~~ ON

LEFT - ☉ PAV'T - RIGHT ON


28' TO LT EDGE PAVEMENT

S.L.M. 1574+21

GRID: NORTHING: _____ EASTING: _____

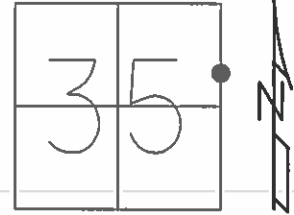

RECORD: P.C.
9/16/85
MEASURED TO CTR
OF MONBOX
6/10/93

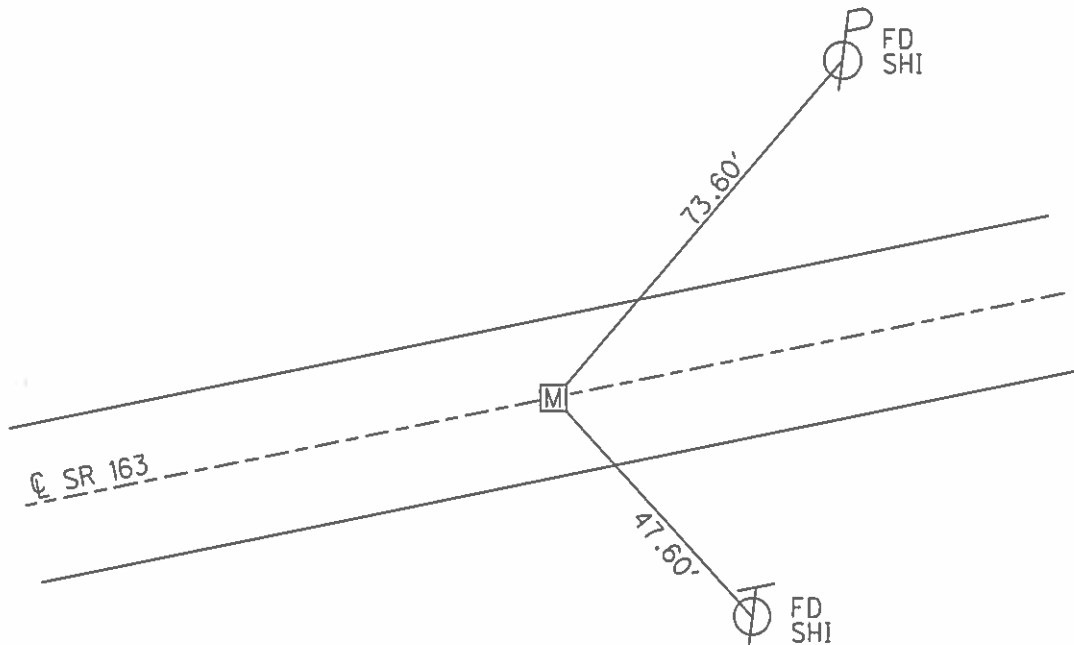

O.D.O.T. DISTRICT 2 SURVEY OFFICE (Use Only)

PERSONNEL _____

REFERENCE NO. 129 A

SHEET 14 OF 18

NOTES Cheney

DATE 6-10-1993

ROUTE SR 163

H.C. Ripple

WEATHER Cloudy

COUNTY OTTAWA

R.C. Barbour

TEMP. 80°

TOWNSHIP PORTAGE

Geyman

SECTION 35

T 7 N R 17 E

TYPE MONUMENT Fd. Mon. Box w/Punch Hole in "+"


ON SURFACE - ~~BELOW~~ On Surface

~~LEFT~~ - CL PAV'T - ~~RIGHT~~ CL Pav'T

28' TO LT. EDGE PAVEMENT


S.L.M. 1574+21

Grid: Northing: _____ Easting: _____

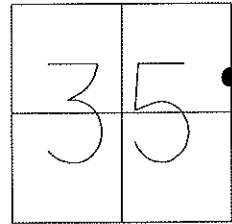

Record: 9-16-1985

P.C. 171+22.05 (SR#53)

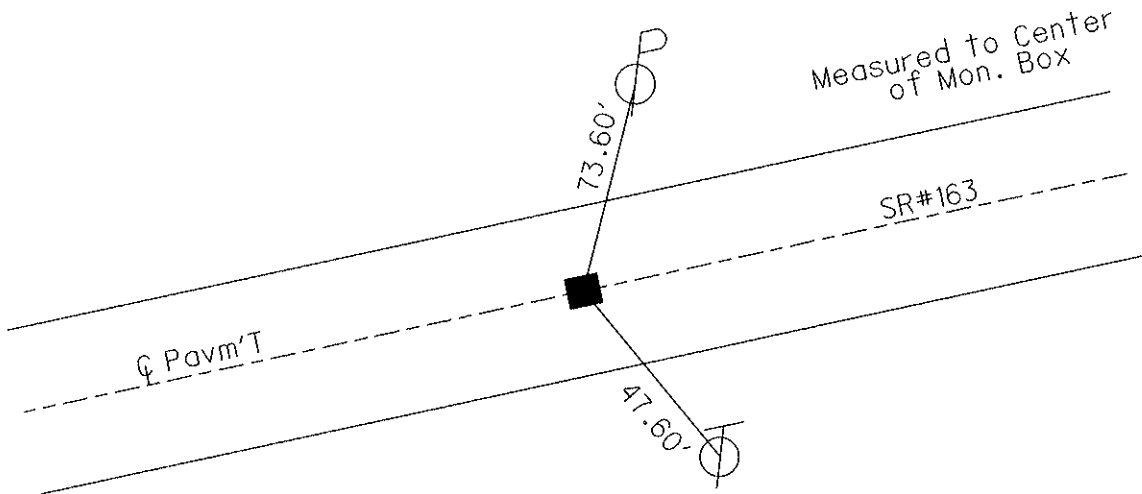

O.D.O.T. DISTRICT 2 SURVEY OFFICE

PERSONNEL

REFERENCE NO. 129 A

SHEET 17 OF 23

NOTES CHENEY

H.C. RIPPLE

R.C. BARBOUR

GEYMAN

DATE 6-10-1993

WEATHER Cloudy

TEMP. 80°

ROUTE SR#163

COUNTY OTTAWA

TOWNSHIP Portage

SECTION 35

T7 N R 17 E


TYPE MONUMENT Fd. Mon. Box w/Punch Hole in "+"

ON SURFACE - ~~BELOW~~ ON SURFACE

~~LEFT - & PAV'T. - RIGHT~~ & PAV'T.


28' TO LT. EDGE PAVEMENT

S.L.M. 1574 + 21

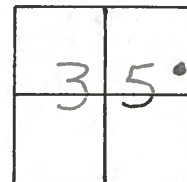

Record: 9-16-1985

P.C. 171 + 22.05

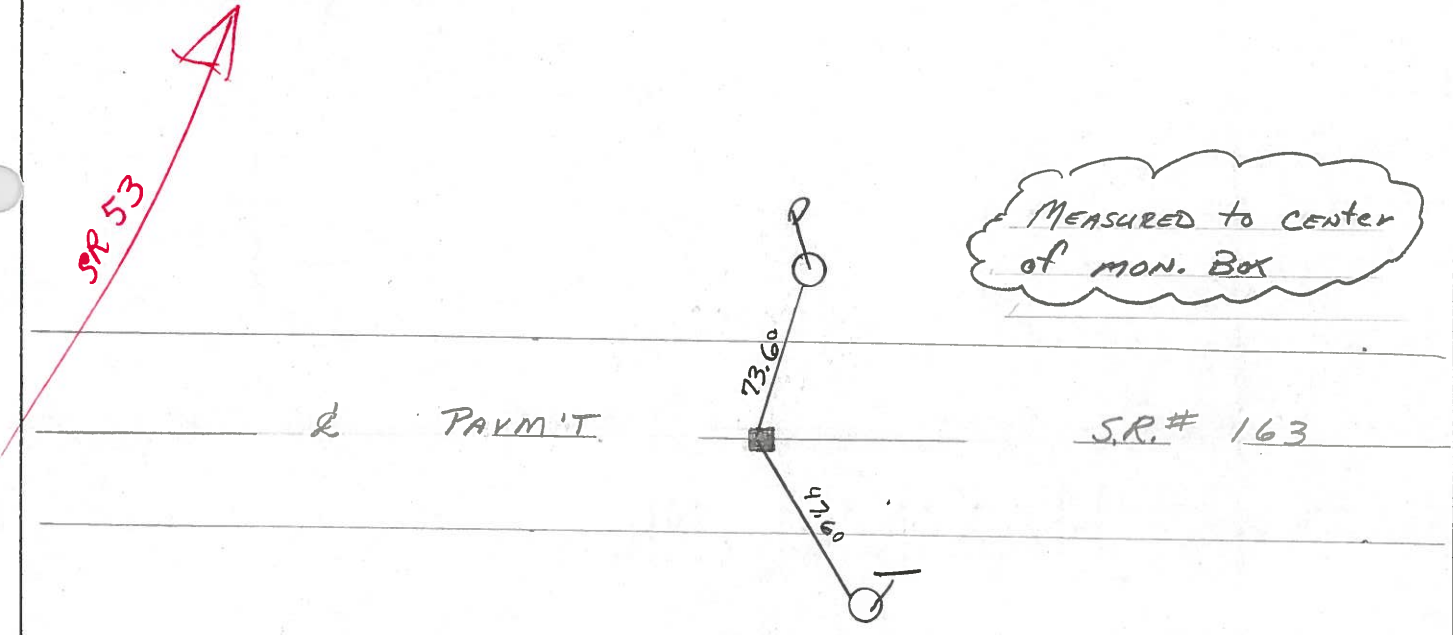

O.D.O.T. DISTRICT 2 SURVEY OFFICE

PERSONNEL

REFERENCE NO. _____ SHEET 17 OF _____

NOTES CROWIN

H.C. RIPPLE

R.C. BARBOUR

GEYMAN

DATE 9/16/85

WEATHER SUNNY

TEMP. 75°

ROUTE #163

COUNTY OTTAWA

TOWNSHIP PORTAGE

SECTION 35

T. 2 N. R. 17 E.


TYPE MONUMENT Mon Box

ON SURFACE - BELOW ON SURFACE

LEFT- & PAVT. - RIGHT & PAVT.

_____ TO _____ EDGE PAVEMENT

S.L.M. _____

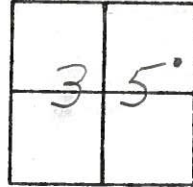

129A



P.C.

171+22.05