

O.D.O.T. DISTRICT 2 SURVEY OFFICE

PERSONNEL

REFERENCE NO. 131C


SHEET 25 OF     

NOTES Cronin  
H.C. RIPPLE  
R.C. BARBOUR  
GEYMAN


DATE 9/17/85  
WEATHER SUNNY  
TEMP. 75°

ROUTE #163  
COUNTY OTTAWA  
TOWNSHIP DANBURY  
SECTION       
T      R     

TYPE MONUMENT P.K. & WATER HOP P.K.  
ON SURFACE - BELOW ON SURFACE  
LEFT - & PAV'T. - RIGHT & PAVT.  
TO      EDGE PAVEMENT  
S.L.M.     

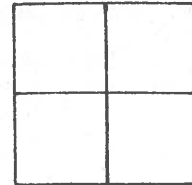

P.C.  
294 + 15.38

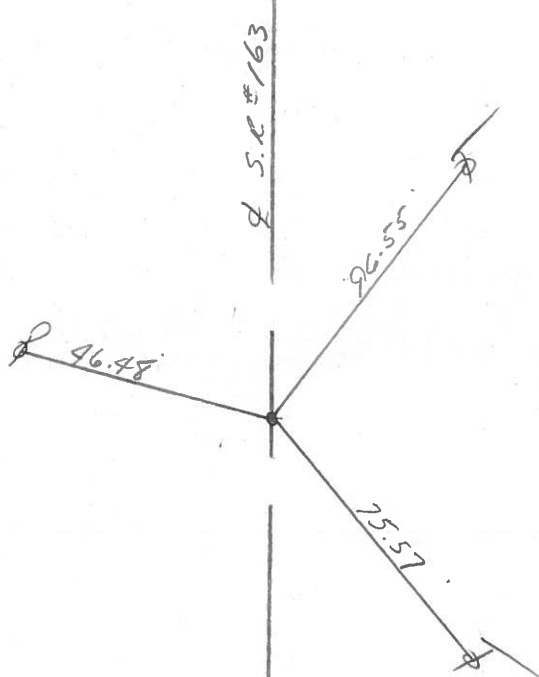



PERSONNEL	TITLE	PERSONNEL	TITLE
Schneider			
Mosser			
Redding			
Potts			

COUNTY Ottawa DATE 9-5-68  
 S. R. 163 WEATHER cloudy - Rain  
 SEC. Port Clinton - East TEMP. 75°

DESCRIPTION Ties for Control Points JOB NO. \_\_\_\_\_

