

O.D.O.T. DISTRICT 2 SURVEY OFFICE

PERSONNEL



REFERENCE NO. 131 D SHEET 26 OF     

NOTES CROWIN  
H.C. RIPPLE  
R.C. BARBOUR  
COYMAN

DATE 9/17/85  
WEATHER SUNNY  
TEMP. 78°

ROUTE #163  
COUNTY OTTAWA  
TOWNSHIP DANBURY  
SECTION       
T      R     

TYPE MONUMENT P.K. WASHER ATOP R.K. WASHER  
ATOP R.R. SPIKE  
ON SURFACE - BELOW ON SURFACE  
LEFT - ¢ PAV'T. - RIGHT 9' 4. & PUT  
TO      EDGE PAVEMENT  
S.L.M.     

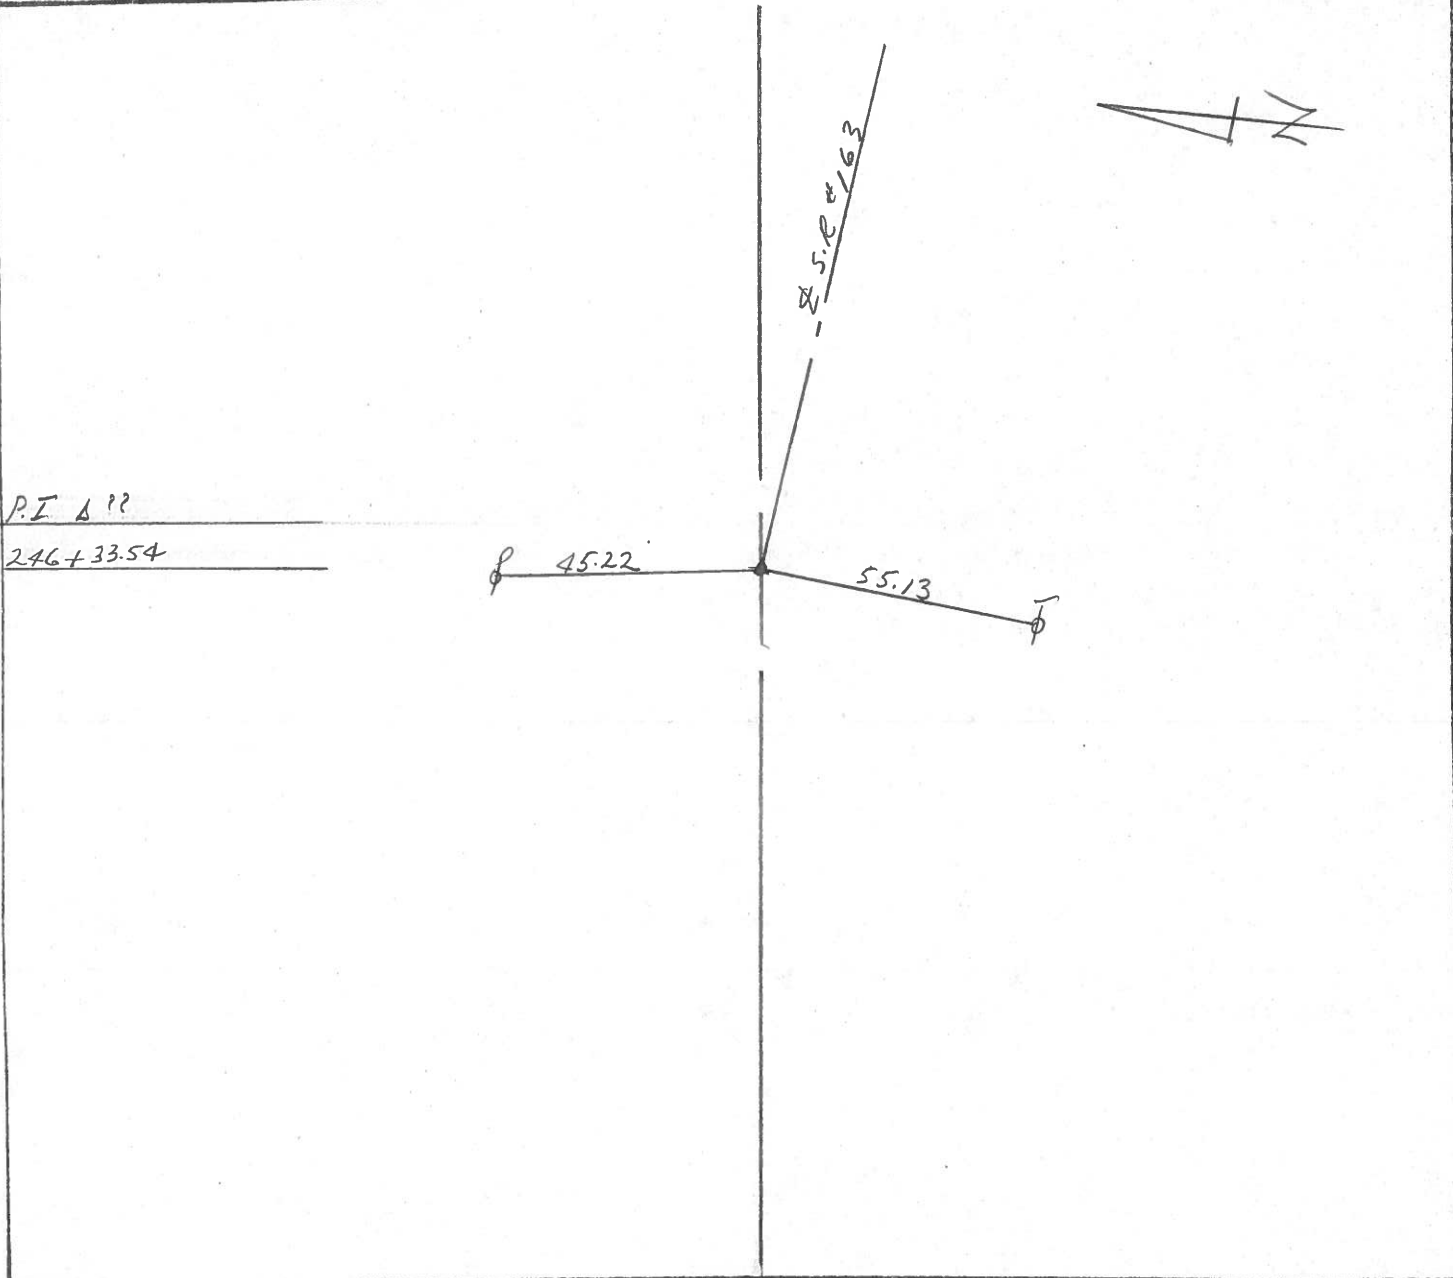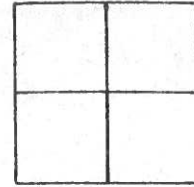


PERSONNEL TITLE PERSONNEL TITLE

COUNTY Ottawa DATE 6-12-69

S. R. 163 WEATHER \_\_\_\_\_

SEC. 4 TEMP. \_\_\_\_\_

DESCRIPTION Danbury Twp. JOB NO. \_\_\_\_\_

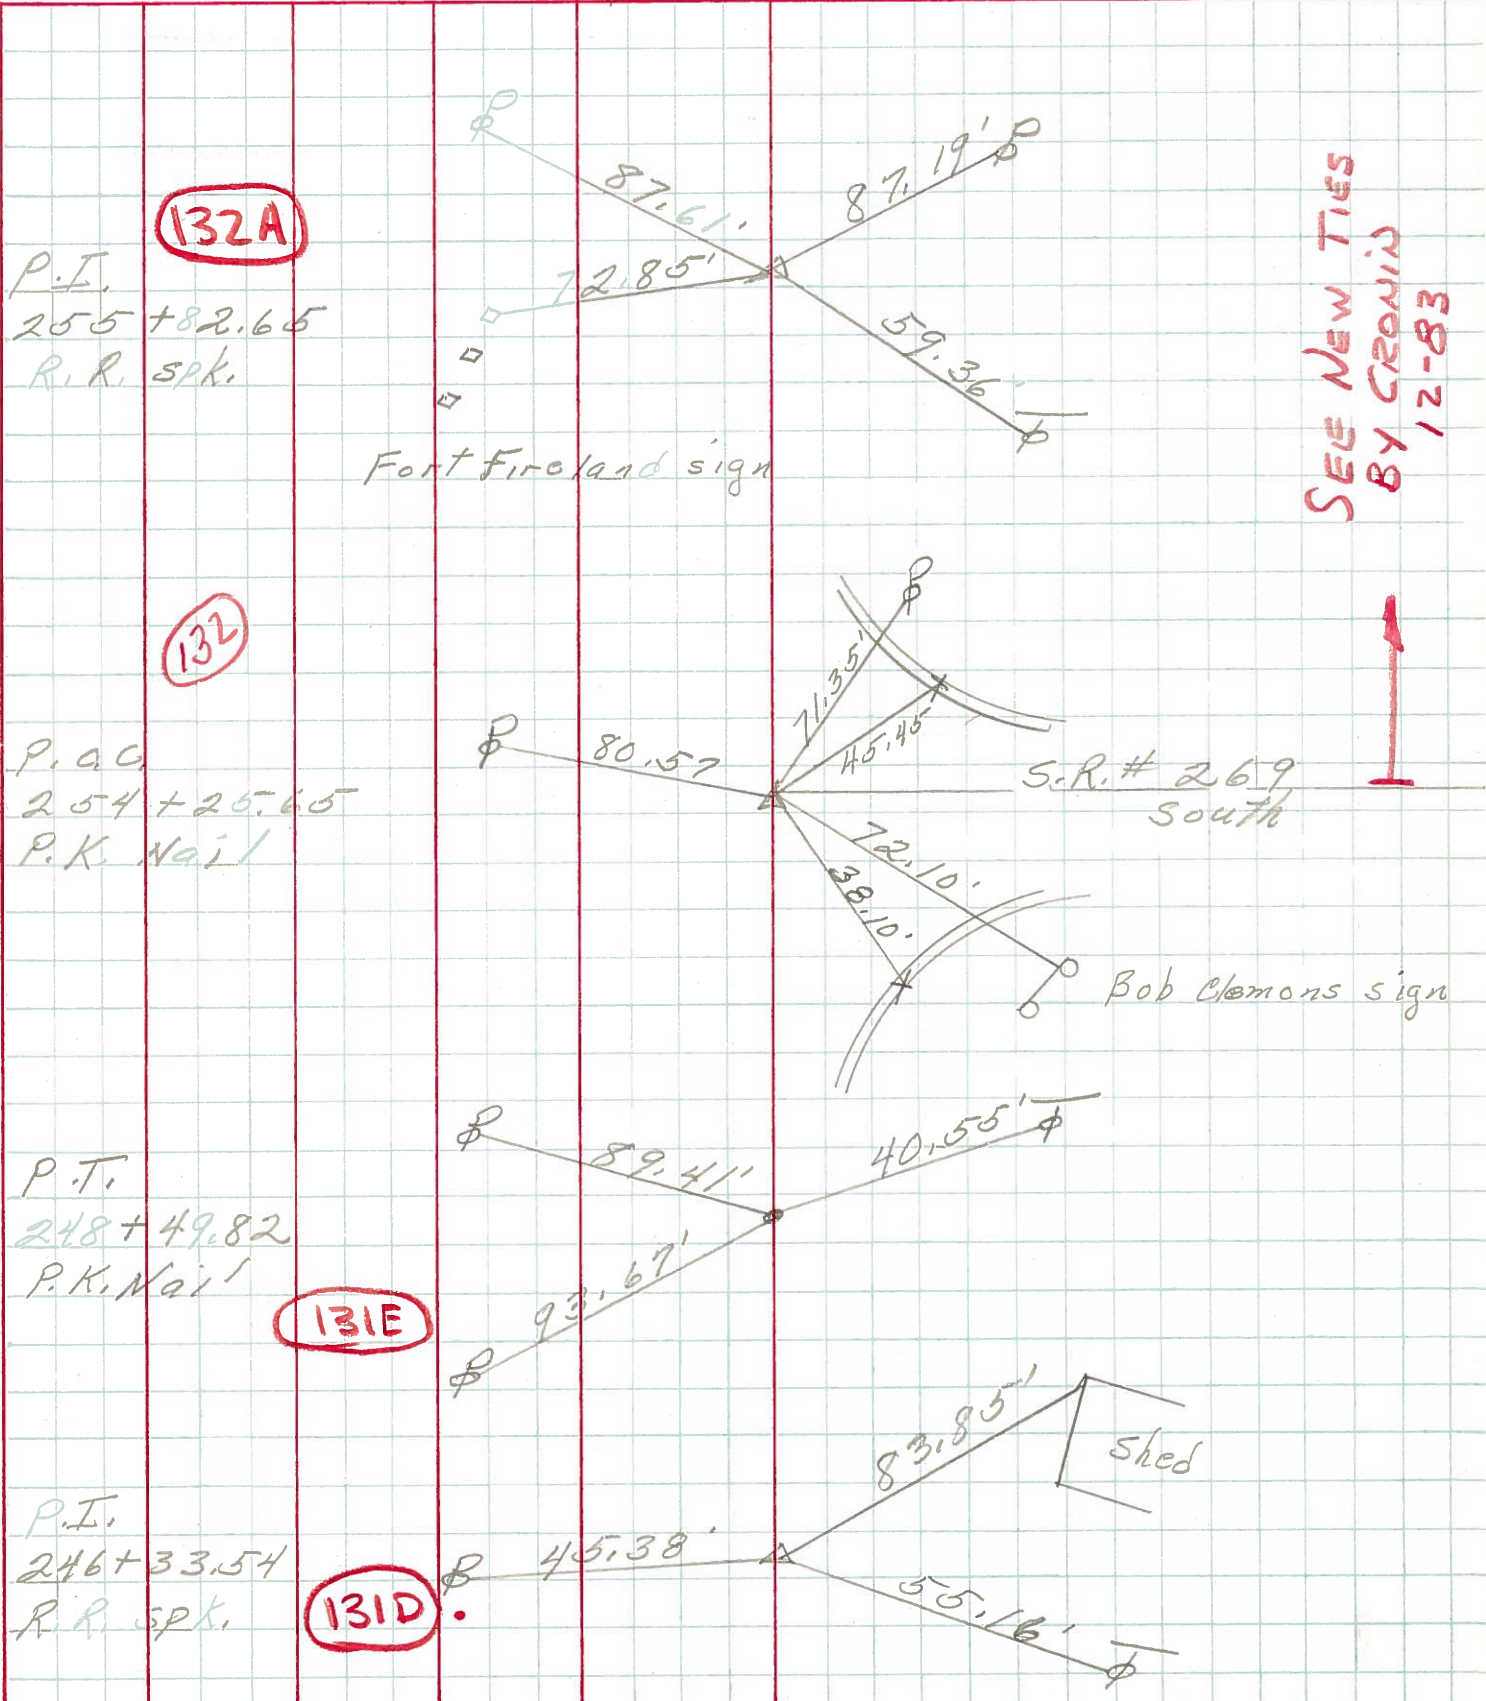

PERSONNEL	TITLE	PERSONNEL	TITLE	COUNTY	DATE
Schneider				Ottawa	9-5-68
Mosser				S. R. 163	WEATHER cloudy-Rain
Redding				SEC. Port Clinton-East	TEMP. 75°
Potts					

DESCRIPTION Ties for Control Points JOB NO. \_\_\_\_\_

