

O.D.O.T. DISTRICT 2 SURVEY OFFICE

PERSONNEL

REFERENCE NO. 131 E

SHEET 27 OF

NOTES CROWIN

H.C. RIPPLE

R.C. BARBOUR

GEYMAN

DATE 9/17/85

WEATHER SUNNY

TEMP. 78°

ROUTE # 163

COUNTY OTTAWA

TOWNSHIP DANBURY

SECTION

T R



TYPE MONUMENT P.K. WASHER, Also P.K. WASHER

ON SURFACE - BELOW ON SURFACE

LEFT - & PAV'T. - RIGHT 6.5' RT. & PAV'T.

 TO EDGE PAVEMENT

S.L.M.

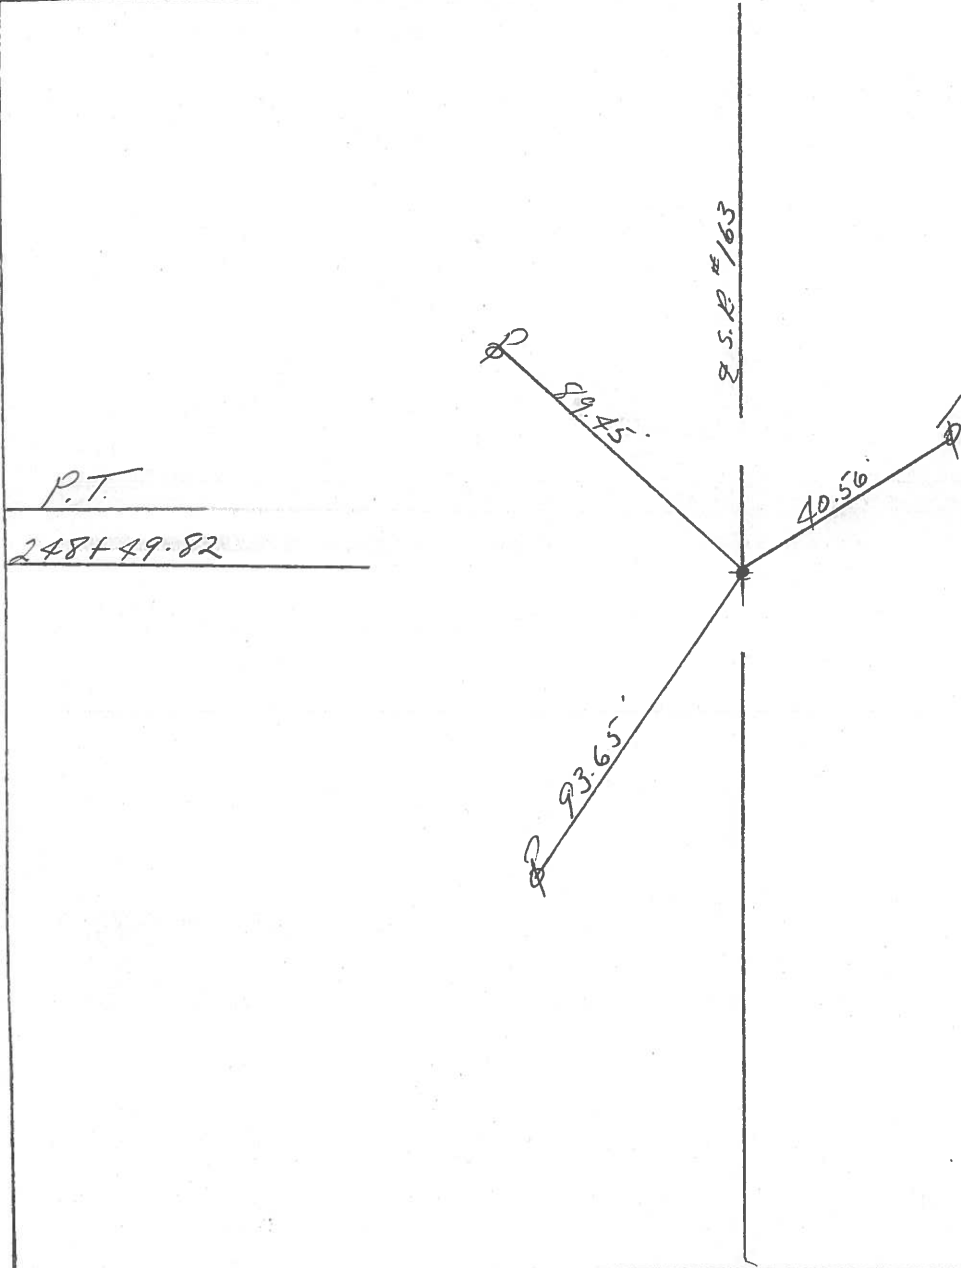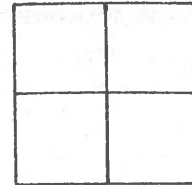


PERSONNEL TITLE PERSONNEL TITLE

COUNTY Ottawa DATE 6-12-69

S. R. 163 WEATHER _____

SEC. 4 TEMP. _____

DESCRIPTION Danbury Twp. JOB NO. _____

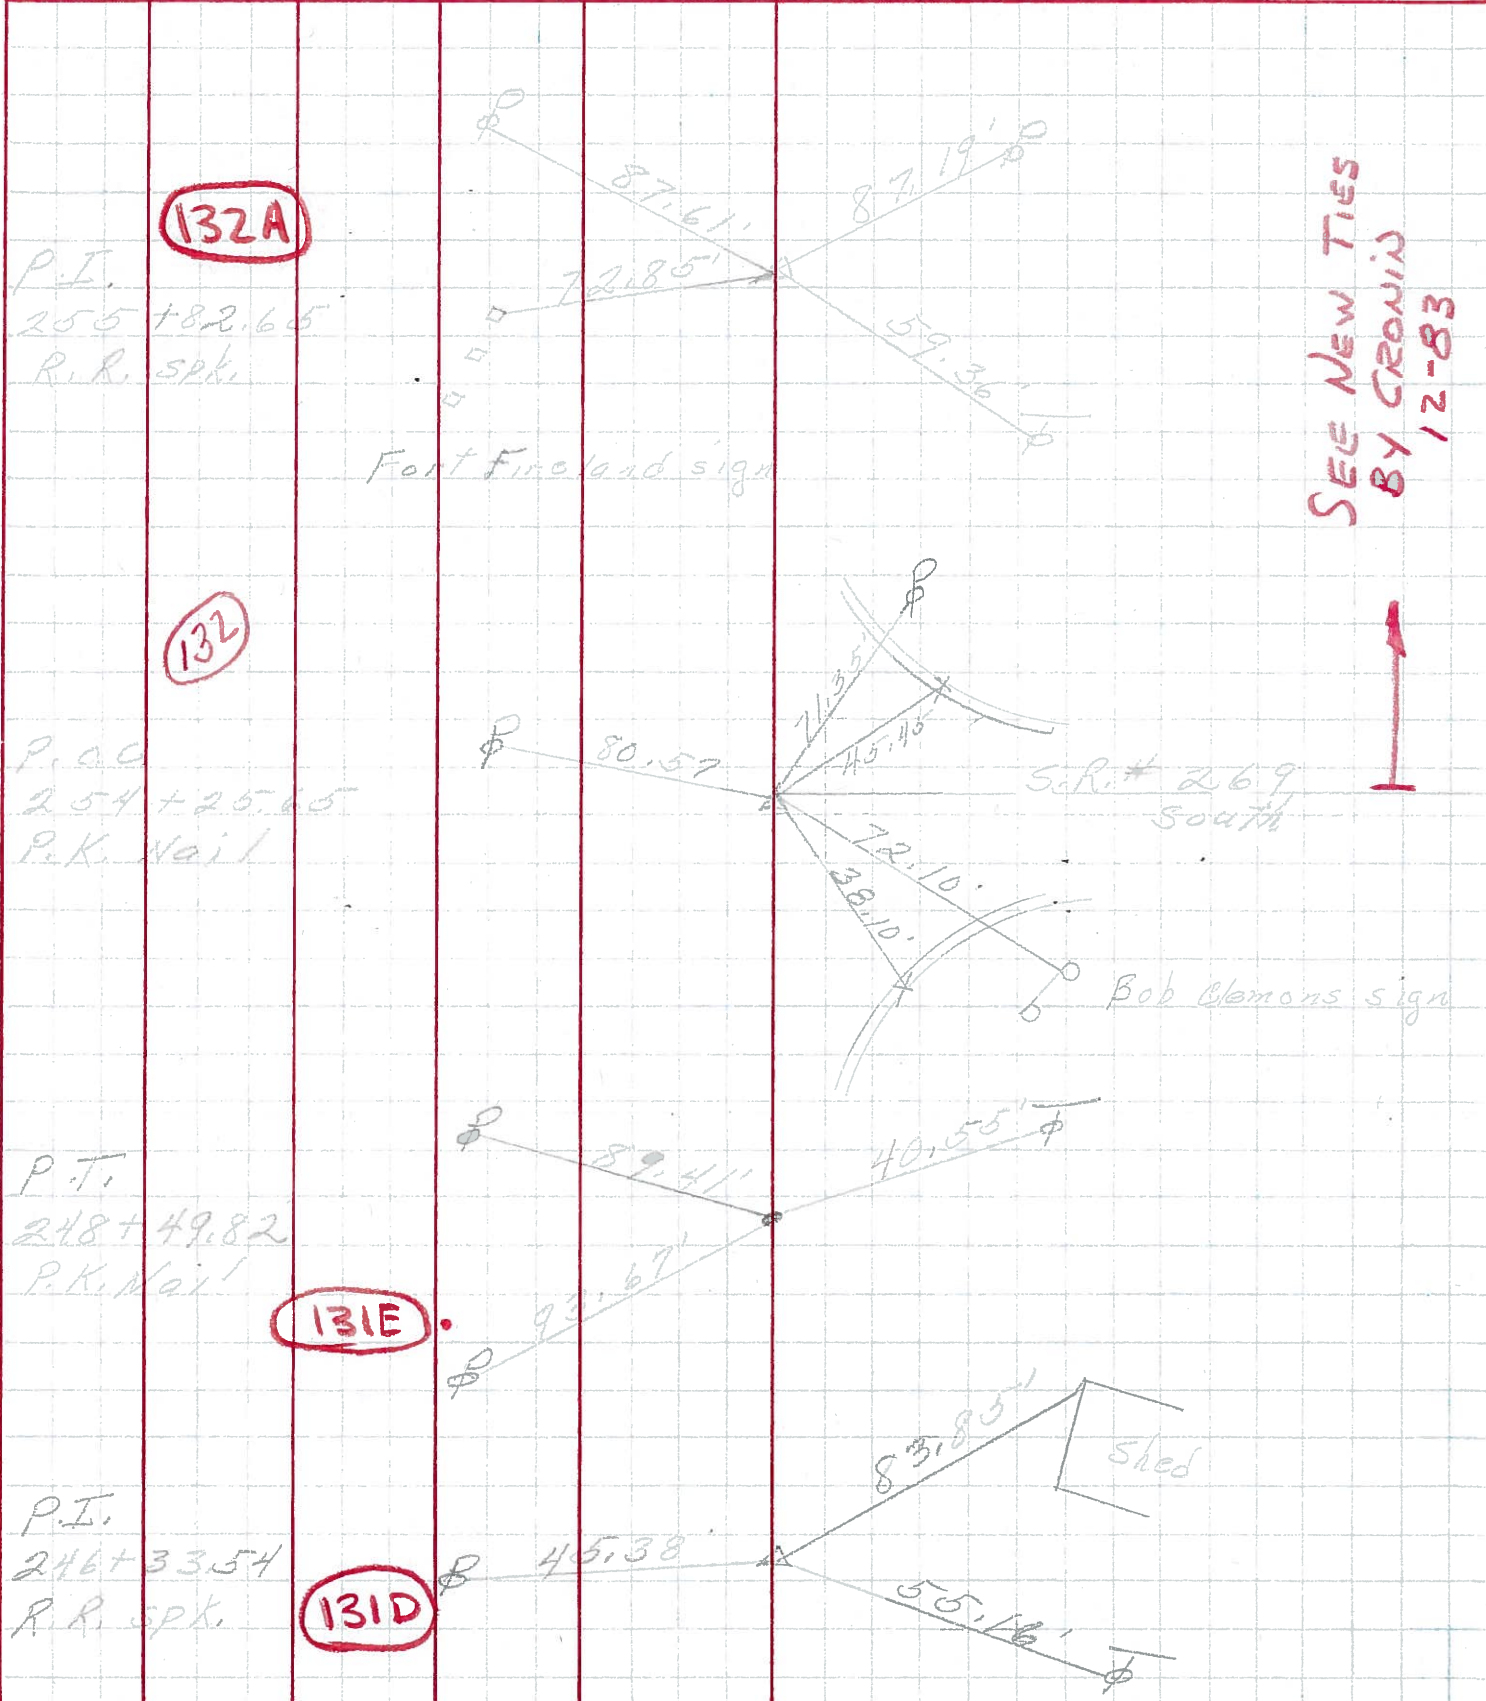

PERSONNEL	TITLE	PERSONNEL	TITLE
Schneider			
Mosser			
Redding			
Potts			

COUNTY Ottawa DATE 9-5-68
 S. R. 163 WEATHER cloudy-Rain
 SEC. Port Clinton-East TEMP. 75°

DESCRIPTION Ties for Control Points JOB NO. _____

	LEFT	CENTER LINE	RIGHT
P. T. P. K. Nail 248 + 49.82 6363	(131E)		
P. I. 246 + 33.57 P. R. Spk.	(131D)		
P. C. P. K. Nail 244 + 15.38 6361	(131C)		
P. O. T. P. K. Nail 6360	(131B)		