



O.D.O.T. DISTRICT 2 SURVEY OFFICE (USE ONLY)

PERSONNEL \_\_\_\_\_ REFERENCE NO. 132 B SHEET 8 OF 66  
 NOTES RHOADES DATE 12/4/14 ROUTE SR 163  
 H.C. WESTFALL WEATHER CLOUDY COUNTY OTTAWA  
 R.C. HOMAN TEMP. 28° TOWNSHIP DANBURY  
 SECTION 4-21  
 DWG BY NIESE PID 107060

TYPE MONUMENT MONBOX  
 ON SURFACE - ~~BELOW~~ ON  
 OFFSET Q PAVEMENT 8.3' LT : RT  
- TO - EDGE PAVEMENT  
 STATION: 1676+97.65

HORIZ.DATUM: NAD83(2011) GEOID: 2012A  
 GRID: NORTHING: 679503.950 EASTING: 1880359.071

NOTES:  
 THIS MAP IS FOR ODOT PURPOSES ONLY.  
 TO INDEX REFERENCE TIES, AND DOES NOT  
 REPRESENT TRUE LAND SUBDIVISION.

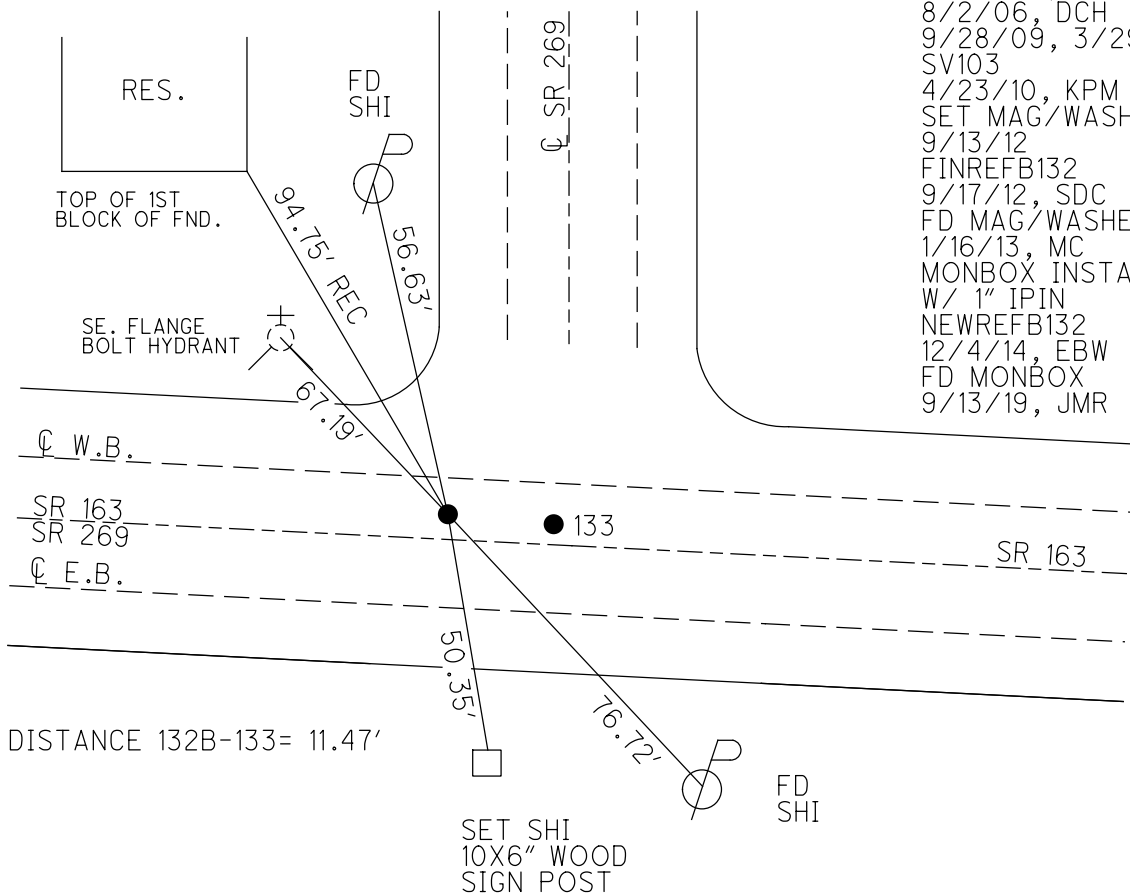
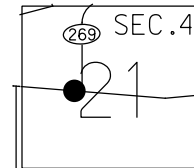


RECORD: P.O.T.  
 STA. 276+61.45  
 SET P.K./WASHER  
 ATOP P.K./WASHER  
 1983 PLAN  
 FD P.K./WASHER  
 12/19/88, CRONIN  
 8/2/06, DCH  
 9/28/09, 3/29/10  
 SV103  
 4/23/10, KPM  
 SET MAG/WASHER  
 9/13/12  
 FINREFB132  
 9/17/12, SDC  
 FD MAG/WASHER  
 1/16/13, MC  
 MONBOX INSTALLED  
 W/ 1" IPIN  
 NEWREFB132  
 12/4/14, EBW  
 FD MONBOX  
 9/13/19, JMR

O.D.O.T. DISTRICT 2 SURVEY OFFICE (USE ONLY)

PERSONNEL	REFERENCE NO. <u>132 B</u>	SHEET <u>8</u> OF <u>63</u>
NOTES <u>MOSER</u>	DATE <u>5/5/11</u>	ROUTE <u>SR 163</u>
H.C. <u>MOSER</u>	WEATHER <u>SUNNY</u>	COUNTY <u>OTTAWA</u>
R.C. <u>LUMBREZER</u>	TEMP. <u>60°</u>	TOWNSHIP <u>DANBURY</u>
		SECTION <u>4-21</u>

TYPE MONUMENT P.K./WASHER  
 ON SURFACE - ~~BELOW~~ ON  
~~LEFT~~ - Q PAV'T - RIGHT 8.9'  
35.8' TO RT EDGE PAVEMENT  
 S.L.M. 1676+97.65

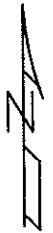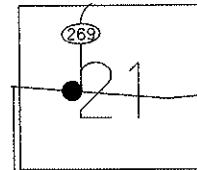

Grid: Northing: 679503.988 Easting: 1880359.037


1983 RECORD  
 P.O.T. 276+61.45  
 SET P.K./WASHER  
 ATOP P.K./WASHER  
 NEAR Q W.B. LANES

FD P.K./WASHER  
 9/28/09, 3/29/10  
 KPM

GPS, SV103  
 4/23/10, KPM

SET MAG/WASHER  
 9/13/12, SDC

GPS, FINREFB132  
 9/17/12, SDC

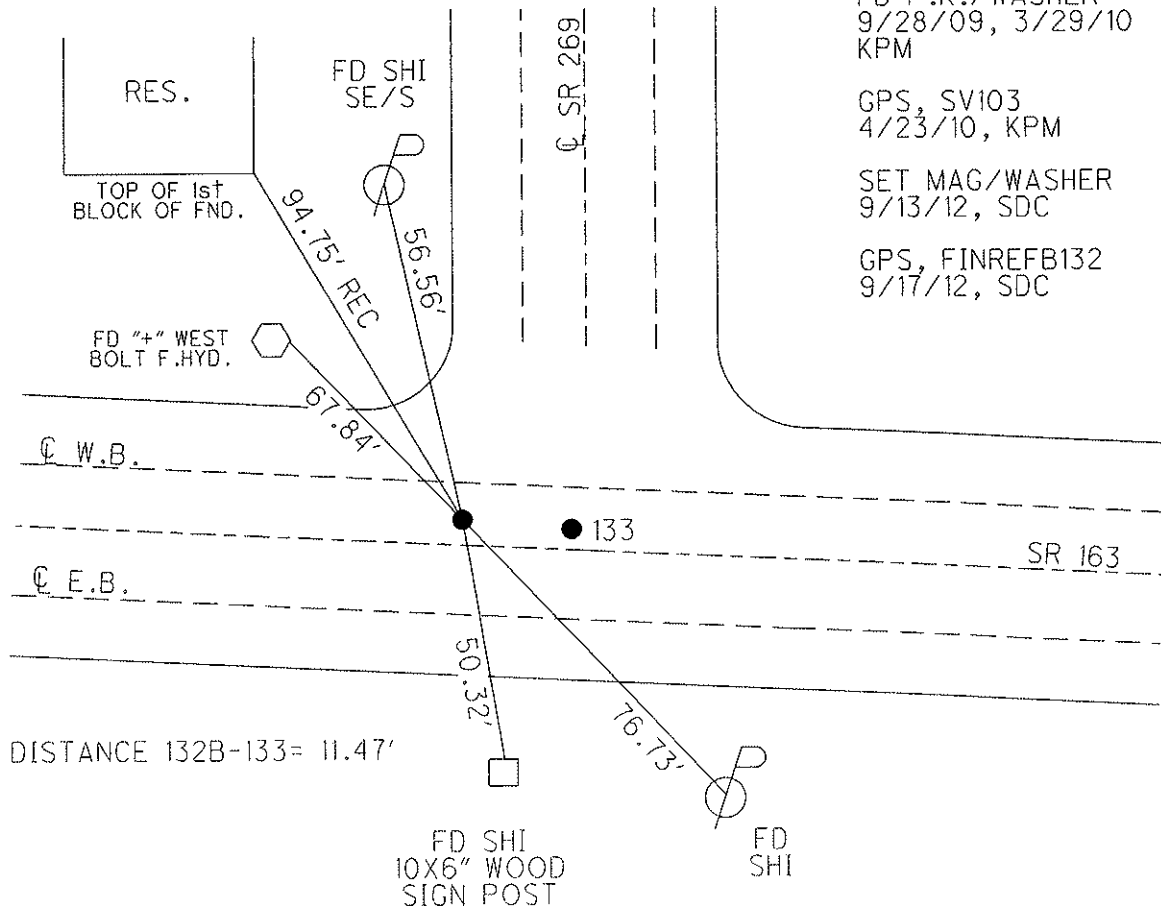

O.D.O.T. DISTRICT 2 SURVEY OFFICE

PERSONNEL

REFERENCE NO. 133

SHEET 3 OF 4

NOTES HUSS

DATE 8-2-06

ROUTE SR 163

H.C. CORDES

WEATHER SUNNY-HOT

COUNTY OTTAWA

R.C. VIETH

TEMP. +87°

TOWNSHIP DANBURY

HOMAN

SECTION Conn. West. Reserve

MIKLOVIC

T    N    R    E


TYPE MONUMENT Ⓐ-PK/WASHER Ⓑ-PK

ON SURFACE - BELOW YES

LEFT - ☉ PAV'T - RIGHT 8.3' LT. ☉

36' TO RT. EDGE PAVEMENT


S.L.M. 1679 + 95

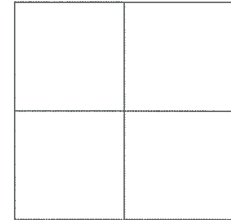

1983 RECORD  
P.O.T. 276+66.45  
SET PK & WASHER ATOP  
PK & WASHER NEAR  
☉ W.B. LANES

NOTE: PT. "B" SET BY  
OTHERS - UNKNOWN ORIGIN

PT "A" ODOT REF. PT.

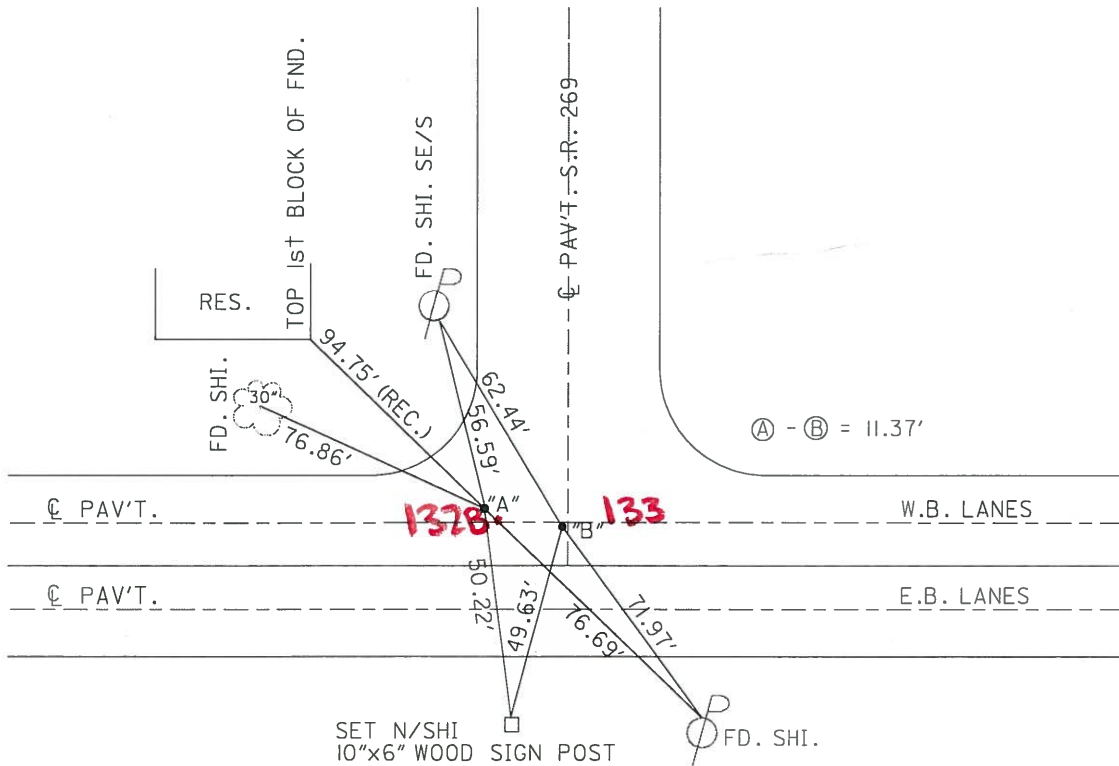

# O.D.O.T. DISTRICT 2 SURVEY OFFICE

PERSONNEL

REFERENCE NO. 133

SHEET 4 OF 52

NOTES LOEHARKE

H.C. LOEHARKE

R.C. ROUSOS

CANTERBURY

DATE 5-17-95

WEATHER Cloudy

TEMP. +70°

ROUTE S.R. 163

COUNTY OTTAWA

TOWNSHIP DANBURY

SECTION Com. WEST. RESERVE

T     R    


TYPE MONUMENT P.K. / WASHER <sup>Reset</sup> 6-4-96

ON SURFACE - ~~BELOW~~ Yes

LEFT-~~☉~~ PAVT. - ~~RIGHT~~ 8.3 Lt ☉ PAVT S.R. 163

36' TO Rt EDGE PAVEMENT

S.L.M. 1679+95

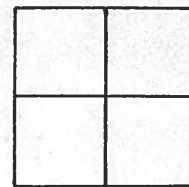

1983 RECORD  
P.O.T. 276+66.45  
SET P.K. & WASHER atop  
P.K. & WASHER Near  
☉ W.B. LANES.

