




O.D.O.T. DISTRICT 2 SURVEY OFFICE (USE ONLY)

PERSONNEL _____ REFERENCE NO. 136 SHEET 17 OF 67
 NOTES LUMBREZER DATE 5/6/11 ROUTE SR 163
 H.C. FINTEL WEATHER CLOUDY COUNTY OTTAWA
 R.C. LUMBREZER TEMP. 60° TOWNSHIP DANBURY
 SECTION 2-13
 DWG BY NIESE PID 109637

TYPE MONUMENT P.K./WASHER
 ON SURFACE - ~~BELOW~~ ON _____
 OFFSET CL PAVEMENT 2.1' LT : ~~RT~~
9.5' TO RT EDGE PAVEMENT
 STATION: 1770+60

HORZ. DATUM: NAD83(2011) GEOID: 2012B
 GRID: NORTHING: 679641.677 EASTING: 1889347.736

NOTE:
THIS MAP IS FOR ODOT PURPOSES ONLY.
TO INDEX REFERENCE TIES, AND DOES NOT
REPRESENT TRUE LAND SUBDIVISION.

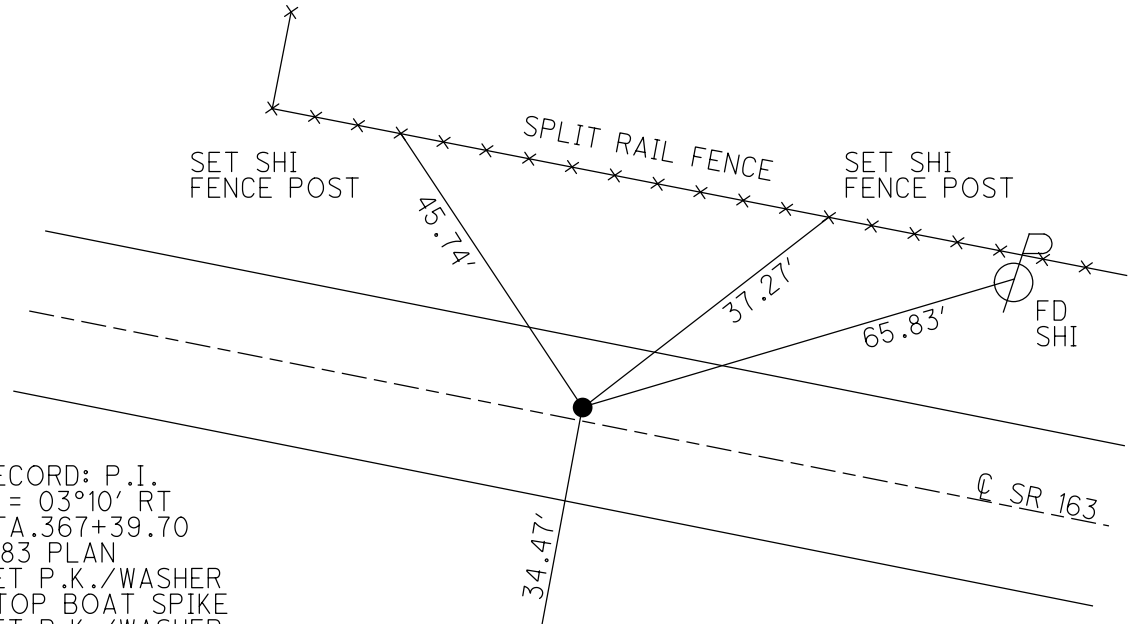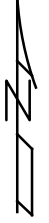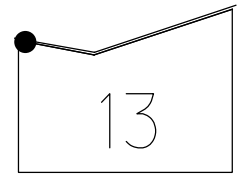



RECORD: P.I.
 $\Delta = 03^{\circ}10' RT$
 STA. 367+39.70
 1983 PLAN
 SET P.K./WASHER
 ATOP BOAT SPIKE
 SET P.K./WASHER
 6/5/96
 FD P.K. SHANK
 9/28/09, 4/8/10
 SV112
 4/23/10, KPM
 SET MAG/WASHER
 FINREF136
 9/17/12, SDC
 FD P.K./WASHER
 REF136
 4/2/19
 9/13/19, JFO
 4/21/22, JFO
 8/9/22, DSA

O.D.O.T. DISTRICT 2 SURVEY OFFICE (USE ONLY)


PERSONNEL _____ REFERENCE NO. 136 SHEET 17 OF 66
 NOTES LUMBREZER DATE 5/6/11 ROUTE SR 163
 H.C. FINTEL WEATHER CLOUDY COUNTY OTTAWA
 R.C. LUMBREZER TEMP. 60° TOWNSHIP DANBURY
 SECTION 2-13
 DWG BY NIESE PID 107060

TYPE MONUMENT P.K./WASHER
 ON SURFACE - ~~BELOW~~ ON _____
 OFFSET C PAVEMENT 2.1' LT : ~~RT~~
9.5' TO RT EDGE PAVEMENT
 STATION: 1770+60

NOTE:
 THIS MAP IS FOR ODOT PURPOSES ONLY
 TO INDEX REFERENCE TIES, AND DOES NOT
 REPRESENT TRUE LAND SUBDIVISION.

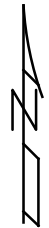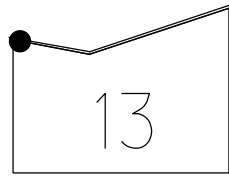

HORIZ.DATUM: NAD83(2011) GEOID: 2012A
 GRID: NORTHING: 679641.637 EASTING: 1889347.712

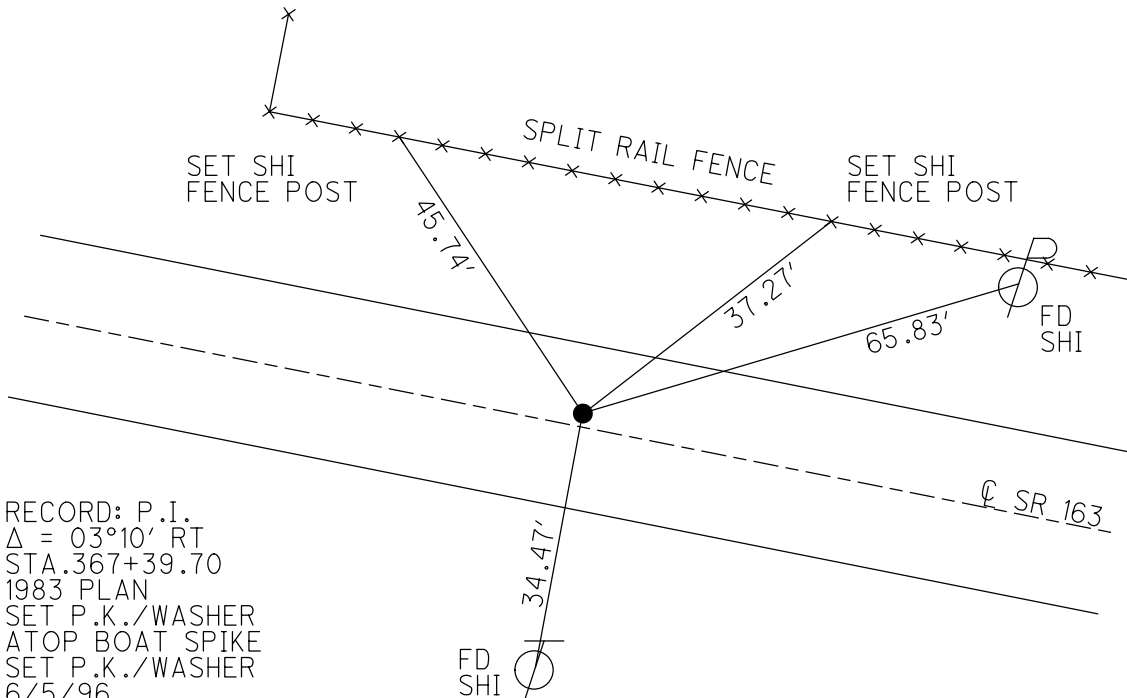


RECORD: P.I.
 $\Delta = 03^{\circ}10' \text{ RT}$
 STA. 367+39.70
 1983 PLAN
 SET P.K./WASHER
 ATOP BOAT SPIKE
 SET P.K./WASHER
 6/5/96
 FD P.K.SHANK
 9/28/09, 4/8/10
 SV112
 4/23/10, KPM
 SET MAG/WASHER
 FINREF136
 9/17/12, SDC
 FD P.K./WASHER
 REF136
 4/2/19
 9/13/19, JFO
 4/21/22, JFO

O.D.O.T. DISTRICT 2 SURVEY OFFICE (USE ONLY)


PERSONNEL _____ REFERENCE NO. 136 SHEET 17 OF 63
 NOTES LUMBREZER DATE 5/6/11 ROUTE SR 163
 H.C. FINTEL WEATHER CLOUDY COUNTY OTTAWA
 R.C. LUMBREZER TEMP. 60° TOWNSHIP DANBURY
 SECTION 2-13
 DWG BY NIESE PID 107060

TYPE MONUMENT P.K./WASHER
 ON SURFACE - ~~BELOW~~ ON _____
 OFFSET \odot PAVEMENT 2.1' LT : ~~RT~~
9.5' TO RT EDGE PAVEMENT
 STATION: 1770+60

NOTE:
THIS MAP IS FOR ODOT PURPOSES ONLY.
TO INDEX REFERENCE TIES, AND DOES NOT
REPRESENT TRUE LAND SUBDIVISION.

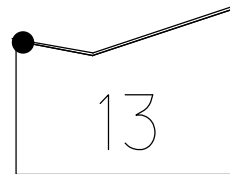

HORIZ.DATUM: NAD83(2011) GEOID: 2012A
 GRID: NORTHING: 679641.637 EASTING: 1889347.712

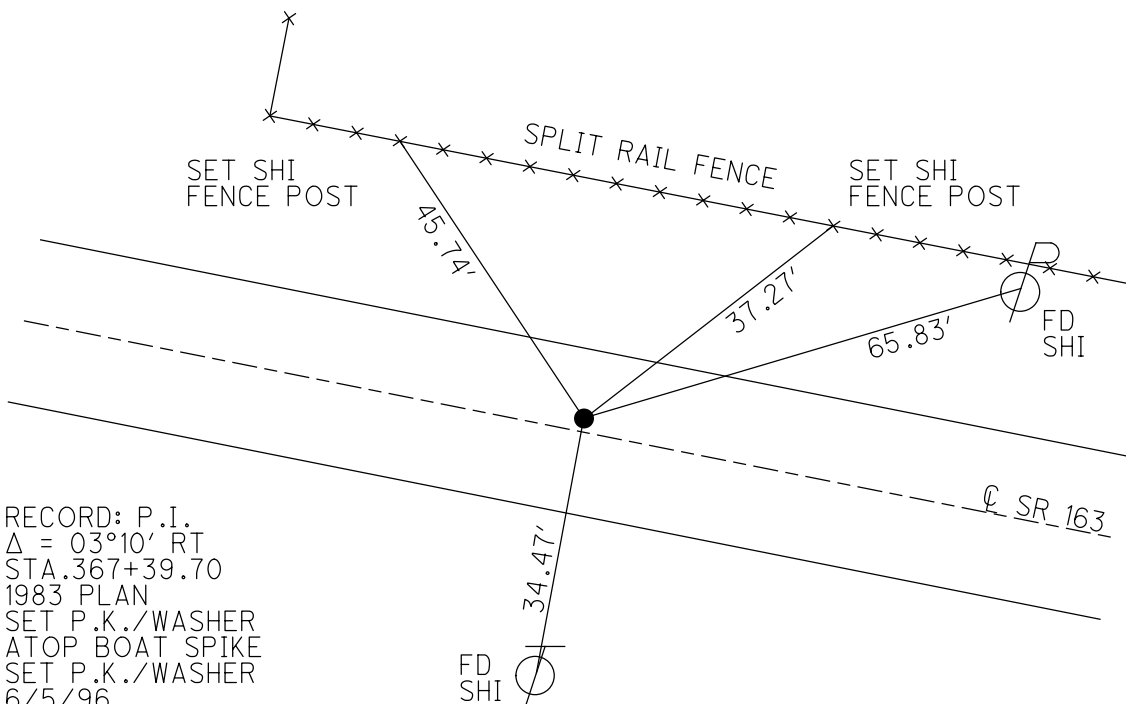

RECORD: P.I.
 $\Delta = 03^{\circ}10' RT$
 STA.367+39.70
 1983 PLAN
 SET P.K./WASHER
 ATOP BOAT SPIKE
 SET P.K./WASHER
 6/5/96
 FD P.K.SHANK
 9/28/09, 4/8/10
 SV112
 4/23/10, KPM
 SET MAG/WASHER
 FINREF136
 9/17/12, SDC
 FD P.K./WASHER
 REF136
 4/2/19
 9/13/19, JFO

O.D.O.T. DISTRICT 2 SURVEY OFFICE (USE ONLY)

PERSONNEL

REFERENCE NO. 136

SHEET 17 OF 63

NOTES LUMBREZER

DATE 5/6/11

ROUTE SR 163

H.C. FINTEL

WEATHER CLOUDY

COUNTY OTTAWA

R.C. LUMBREZER

TEMP. 60°

TOWNSHIP DANBURY

SECTION 2-13

TYPE MONUMENT P.K./WASHER


ON SURFACE - BELOW ON

LEFT - Q PAV'T - RIGHT 2.1'


9.5' TO LT. EDGE PAVEMENT

S.L.M. 1770+60

Grid: Northing: 679641.632 Easting: 1889347.682

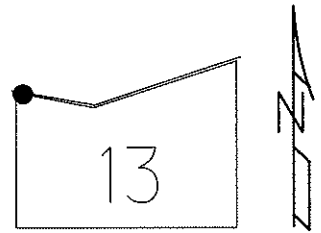

1983 RECORD
 P.I. $\Delta = 03^\circ 10'$ RT. (PLAN)
 367+39.70
 SET P.K./WASHER ATOP
 BOAT SPIKE
 2.5' LT. Q PAV'T

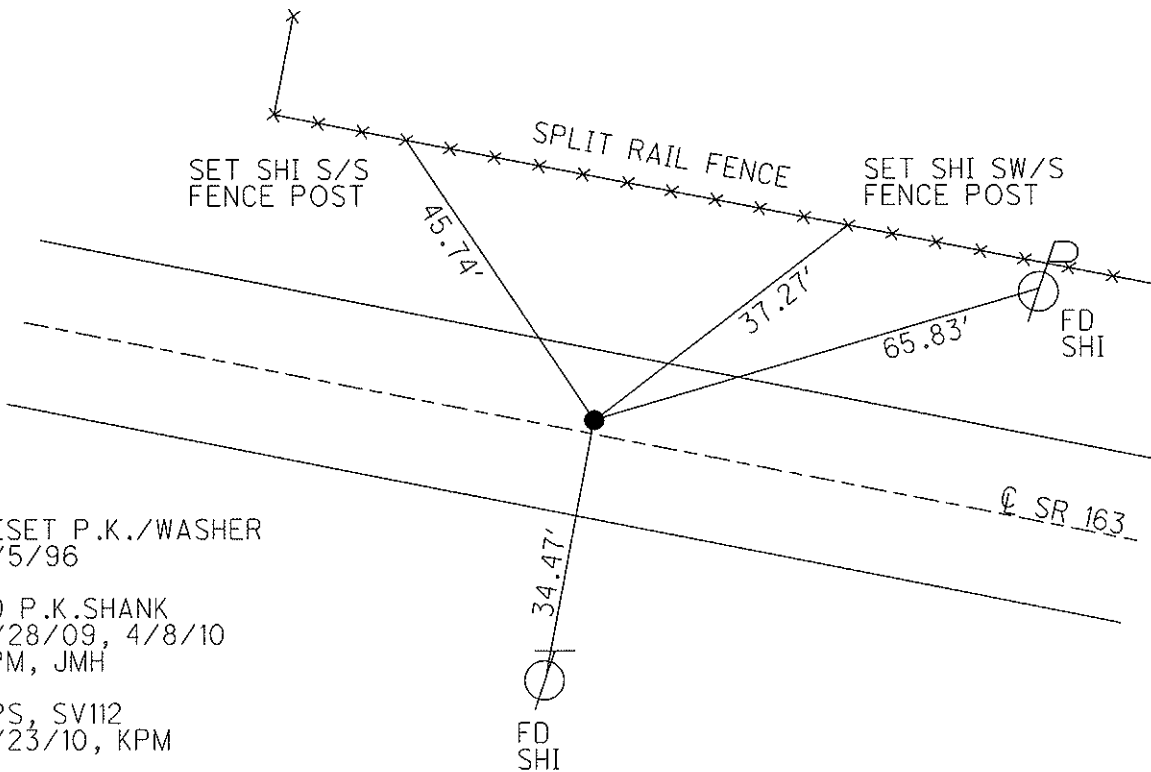

RESET P.K./WASHER
 6/5/96

FD P.K. SHANK
 9/28/09, 4/8/10
 KPM, JMH

GPS, SV112
 4/23/10, KPM

SET MAG/WASHER
 9/13/12, SDC

GPS, FINREF136
 9/17/12, SDC

O.D.O.T. DISTRICT 2 SURVEY OFFICE

PERSONNEL _____

REFERENCE NO. 136

SHEET 12 OF 52

NOTES CANTERBURY

H.C. LOEHRKE

R.C. ROUSAS

DATE 5-25-95

WEATHER CLOUDY

TEMP. ± 56° F

ROUTE S.R. 163

COUNTY OTTAWA

TOWNSHIP DANBURY

SECTION Com. West Reserve

T _____ R _____

Reset 6-5-96


TYPE MONUMENT PK NAIL / WASHER

ON SURFACE - BELOW ON SURFACE

LEFT- <math>\epsilon</math> PAV'T. - RIGHT 2.1' LT <math>\epsilon</math>

9.5 TO LT EDGE PAVEMENT

S.L.M. 1770 + 60

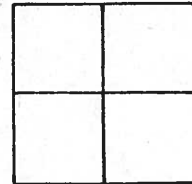


1983 RECORD

P.I. $\Delta = 030^{\circ} - 10' = 00''$ Rt. (PAV)

367 + 39.70

SET P.K. <math>\epsilon</math> WASHER ATOP
BOAT SPIKE <math>\epsilon</math> WASHER 25' LT.
<math>\epsilon</math> PAV'T.

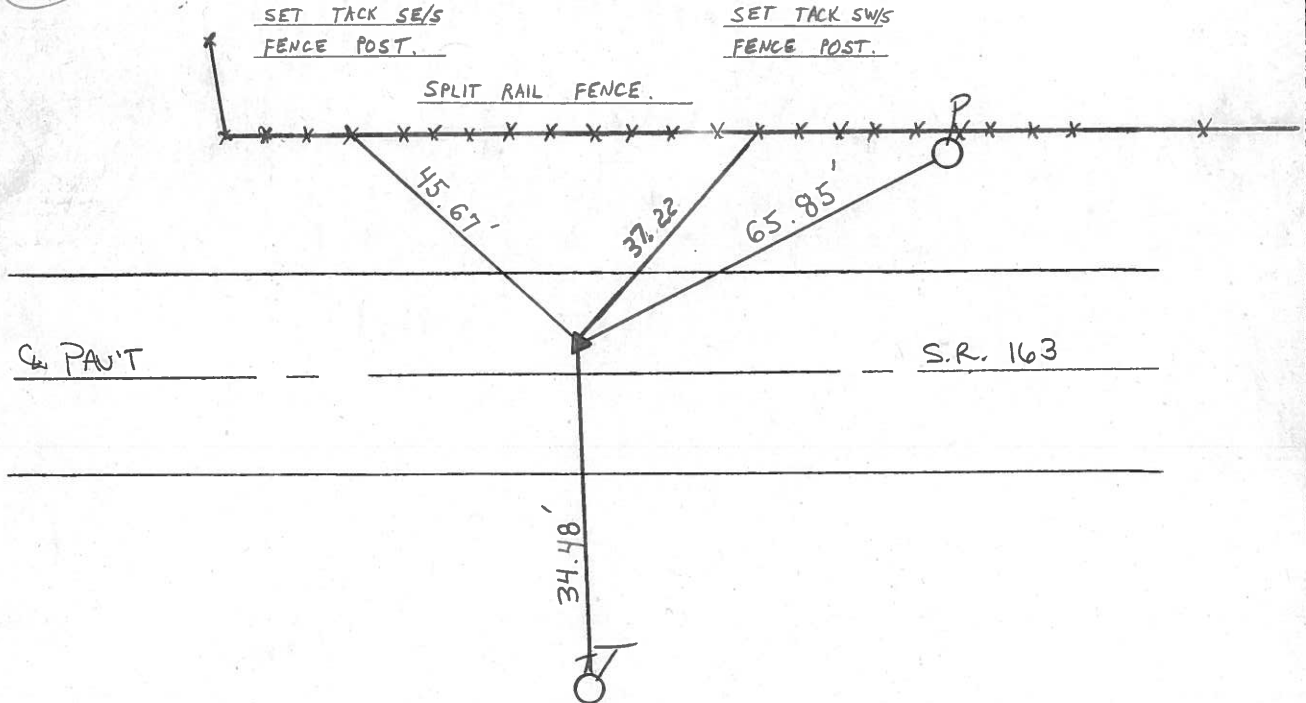

County Ottawa S.R. #163

Date 11/21/83

Township Danbury

Weather sunny - windy

Section

Temp. 53°


T-N, R-E

Personnel Cronin

Rippke

Geyman


Barbour

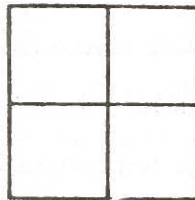

136



Plan
P.I. $\Delta = 03^\circ 10' R$
367+39.70
Set P.K. & washer atop
boat spike & washer 25' Lt &
Paumt.

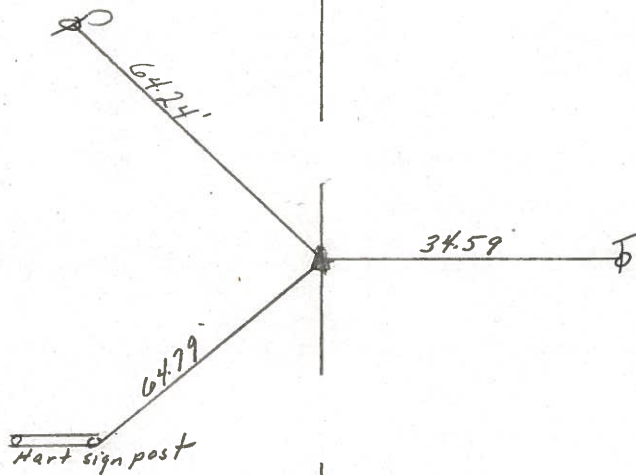


S.R. #163


PERSONNEL	TITLE	PERSONNEL	TITLE
COUNTY <u>Ottawa</u> DATE <u>6-9-71</u>			
S. R. <u>163</u> WEATHER _____			
SEC. <u>2</u> TEMP. _____			
DESCRIPTION <u>S.R. #269 East</u> JOB NO. _____			
	LEFT	CENTER LINE	RIGHT

372+73.93
 P.K. Nail
 on top A.A. Market


136A

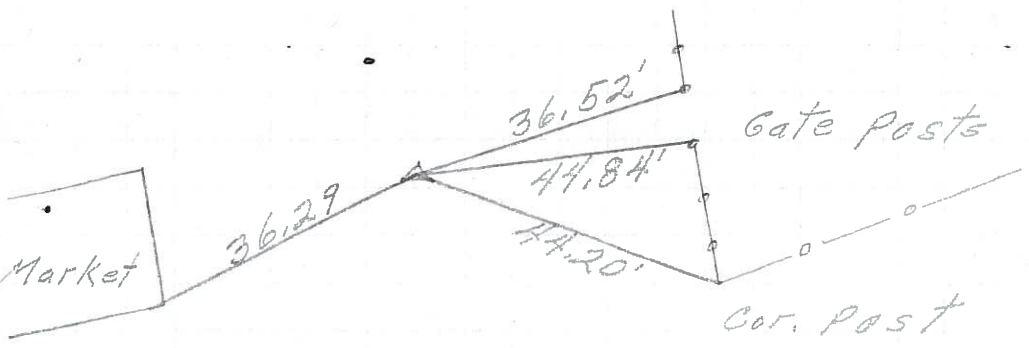

P.I. **136**
 367+39.7
 small spk.

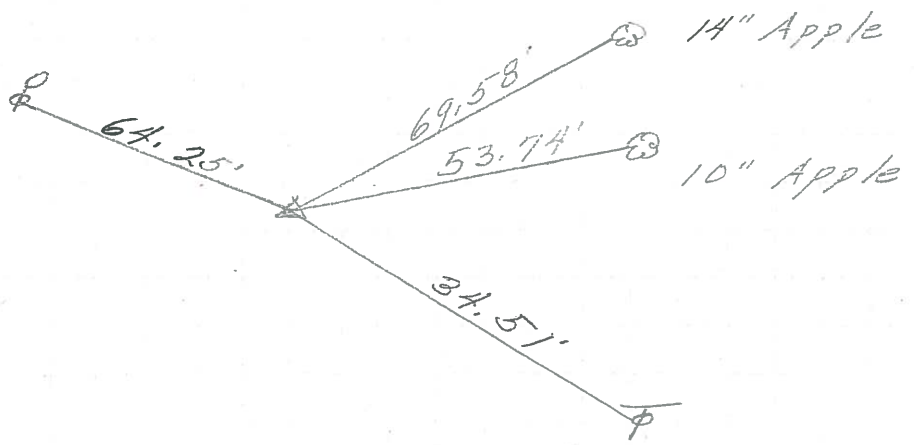

P.I. **135A**
 362+40.06
 P.K. Nail
 on surface

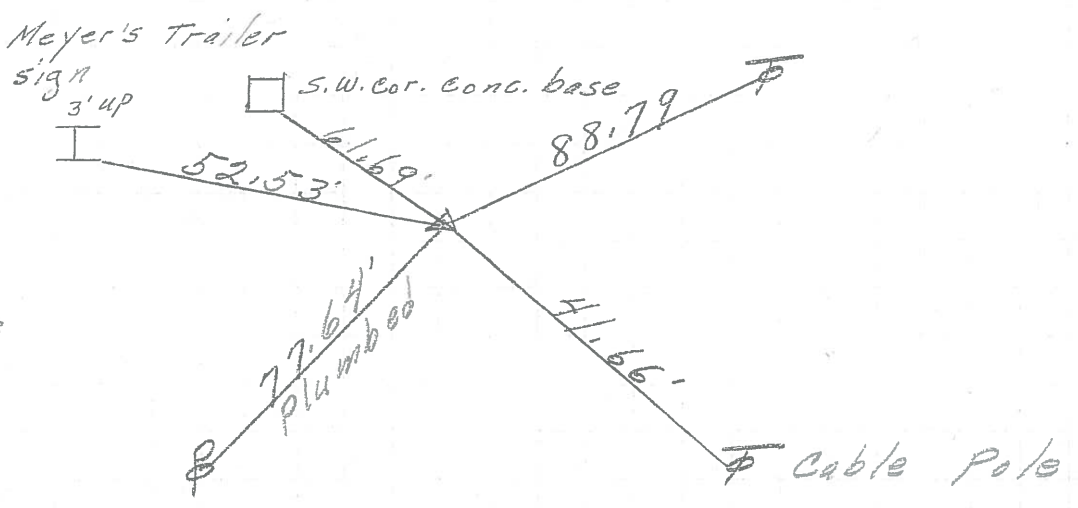

PERSONNEL	TITLE	PERSONNEL	TITLE	COUNTY	DATE
Schneider		Potts		Ottawa	9-10-68
Mosser				S. R. 163	WEATHER Cloudy
Barbour				SEC. S.R. #269 - East	TEMP. 70°
Redding					
DESCRIPTION	Ties for Control Points				JOB NO.

