


O.D.O.T. DISTRICT 2 SURVEY OFFICE (USE ONLY)

PERSONNEL _____ REFERENCE NO. 140 SHEET 24 OF 66
 NOTES LUMBREZER DATE 5/6/11 ROUTE SR 163
 H.C. FINTEL WEATHER CLOUDY COUNTY OTTAWA
 R.C. LUMBREZER TEMP. 60° TOWNSHIP DANBURY
 DWG BY NIESE PID 107060 SECTION 2-13


TYPE MONUMENT P.K./WASHER
 ON SURFACE - ~~BELOW~~ ON
 OFFSET \varnothing PAVEMENT 1.0' LT : ~~RT~~
9.7' TO LT EDGE PAVEMENT
 STATION: 1820+14

NOTE:
THIS MAP IS FOR ODOT PURPOSES ONLY
TO INDEX REFERENCE TIES, AND DOES NOT
REPRESENT TRUE LAND SUBDIVISION.

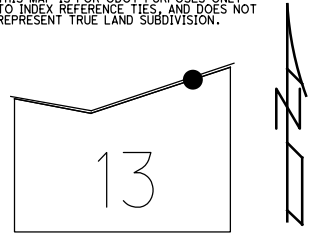

HORZ.DATUM: NAD83(2011) GEOID: 2012A
 GRID: NORTHING: 679513.100 EASTING: 1894020.025

RECORD: P.I.
 $\Delta = 01^{\circ}52' RT$
 STA. 417+02.07
 1983 PLAN
 SET P.K./WASHER
 6/5/96
 FD P.K./WASHER
 9/28/09, 4/8/10
 SV118
 4/28/10, KPM
 SET MAG/WASHER
 FINREF140
 9/19/12, SDC
 FD P.K./WASHER
 REF140
 4/2/19
 9/13/19, JFO
 4/21/22, JFO

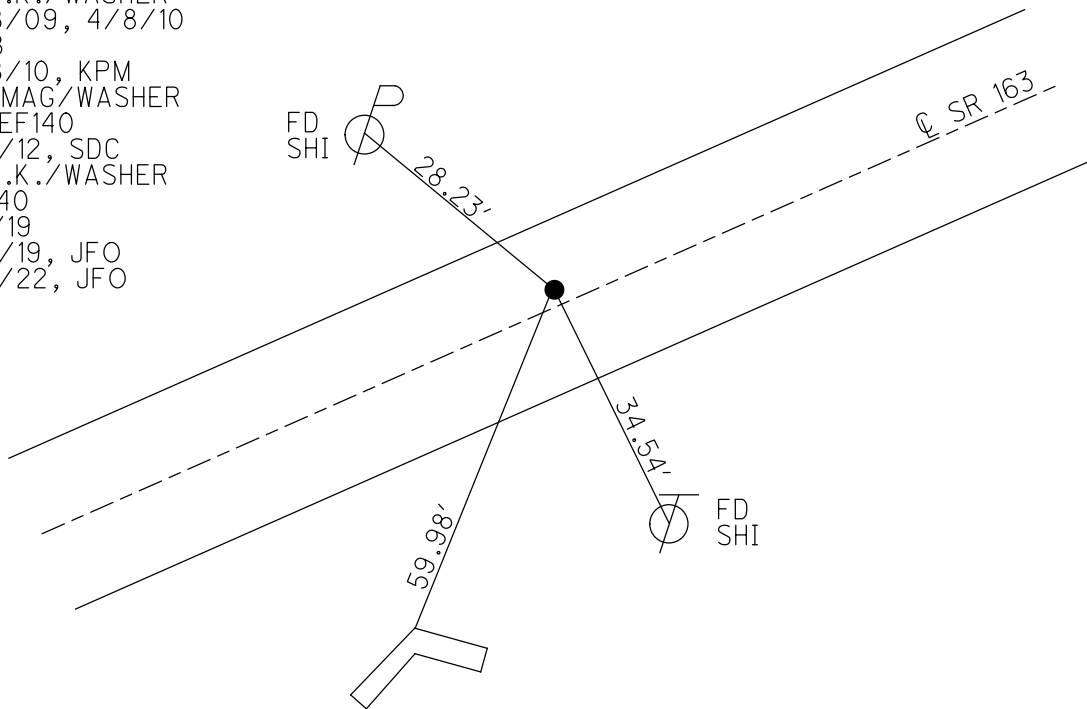


MASONRY SIGN
 TOP OF 5TH
 BRICK UP

O.D.O.T. DISTRICT 2 SURVEY OFFICE (USE ONLY)

PERSONNEL _____ REFERENCE NO. 140 SHEET 24 OF 63
 NOTES LUMBREZER DATE 5/6/11 ROUTE SR 163
 H.C. FINTEL WEATHER CLOUDY COUNTY OTTAWA
 R.C. LUMBREZER TEMP. 60° TOWNSHIP DANBURY
 DWG BY NIESE PID 107060 SECTION 2-13


TYPE MONUMENT P.K./WASHER
 ON SURFACE - ~~BELOW~~ ON _____
 OFFSET ϕ PAVEMENT 1.0' LT : ~~RT~~
9.7' TO LT EDGE PAVEMENT
 STATION: 1820+14

NOTE:
THIS MAP IS FOR ODOT PURPOSES ONLY.
TO INDEX REFERENCE TIES, AND DOES NOT
REPRESENT TRUE LAND SUBDIVISION.

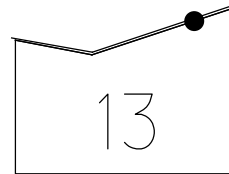

HORIZ.DATUM: NAD83(2011) GEOID: 2012A
 GRID: NORTHING: 679513.100 EASTING: 1894020.025

RECORD: P.I.
 $\Delta = 01^{\circ}52' RT$
 STA. 417+02.07
 1983 PLAN
 SET P.K./WASHER
 6/5/96
 FD P.K./WASHER
 9/28/09, 4/8/10
 SV118
 4/28/10, KPM
 SET MAG/WASHER
 FINREF140
 9/19/12, SDC
 FD P.K./WASHER
 REF140
 4/2/19
 9/13/19, JFO

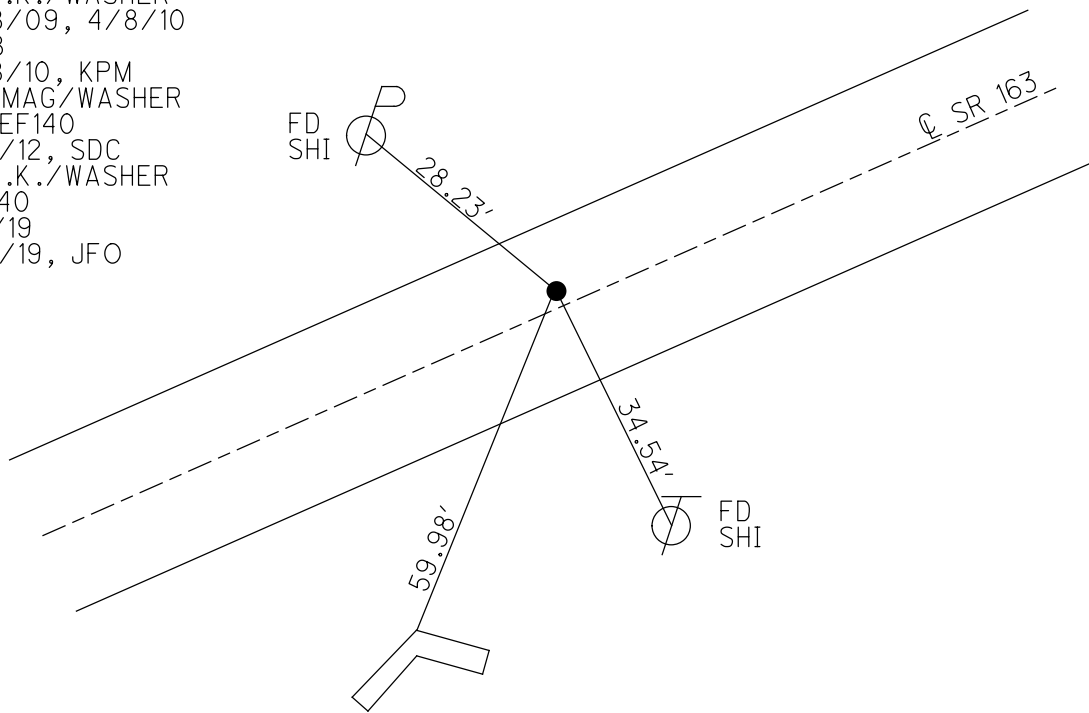


MASONARY SIGN
 TOP OF 5TH
 BRICK UP

O.D.O.T. DISTRICT 2 SURVEY OFFICE (USE ONLY)


PERSONNEL	REFERENCE NO. <u>140</u>	SHEET <u>24</u> OF <u>63</u>
NOTES <u>LUMBREZER</u>	DATE <u>5/6/11</u>	ROUTE <u>SR 163</u>
H.C. <u>FINTEL</u>	WEATHER <u>CLOUDY</u>	COUNTY <u>OTTAWA</u>
R.C. <u>LUMBREZER</u>	TEMP. <u>60°</u>	TOWNSHIP <u>DANBURY</u>
		SECTION <u>2-13</u>

TYPE MONUMENT P.K./WASHER
 ON SURFACE - ~~BELOW~~ ON
 LEFT - ☉ PAV'T - ~~RIGHT~~ 1'
9.7' TO LT. EDGE PAVEMENT
 S.L.M. 1820+14

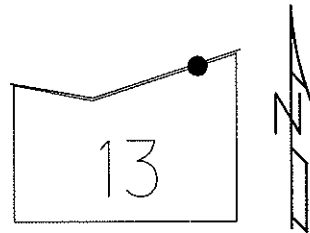

Grid: Northing: 679513.201 Easting: 1894019.960

1983 RECORD
 P.I. Δ = 01° 52' RT. (PLAN)
 417+02.07
 SET P.K./WASHER
 1' LT. ☉ PAV'T

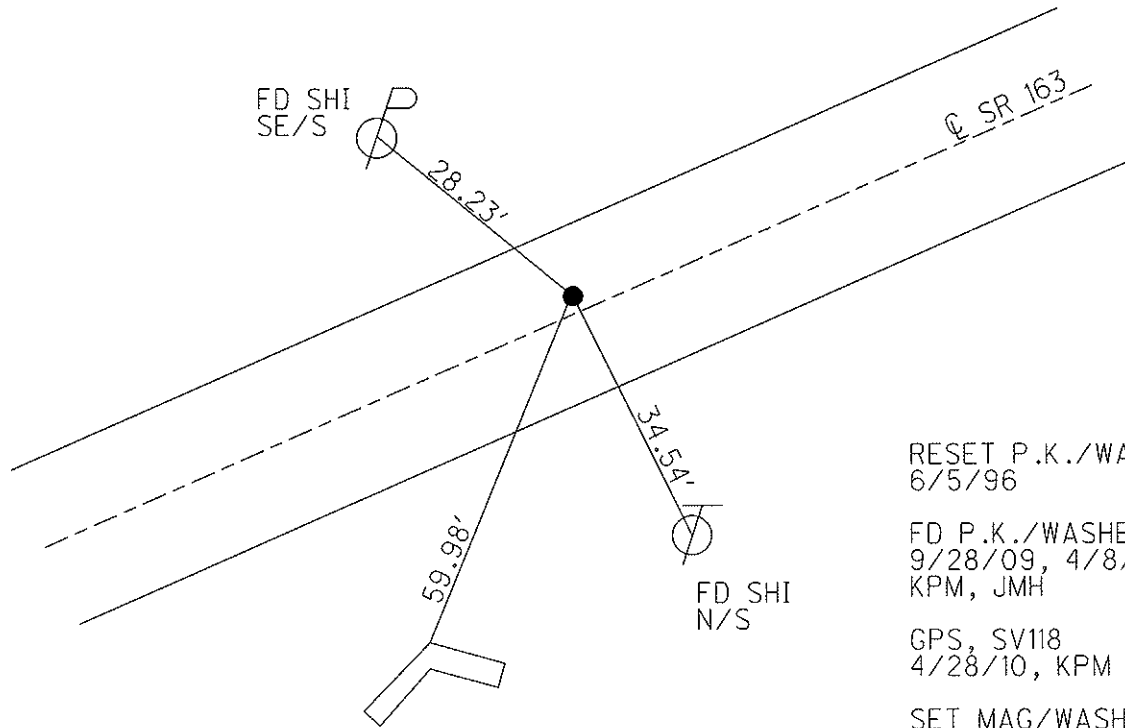

RESET P.K./WASHER
 6/5/96

FD P.K./WASHER
 9/28/09, 4/8/10
 KPM, JMH

GPS, SV118
 4/28/10, KPM

SET MAG/WASHER
 9/12/12, SDC

GPS, FINREF140
 9/19/12, SDC

O.D.O.T. DISTRICT 2 SURVEY OFFICE

PERSONNEL _____

REFERENCE NO. 140

SHEET 17 OF 52

NOTES CANTERBURY

H.C. Loehrke

R.C. Rousos

DATE 5-25-95

WEATHER CLOUDY

TEMP. +60°F

ROUTE S.R. 163

COUNTY OTTAWA

TOWNSHIP DANBURY

SECTION CANV. WEST. RESERVE

T. _____ R. _____

Reset


TYPE MONUMENT P.K. / WASHER 6-5-96

ON SURFACE - BELOW Yes

LEFT-☉ PAW'T. - RIGHT 1.0' LT ☉

9.7 TO LT EDGE PAVEMENT

S.L.M. 1820 + 14

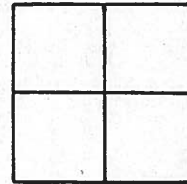


1983 RECORD

P.I. $\Delta = 01^{\circ}52'00''$ RT (PLAW)

417 + 02.07

SET P.K. & WASHER

1' LT ☉ PAW'T

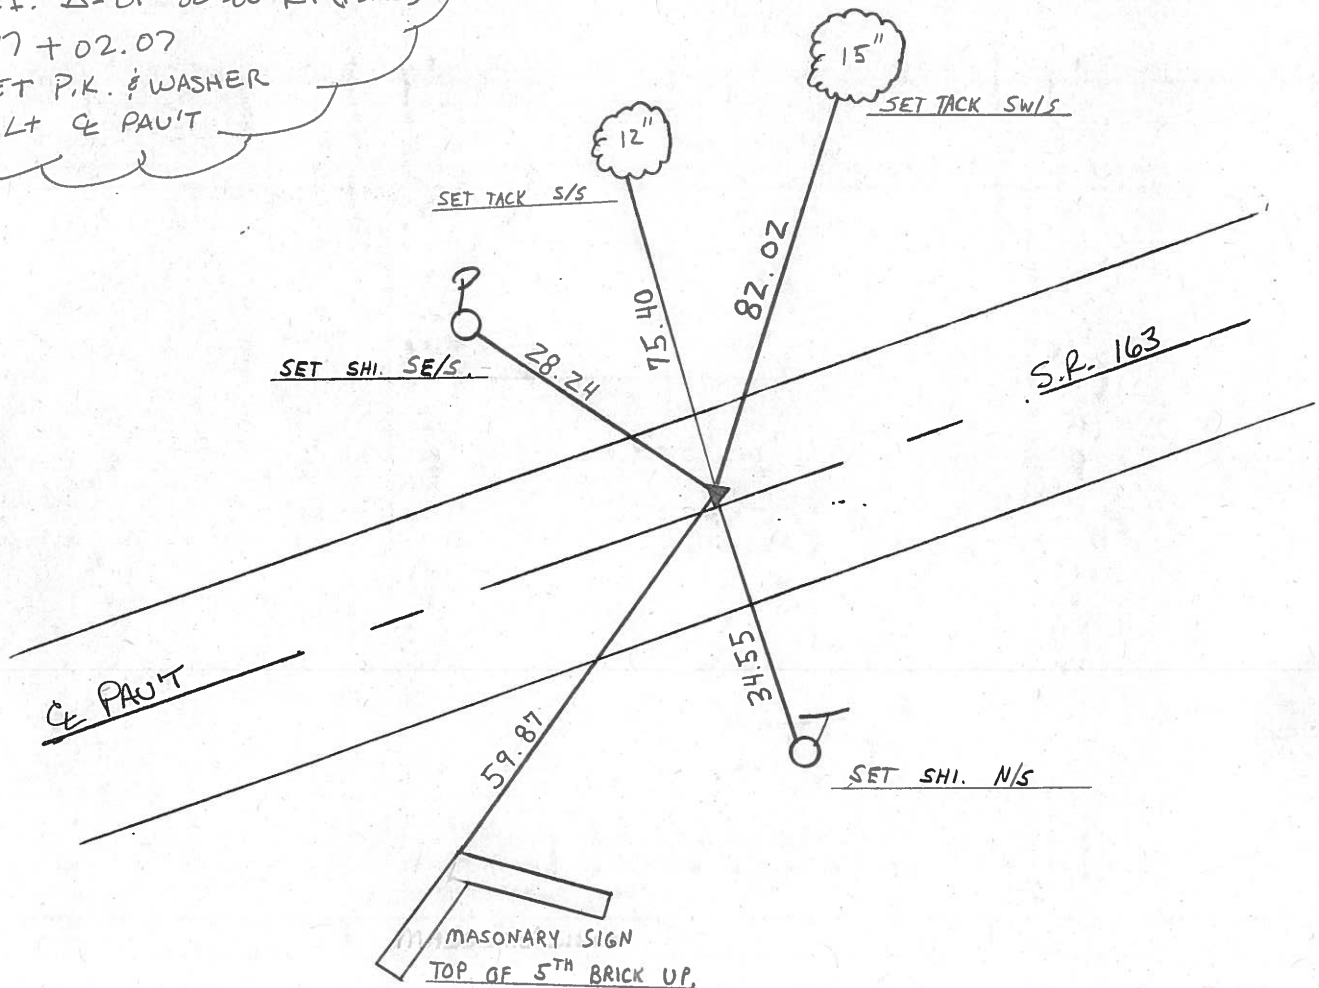

County Ottawa S.R. #163

Date 11/22/83

Township Danbury

Weather sunny

Section

Temp. 44°


T-N, R-E

Personnel Cronin


Ripple

Geyman

Barbour

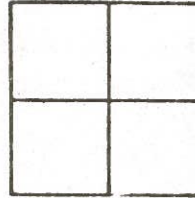

140

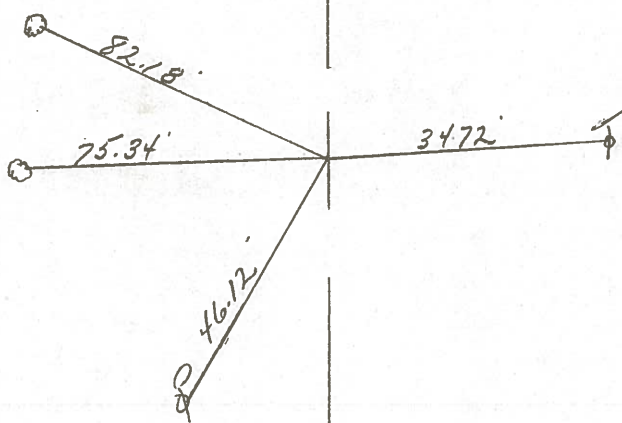


Plan
 P.I. $\Delta = 01^{\circ}52' Rt.$
 417 + 02.07
 set P.K. & washer
 1' Lt. & Paint


S.R. #163

PERSONNEL	TITLE	PERSONNEL	TITLE	COUNTY	DATE	WEATHER	TEMP.
				Ottawa	6-10-71		
				S. R. 163			
				SEC. 2			
DESCRIPTION	S.R. # 269	East					
	LEFT	CENTER LINE	RIGHT				JOB NO.


P.I. **(140)**
 417+02.07
 P.K. Nail

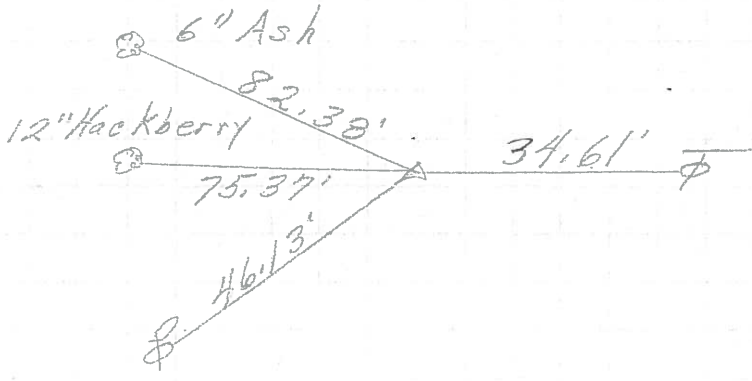

(139)
 412+40.07
 P.K. Nail

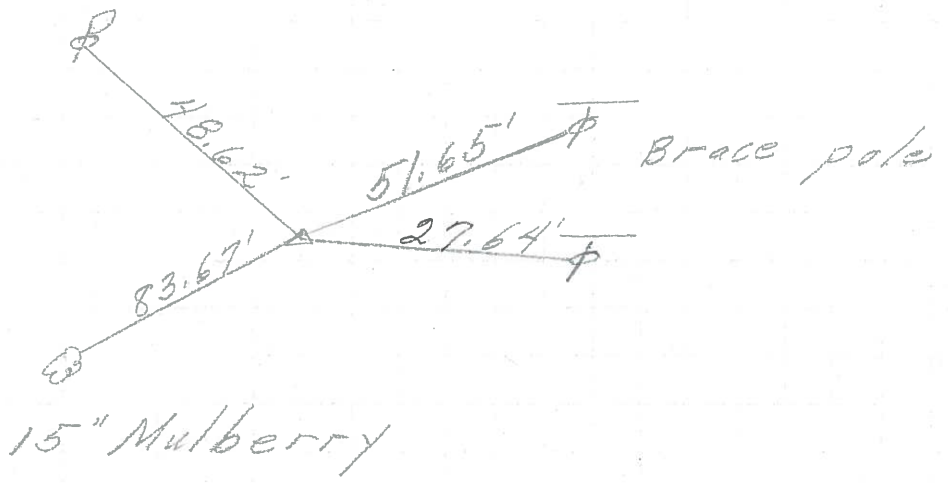

(138)
 398+10.26

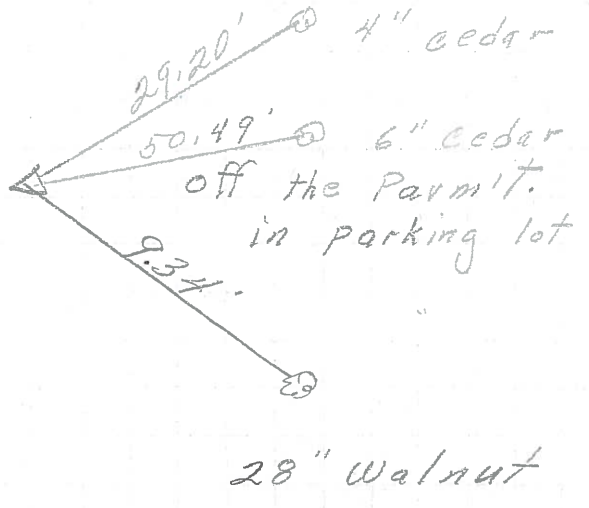

did not find

28" Walnut

PERSONNEL	TITLE	PERSONNEL	TITLE	COUNTY	DATE	WEATHER	TEMP.
Schneider		Potts		Ottawa	9-10-68	cloudy	70°
Mosser				S. R. 163			
Barbour				SEC. S.R.#269 - East			
Redding							

DESCRIPTION Ties for Control Points JOB NO. _____

