


O.D.O.T. DISTRICT 2 SURVEY OFFICE (USE ONLY)

PERSONNEL _____ REFERENCE NO. 141 B SHEET 27 OF 63
 NOTES MOSER DATE 5/6/11 ROUTE SR 163
 H.C. MOSER WEATHER CLOUDY COUNTY OTTAWA
 R.C. HARBAUGH TEMP. 60° TOWNSHIP DANBURY
 SECTION 1-9
 DWG BY NIESE PID 107060


TYPE MONUMENT 3/4" IPIN
~~ON SURFACE~~ - BELOW 2"
 OFFSET C PAVEMENT 26.1' ~~LT~~ : RT
14.0' RT TO RT EDGE PAVEMENT
 STATION: 1853+48

NOTE:
 THIS MAP IS FOR ODOT PURPOSES ONLY
 TO INDEX REFERENCE TIES, AND DOES NOT
 REPRESENT TRUE LAND SUBDIVISION.

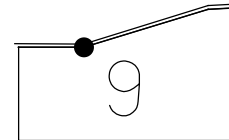

HORZ. DATUM: NAD83(2011) GEOID: 2012A
 GRID: NORTHING: 680310.099 EASTING: 1897181.991

RECORD: P.I.
 $\Delta = 20^\circ 40' \text{ LT}$
 STA. 450+27.85
 1991 PLAN
 FD IPIN
 2" DOWN
 FD 3/4" IPIN
 SV120
 4/29/10, KPM
 SV121
 9/9/10, JMH

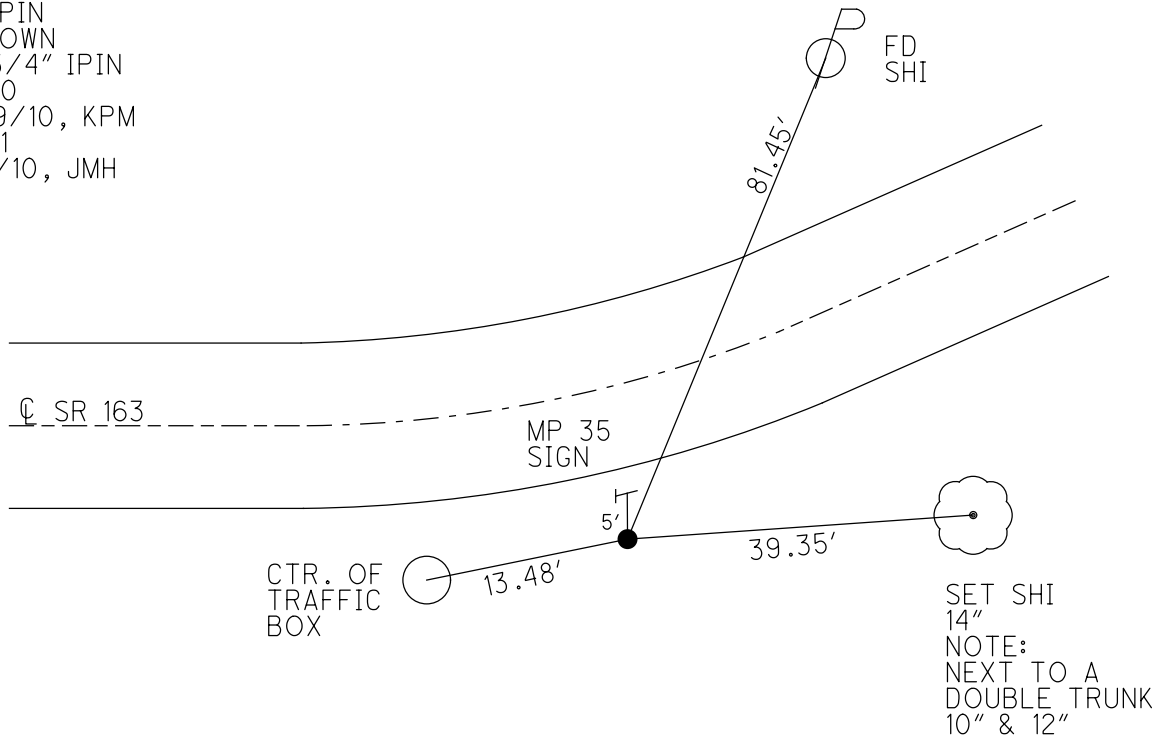

O.D.O.T. DISTRICT 2 SURVEY OFFICE (USE ONLY)

PERSONNEL _____ REFERENCE NO. 141 B SHEET 27 OF 63

NOTES MOSER DATE 5/6/11 ROUTE SR 163

H.C. MOSER WEATHER CLOUDY COUNTY OTTAWA

R.C. HARBAUGH TEMP. 60° TOWNSHIP DANBURY

SECTION 1-9

TYPE MONUMENT 3/4" IPIN


~~ON SURFACE~~ - BELOW 2"

~~LEFT~~ - CL PAV'T - RIGHT 26.1'

14' RT TO RT EDGE PAVEMENT

S.L.M. 1853+48


Grid: Northing: 680310.099 Easting: 1897181.991

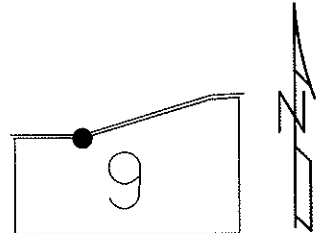

1991 RECORD
 P.I. Δ = 20° 40' LT. (PLAN)
 450+27.85
 FD IPIN 2" BELOW GROUND
 14' RT. OF RT. E.P.

FD 3/4" IPIN
 GPS, SV120
 4/29/10, KPM

RESHOT
 GPS, SV121
 9/9/10, JMH

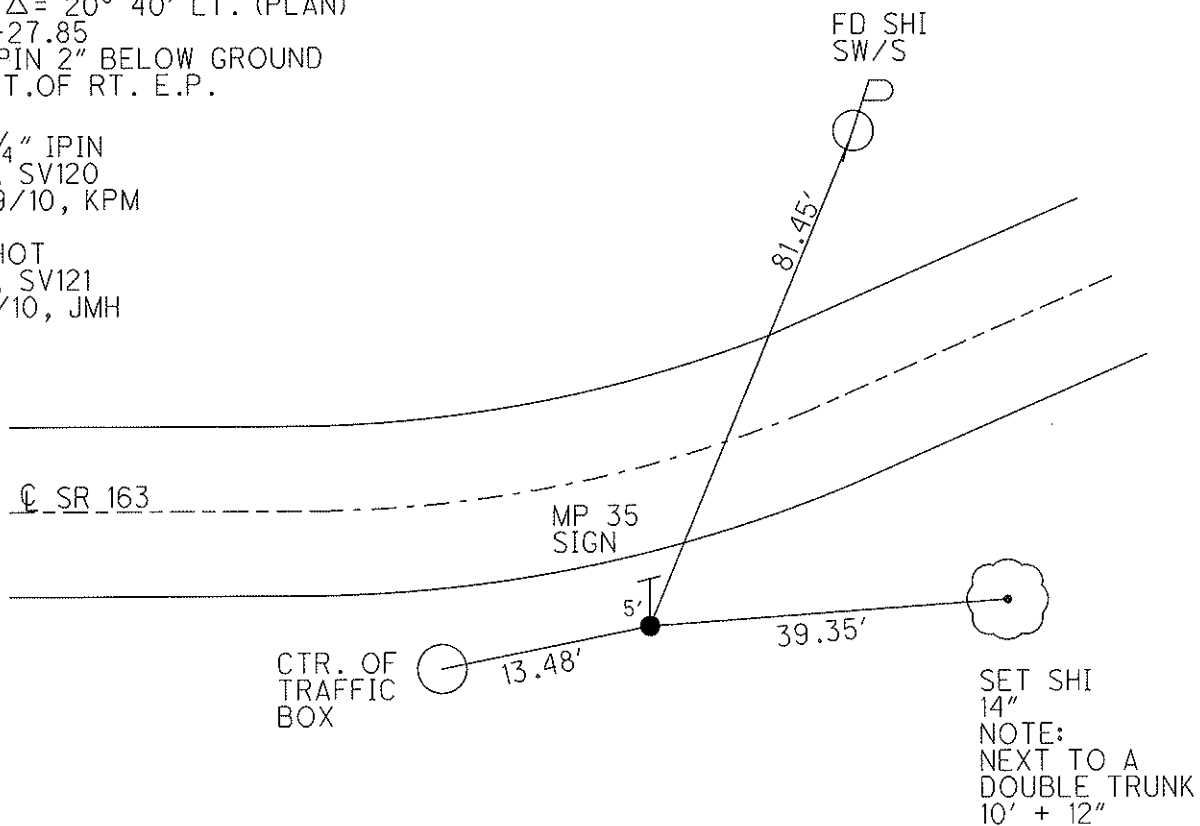

O.D.O.T. DISTRICT 2 SURVEY OFFICE

PERSONNEL _____

REFERENCE NO. 141 B

SHEET 20 OF 52

NOTES CANTERBURY

H.C. LOHRKE

R.C. ROUSOS

DATE 5-25-95

WEATHER CLOUDY

TEMP. +60°F

ROUTE S.R. 163

COUNTY OTTAWA

TOWNSHIP DANBURY

SECTION CONV. WEST. RESERVE

T. _____ R. _____


TYPE MONUMENT IRON PIN 3/4"

ON SURFACE - BELOW 2" BELOW


LEFT - CL. PAV'T. - RIGHT 26.1 RT &

14' RT. OF 50 RT. EDGE PAVEMENT

S.L.M. 1853 + 48

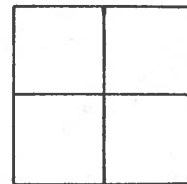

1991 RECORD
 P.I. $\Delta = 20^{\circ}40'00''$ Lt. (PLAN)
 450 + 27.85
 FOUND. I. PIN 2" BELOW GROUND
 14' RT. RT. E.P.

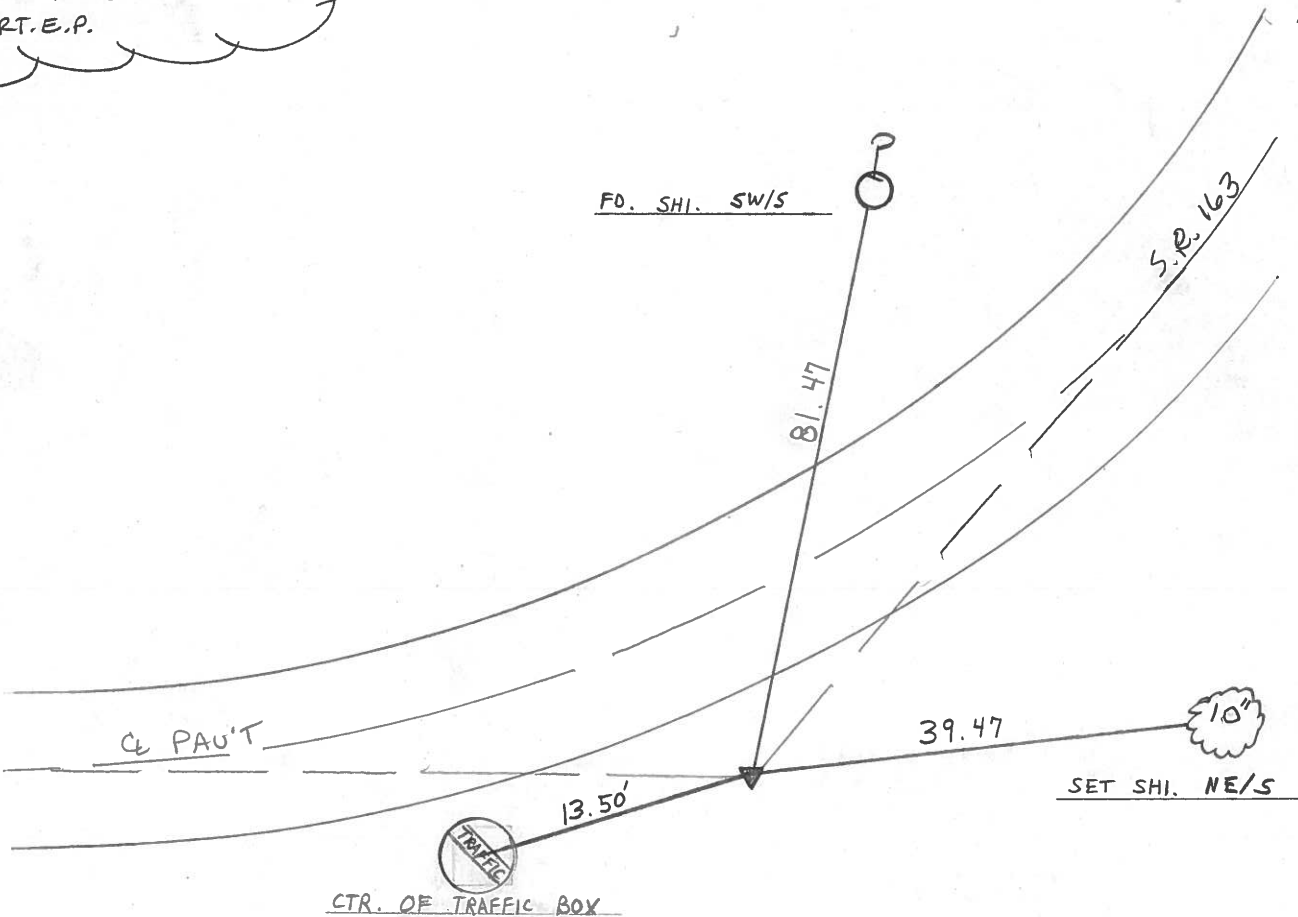

O.D.O.T. DISTRICT 2 SURVEY OFFICE

PERSONNEL

REFERENCE NO. 141 B

SHEET 15 OF 15

NOTES RIPPLE

H.C. BARBOUR

R.C. GEYMAN

DATE 2/26/91

WEATHER SNOW

TEMP. 20°

ROUTE SR#163

COUNTY OTTAWA

TOWNSHIP DANBURY

SECTION -

T - - R - -


TYPE MONUMENT "I." PIN

ON SURFACE - BELOW -

LEFT - <math>C</math> PAV'T. - RIGHT 14' RT. RT. E.P.

TO EDGE PAVEMENT


S.L.M. 34.8

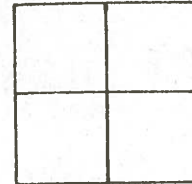

P.I. $\Delta = 20^{\circ} 40' Lt.$

450 + 27.85

Found I. Pin 2" below
ground 14' RT. RT. E.P.

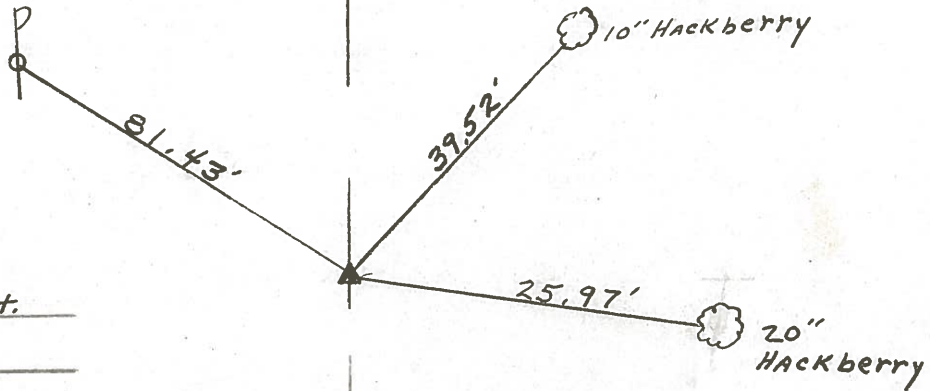

S.R. #1637

County Ottawa S.R. #163

Date 11/22/83

Township Danbury

Weather sunny

Section _____

Temp. 46°

T-N, R-E



Personnel Cronin

Ripple

Geymen

Barbour

141B

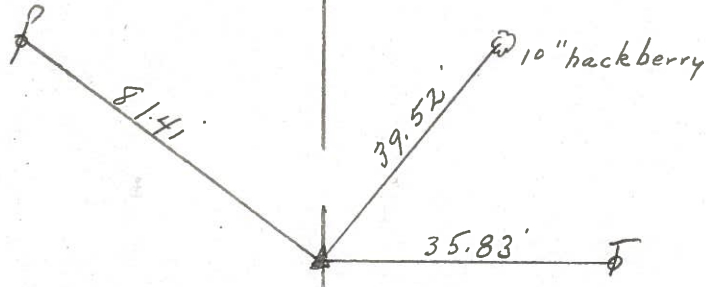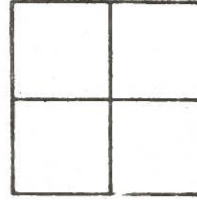

Plan
P.I. A = 20°40' Lt.


450 ± 27.85

Fd. I. Pin 2" below
ground 14' Rt.-Rt. E.R.


S.R. #163

PERSONNEL	TITLE	PERSONNEL	TITLE
COUNTY <u>Ottawa</u> DATE <u>6-10-71</u>			
S. R. <u>163</u> WEATHER _____			
SEC. <u>1</u> TEMP. _____			
DESCRIPTION <u>S.R. # 269</u>		<u>East</u>	
	LEFT	CENTER LINE	RIGHT
JOB NO. _____			


P.I. **(141B)**
 450+27.85
 Iron Pin
 All dist. plumbed.
 2" down - 14' Rt. of
 Rt. edge of Pavmit.

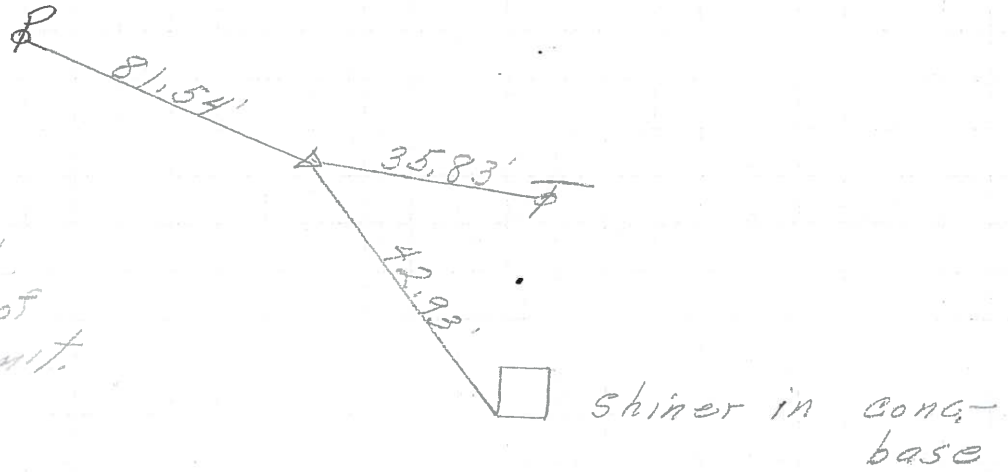

P.I. **(141A)**
 436+43.20
 P.K. Nail
 on Black top dr.

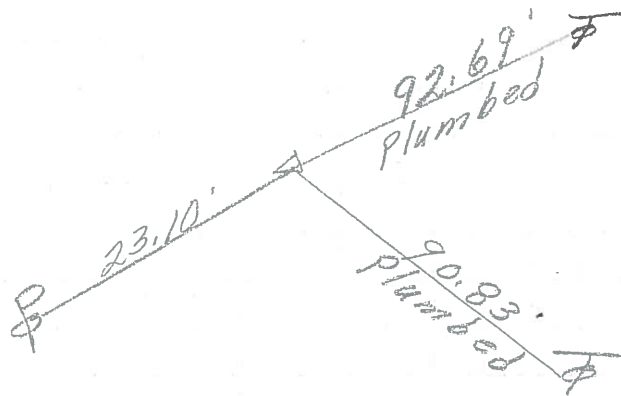

P.I. **(141)**
 420+26.90
 P.K. Nail

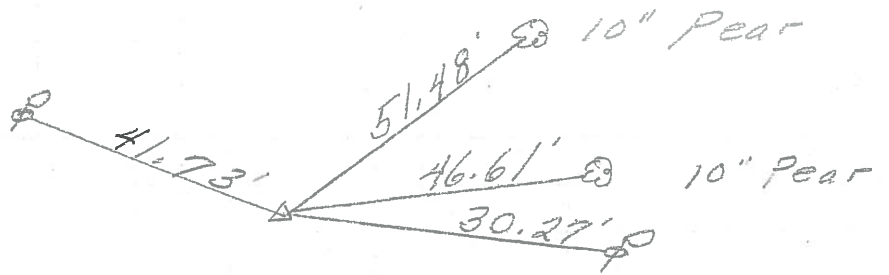

PERSONNEL	TITLE	PERSONNEL	TITLE	COUNTY	DATE
Schneider		Potts		Ottawa	9-10-68
Mosser				S. R. 163	WEATHER cloudy
Barbour				SEC. S.R. # 269 - East	TEMP. 70'
Redding					

DESCRIPTION Ties for Control Points JOB NO. _____

