
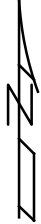


O.D.O.T. DISTRICT 2 SURVEY OFFICE (USE ONLY)

PERSONNEL _____ REFERENCE NO. 141 C SHEET 28 OF 66
 NOTES MOSER DATE 5/6/11 ROUTE SR 163
 H.C. MOSER WEATHER DRIZZLE COUNTY OTTAWA
 R.C. HARBAUGH TEMP. 60° TOWNSHIP DANBURY
 DWG BY NIESE PID 107060 SECTION 1-9


TYPE MONUMENT P.K./WASHER
 ON SURFACE - ~~BELOW~~ ON
 OFFSET C PAVEMENT 6.5' ~~LT~~ : RT
4.5' TO RT EDGE PAVEMENT
 STATION: 1861+16

NOTE:
 THIS MAP IS FOR ODOT PURPOSES ONLY
 TO INDEX REFERENCE TIES, AND DOES NOT
 REPRESENT TRUE LAND SUBDIVISION.

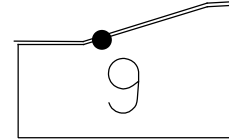

HORIZ.DATUM: NAD83(2011) GEOID: 2012A
 GRID: NORTHING: 680589.978 EASTING: 1897901.094

RECORD: P.I.
 $\Delta = 05^\circ 30' \text{ LT}$
 STA.457+97.80
 1983 PLAN
 SET P.K./WASHER
 ATOP BOAT SPIKE/WASHER
 SET P.K./WASHER
 6/5/96
 FD P.K./WASHER
 4/8/10, 4/29/10
 SV122
 4/29/10, KPM
 SET MAG/WASHER
 FINREFC141
 9/19/12, SDC
 FD P.K./WASHER
 REFC141
 4/2/19
 9/13/19, JFO
 4/21/22, JFO

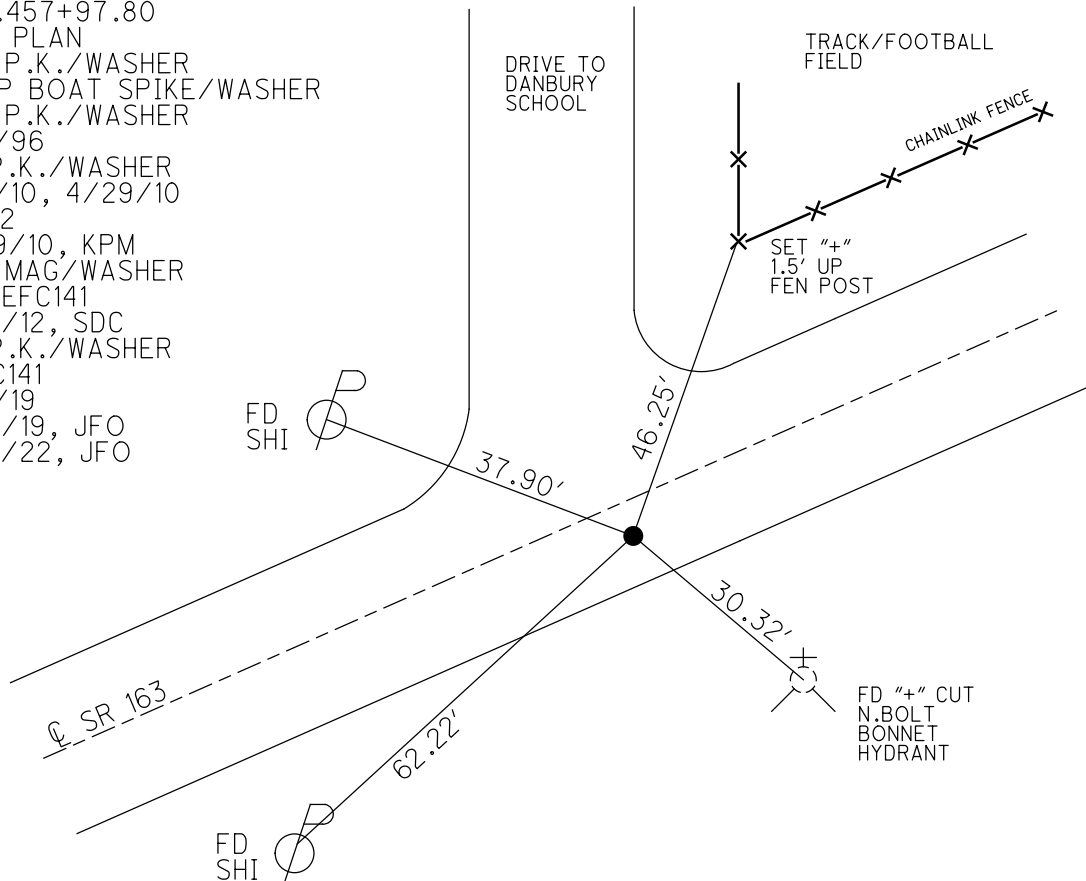


O.D.O.T. DISTRICT 2 SURVEY OFFICE (USE ONLY)

PERSONNEL _____ REFERENCE NO. 141 C SHEET 28 OF 63
 NOTES MOSER DATE 5/6/11 ROUTE SR 163
 H.C. MOSER WEATHER DRIZZLE COUNTY OTTAWA
 R.C. HARBAUGH TEMP. 60° TOWNSHIP DANBURY
 SECTION 1-9

DWG BY NIESE PID 107060


TYPE MONUMENT P.K./WASHER
 ON SURFACE - ~~BELOW~~ ON
 OFFSET CL PAVEMENT 6.5' LT : RT
4.5' TO RT EDGE PAVEMENT
 STATION: 1861+16

NOTE:
 THIS MAP IS FOR ODOT PURPOSES ONLY
 TO INDEX REFERENCE TIES, AND DOES NOT
 REPRESENT TRUE LAND SUBDIVISION.

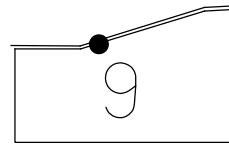

HORZ.DATUM: NAD83(2011) GEOID: 2012A
 GRID: NORTHING: 680589.978 EASTING: 1897901.094

RECORD: P.I.
 $\Delta = 05^\circ 30' \text{ LT}$
 STA. 457+97.80
 1983 PLAN
 SET P.K./WASHER
 ATOP BOAT SPIKE/WASHER
 SET P.K./WASHER
 6/5/96
 FD P.K./WASHER
 4/8/10, 4/29/10
 SV122
 4/29/10, KPM
 SET MAG/WASHER
 FINREFC141
 9/19/12, SDC
 FD P.K./WASHER
 REFC141
 4/2/19
 9/13/19, JFO

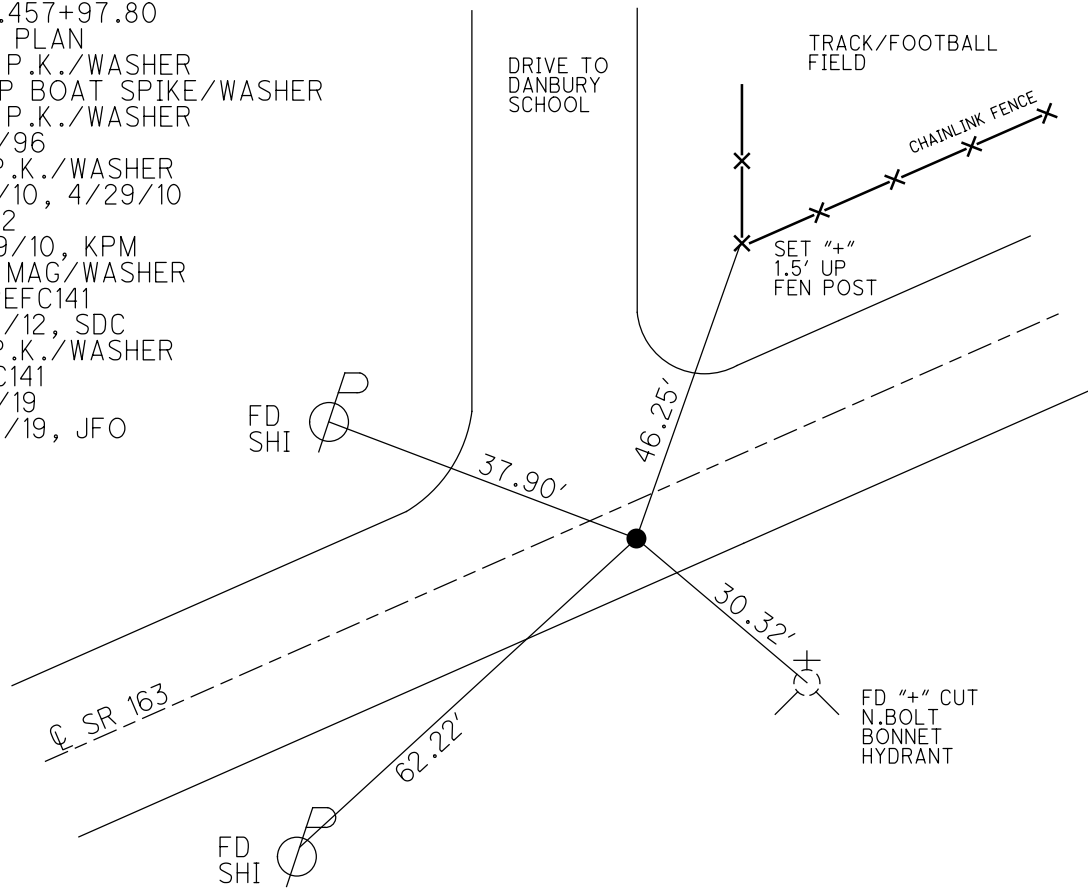

O.D.O.T. DISTRICT 2 SURVEY OFFICE (USE ONLY)

PERSONNEL

REFERENCE NO. 141 C

SHEET 28 OF 63

NOTES MOSER

DATE 5/6/11

ROUTE SR 163

H.C. MOSER

WEATHER DRIZZLE

COUNTY OTTAWA

R.C. HARBAUGH

TEMP. 60°

TOWNSHIP DANBURY

SECTION 1-9

TYPE MONUMENT P.K./WASHER


ON SURFACE - BELOW ON

LEFT - Q PAV'T - RIGHT 6.5'


4.5' TO RT EDGE PAVEMENT

S.L.M. 1861+16

Grid: Northing: 680589.902 Easting: 1897901.037

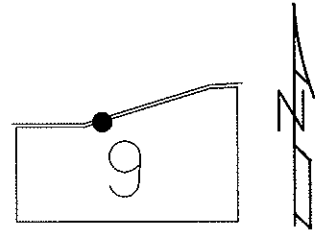

1983 RECORD
 P.I. Δ = 05° 30' LT. (PLAN)
 457+97.80
 SET P.K./WASHER ATOP
 BOAT SPIKE/WASHER
 7' RT. Q PAV'T

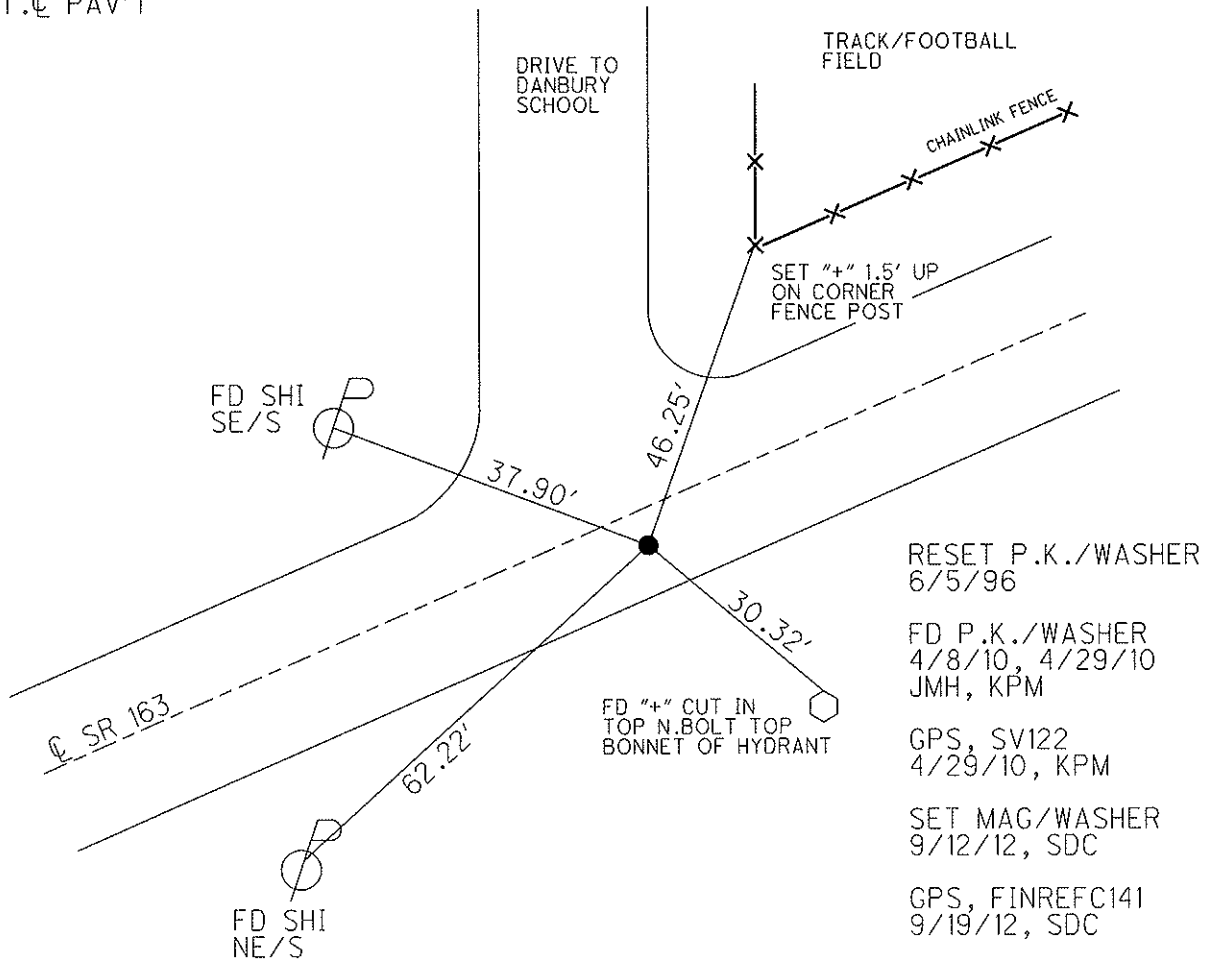

O.D.O.T. DISTRICT 2 SURVEY OFFICE

PERSONNEL

REFERENCE NO. 141 C

SHEET 21 OF 52

NOTES CANTERBURY

H.C. LOEHRKE

R.C. ROUSOS

DATE 5-25-95

WEATHER CLOUDY

TEMP. +60° F

ROUTE S.R. 163

COUNTY OTTAWA

TOWNSHIP DANBURY

SECTION CONN. WEST. RESERVE

T. R.

Reset

6-5-96


TYPE MONUMENT PR NAIL / WASHER

ON SURFACE - BELOW ON SURFACE

LEFT - ☉ PAV'T. - RIGHT 6.8' RT ☉

4.9' TO RT EDGE PAVEMENT

S.L.M. 1861 + 16

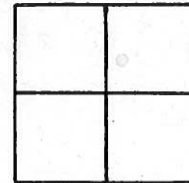

1983 RECORD


P.I. $\Delta = 65^{\circ} - 30' - 00''$ LT (PLAN)

457+97.80

SET P.K. $\&$ WASHER ATOP BOAT SPK.

$\&$ WASHER 7.0' RT. $\&$ PAV'T

TRACK &
FOOTBALL
FIELD

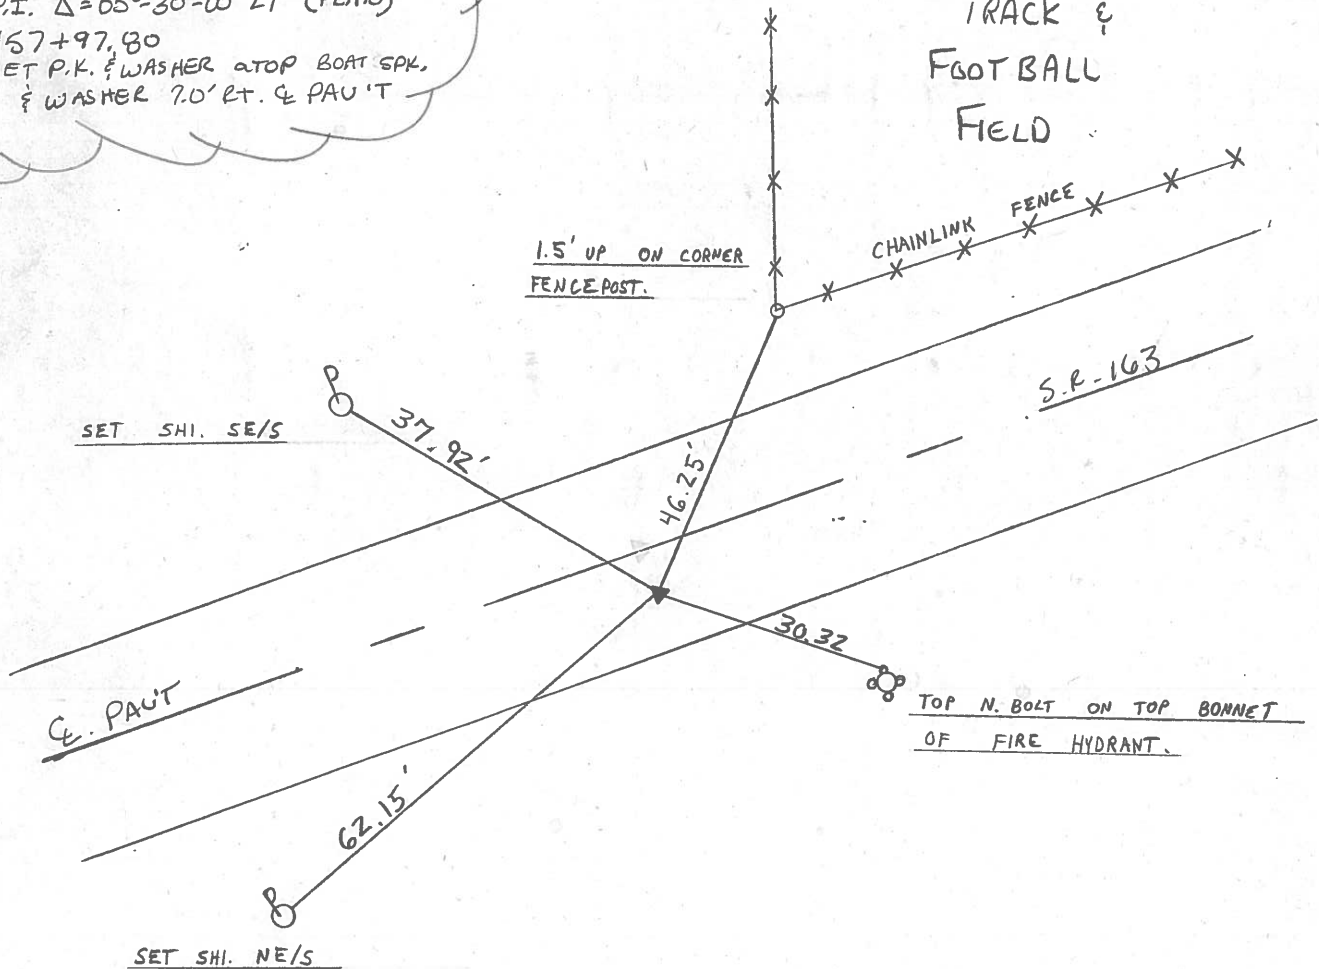

County Ottawa S.R. #163

Date 11/22/83

Township Danbury

Weather sunny

Section _____

Temp. 46°


T-N, R-E

Personnel Cronin


Lippie

Geyman

Barbour

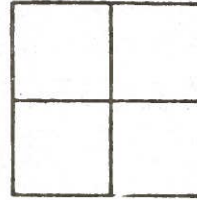


141 C

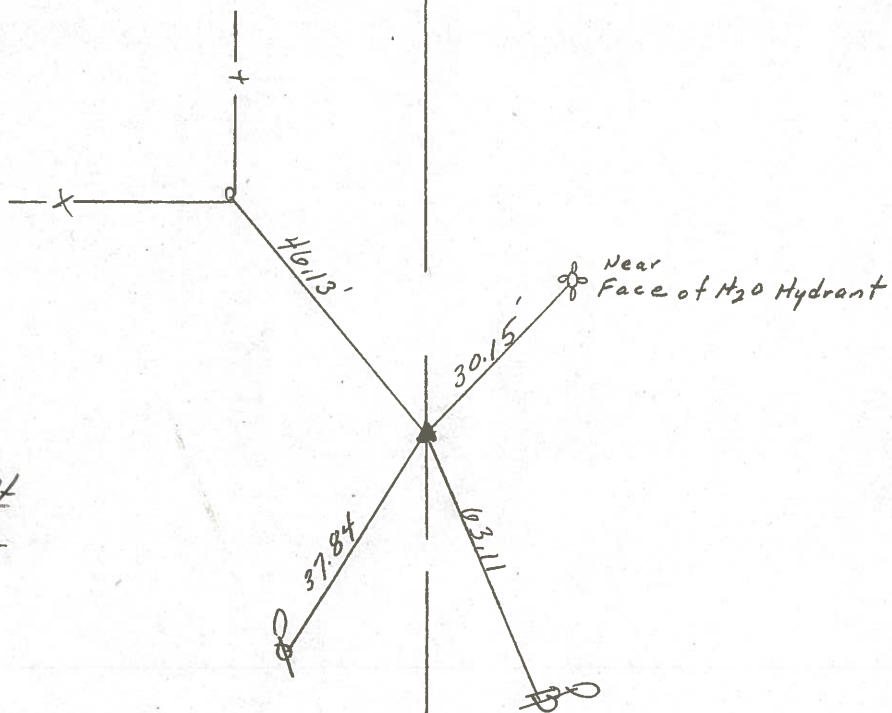

P.I. - Δ = 05°30' Lt.
457 + 97.80
Set P.K. & washer atop
boat spike & washer 7.0' Rt
& Pavement

S.S.R. #163

PERSONNEL _____ TITLE _____ PERSONNEL _____ TITLE _____
 COUNTY Ottawa DATE 6-10-71
 S. R. 163 WEATHER _____
 SEC. 1 TEMP. _____
 DESCRIPTION S.R. # 269 East JOB NO. _____

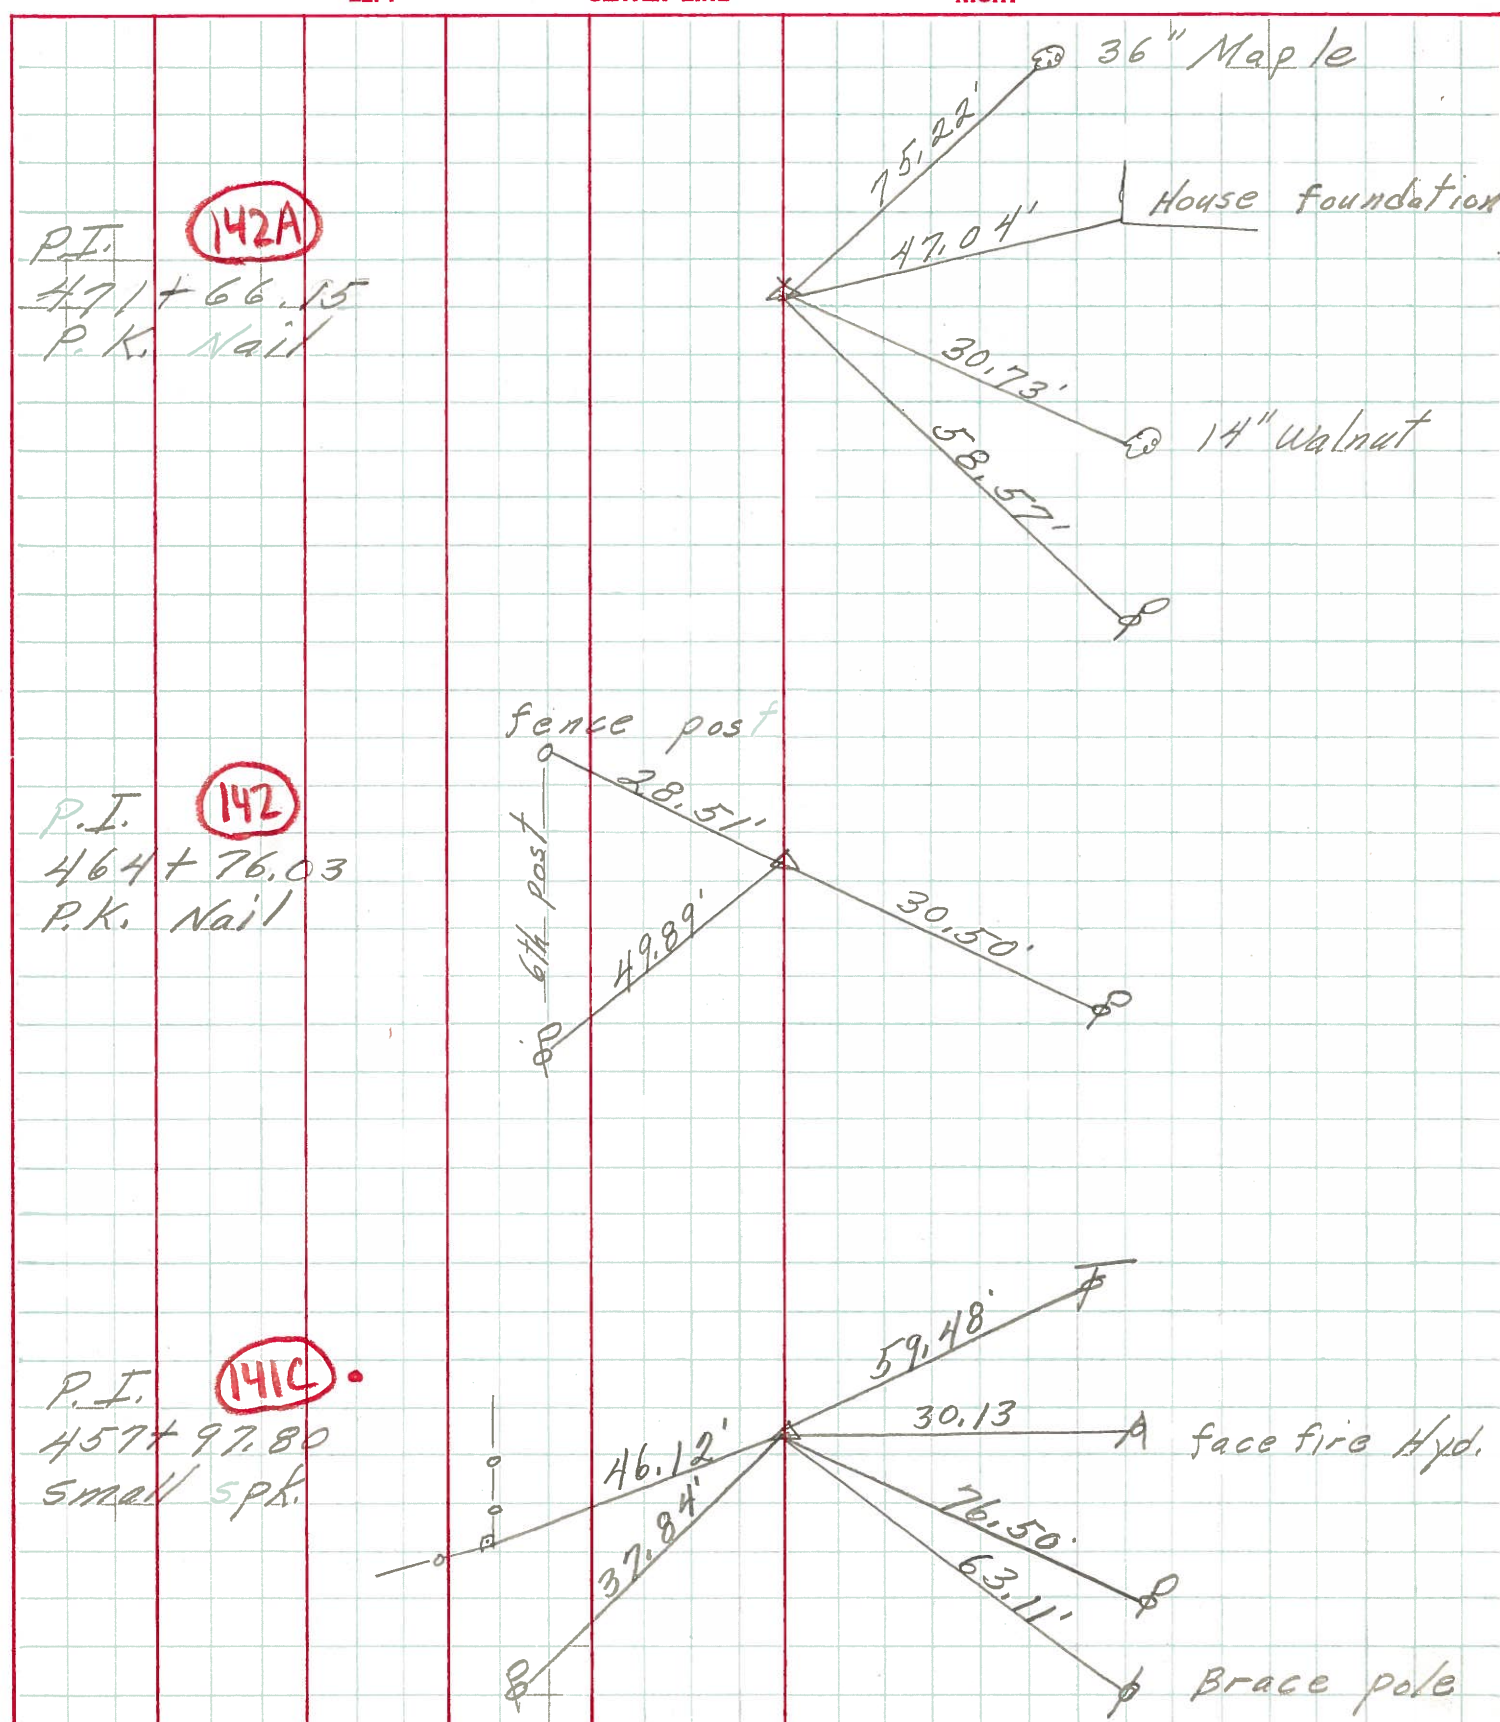

PERSONNEL	TITLE	PERSONNEL	TITLE	COUNTY	DATE
Schneider		Potts		Ottawa	9-10-68
Mosser				S. R. 163	WEATHER Cloudy
Barbour				SEC. S.R. #269 - East	TEMP. 70'
Redding					

DESCRIPTION Ties for Control Points JOB NO. _____

