


O.D.O.T. DISTRICT 2 SURVEY OFFICE (USE ONLY)

PERSONNEL _____ REFERENCE NO. 143 A SHEET 34 OF 63
 NOTES MOSE DATE 5/6/11 ROUTE SR 163
 H.C. MOSE WEATHER CLOUDY COUNTY OTTAWA
 R.C. HARBAUGH TEMP. 60° TOWNSHIP DANBURY
 SECTION 1-7


DWG BY NIESE PID 107060

TYPE MONUMENT 5/8" IPIN
 ON SURFACE - ~~BELOW~~ 3"
 OFFSET Q PAVEMENT 22.4' LT : ~~RT~~
10.7' LT TO LT EDGE PAVEMENT

NOTE:
THIS MAP IS FOR ODOT PURPOSES ONLY
TO INDEX REFERENCE TIES, AND DOES NOT
REPRESENT TRUE LAND SUBDIVISION.

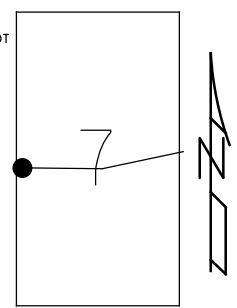

STATION: 1904+45
 HORZ. DATUM: - GEOID: -
 GRID: NORTHING: 682351.765 EASTING: 1901773.188


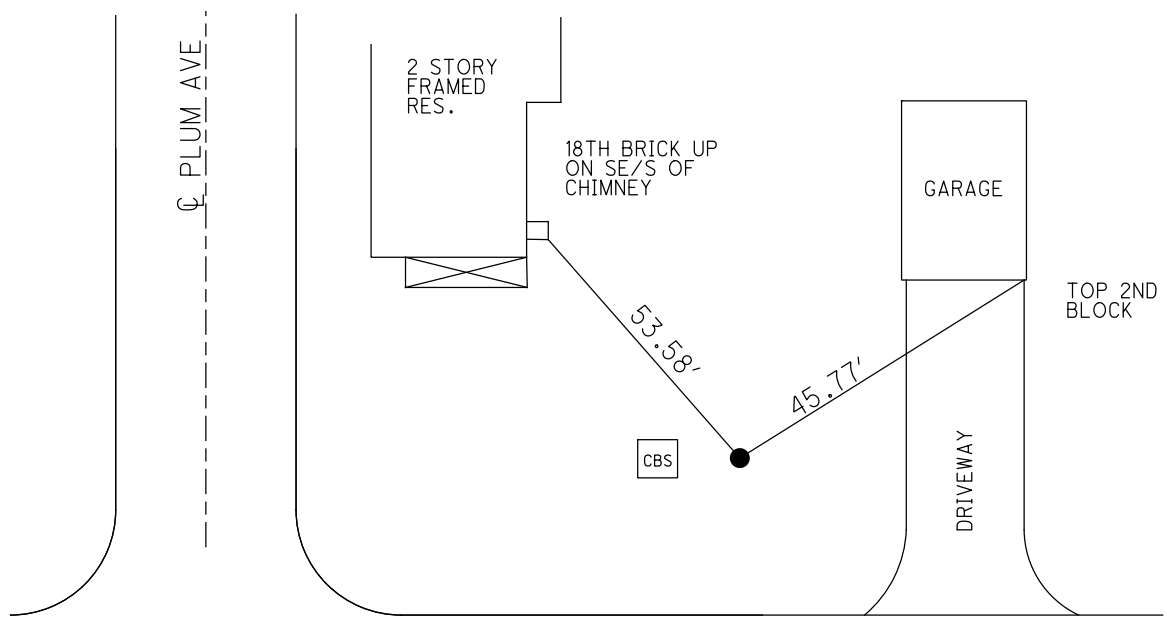


RECORD: P.I.
 $\Delta = 09^\circ 46' RT$
 STA. 501+16.73
 FD IPIN
 4/8/10, 4/29/10
 SV128
 4/29/10, KPM
 9/9/10, JMH

O.D.O.T. DISTRICT 2 SURVEY OFFICE (USE ONLY)

PERSONNEL _____ REFERENCE NO. 143 A SHEET 34 OF 63
 NOTES MOSER DATE 5/6/11 ROUTE SR 163
 H.C. MOSER WEATHER CLOUDY COUNTY OTTAWA
 R.C. HARBAUGH TEMP. 60° TOWNSHIP DANBURY
 _____ SECTION 1-7

TYPE MONUMENT 5/8" IPIN
 ON SURFACE - ~~BELOW~~ 3"
 LEFT - ☉ PAV'T - ~~RIGHT~~ 22.4'
10.7' LT TO LT EDGE PAVEMENT
 S.L.M. 1904+45
 Grid: Northing: 682351.765 Easting: 1901773.188

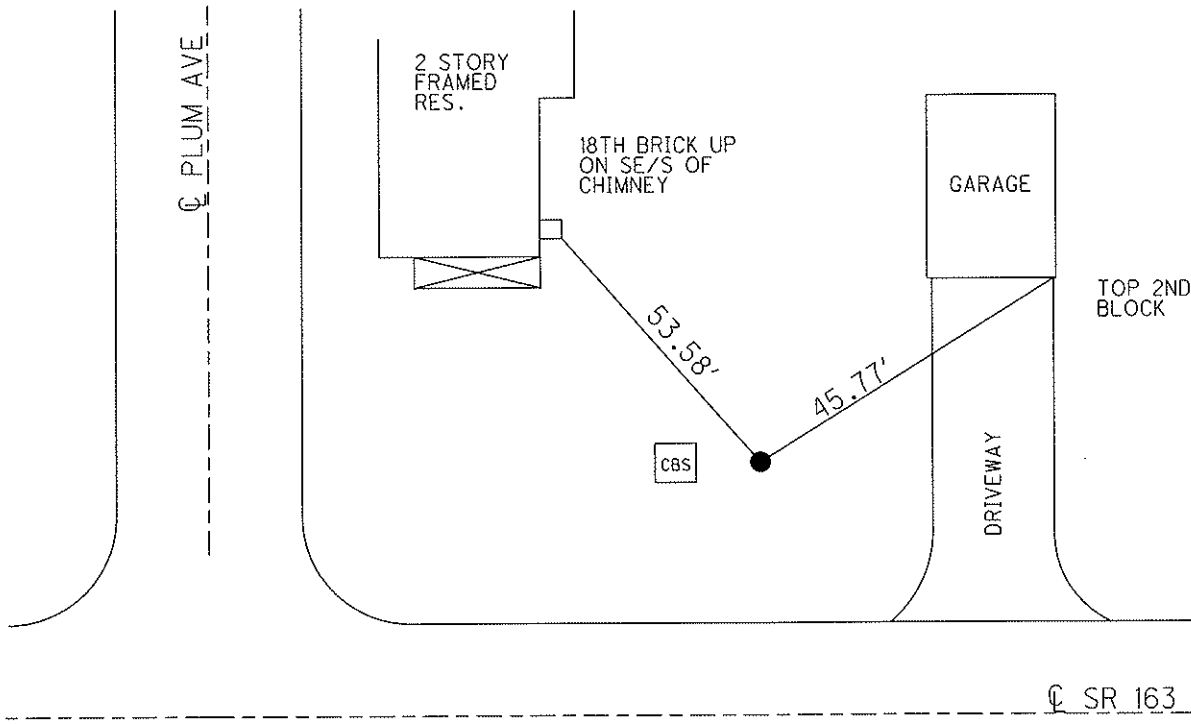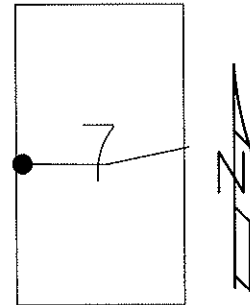

RECORD
 P.I. $\Delta = 09^\circ 46'$ RT.
 501+16.73
 NE/COR. OF PLUM AVE.
 AND SR163. 1' IN.

FD IPIN
 4/8/10, 4/29/10
 JMH, KPM
 GPS, SV128
 4/29/10, KPM
 9/9/10, JMH

O.D.O.T. DISTRICT 2 SURVEY OFFICE

PERSONNEL

REFERENCE NO. 143 A

SHEET 27 OF 52

NOTES CANTERBURY

H.C. LOEHRKE

R.C. ROUSOS

DATE 5-30-95

WEATHER FAIR

TEMP. +65° F

ROUTE S.R. 163

COUNTY OTTAWA

TOWNSHIP DANBURY

SECTION _____

T _____ R _____



TYPE MONUMENT IRON ROD

ON SURFACE - BELOW 3" BELOW

LEFT - CL PAV'T. - RIGHT 22.4' LT CL

10.7' LT OF TO LT EDGE PAVEMENT

S.L.M. 1904 + 45

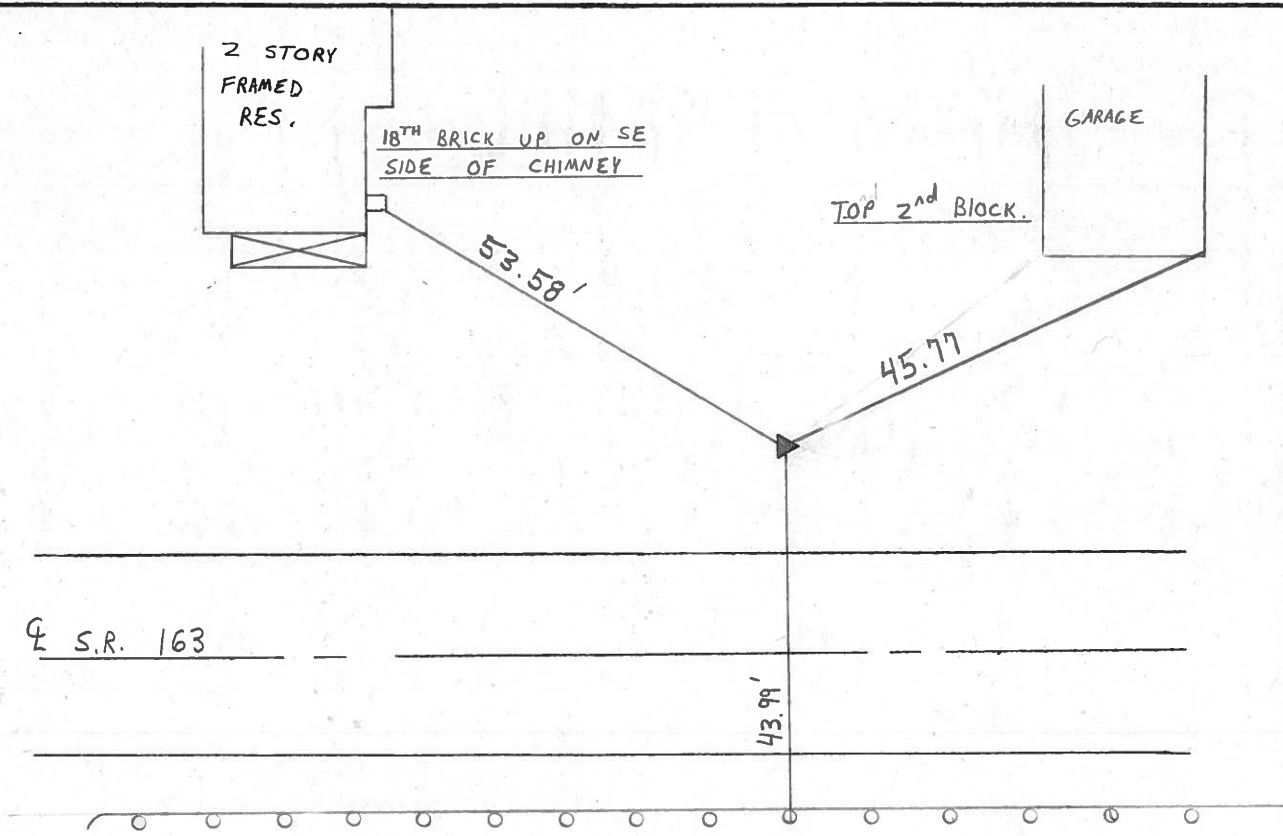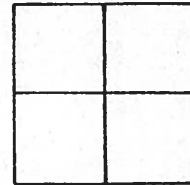

SET SHI. IN N/S 6-RAIL
POST, 10TH POST FROM WEST.

RECORD: P.I. $\blacktriangle = 09^{\circ} 46'$ RT

STA 501 + 16.73

NE/COR. OF PLUM ST. AND S.R. 163

County Ottawa S.R. #163

Date 12/13/83

Township Danbury

Weather sunny

Section _____

Temp. 36°


T N, R E

Personnel Cronin

Ripple

Geyman

Barbour

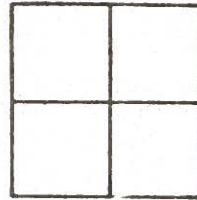

143A



Gar. Top 2nd block

37.30'

45.93'

11" birch

53.58'

18th brick up
in chimney

Plan
P.I. A = 09°46' Rt.
501 + 16.73
Fd. I. Rod 3" below
ground - 10.6' Lt. Lt. E.P.

S.R. #163