



O.D.O.T. DISTRICT 2 SURVEY OFFICE (USE ONLY)

PERSONNEL _____ REFERENCE NO. 145 A SHEET 37 OF 66
 NOTES MOSER DATE 5/6/11 ROUTE SR 163
 H.C. MOSER WEATHER CLOUDY COUNTY OTTAWA
 R.C. HARBAUGH TEMP. 60° TOWNSHIP DANBURY
 SECTION 1-7

DWG BY NIESE PID PVTRAIN

TYPE MONUMENT P.K./WASHER
 ON SURFACE - ~~BELOW~~ ON
 OFFSET Q PAVEMENT 11.0' LT : ~~RT~~
0.5' TO LT EDGE PAVEMENT
 STATION: 1914+37


NOTE:
THIS MAP IS FOR ODOT PURPOSES ONLY
TO INDEX REFERENCE TIES, AND DOES NOT
REPRESENT TRUE LAND SUBDIVISION.

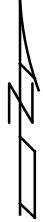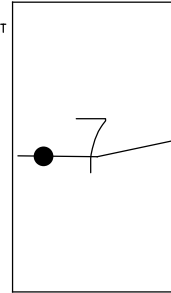

HORIZ.DATUM: NAD83 (2011) GEOID: NAVD88 2018
 GRID: NORTHING: 682423.991 EASTING: 1902754.616

RECORD: P.I.
 $\Delta = 15^{\circ}44'$ RT
 STA 510+96.55
 FD RUSTY HOLE IN
 ASPHALT PAV'T. LAST
 REMAINING TIE WAS
 GOOD TO SAID HOLE
 4/14/96, CAL
 SET P.K./WASHER
 6/5/96
 FD P.K./WASHER
 4/30/10, KPM
 5/6/11, KPM
 SET MAG/WASHER
 11/5/12, SDC
 FD MAG/WASHER
 11/9/12, SDC
 REFA145
 6/11/21, TDN
 2/7/22, JFO

POST
OFFICE

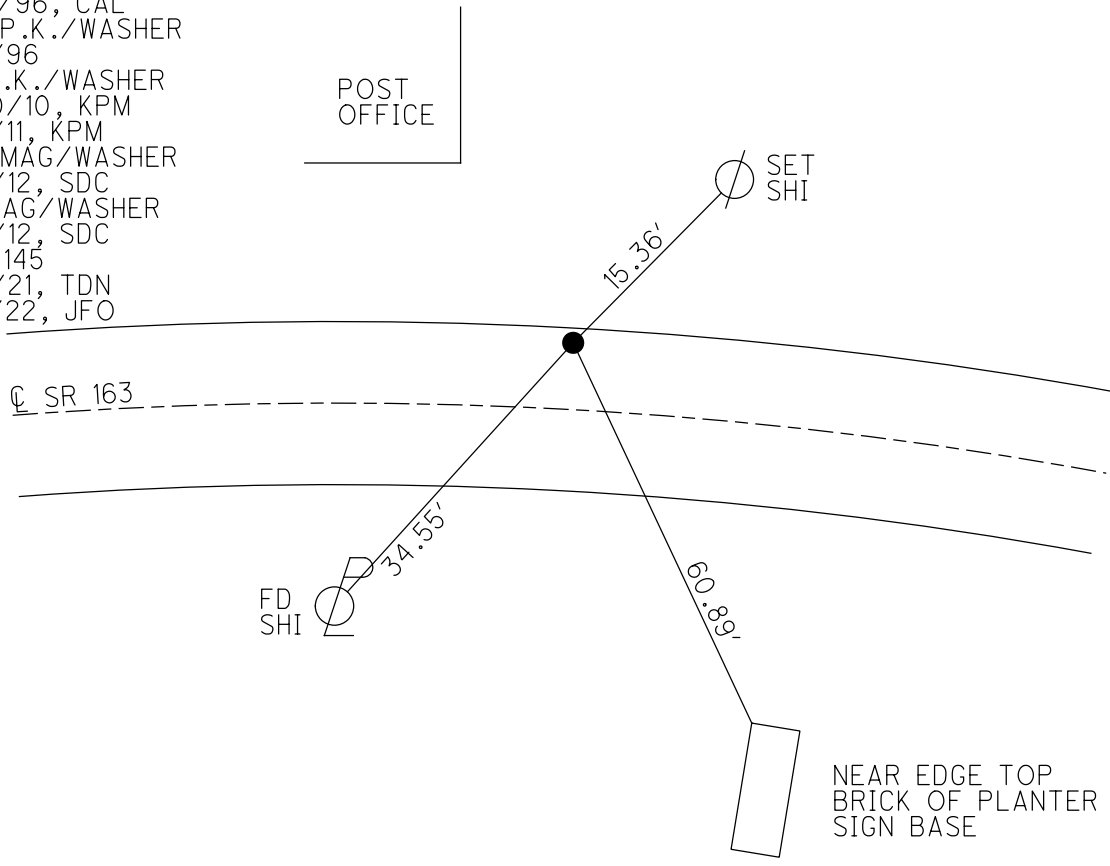


NEAR EDGE TOP
BRICK OF PLANTER
SIGN BASE

O.D.O.T. DISTRICT 2 SURVEY OFFICE (USE ONLY)

PERSONNEL _____ REFERENCE NO. 145 A SHEET 37 OF 63
 NOTES MOSER DATE 5/6/11 ROUTE SR 163
 H.C. MOSER WEATHER CLOUDY COUNTY OTTAWA
 R.C. HARBAUGH TEMP. 60° TOWNSHIP DANBURY
 _____ SECTION 1-7

TYPE MONUMENT P.K./WASHER
 ON SURFACE - ~~BELOW~~ ON
 LEFT - ☉ PAV'T - ~~RIGHT~~ 11.0'
0.5' TO LT EDGE PAVEMENT
 S.L.M. 1914+37
 Grid: Northing: 682423.914 Easting: 1902754.559

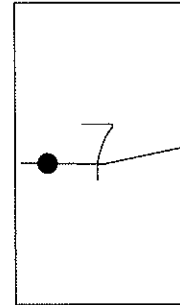

RECORD (PLAN)
 P.I. Δ = 15° 44' RT.
 510+96.55


NOTE: FD. RUSTY HOLE IN
 ASPHALT PAV'T. LAST REMAINING
 TIE WAS GOOD TO SAID HOLE.
 4/14/96, C.A.L.

RESET P.K./WASHER
 6/5/96

FD P.K./WASHER
 GPS, SV131
 4/30/10, KPM

SET MAG/WASHER
 11/5/12, SDC

GPS, FINREFA145
 11/9/12, SDC

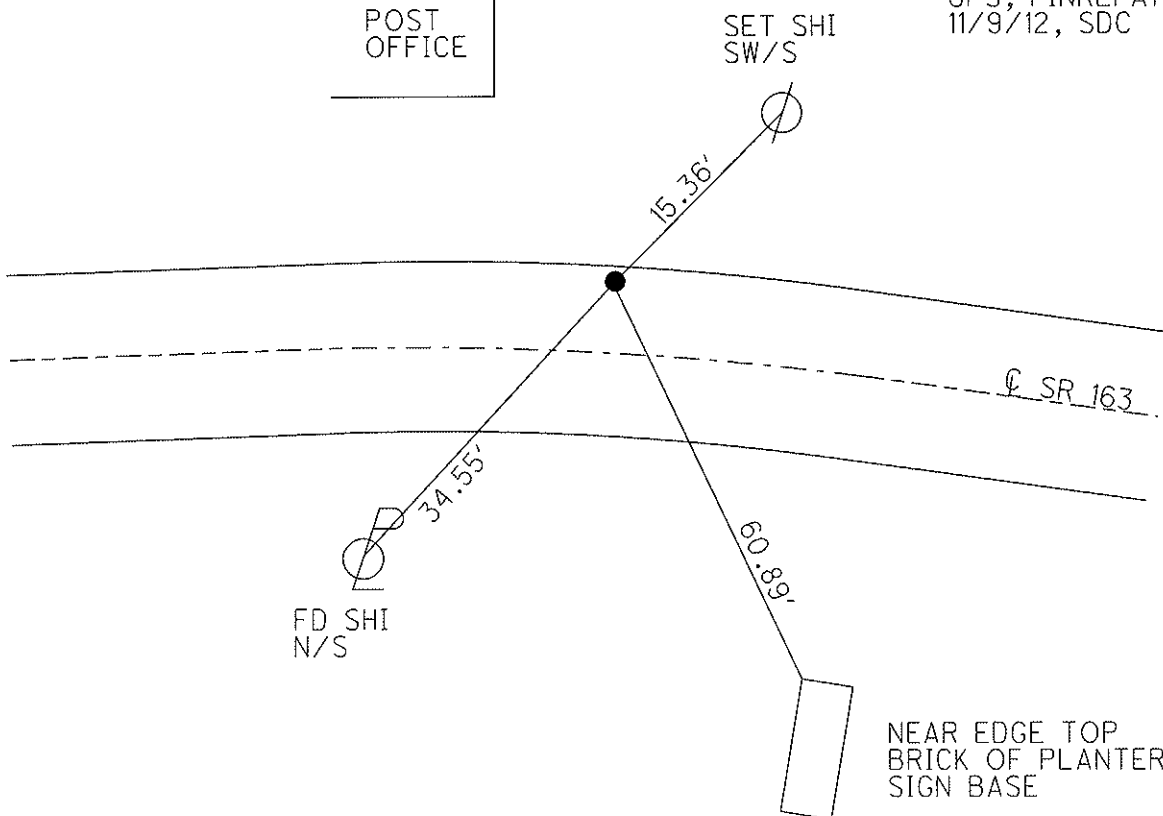

O.D.O.T. DISTRICT 2 SURVEY OFFICE

PERSONNEL

REFERENCE NO. 145A

SHEET 30 OF 52

NOTES CANTERBURY

H.C. LOEHKE

R.C. ROUSAS

DATE 5-30-95

WEATHER Nice

TEMP. +70

ROUTE S.R. 163

COUNTY OTTAWA

TOWNSHIP MARBLEHEAD

SECTION _____

T _____ R _____

TYPE MONUMENT "Rusty Hole"


Set P.K./WASHER
6-5-96

ON SURFACE - BELOW _____


LEFT - ℄ PAVT. - RIGHT 10.7

0.9 TO L+ EDGE PAVEMENT

S.L.M. 1914+37

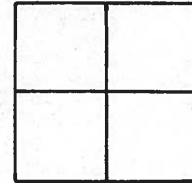

PLAN RECORD P.I.
Sta 510 + 96.55
 $\Delta = 15^{\circ} 44' \text{ Rt}$

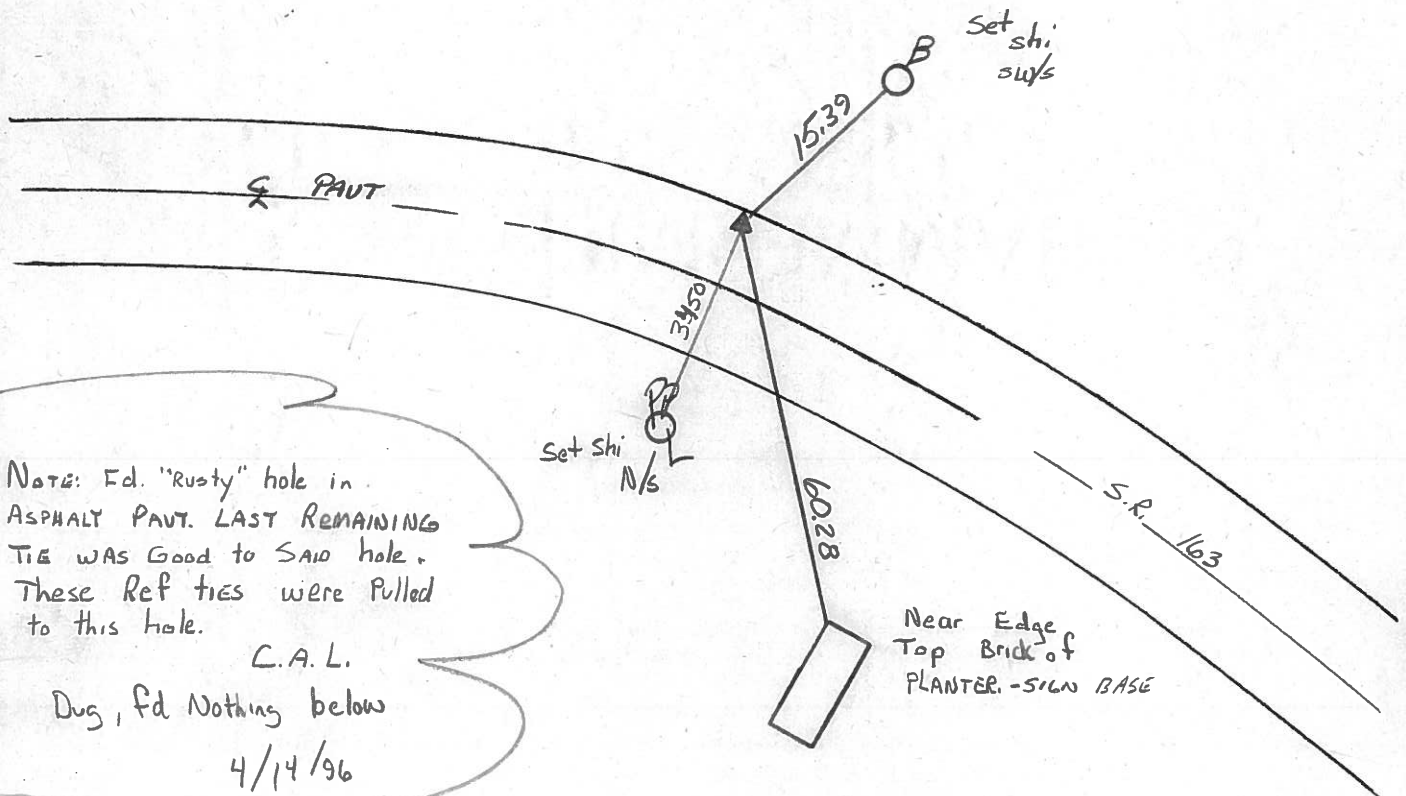

County Ottawa S.R. # 163

Date 12/13/83

Township Marblehead

Weather sunny

Section _____

Temp. 36°


T N, R E

Personnel Cronin

Ripple

Geyman


Barbour

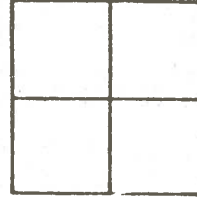

145 A



Plan
P.I. $\Delta = 15^{\circ}44'$ Rt.
510 + 96.55
set P.K. & washer atop
P.K. 1' Rt. Lt. edge
of pavement

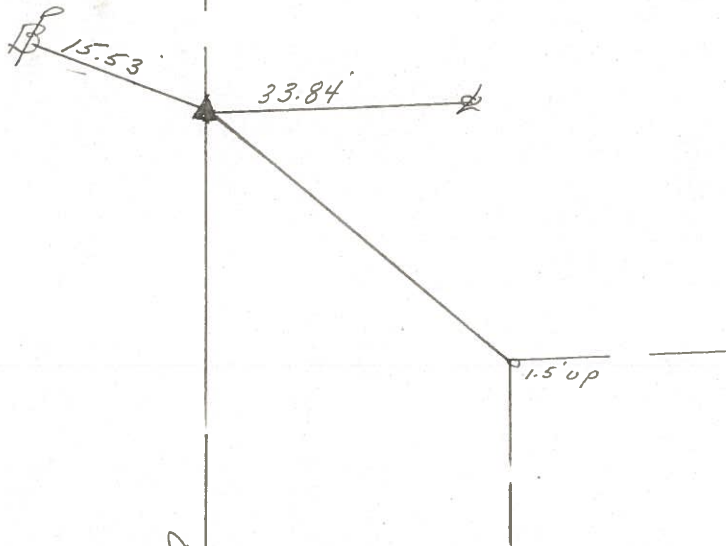

S.R. # 163 D

PERSONNEL TITLE PERSONNEL TITLE


COUNTY Ottawa DATE 6-11-71

S. R. 163 WEATHER

SEC. 1 TEMP.

DESCRIPTION S.R. # 269 East of Marblehead JOB NO.

LEFT CENTER LINE RIGHT

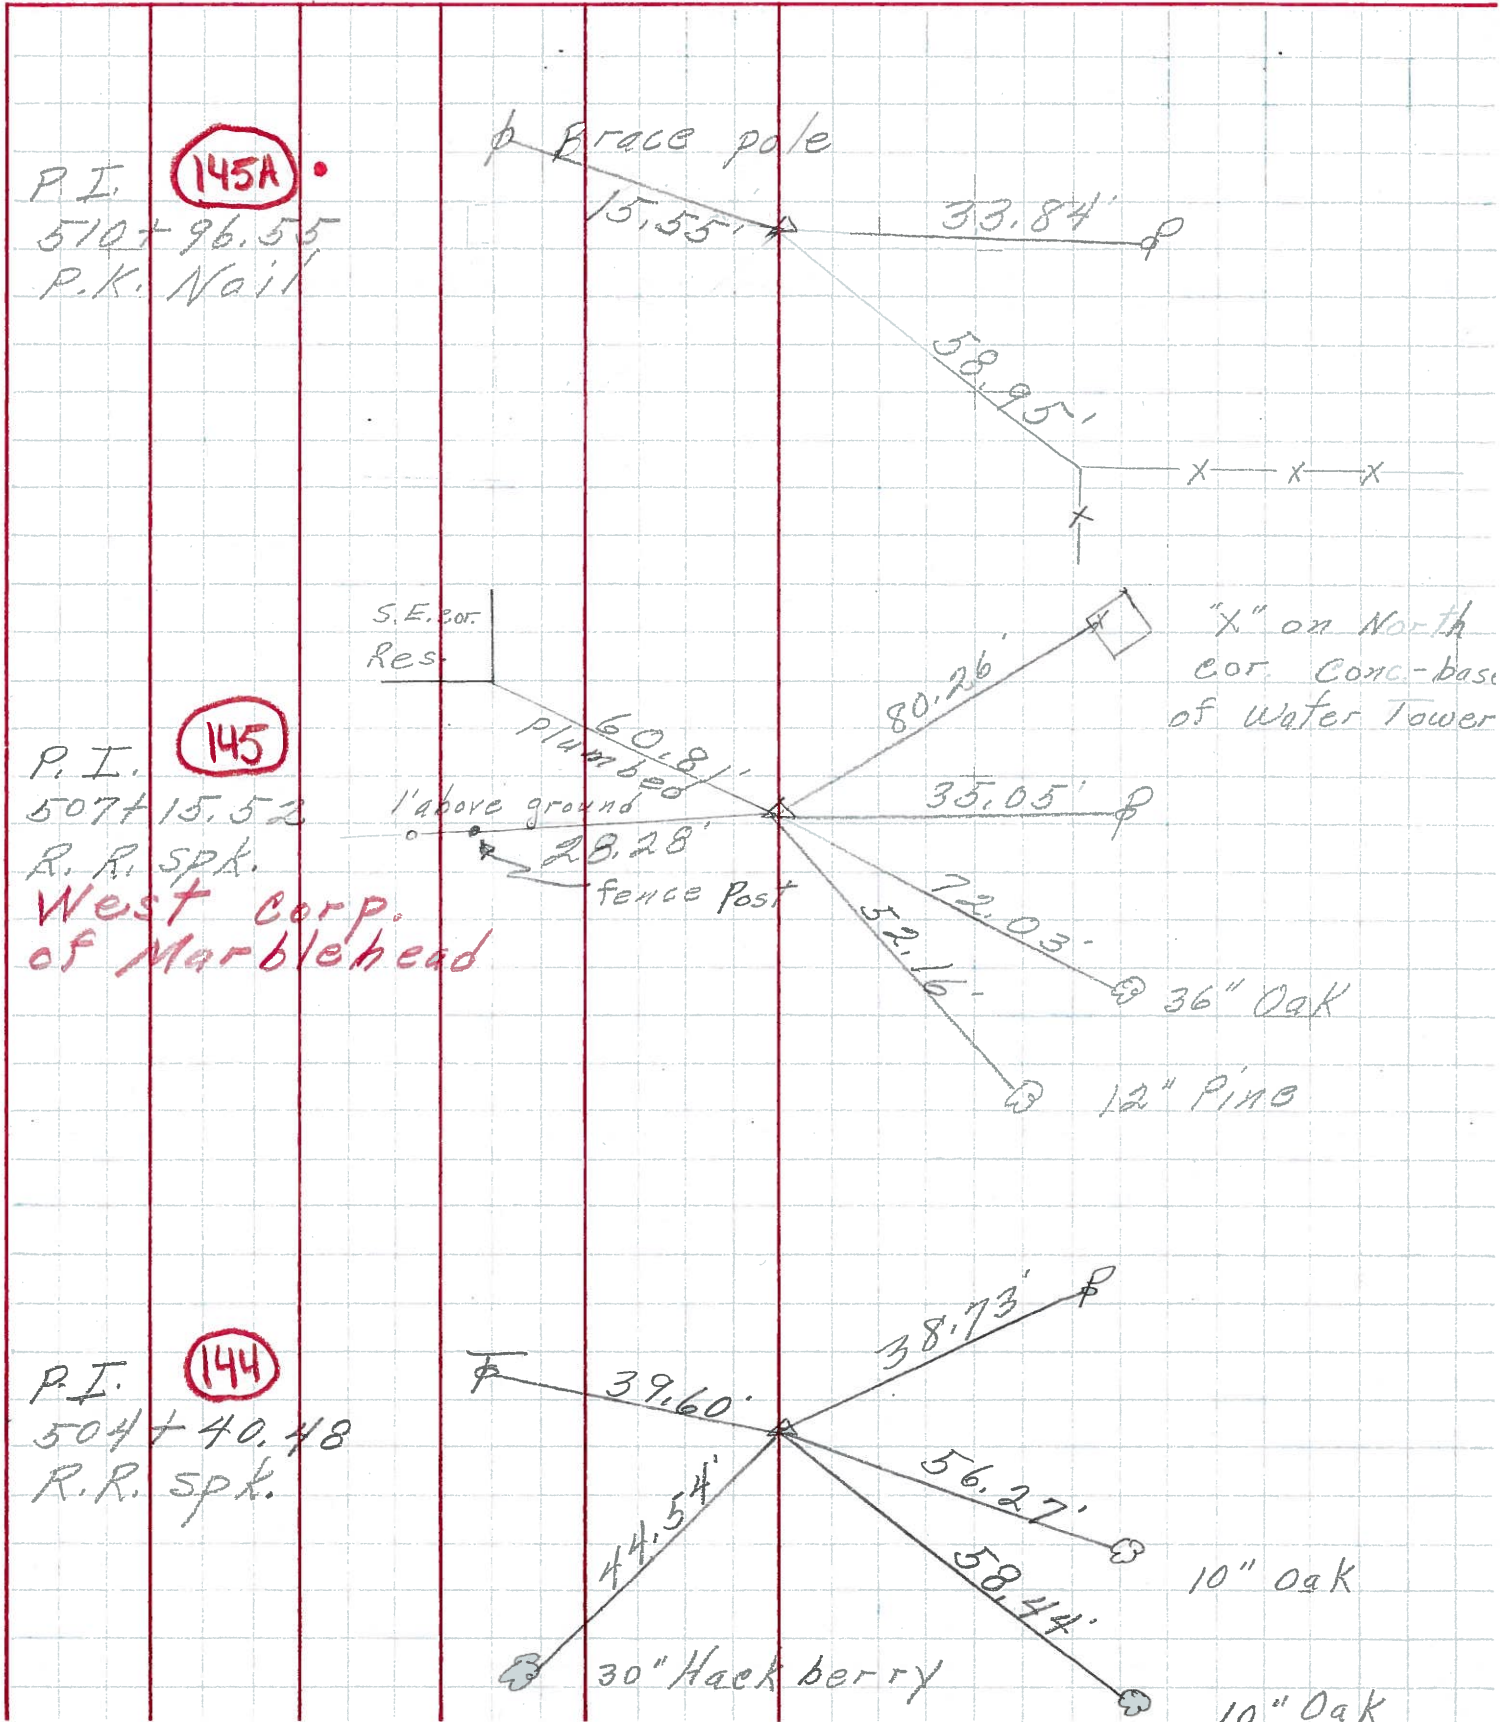

PERSONNEL	TITLE	PERSONNEL	TITLE	COUNTY	DATE	WEATHER	TEMP.
Schneider		Potts		Ottawa	9-12-68	Fair	70°
Mosser				S. R. 163			
Barbour				SEC. S.R. #269 - East			
Redding				Marblehead			

DESCRIPTION Ties for Control Points JOB NO. _____

