

O.D.O.T. DISTRICT 2 SURVEY OFFICE (USE ONLY)


PERSONNEL _____ REFERENCE NO. 146 SHEET 41 OF 66
 NOTES CODER _____ DATE 9/4/12 ROUTE SR 163
 H.C. CODER _____ WEATHER CLOUDY COUNTY OTTAWA
 R.C. RHOADES TEMP. 75° TOWNSHIP DANBURY
 SECTION 1-7

DWG BY NIESE PID PVTRAIN


NOTE: THIS MAP IS FOR ODOT PURPOSES ONLY TO INDEX REFERENCE TIES, AND DOES NOT REPRESENT TRUE LAND SUBDIVISION.

TYPE MONUMENT P.K./WASHER
 ON SURFACE - ~~BELOW~~ ON
 OFFSET 3.7' LT : ~~RT~~
6.7' TO LT EDGE PAVEMENT
 STATION: 1935+01

HORZ.DATUM: NAD83 (2011) GEOID: NAVD88 2018
 GRID: NORTHING: 682651.091 EASTING: 1904779.598

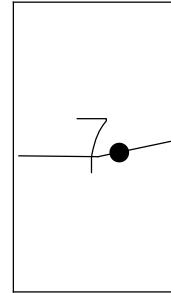


RECORD: P.I.
 $\Delta = 05^{\circ}09'$ RT. (PLAN)
 STA 531+56.02
 SET P.K./WASHER
 3.5' LT \odot PAV'T
 FD P.K./WASHER
 5/3/10, KPM
 9/4/12, SDC
 SET MAG/WASHER
 11/5/12, SDC
 FD MAG/WASHER
 11/9/12, SDC
 REF146
 6/11/21, TDN
 2/7/22, JFO

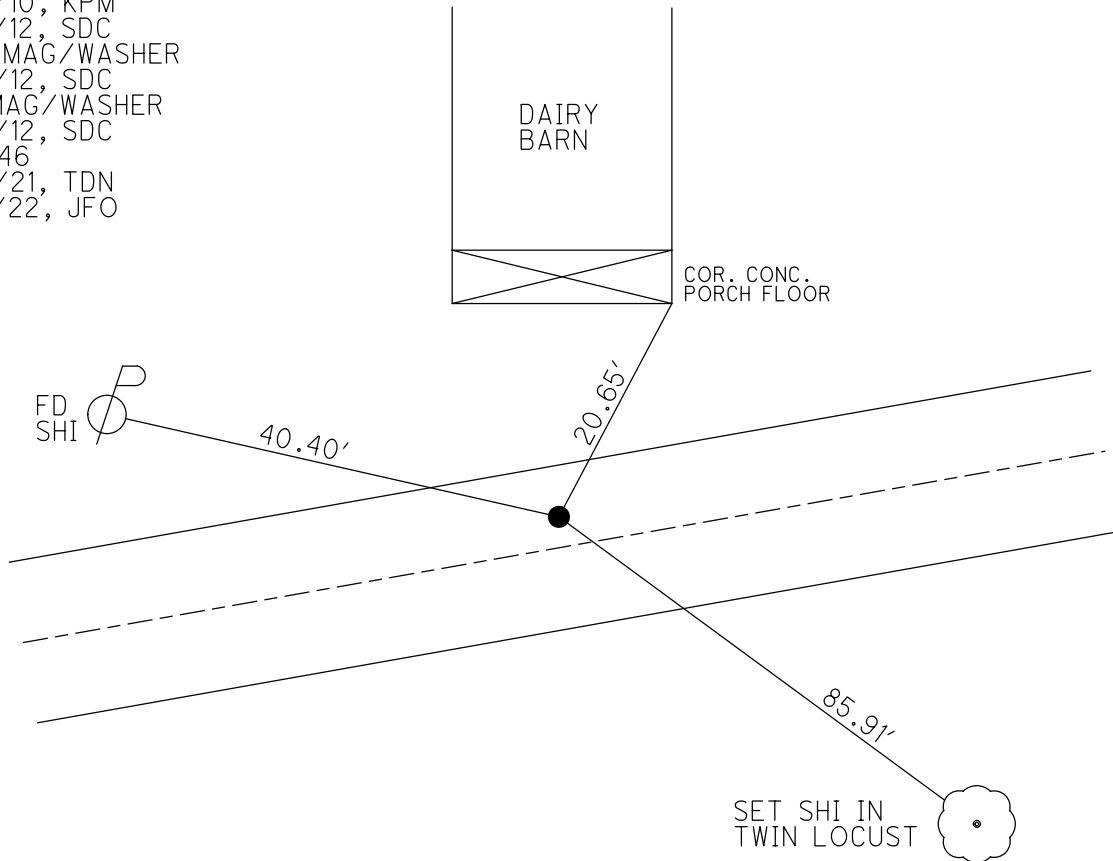

O.D.O.T. DISTRICT 2 SURVEY OFFICE (USE ONLY)


PERSONNEL	REFERENCE NO. <u>146</u>	SHEET <u>41</u> OF <u>63</u>
NOTES <u>CODER</u>	DATE <u>9/4/12</u>	ROUTE <u>SR 163</u>
H.C. <u>CODER</u>	WEATHER <u>CLOUDY</u>	COUNTY <u>OTTAWA</u>
R.C. <u>RHOADES</u>	TEMP. <u>75°</u>	TOWNSHIP <u>DANBURY</u>
		SECTION <u>1-7</u>

TYPE MONUMENT P.K./WASHER
 ON SURFACE - ~~BELOW~~ ON
 LEFT - ☉ PAV'T - ~~RIGHT~~ 3.7'
6.7' TO LT. EDGE PAVEMENT
 S.L.M. 1935+01
 Grid: Northing: 682650.922 Easting: 1904779.611

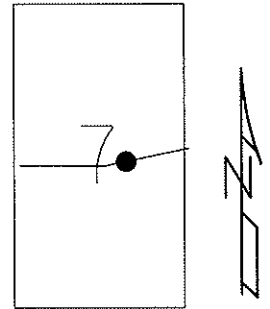

RECORD
 P.I. Δ = 05° 09' RT. (PLAN)
 531+56.02
 SET P.K./WASHER
 3.5' LT. ☉ PAV'T

FD P.K./WASHER
 GPS, SV135
 5/3/10, KPM
 SET MAG/WASHER
 11/5/12, SDC
 GPS, FINREF146
 11/9/12, SDC

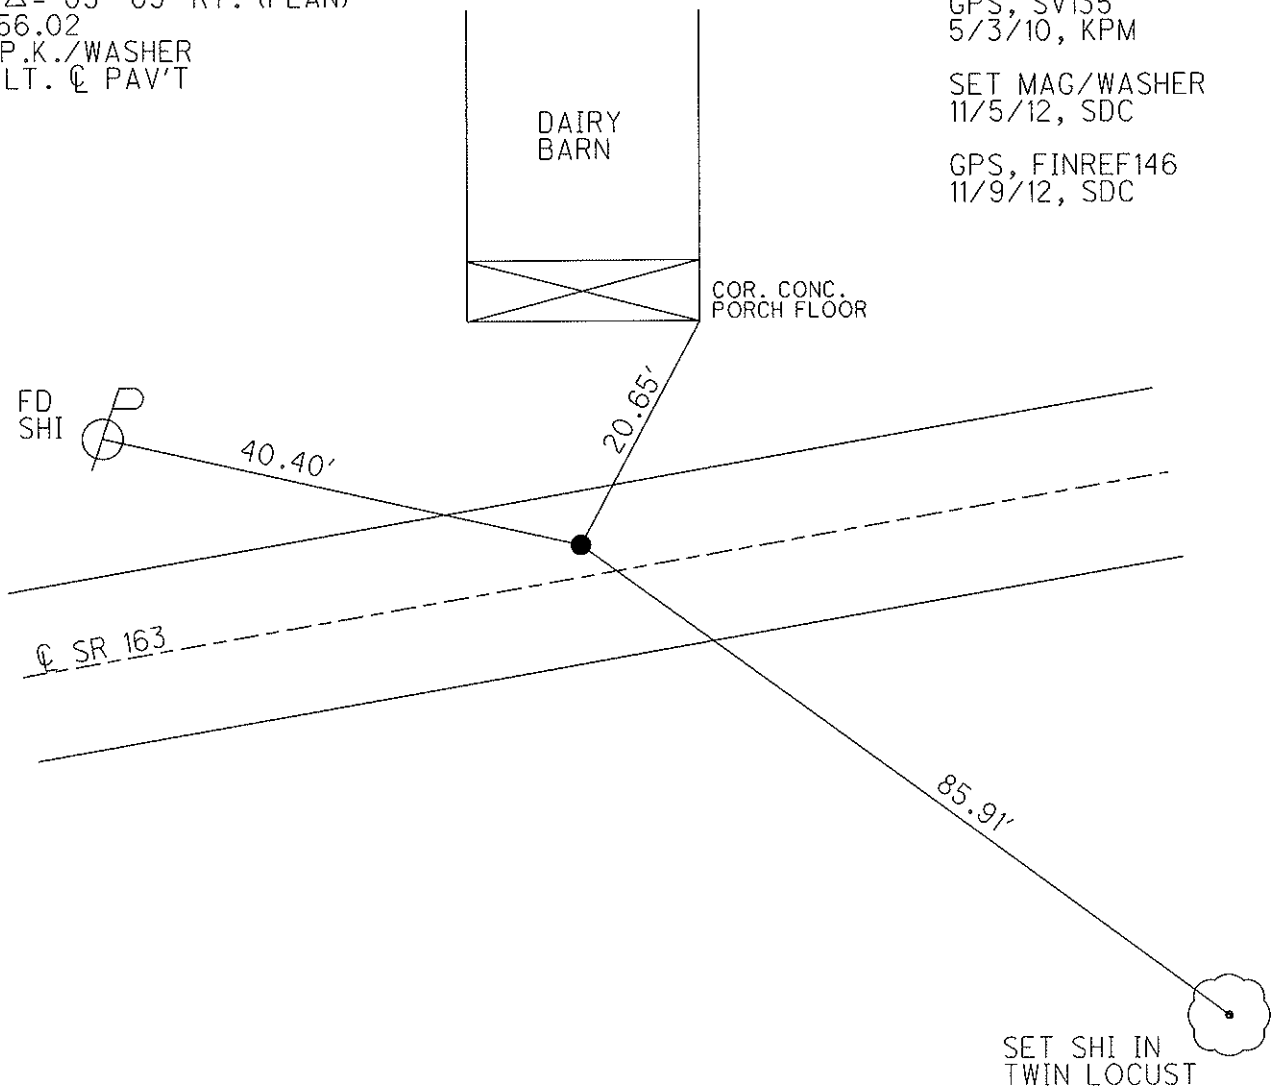

O.D.O.T. DISTRICT 2 SURVEY OFFICE

PERSONNEL

REFERENCE NO. 146

SHEET 34 OF 52

NOTES Rousor

H.C. LOEHMKE

DATE 6-5-95

ROUTE SR #163

R.C. Rousor

WEATHER CLEAR

COUNTY OTTAWA

CANTERBURY

TEMP. 75°

TOWNSHIP MARBLEHEAD

SECTION _____

T _____ R _____


TYPE MONUMENT PK / WASHER

~~ON SURFACE~~ BELOW ON SURFACE


LEFT - ¢ PAV'T. - RIGHT 3.7' L + 1 ¢

6.7 TO 7 EDGE PAVEMENT

S.L.M. 1935+01

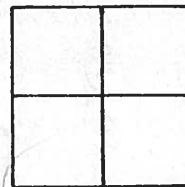

PI. PLAX $\Delta = 05^{\circ} 09' R+$
 531+56.07
 SET PK & WASHER
 3.5' LT & PAVT

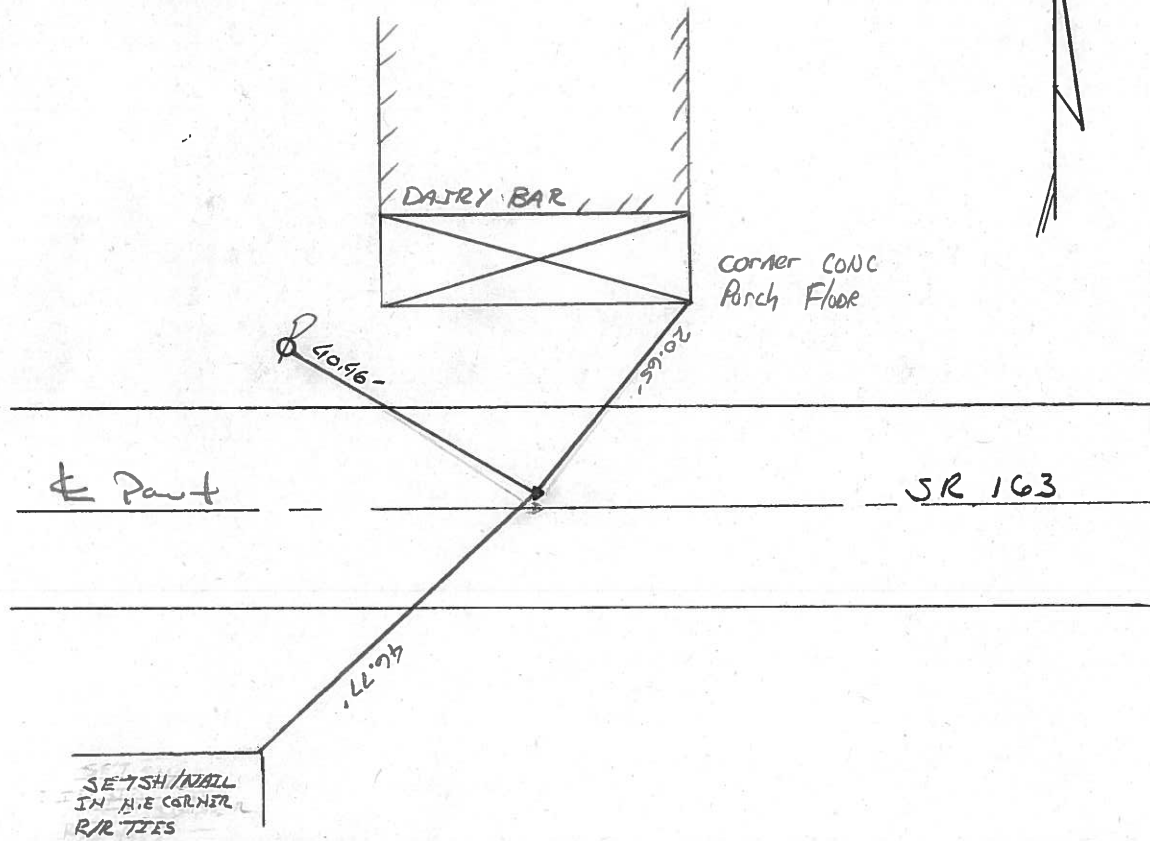

County Ottawa S.R. #163

Date 12/13/83

Township Morblehead


Weather overcast

Section _____

Temp. 38°

T-N, R-E

Personnel Cronin

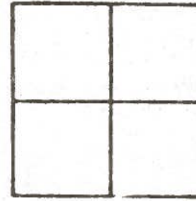

Ripple


Geyman

Barbour

146



Plan
P.I. $\Delta = 05^{\circ} 09' R.$
531456.02
set P.K. & washer
3.5' Lt. & Paumt.

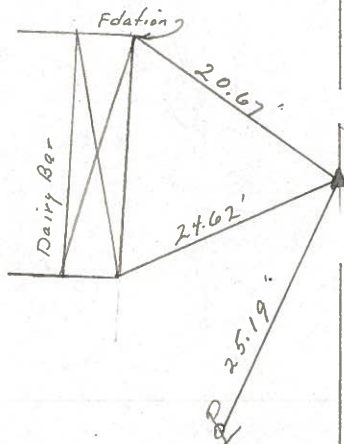

S.R. #163

PERSONNEL TITLE PERSONNEL TITLE

COUNTY Ottawa DATE 6-14-71

S. R. 163 WEATHER

SEC. 1 TEMP.

DESCRIPTION


Marblehead

JOB NO.

LEFT

CENTER LINE

RIGHT

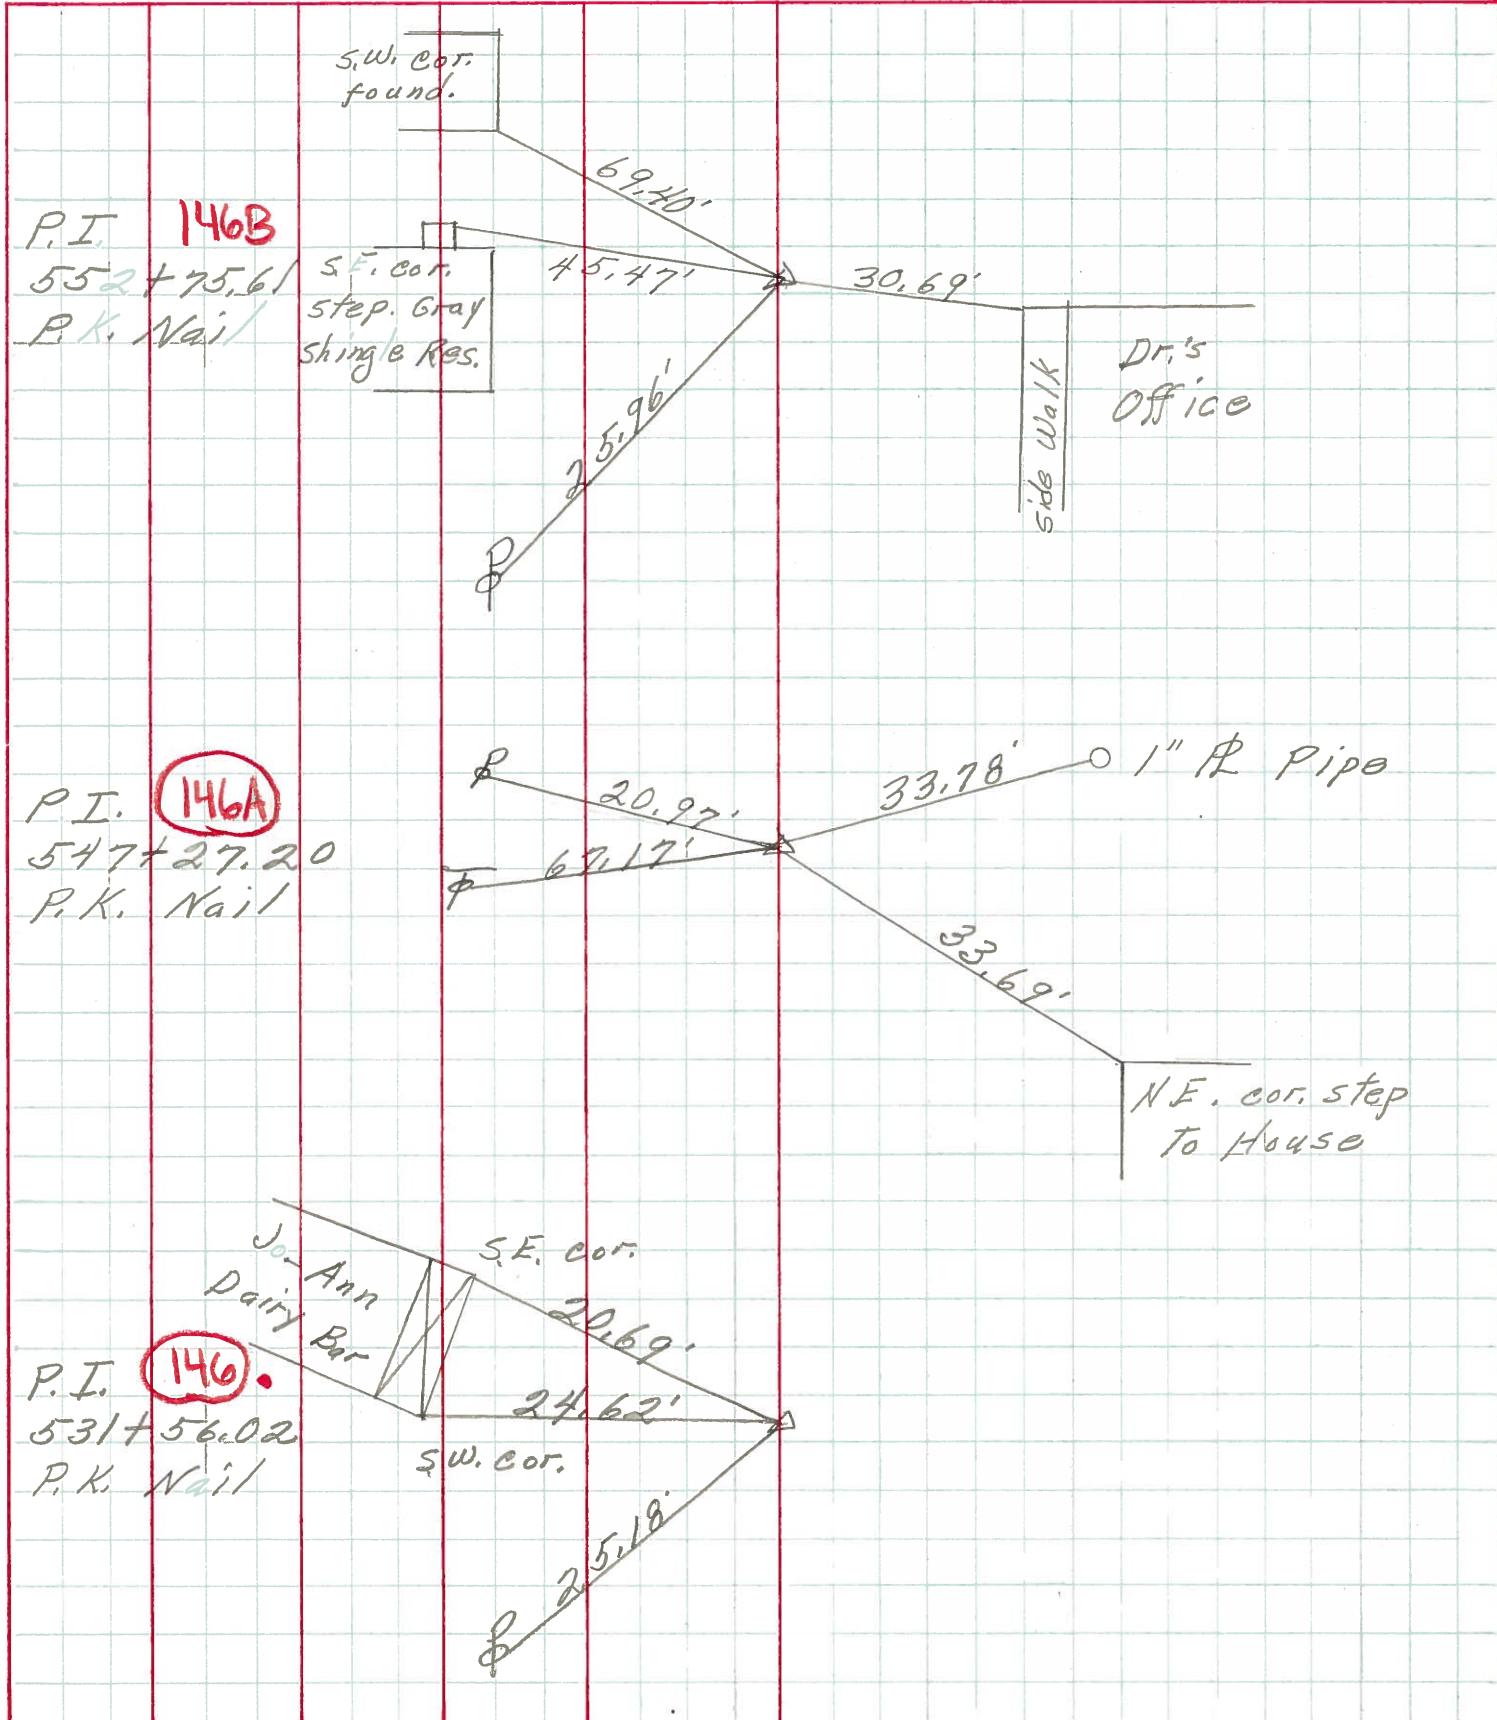

PERSONNEL TITLE PERSONNEL TITLE

COUNTY Offawa DATE 9-12-68

S. R. 163 WEATHER Fair

SEC. Marblehead TEMP. 70°

DESCRIPTION Ties for Control Points

JOB NO.

LEFT

CENTER LINE

RIGHT

