


O.D.O.T. DISTRICT 2 SURVEY OFFICE (USE ONLY)

PERSONNEL _____ REFERENCE NO. 146 A SHEET 42 OF 66
 NOTES CODER _____ DATE 9/4/12 ROUTE SR 163
 H.C. CODER _____ WEATHER CLOUDY COUNTY OTTAWA
 R.C. RHOADES TEMP. 75° TOWNSHIP DANBURY
 SECTION 1-1
 DWG BY NIESE PID PVTRAIN


TYPE MONUMENT P.K./WASHER
 ON SURFACE - ~~BELOW~~ ON
 OFFSET \bar{C} PAVEMENT 5.1' LT : ~~RT~~
5.7' TO LT EDGE PAVEMENT
 STATION: 1950+75

NOTE:
 THIS MAP IS FOR ODOT PURPOSES ONLY.
 TO INDEX REFERENCE TIES, AND DOES NOT
 REPRESENT TRUE LAND SUBDIVISION.

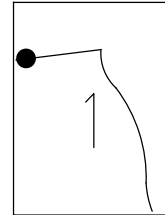

HORZ. DATUM: NAD83 (2011) GEOID: NAVD88 2018
 GRID: NORTHING: 682892.202 EASTING: 1906331.609

RECORD: P.I.
 $\Delta = 12^{\circ}15'$ RT
 STA 547+27.20
 SET P.K./WASHER
 6/5/96, MC
 FD P.K./WASHER
 5/3/10, KPM
 9/4/12, SDC
 SET MAG/WASHER
 11/5/12, SDC
 FD MAG/WASHER
 11/9/12, SDC
 REFA146
 6/11/21, TDN
 2/7/22, JFO


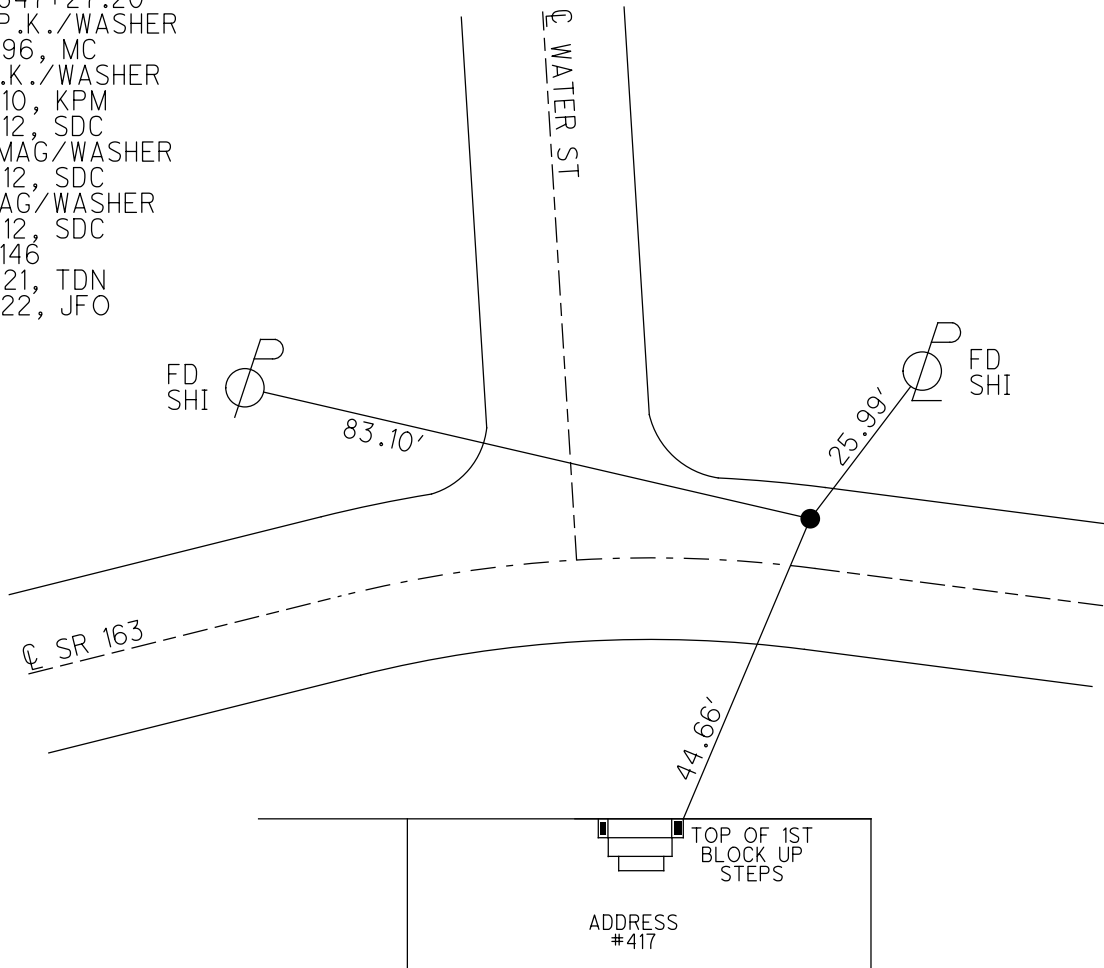


O.D.O.T. DISTRICT 2 SURVEY OFFICE (USE ONLY)

PERSONNEL	REFERENCE NO. <u>146 A</u>	SHEET <u>42</u> OF <u>63</u>
NOTES <u>CODER</u>	DATE <u>9/4/12</u>	ROUTE <u>SR 163</u>
H.C. <u>CODER</u>	WEATHER <u>CLOUDY</u>	COUNTY <u>OTTAWA</u>
R.C. <u>RHOADES</u>	TEMP. <u>75°</u>	TOWNSHIP <u>DANBURY</u>
		SECTION <u>1-1</u>


TYPE MONUMENT P.K./WASHER
 ON SURFACE - ~~BELOW~~ ON
 LEFT - ☉ PAV'T - ~~RIGHT~~ 5.1'
5.7' TO LT EDGE PAVEMENT
 S.L.M. 1950+75

Grid: Northing: 682892.173 Easting: 1906331.593

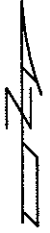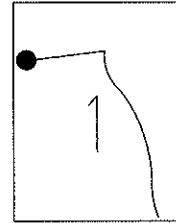

RECORD
 P.I. Δ = 12° 15' RT.
 547+27.20

RESET P.K./WASHER
 6/5/96, MC
 FD P.K./WASHER
 GPS, SV136
 5/3/10, KPM
 SET MAG/WASHER
 11/5/12, SDC
 GPS, FINREFA146
 11/9/12, SDC

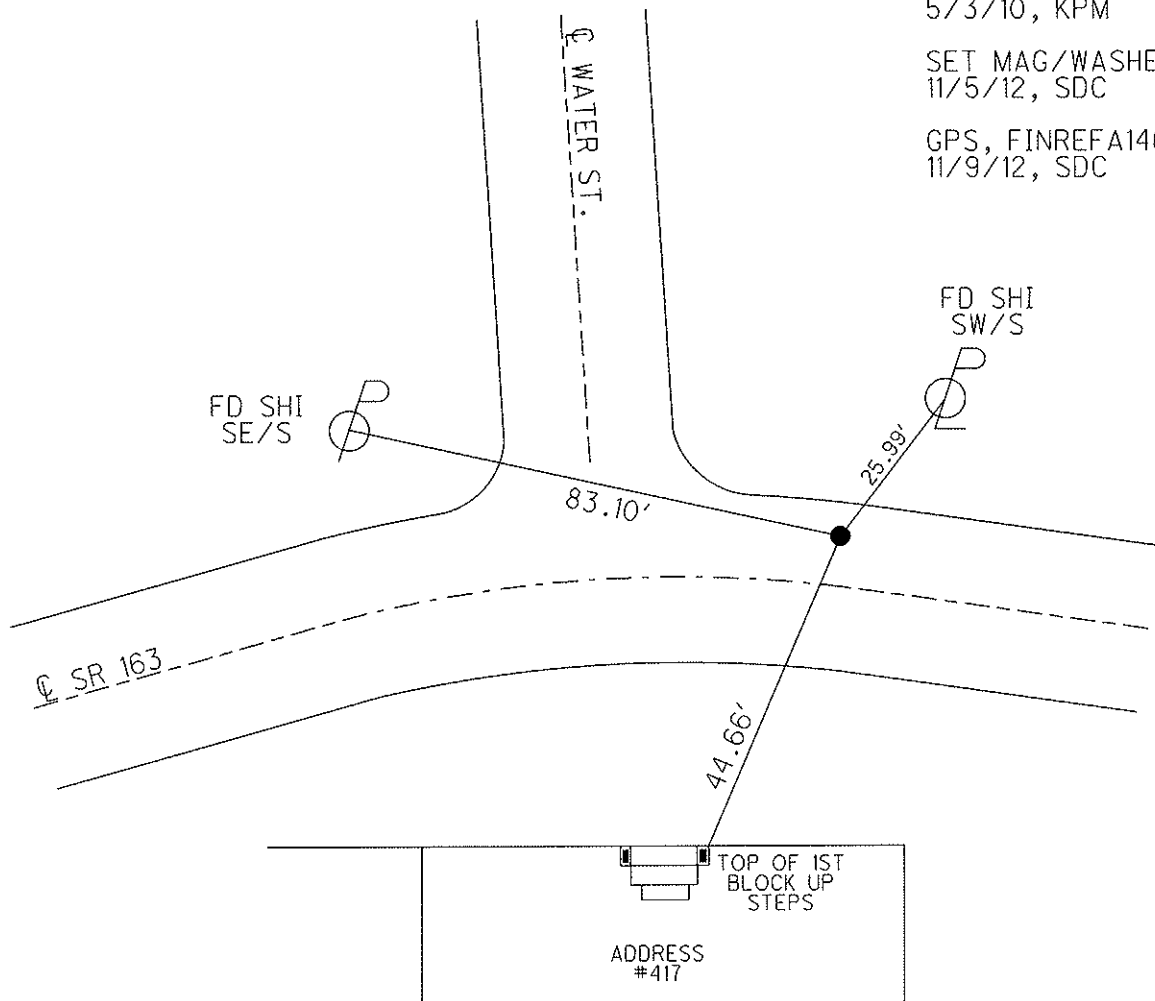

O.D.O.T. DISTRICT 2 SURVEY OFFICE

PERSONNEL _____

REFERENCE NO. 146A

SHEET 35 OF 52

NOTES CANTERBURY

H.C. LOEHMKE

DATE 6-5-95

ROUTE S.R. 163

R.C. Rousos

WEATHER Nice

COUNTY OTTAWA

TEMP. +75

TOWNSHIP MARBLE HEAD

SECTION _____

T _____ R _____

Set P.K. / WASHER
6-5-96


TYPE MONUMENT P.K. Shank

ON SURFACE - BELOW _____

LEFT - ~~C~~ PAV'T. - ~~RIGHT~~ 6.8

4.0 TO L EDGE PAVEMENT

S.L.M. 1950+75

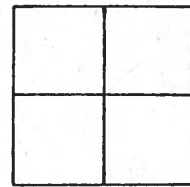


RECORD.

P.I. Sta 547+27.20

$\Delta = 12^{\circ} - 15' \text{ Rt.}$

Dwg. Fd Nothing Below

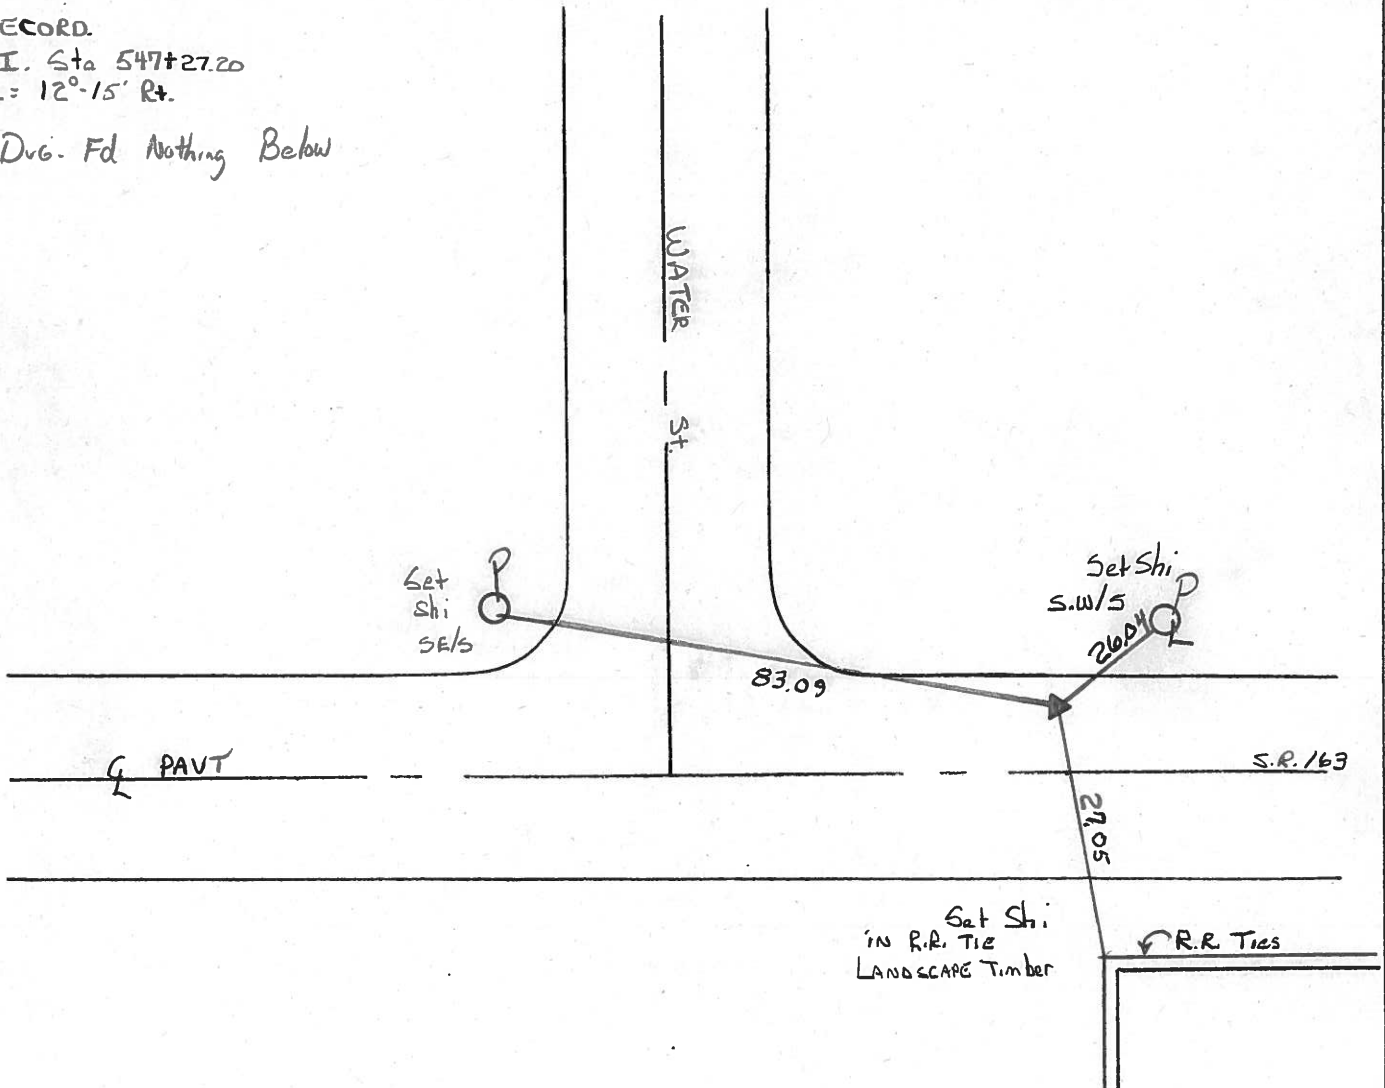

Q.D.O.T. DISTRICT 2 SURVEY OFFICE

SHEET 34 OF

County Ottawa S.R. #163

Date 12/13/83

Township Marblehead

Weather overcast

Section —

Temp. 38°


T-N, R-E

Personnel Cronin

Ripple

Geyman


Barbour

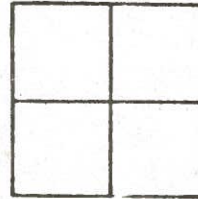

146A




P.I. Δ = 12° 15' Rt.
547 + 27.20
Set P.K. & washer
6.5' Lt. & Paumt

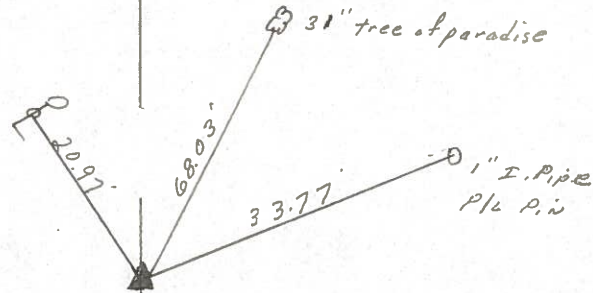

Q.D.O.T. #163A

PERSONNEL	TITLE	PERSONNEL	TITLE
COUNTY <u>Ottawa</u> DATE <u>6-14-71</u>			
S. R. <u>163</u> WEATHER _____			
SEC. <u>1</u> TEMP. _____			
DESCRIPTION <u>Marblehead</u>			JOB NO. _____
	LEFT	CENTER LINE	RIGHT

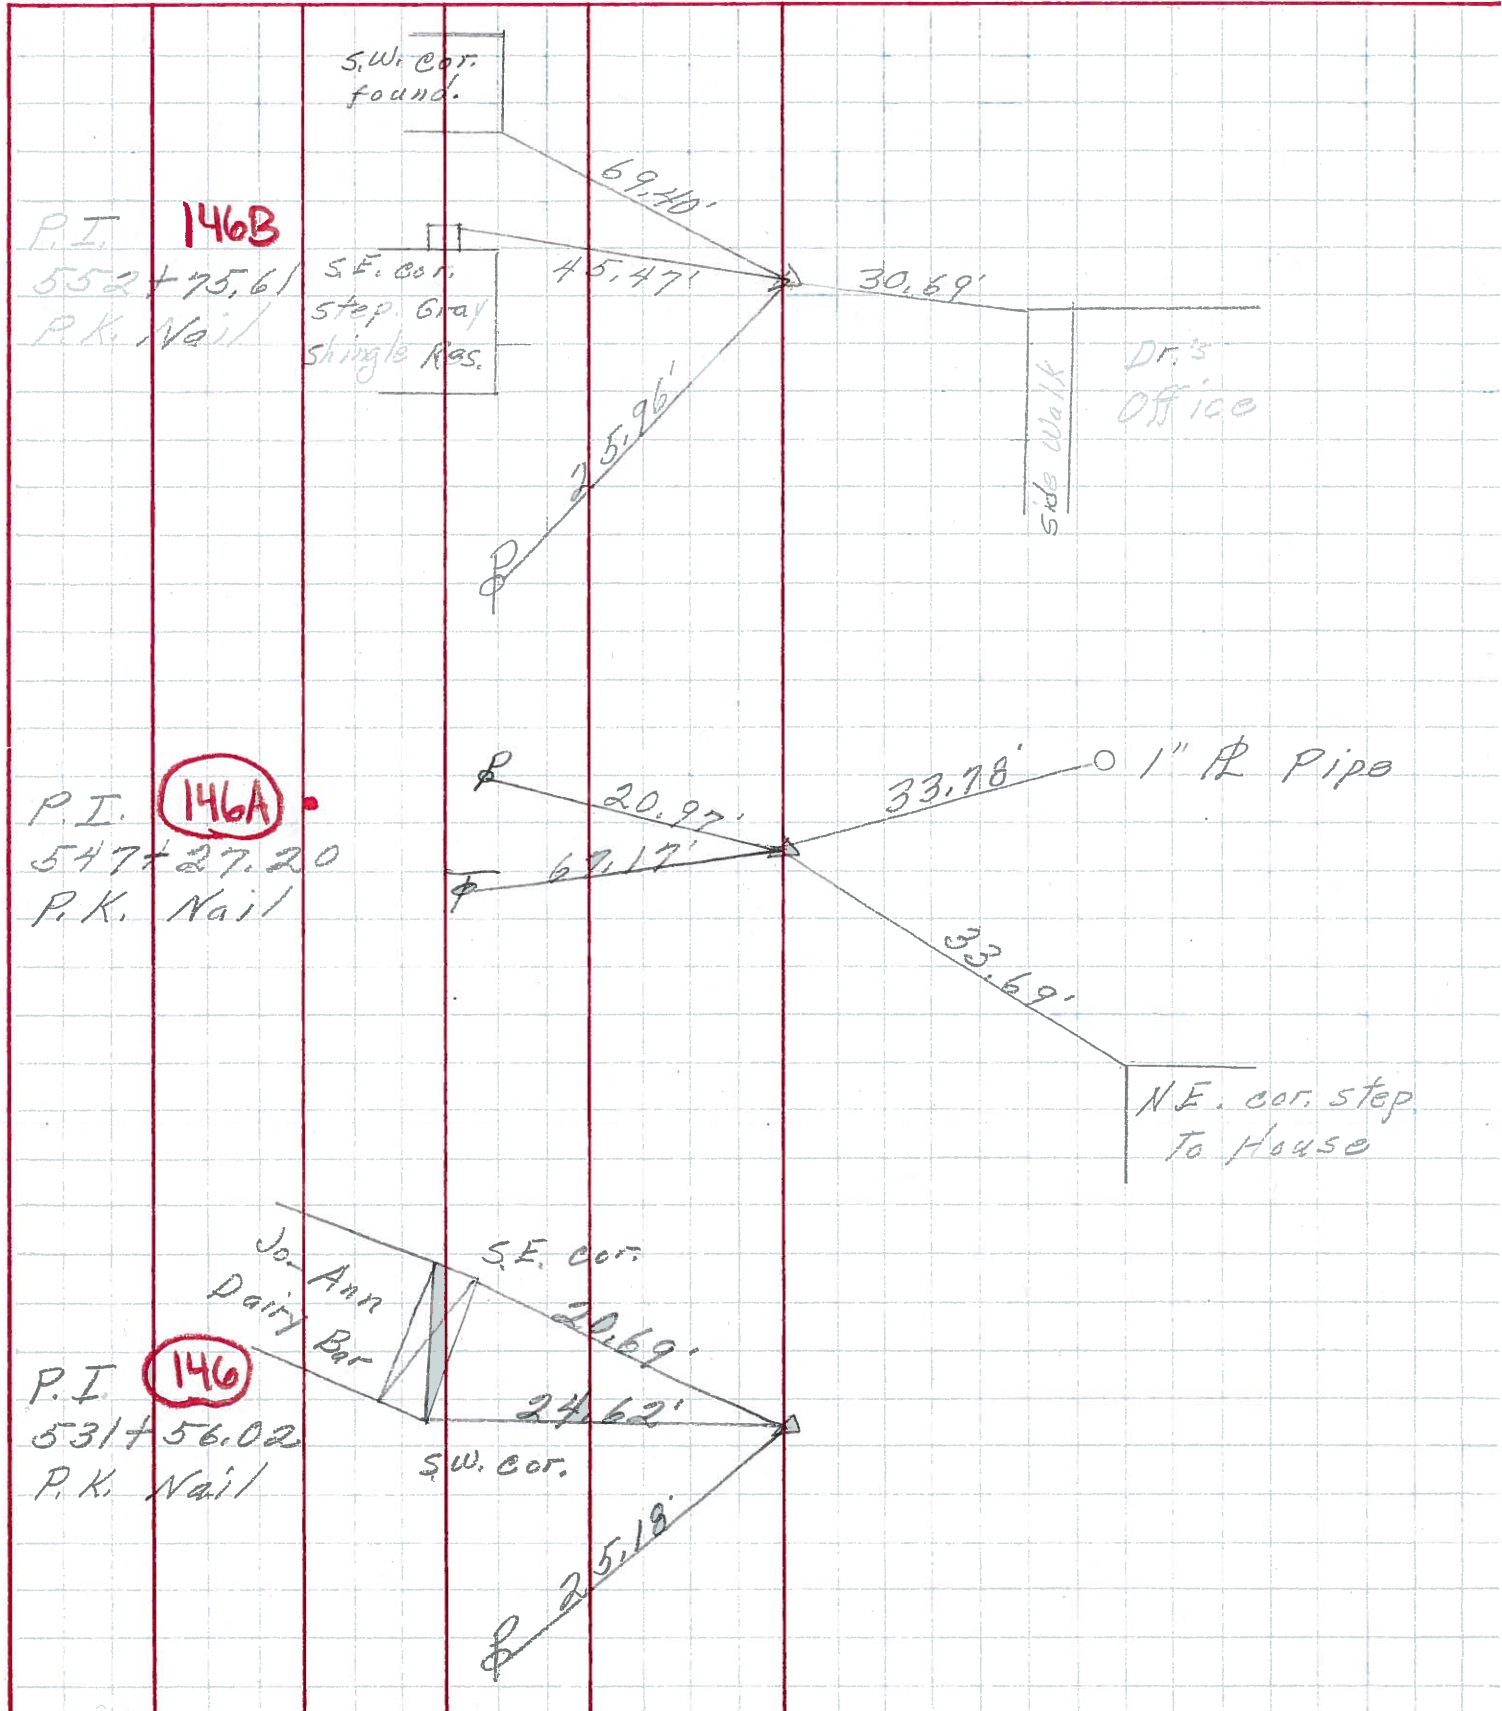

PERSONNEL	TITLE	PERSONNEL	TITLE	COUNTY	DATE
				Offowa	9-12-68
				S. R. 163	WEATHER Fair
				SEC. Marblehead	TEMP. 70°
DESCRIPTION	Ties for Control Points				JOB NO.
	LEFT	CENTER LINE	RIGHT		

