


O.D.O.T. DISTRICT 2 SURVEY OFFICE (USE ONLY)

PERSONNEL _____ REFERENCE NO. 146 C SHEET 44 OF 66
 NOTES CODER DATE 9/4/12 ROUTE SR 163
 H.C. CODER WEATHER CLOUDY COUNTY OTTAWA
 R.C. RHOADES TEMP. 75° TOWNSHIP DANBURY
 SECTION 1-1

DWG BY NIESE PID PVTRAIN

TYPE MONUMENT P.K./WASHER
 ON SURFACE - ~~BELOW~~ ON
 OFFSET Q PAVEMENT 2.0' LT : ~~RT~~
9.0' TO LT EDGE PAVEMENT
 STATION: 1964+46


NOTE:
 THIS MAP IS FOR ODOT PURPOSES ONLY
 TO INDEX REFERENCE TIES, AND DOES NOT
 REPRESENT TRUE LAND SUBDIVISION.

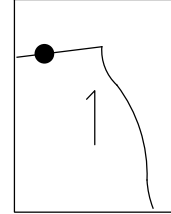

HORZ.DATUM: NAD83 (2011) GEOID: NAVD88 2018
 GRID: NORTHING: 682832.638 EASTING: 1907696.152

CLEMMONS CEMETERY

1' UP DECORATIVE
 IRON FENCE POST

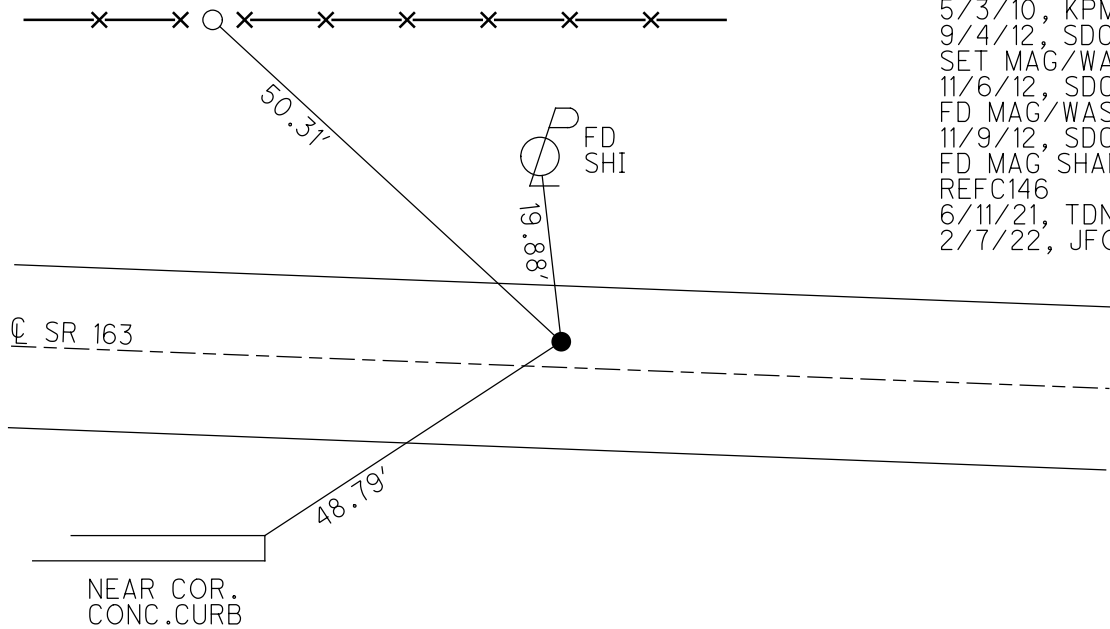


RECORD: P.I.
 $\Delta = 02^\circ 41' RT$
 STA 560+93.71
 SET P.K./WASHER
 6/5/96, MC
 FD P.K./WASHER
 5/3/10, KPM
 9/4/12, SDC
 SET MAG/WASHER
 11/6/12, SDC
 FD MAG/WASHER
 11/9/12, SDC
 FD MAG SHANK
 REFC146
 6/11/21, TDN
 2/7/22, JFO

O.D.O.T. DISTRICT 2 SURVEY OFFICE (USE ONLY)


PERSONNEL _____ REFERENCE NO. 146 C SHEET 44 OF 63
 NOTES CODER _____ DATE 9/4/12 ROUTE SR 163
 H.C. CODER _____ WEATHER CLOUDY COUNTY OTTAWA
 R.C. RHOADES TEMP. 75° TOWNSHIP DANBURY
 _____ SECTION 1-1

TYPE MONUMENT P.K./WASHER
 ON SURFACE - ~~BELOW~~ ON _____
 LEFT - Q PAV'T - ~~RIGHT~~ 2.0'
9.0' TO LT. EDGE PAVEMENT
 S.L.M. 1964+46
 Grid: Northing: 682832.626 Easting: 1907696.059

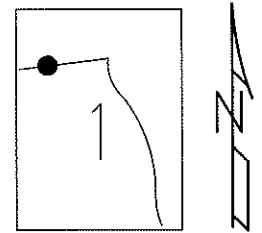

CLEMMONS CEMETERY

1' UP DECORATIVE
IRON FENCE POST

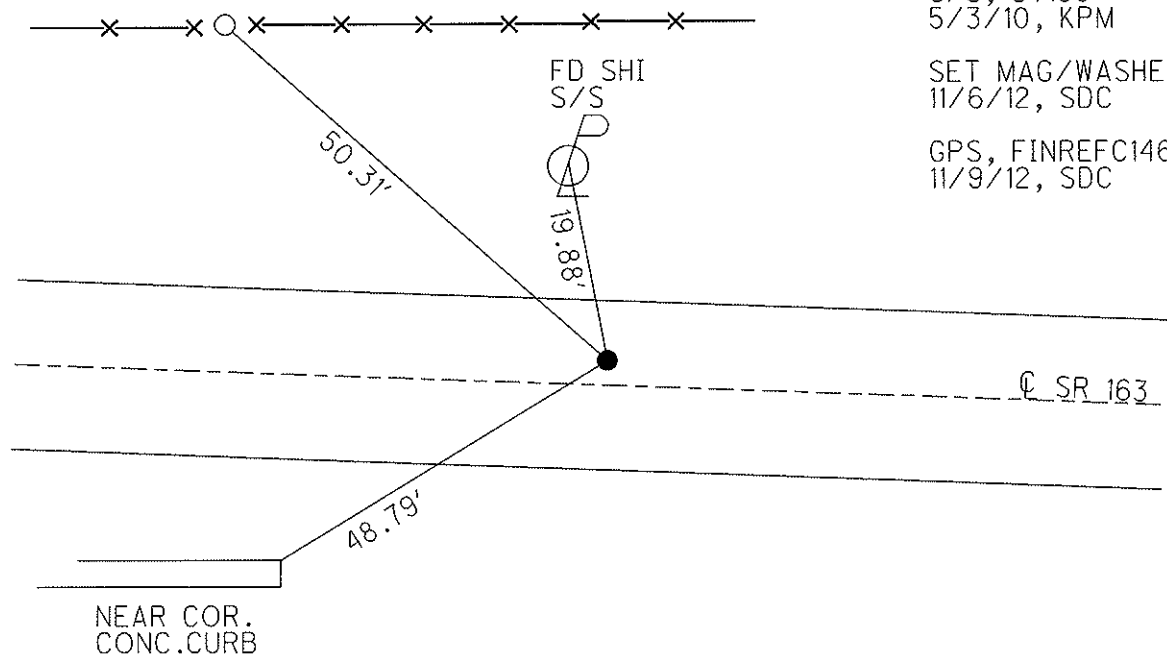

RECORD
 P.I. $\Delta = 02^\circ 41' RT.$
 560+93.71
 RESET P.K./WASHER
 6/5/96, MC
 FD P.K./WASHER
 GPS, SV138
 5/3/10, KPM
 SET MAG/WASHER
 11/6/12, SDC
 GPS, FINREFC146
 11/9/12, SDC

O.D.O.T. DISTRICT 2 SURVEY OFFICE

PERSONNEL

REFERENCE NO. 146 C SHEET 37 OF 52

NOTES CANTERBURY

H.C. LOEHRKE

R.C. ROUSAS

DATE 6-5-95

WEATHER SUNNY

TEMP. +75°F

ROUTE S.R. 163

COUNTY OTTAWA

TOWNSHIP MARBLEHEAD

SECTION _____

T _____ R _____


TYPE MONUMENT PK NAIL / WASHER ^{Reset} 6-5-96

ON SURFACE - BELOW YES

LEFT-☉ PAV'T. - RIGHT 2.0' LT ☉

9.0' TO LT EDGE PAVEMENT


S.L.M. 1964 + 46

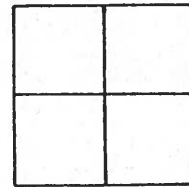


RECORD: P.I. $\Delta = 02^\circ 41'$ RT.

STA 560 + 93.71

1.0' UP ON DECORATIVE
IRON FENCE POST.

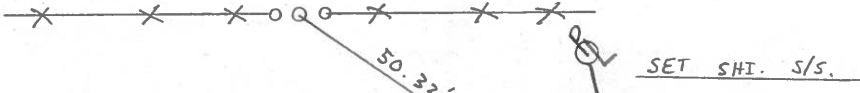

☉ S.R. #163 →

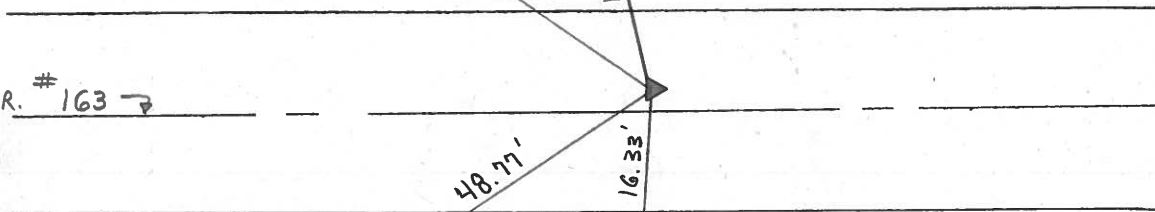

NEAR CORNER CONC.
CURB.

ODOT. DISTRICT 2 SURVEY OFFICE

SHEET 36 OF

County Ottawa S.R. # 163

Date 12/13/83

Township Marblehead

Weather overcast

Section

Temp. 40°


T-N, R-E

Personnel Cronin


Ripple

Geyman


Barbour

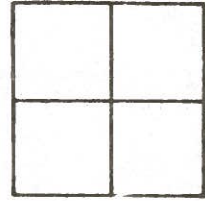

146 C

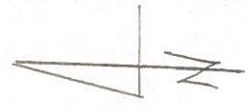

Plan
P.I. $\Delta = 02^{\circ}41' \text{ Rt.}$
560 + 93.71
Set P.K. & washer 1.5'
Lt. & Pavil

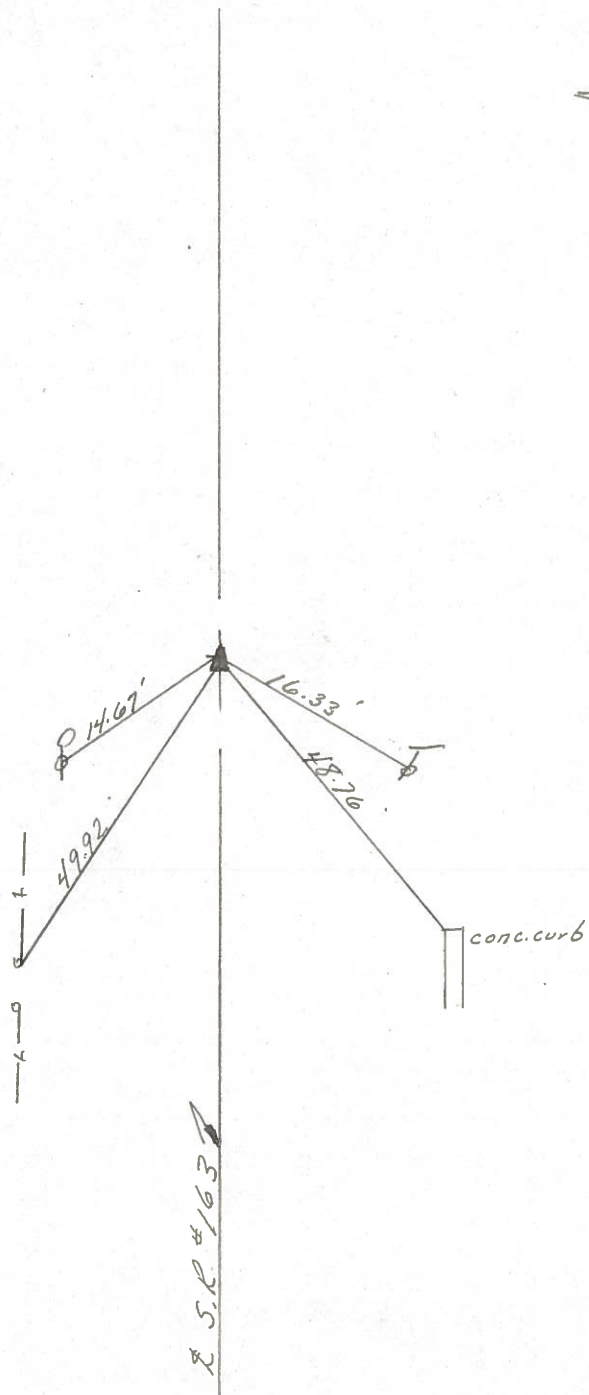

PERSONNEL TITLE PERSONNEL TITLE


COUNTY Ottawa DATE 6-14-71

S. R. 163 WEATHER


SEC. 1 TEMP.

DESCRIPTION Marble head LEFT CENTER LINE RIGHT JOB NO.


P.I. **147**
565 + 22.21
Iron Pin
2" below
Surface

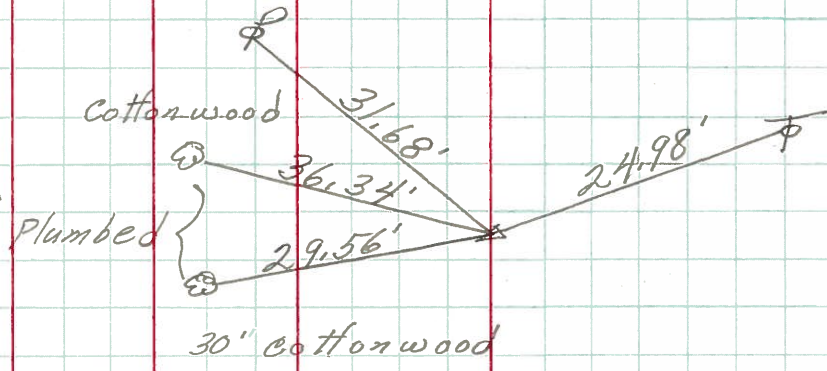

P.I. **146D**
562 + 87
Iron Pin
3" down
1' off edge permit.

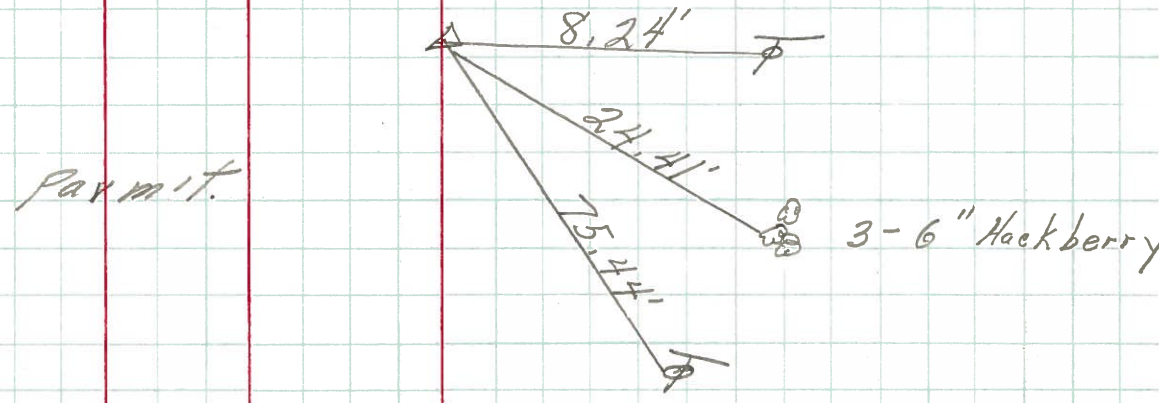

P.I. **146C**
560 + 93.71
P.K. Nail

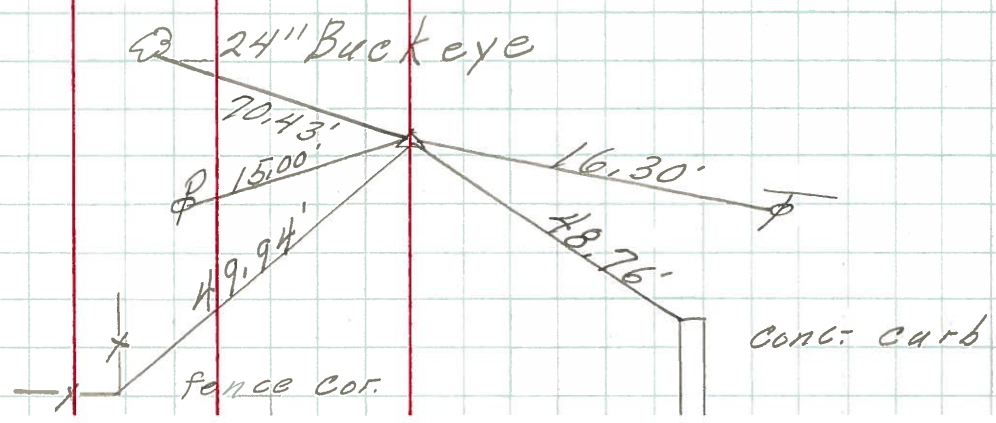

PERSONNEL TITLE PERSONNEL TITLE

COUNTY Offawa DATE 9-12-68

S. R. 163 WEATHER Fair

SEC. Marblehead TEMP. 70°

DESCRIPTION Ties for Control Points

JOB NO.

LEFT CENTER LINE RIGHT



6398

6397

6396

6395

146C

146B

146A

146