

O.D.O.T. DISTRICT 2 SURVEY OFFICE (USE ONLY)

PERSONNEL

REFERENCE NO. 146 D

SHEET 45 OF 66

NOTES CODER _____ DATE 9/4/12
 H.C. CODER _____ WEATHER CLOUDY
 R.C. RHOADES _____ TEMP. 75°

ROUTE SR 163
 COUNTY OTTAWA
 TOWNSHIP DANBURY
 SECTION 1-1

DWG BY NIESE PID PVTRAIN

TYPE MONUMENT 5/8" IPIN

ON SURFACE - ~~BELOW~~ ON

OFFSET CL PAVEMENT _____ LT : RT


2.5' RT OF RT EDGE PAVEMENT

STATION: 1966+39


HORZ. DATUM: _____ GEOID: _____

GRID: NORTHING: 682817.409 EASTING: 1907889.143

NOTE:
THIS MAP IS FOR ODOT PURPOSES ONLY
TO INDEX REFERENCE TIES, AND DOES NOT
REPRESENT TRUE LAND SUBDIVISION.

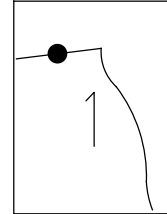

RECORD: P.I.
 $\Delta = 27^\circ 45' \text{ LT}$
 STA 562+87.50
 FD IPIN
 4" DOWN
 3.0' RT RT EP
 SERT 5/8" IPIN
 2" DEEP IN STONE
 BERM USING OLD TIES
 6/5/96, CL
 FD IPIN
 SV139
 5/3/10, KPM
 9/4/12, SDC

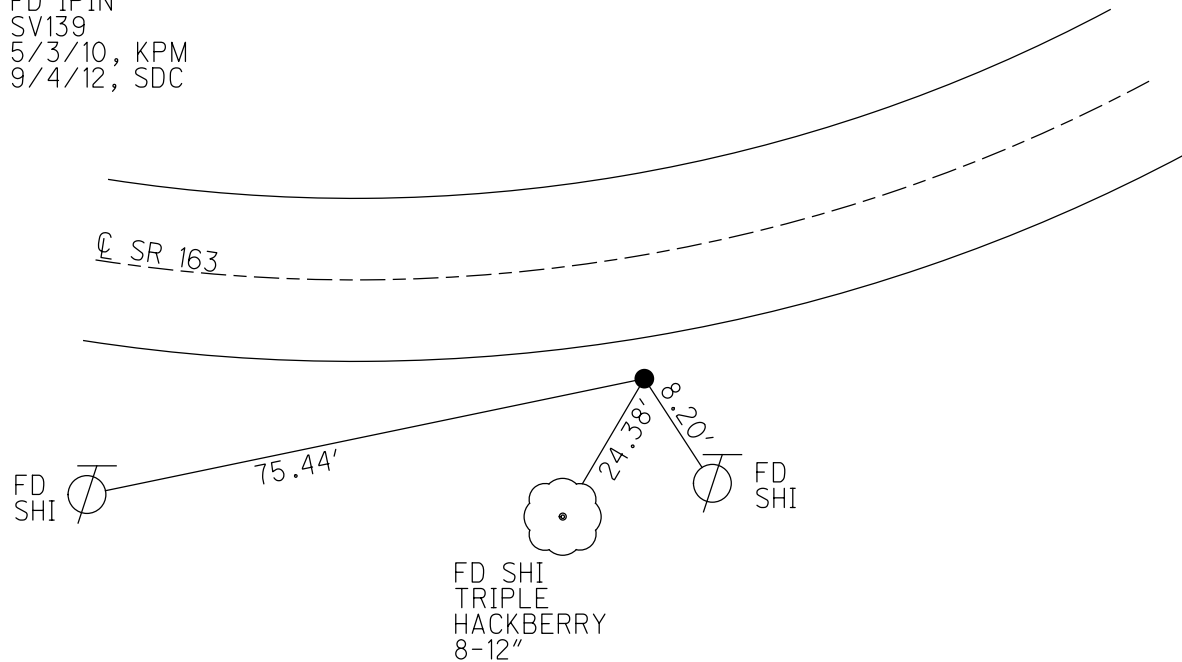

O.D.O.T. DISTRICT 2 SURVEY OFFICE (USE ONLY)

PERSONNEL _____

REFERENCE NO. 146 D

SHEET 45 OF 63

NOTES CODER _____

DATE 9/4/12

ROUTE SR 163

H.C. CODER _____

WEATHER CLOUDY

COUNTY OTTAWA

R.C. RHOADES

TEMP. 75°

TOWNSHIP DANBURY

SECTION 1-1

TYPE MONUMENT 5/8" IPIN


ON SURFACE - ~~BELOW~~ ON _____

~~LEFT~~ - Q PAV'T - RIGHT _____

2.5' RT TO RT EDGE PAVEMENT

S.L.M. 1966+39


Grid: Northing: 682817.409 Easting: 1907889.1428

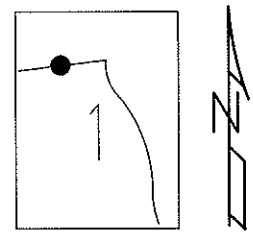

RECORD (PLAN)
 P.I. Δ = 27° 45' LT.
 562+87.50
 FD IPIN 4" BELOW
 SURFACE 3' RT RT EP

NOTE:
 SERT 5/8" IPIN
 2" DEEP IN STONE
 BERM USING OLD TIES.
 6/5/96, C.L.

FD IPIN
 GPS, SV139
 5/3/10, KPM

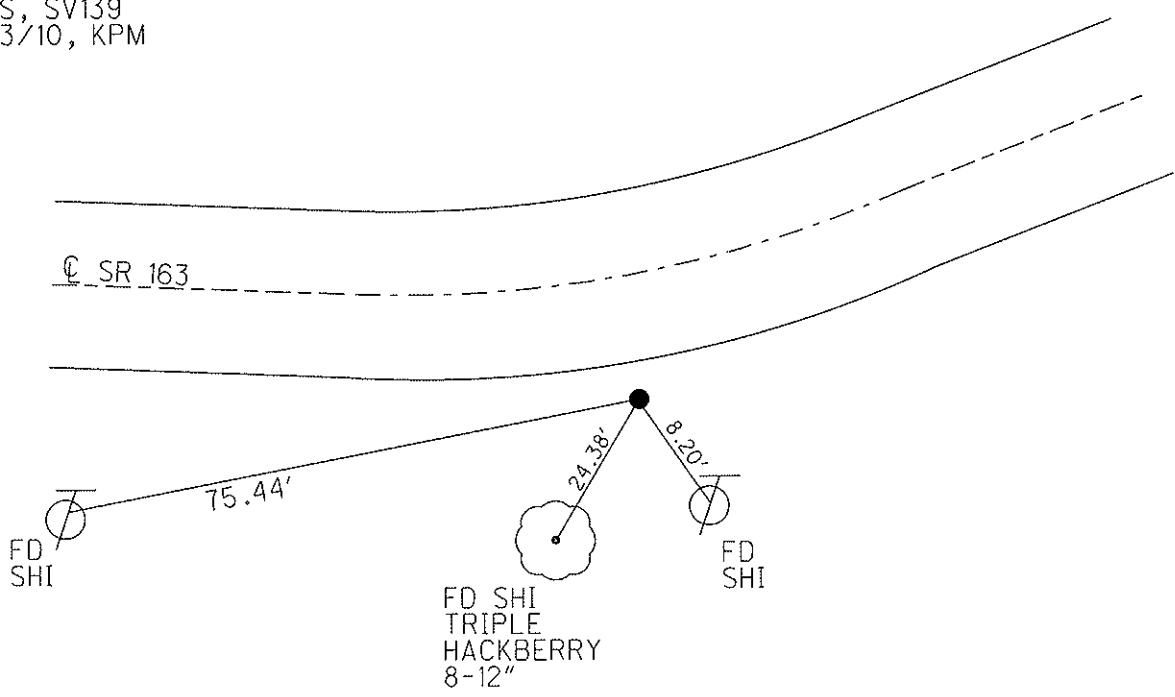

O.D.O.T. DISTRICT 2 SURVEY OFFICE

PERSONNEL

REFERENCE NO. 146 D

SHEET 38 OF 52

NOTES Rousas

H.C. LOEHRKE

DATE 6-5-95

ROUTE SR. 163

R.C. Rousas

WEATHER CLEAR

COUNTY OTTAWA

CANTERBURY

TEMP. 75°

TOWNSHIP MARBLEHEAD

SECTION _____

T _____ R _____



TYPE MONUMENT DID NOT FIND

ON SURFACE - BELOW _____

~~LEFT - C PAV'T.~~ - RIGHT _____

2.5 TO RT EDGE PAVEMENT


S.L.M. 1966 +39

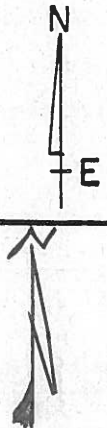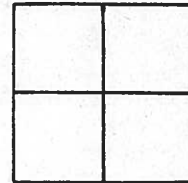

P.I. PLAN Δ = 27° 45' LT
562 + 87.50
F.I. I ROD 4" BELOW
SURFACE 3' RT RT-EP

DID NOT FIND
TIES STILL CROSS 6-5-95

NOTE: Set $\frac{5}{8}$ " DIA ROD \pm 2" Deep in
 Stone Berm - ROD Set using old ties
 C. LOEHRKE
 6-5-96

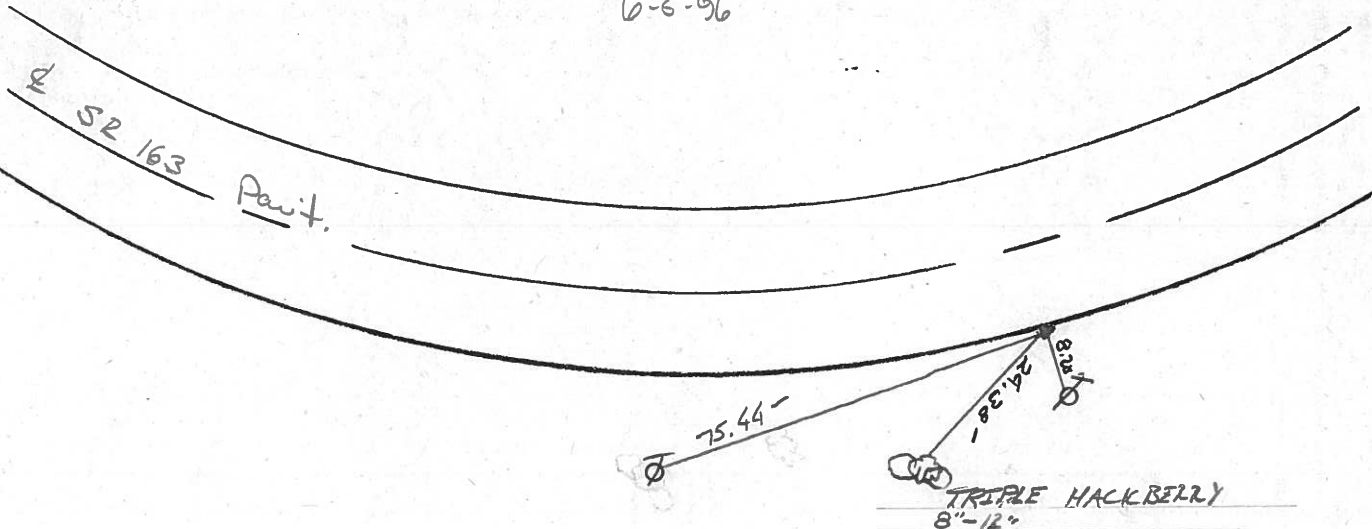

Q.D.O.T. DISTRICT 2 SURVEY OFFICE

SHEET 37 OF

County Ottawa S.R. #163

Date 12/13/83

Township Marblehead


Weather overcast

Section _____

Temp. 40°

T-N, R-E

Personnel Cronin

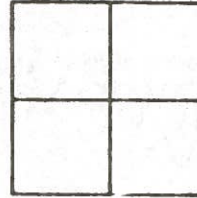

Ripple


Geyman

Barbour

146D



Plan
P.I. A=27°45' Lt.
562+87.50
Ed. I. Rod 4" below
surface - 3' Rt. Rt. E.P.

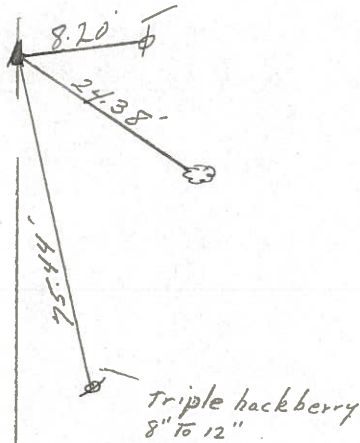

S.S.R. #1637


PERSONNEL TITLE PERSONNEL TITLE

COUNTY Ottawa DATE 6-14-71

S. R. 163 WEATHER

SEC. 1 TEMP.

DESCRIPTION Marble head LEFT CENTER LINE RIGHT JOB NO.

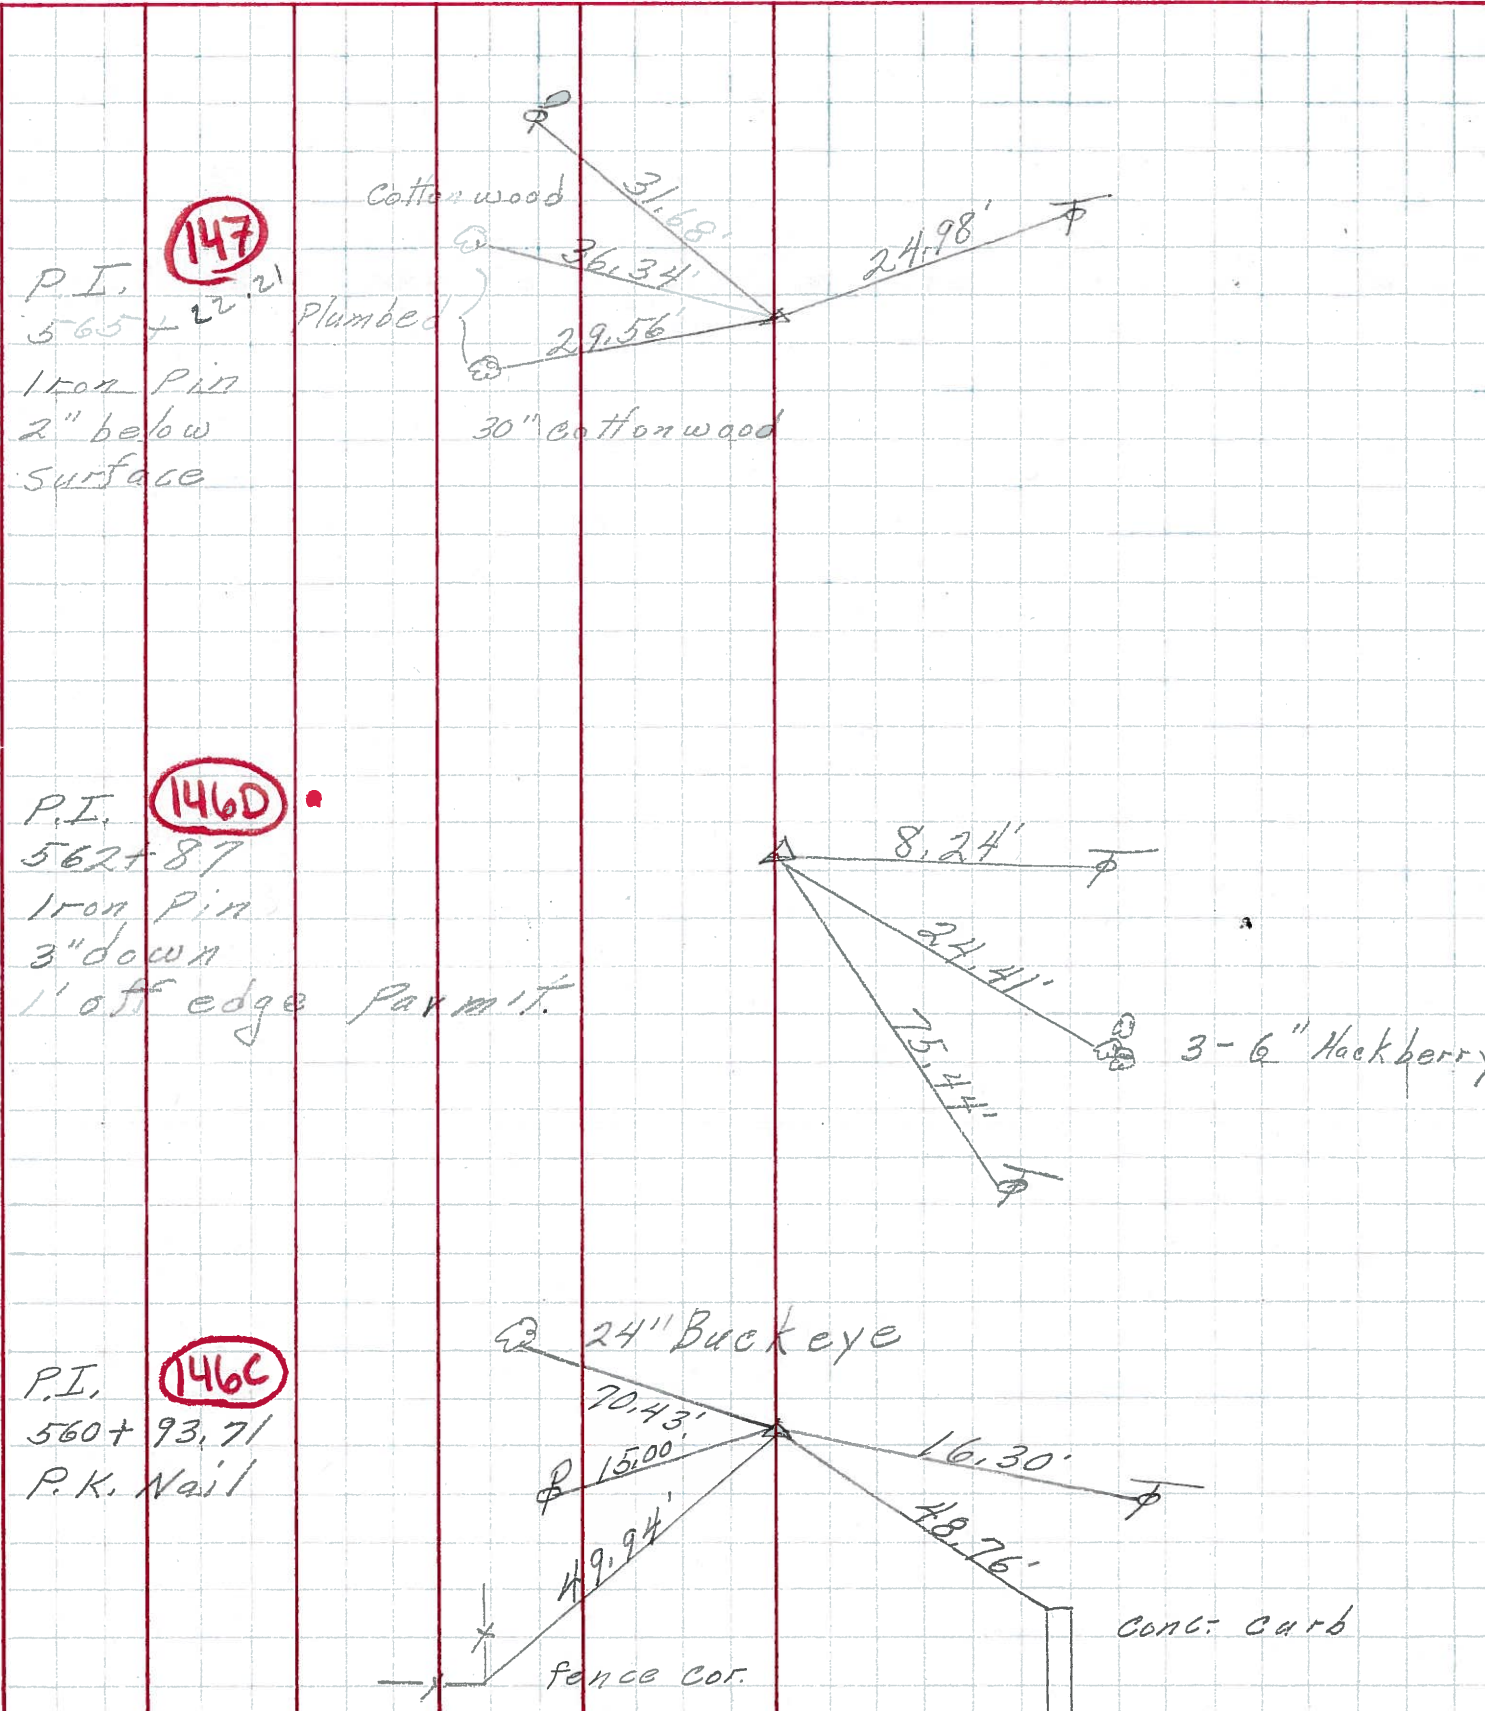

PERSONNEL	TITLE	PERSONNEL	TITLE	COUNTY	DATE
Schneider		otts		0ff	9-12-68
Mosser				S. R. 163	WEATHER Fair
Barbour				SEC. Marble head	TEMP. 70°
Redding					

DESCRIPTION Tie for Control Points JOB NO. _____

