



O.D.O.T. DISTRICT 2 SURVEY OFFICE (USE ONLY)

PERSONNEL _____ REFERENCE NO. 147 B SHEET 48 OF 66
 NOTES MOSER DATE 5/6/11 ROUTE SR 163
 H.C. MOSER WEATHER CLOUDY COUNTY OTTAWA
 R.C. HARBAUGH TEMP. 60° TOWNSHIP DANBURY
 SECTION 1-1
 DWG BY NIESE PID PVTRAIN

TYPE MONUMENT 1" IPIPE
~~ON SURFACE~~ - BELOW 1"
 OFFSET CL PAVEMENT 67.5' LT : ~~RT~~
 57' ; T OF LT EDGE PAVEMENT
 STATION: 1977+60

HORIZ.DATUM: _____ GEOID: _____
 GRID: NORTHING: 682900.668 EASTING: 1909039.366

NOTE:
THIS MAP IS FOR ODOT PURPOSES ONLY.
TO INDEX REFERENCE TIES, AND DOES NOT
REPRESENT TRUE LAND SUBDIVISION.

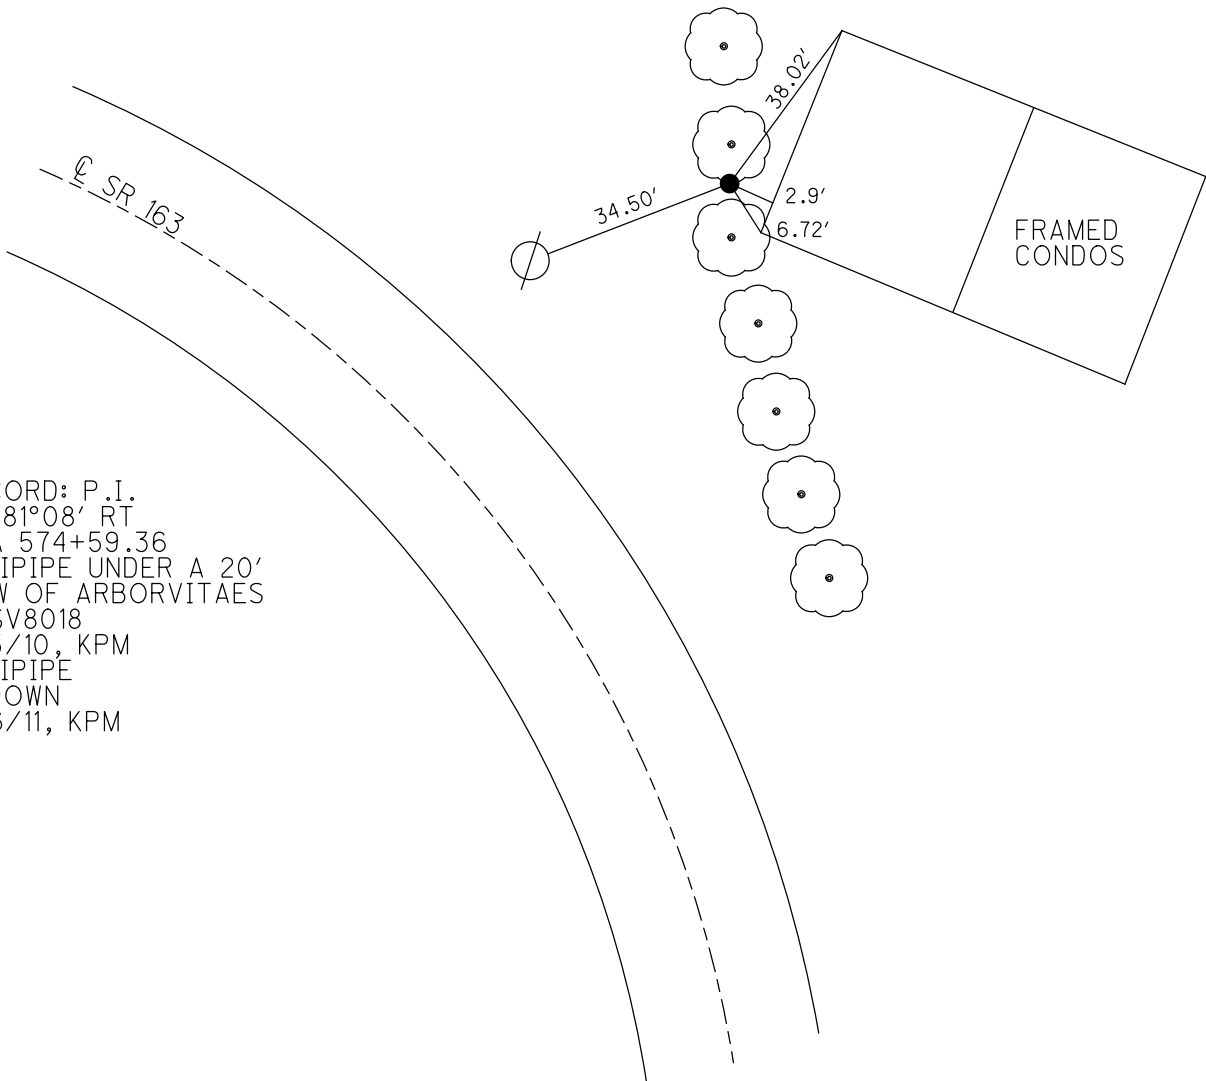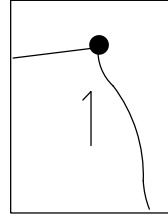

RECORD: P.I.
 $\Delta = 81^{\circ}08'$ RT
 STA 574+59.36
 FD IPIPE UNDER A 20'
 ROW OF ARBORVITAE
 KMSV8018
 5/3/10, KPM
 FD IPIPE
 1" DOWN
 5/6/11, KPM

O.D.O.T. DISTRICT 2 SURVEY OFFICE (USE ONLY)

PERSONNEL

REFERENCE NO. 147 B

SHEET 48 OF 63

NOTES MOSER

DATE 5/6/11

ROUTE SR 163

H.C. MOSER

WEATHER COUDY

COUNTY OTTAWA

R.C. HARBAUGH

TEMP. 60°

TOWNSHIP DANBURY

SECTION 1-1

TYPE MONUMENT 1" IPIPE



~~ON SURFACE~~ - BELOW 1"

LEFT - CL PAV'T - ~~RIGHT~~ 67.5'

57' LT TO LT EDGE PAVEMENT

S.L.M. 1977+60

Grid: Northing: 682900.668 Easting: 1909039.366

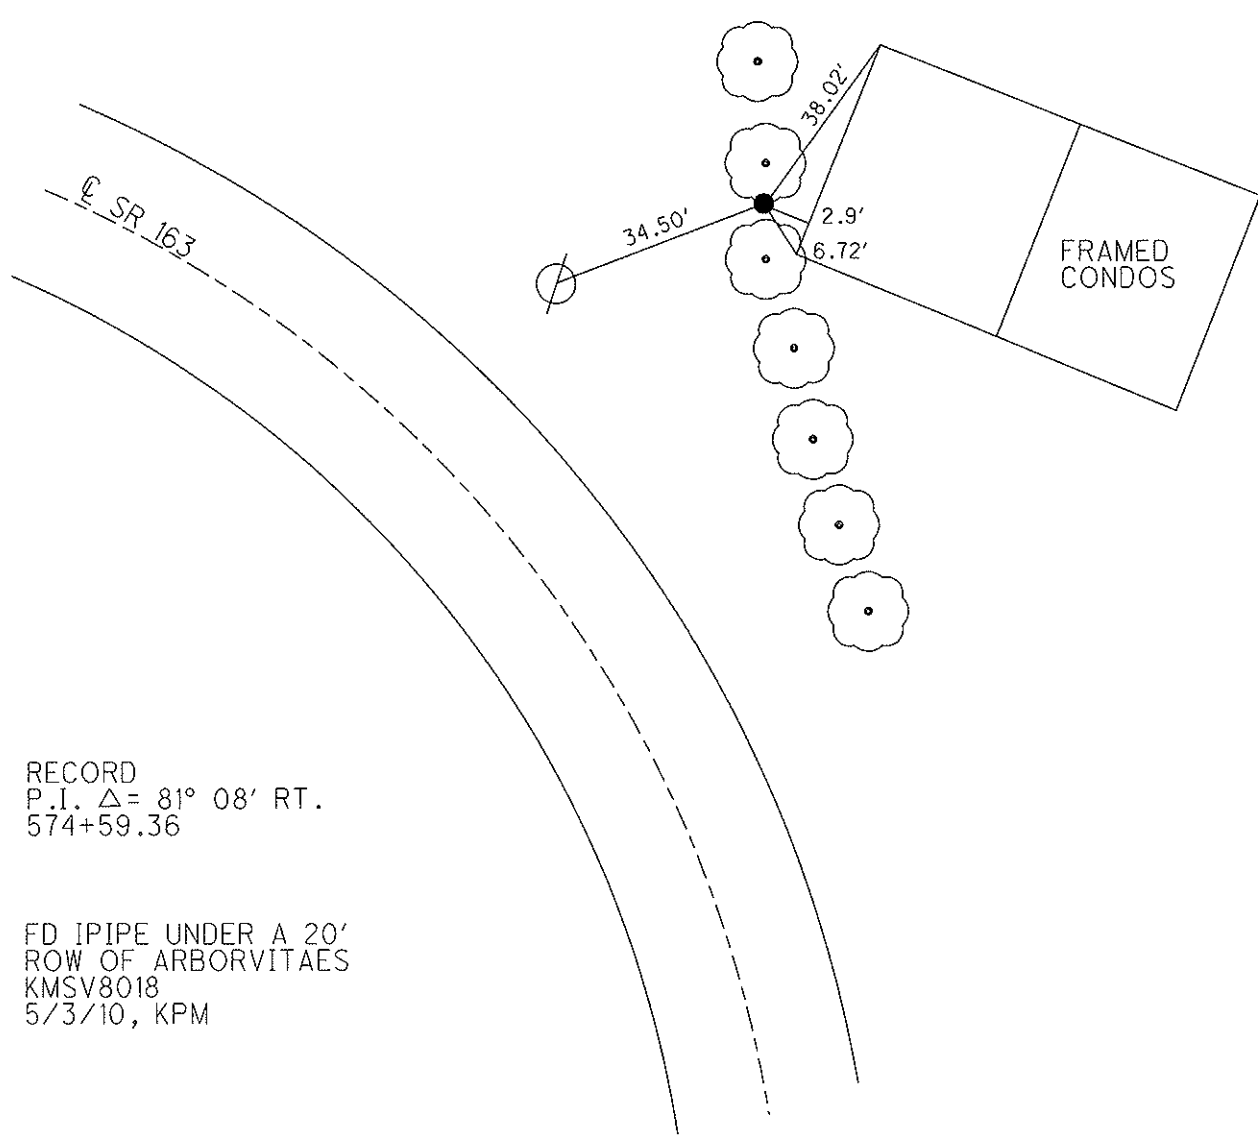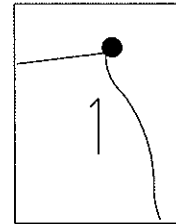

RECORD
P.I. $\Delta = 81^\circ 08' \text{ RT.}$
574+59.36

FD IPIPE UNDER A 20'
ROW OF ARBORVITAEES
KMSV8018
5/3/10, KPM

O.D.O.T. DISTRICT 2 SURVEY OFFICE

PERSONNEL _____

REFERENCE NO. 147 B

SHEET 41 OF 52

NOTES CANTERBURY

H.C. LOHRKE

R.C. ROUSOS

DATE 6-5-95

WEATHER NICE

TEMP. +75

ROUTE S.R. 163

COUNTY OTTAWA

TOWNSHIP MARBLE HEAD

SECTION _____

T. _____ R. _____


TYPE MONUMENT 1" IRON PIPE

~~ON~~ SURFACE - BELOW ± 1/2 inch

LEFT - ~~C~~ PAV'T. - ~~RIGHT~~ 67.5

57' TO Lt EDGE PAVEMENT


S.L.M. 1977+60

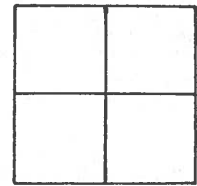

RECORD

P.I. Sta 574+59.36

$\Delta = 81^{\circ}06' Rt$

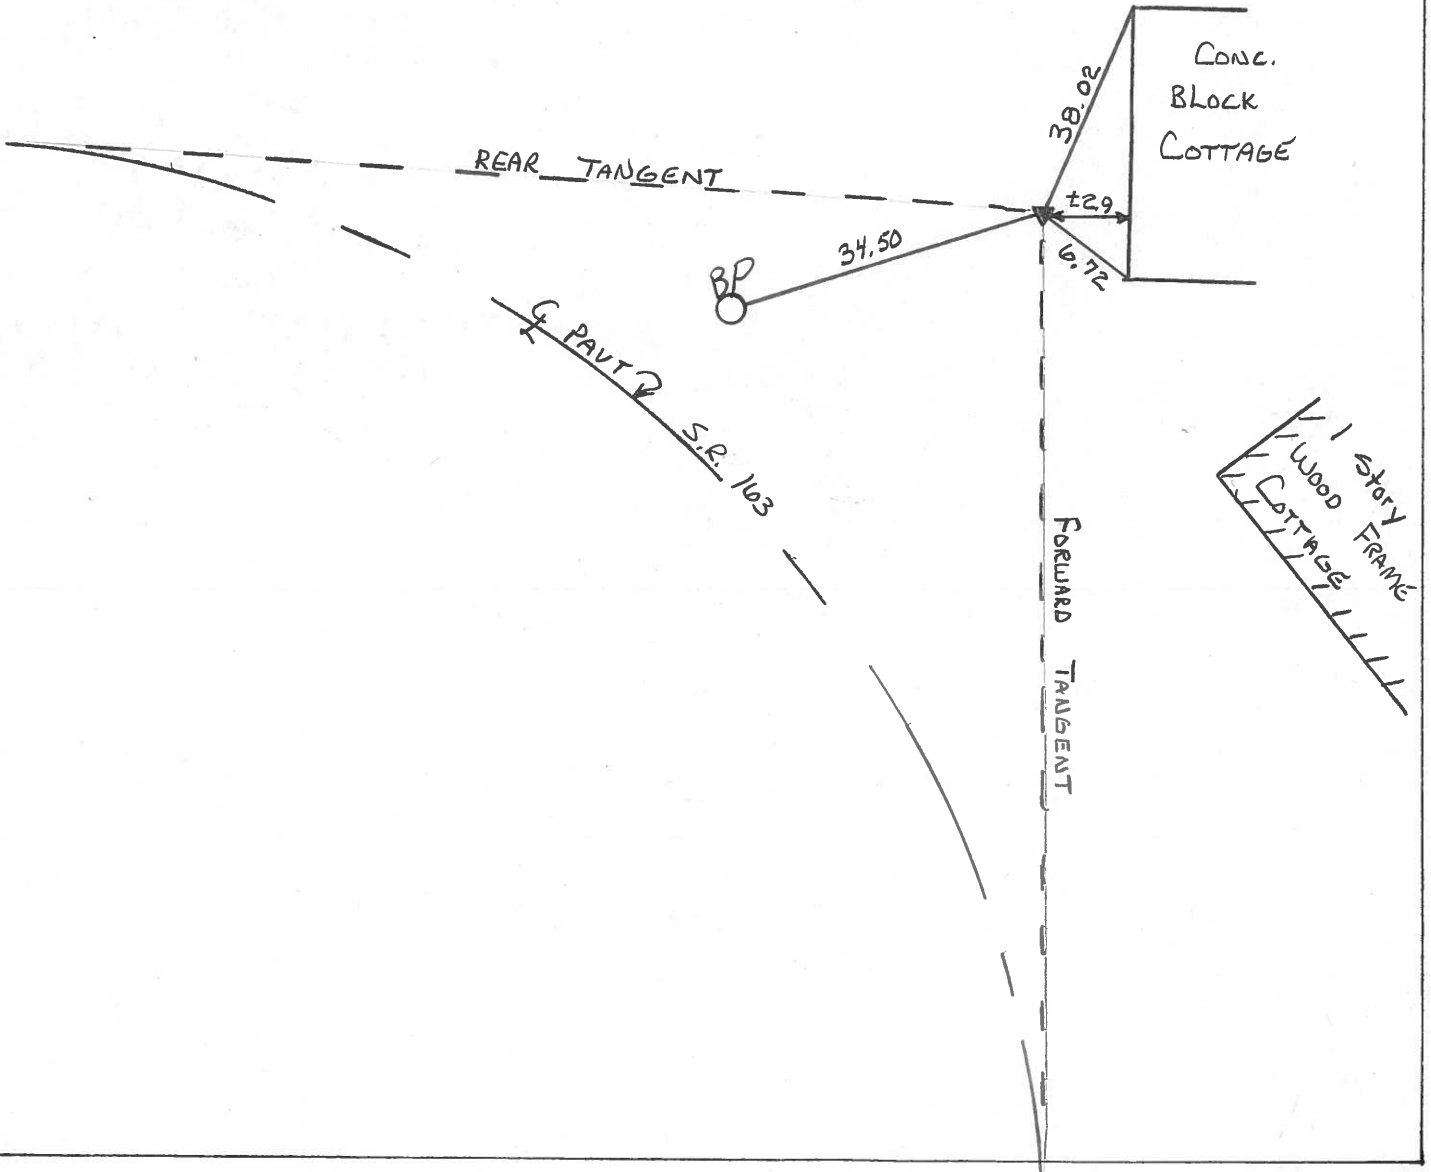

Q.D.O.T. DISTRICT 2 SURVEY OFFICE

SHEET 40 OF _____

County Ottawa S.R. #163

Date 12/14/83

Township Marblehead

Weather overcast

Section _____

Temp. 40°


T N, R E

Personnel Cronin

Ripple

Geyman


Barbour

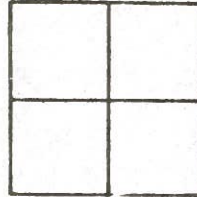

147B



conc. block
cottage

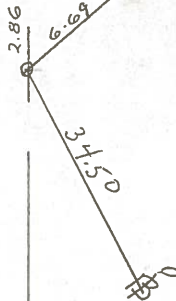

Plan

P.I. $\Delta = 81^{\circ}08' R$

574 + 59.36

Fd. 1" \square Pipe 57'

Lt. Lt. E.P.

PERSONNEL TITLE PERSONNEL TITLE

COUNTY Ottawa DATE 6-14-71


S. R. 163 WEATHER

DANBURY TWP. SEC. 1 TEMP.


DESCRIPTION Marblehead JOB NO.

LEFT CENTER LINE RIGHT


P.I. **147C**
583 + 48.17
Iron Pin
5" down

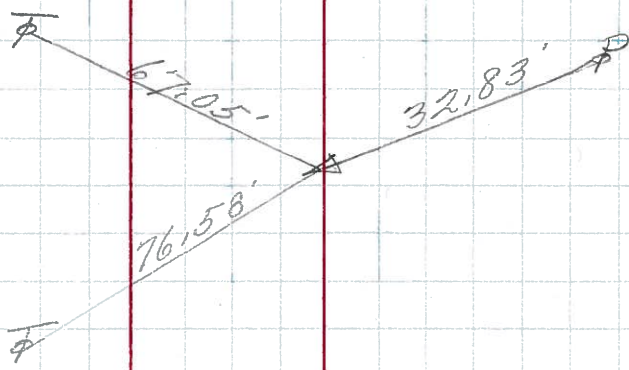

P.I. **147B**
574 + 59.36
1" pipe

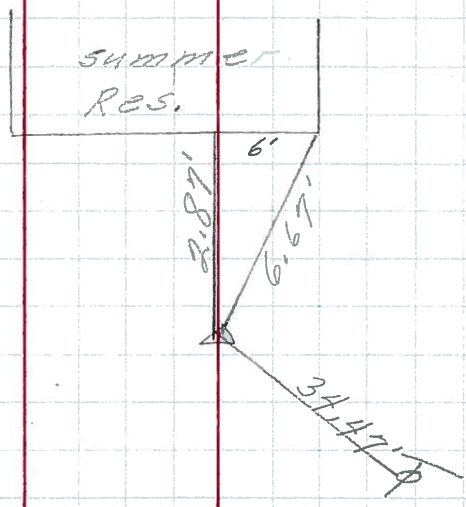

P.I. **147A**
569 + 50.76
R.R. spk.
2" down

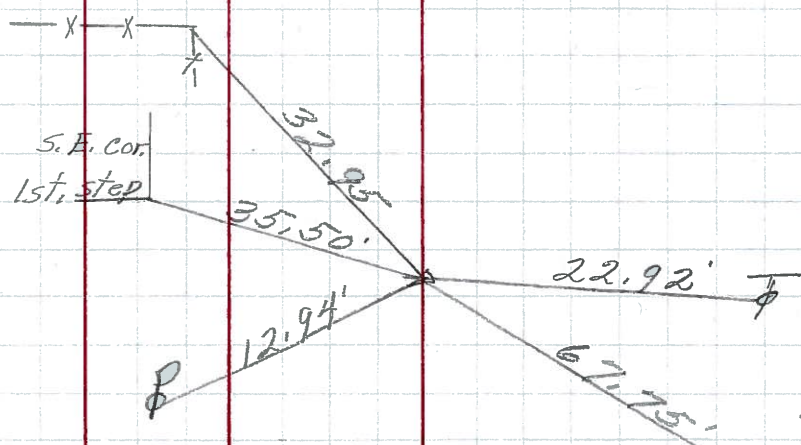

All Plumbed

Top of 2nd Brick
Surf Motel
cinn