



O.D.O.T. DISTRICT 2 SURVEY OFFICE (USE ONLY)

PERSONNEL	REFERENCE NO. <u>147 C</u>	SHEET <u>49</u> OF <u>66</u>
NOTES <u>CODER</u>	DATE <u>9/4/12</u>	ROUTE <u>SR 163</u>
H.C. <u>CODER</u>	WEATHER <u>CLOUDY</u>	COUNTY <u>OTTAWA</u>
R.C. <u>RHOADES</u>	TEMP. <u>70°</u>	TOWNSHIP <u>DANBURY</u>
		SECTION <u>1-1</u>


DWG BY NIESE PID PVTRAIN

TYPE MONUMENT 1" IPIN
~~ON SURFACE~~ - BELOW 10"
 OFFSET \varnothing PAVEMENT 27.6' ~~±~~ : RT
14' RT OF RT EDGE PAVEMENT

NOTE:
THIS MAP IS FOR ODOT PURPOSES ONLY
TO INDEX REFERENCE TIES, AND DOES NOT
REPRESENT TRUE LAND SUBDIVISION.

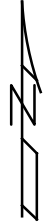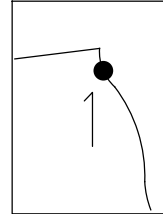

STATION: 1986+82
 HORZ. DATUM: _____ GEOID: _____
 GRID: NORTHING: 681946.7392 EASTING: 1909068.5971

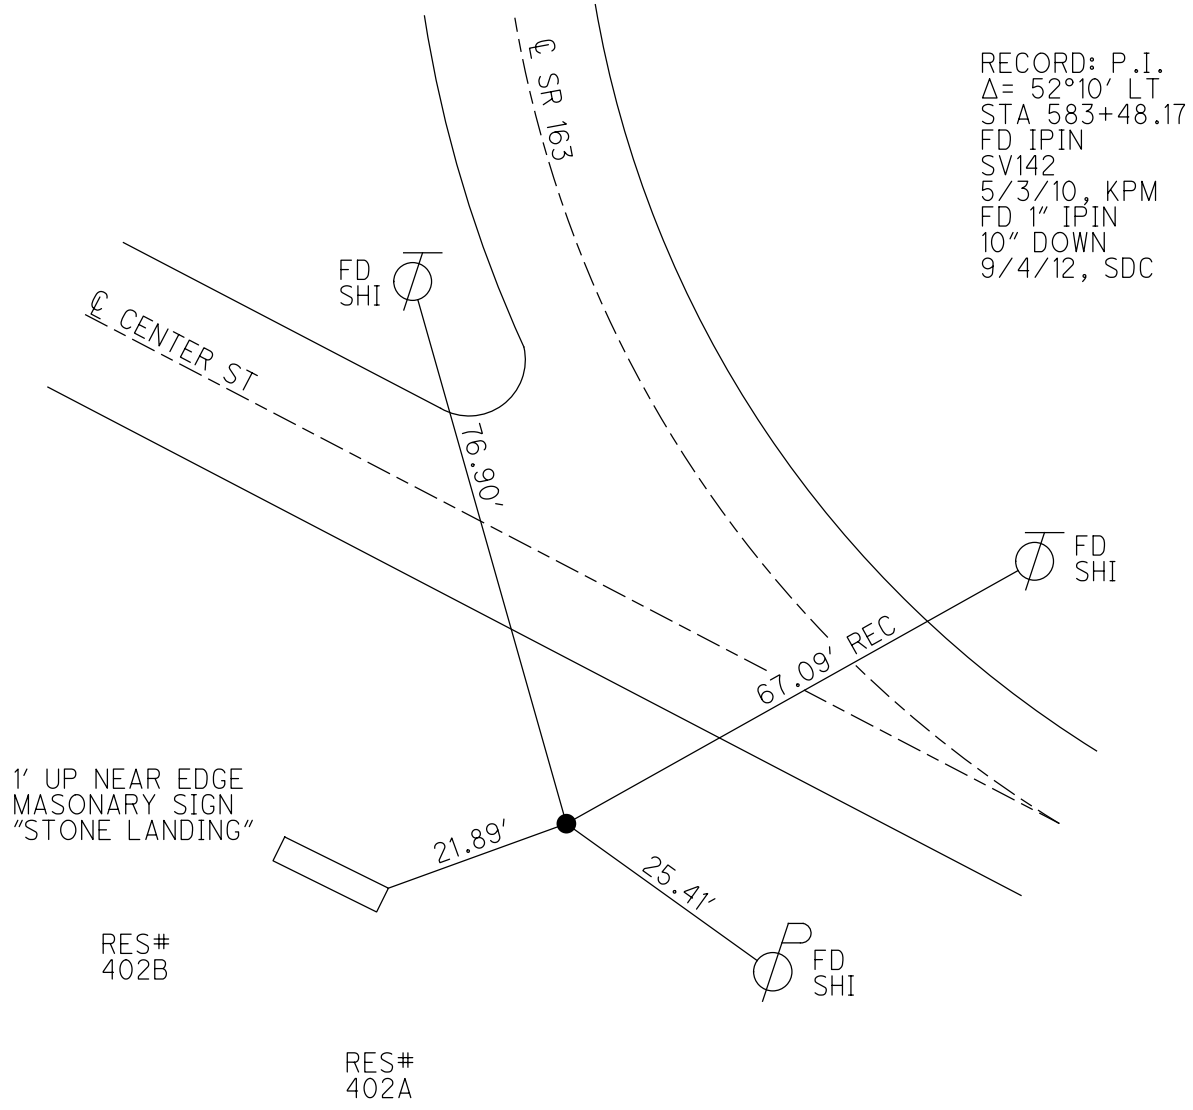

RECORD: P.I.
 $\Delta = 52^{\circ}10' LT$
 STA 583+48.17
 FD IPIN
 SV142
 5/3/10, KPM
 FD 1" IPIN
 10" DOWN
 9/4/12, SDC

O.D.O.T. DISTRICT 2 SURVEY OFFICE (USE ONLY)

PERSONNEL

REFERENCE NO. 147 C

SHEET 49 OF 63

NOTES CODER

DATE 9/4/12

ROUTE SR 163

H.C. CODER

WEATHER CLOUDY

COUNTY OTTAWA

R.C. RHOADES

TEMP. 70°

TOWNSHIP DANBURY

SECTION 1-1

TYPE MONUMENT 1" IPIN




~~ON SURFACE~~ - BELOW 10"

~~LEFT~~ - Q PAV'T - RIGHT 27.6'

14' RT TO RT EDGE PAVEMENT

S.L.M. 1986+82

Grid: Northing: 681946.7392 Easting: 1909068.5971

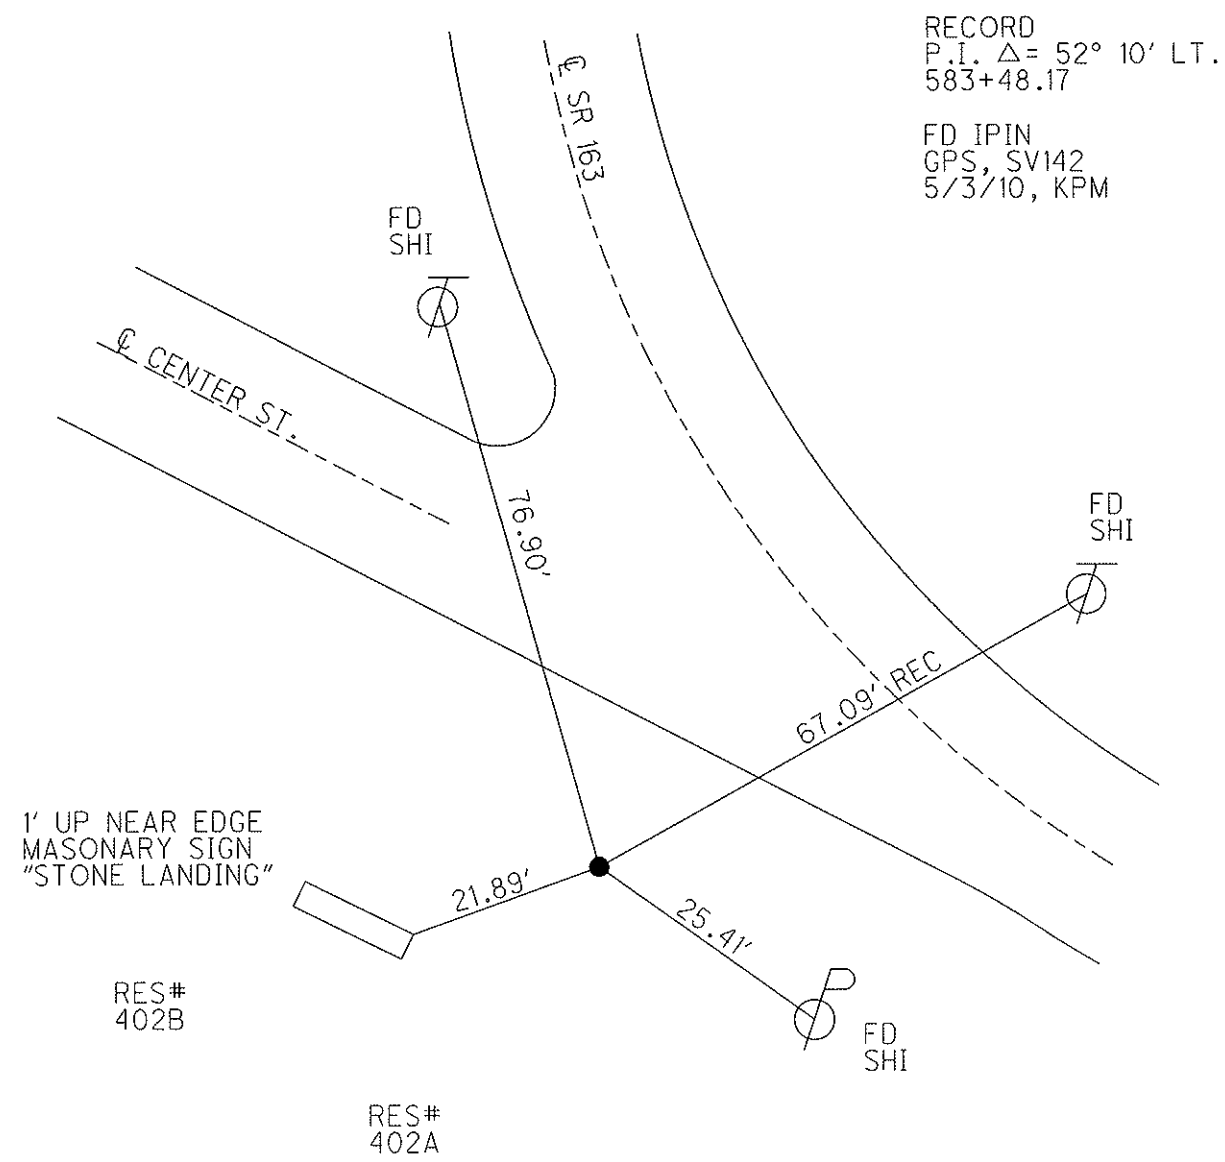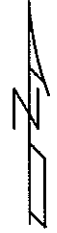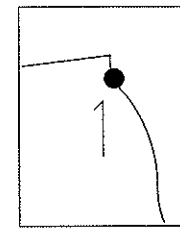

O.D.O.T. DISTRICT 2 SURVEY OFFICE

PERSONNEL _____

REFERENCE NO. 147 C

SHEET 42 OF 52

NOTES CANTERBURY

H.C. LOEHRKE

R.C. ROUSOS

DATE 6-1-95

WEATHER CLOUDY

TEMP. +70°F

ROUTE S.R. 163

COUNTY OTTAWA

TOWNSHIP MARBLEHEAD

SECTION _____



T _____ R _____

TYPE MONUMENT 1" IRON PIN

ON SURFACE - BELOW 5" BELOW

~~LEFT~~ ^{OF} ~~PAV'T.~~ - RIGHT 27.6' RT &
14' RT TO RT EDGE PAVEMENT

S.L.M. 1986 + 82

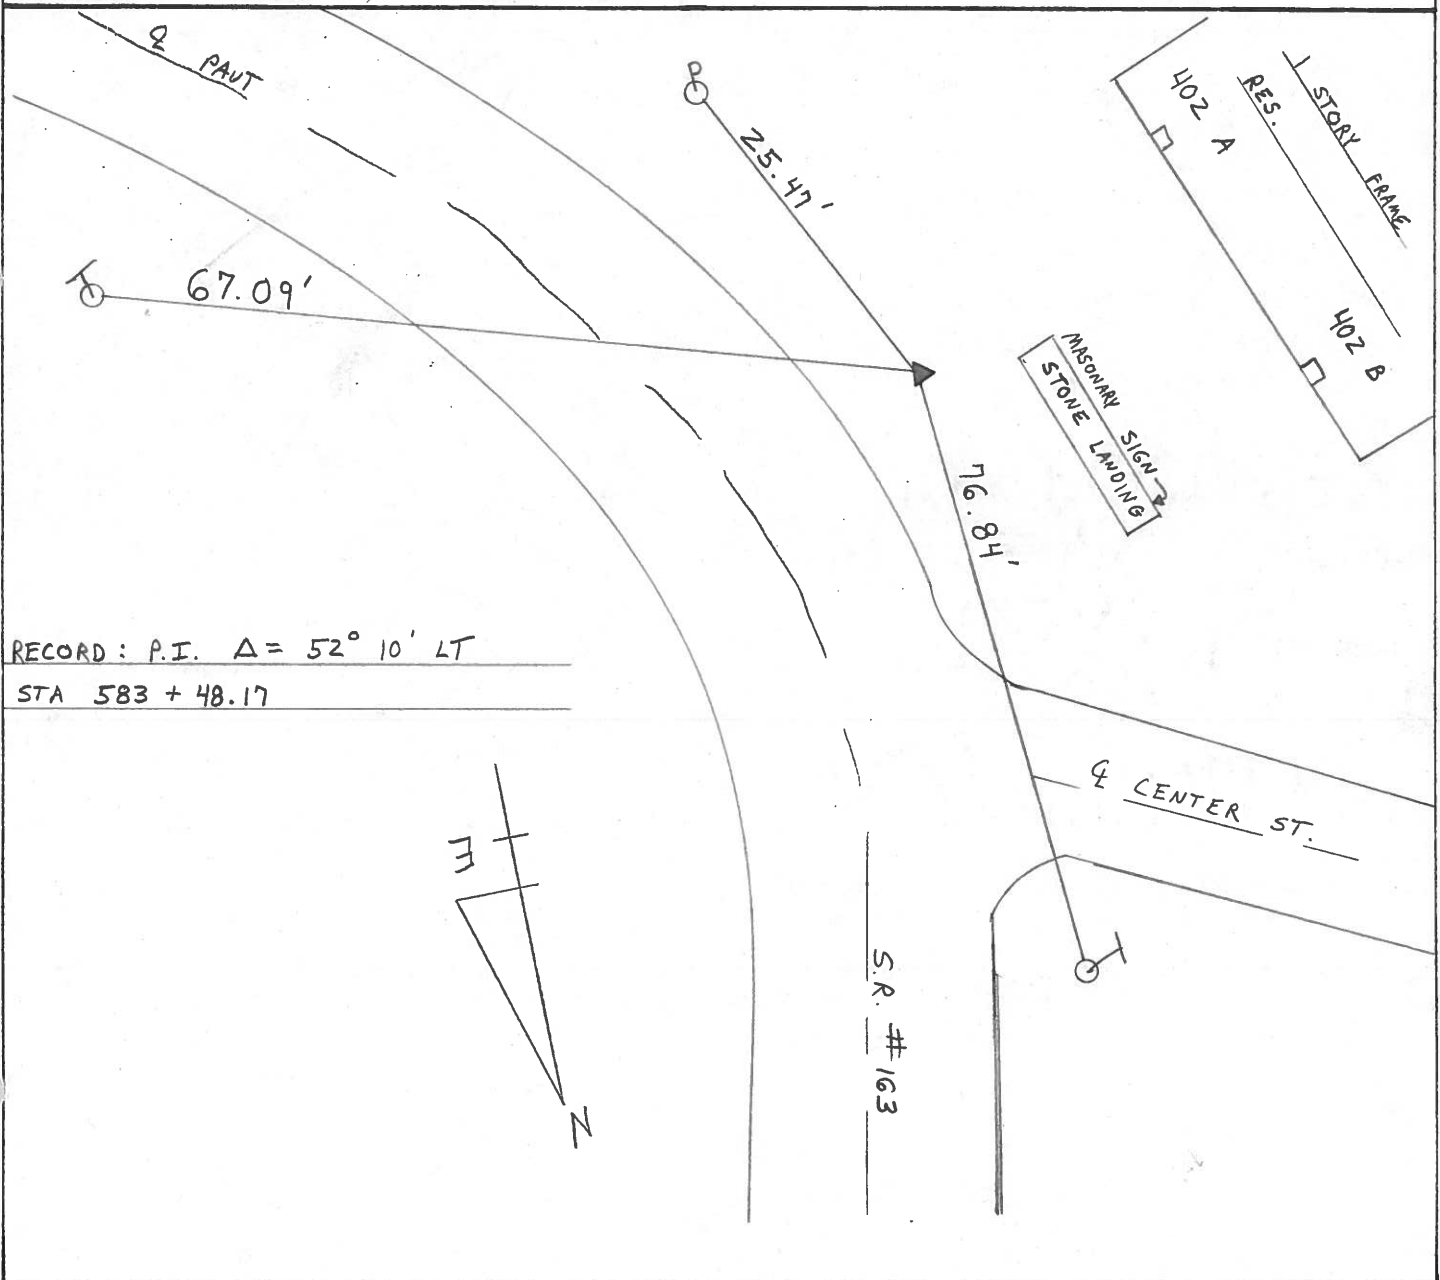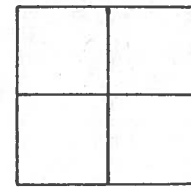

Q.D.O.T. DISTRICT 2 SURVEY OFFICE

SHEET 41 OF _____

County Ottawa S.R. #163

Date 12/14/83

Township Marblehead

Weather overcast

Section _____

Temp. 40°


T-N, R-E

Personnel Cronin

Ripple


Geyman

Barbour

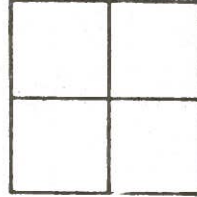

147 C

Plan
P.L. Δ = 52°10' Lt.
583 + 4817
Fd. F. Pin 5" below
surface 14' Rt. Rt. E.P.

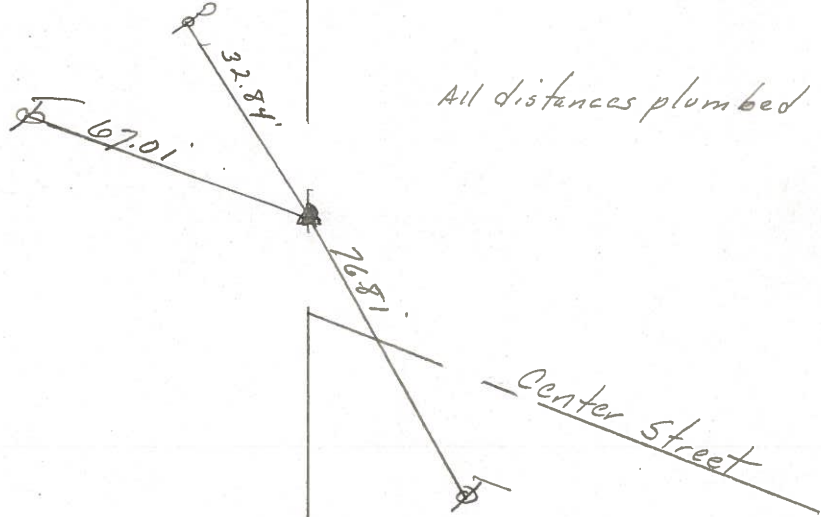

S.R. #163A

PERSONNEL _____ TITLE _____ PERSONNEL _____ TITLE _____
 COUNTY Ottawa DATE 6-14-71
 S. R. 163 WEATHER _____
 JANBURY TWP. SEC. 1 TEMP. _____
 DESCRIPTION Marblehead JOB NO. _____

