

O.D.O.T. DISTRICT 2 SURVEY OFFICE (USE ONLY)

PERSONNEL _____ REFERENCE NO. 147 D SHEET 50 OF 66
 NOTES CODER _____ DATE 9/4/12 ROUTE SR 163
 H.C. CODER _____ WEATHER CLOUDY COUNTY OTTAWA
 R.C. RHOADES TEMP. 70° TOWNSHIP DANBURY
 SECTION 1-1
 DWG BY NIESE PID PVTRAIN

NOTE:
THIS MAP IS FOR ODOT PURPOSES ONLY
TO INDEX REFERENCE TIES, AND DOES NOT
REPRESENT TRUE LAND SUBDIVISION.

TYPE MONUMENT P.K. IN DRILLHOLE

ON SURFACE - ~~BELOW~~ ON



OFFSET Q PAVEMENT 19.7' LT : ~~RT~~

9.0' LT OF LT EDGE PAVEMENT

STATION: 1991+06.02

HORZ. DATUM: _____ GEOID: _____

GRID: NORTHING: 681686.361 EASTING: 1909425.789

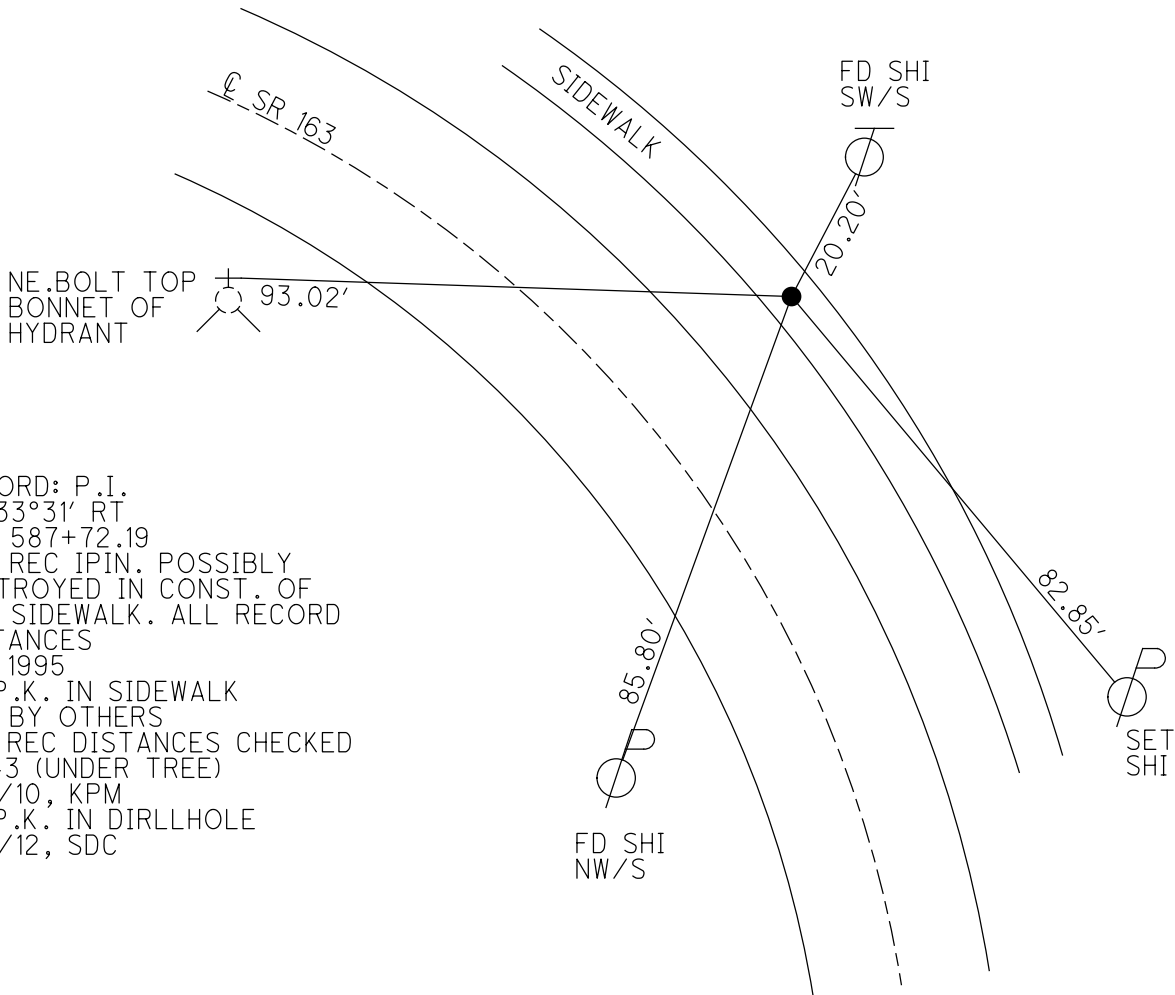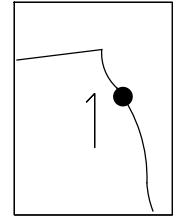

RECORD: P.I.
 $\Delta = 33^{\circ}31' RT$
 STA 587+72.19
 DNF REC IPIN. POSSIBLY
 DESTROYED IN CONST. OF
 NEW SIDEWALK. ALL RECORD
 DISTANCES
 MC, 1995
 FD P.K. IN SIDEWALK
 SET BY OTHERS
 2-3 REC DISTANCES CHECKED
 SV143 (UNDER TREE)
 5/3/10, KPM
 FD P.K. IN DIRLLHOLE
 9/4/12, SDC

O.D.O.T. DISTRICT 2 SURVEY OFFICE (USE ONLY)

PERSONNEL _____ REFERENCE NO. 147 D SHEET 50 OF 63

NOTES CODER DATE 9/4/12 ROUTE SR 163

H.C. CODER WEATHER CLOUDY COUNTY OTTAWA

R.C. RHOADES TEMP. 70° TOWNSHIP DANBURY

SECTION 1-1

TYPE MONUMENT P.K. IN DRILLHOLE



~~ON SURFACE~~ - BELOW ON

LEFT - Q PAV'T - ~~RIGHT~~ 19.7'

9' LT TO LT EDGE PAVEMENT

S.L.M. 1991+06.02

Grid: Northing: 681686.3610 Easting: 1909425.7890

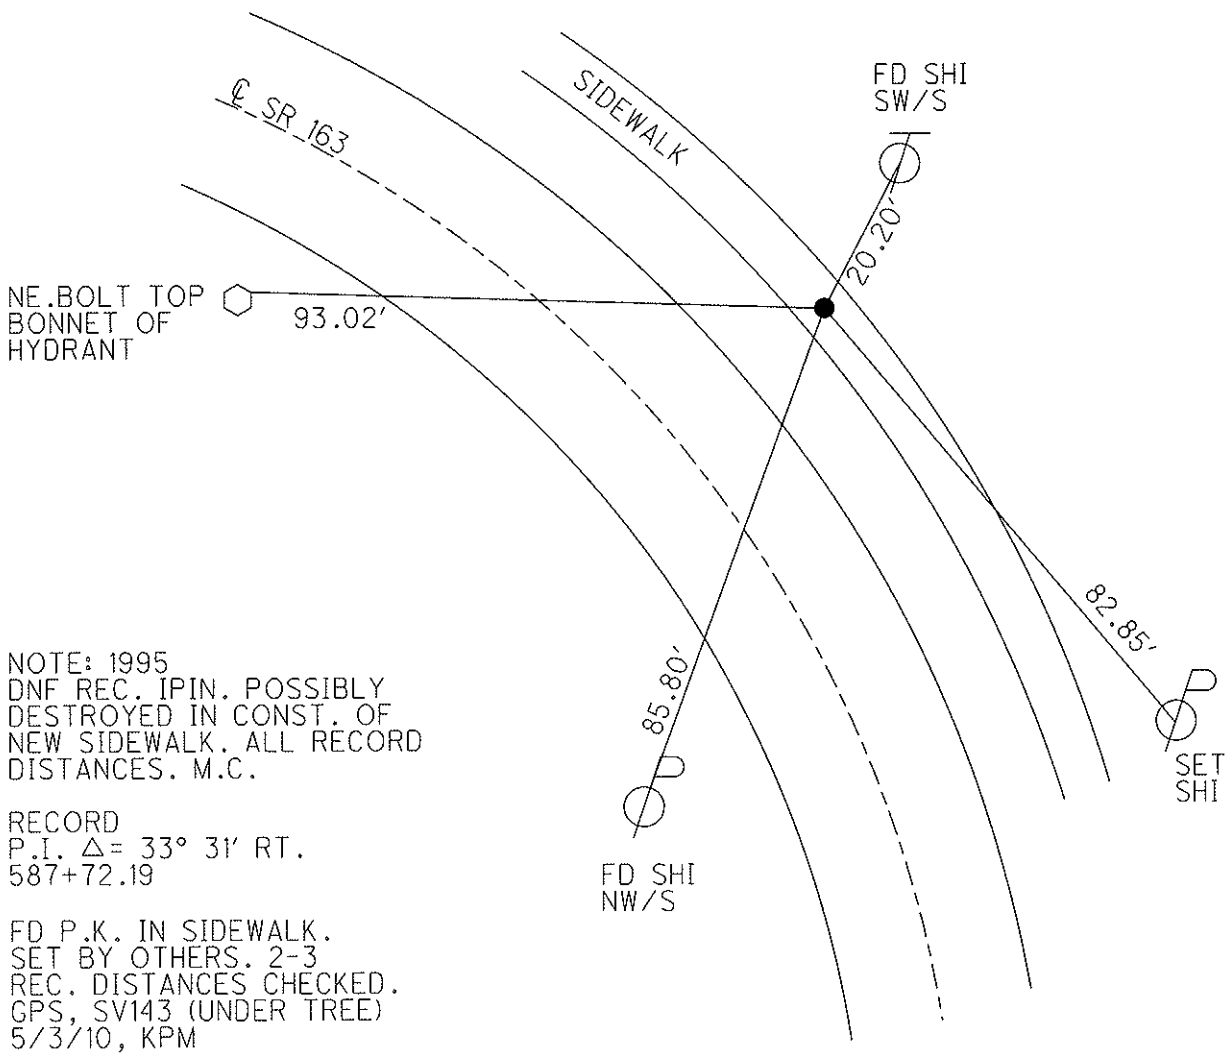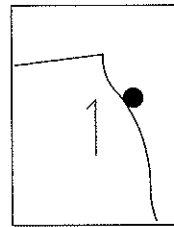

NOTE: 1995
DNF REC. IPIN. POSSIBLY
DESTROYED IN CONST. OF
NEW SIDEWALK. ALL RECORD
DISTANCES. M.C.

RECORD
P.I. $\Delta = 33^\circ 31'$ RT.
587+72.19

FD P.K. IN SIDEWALK.
SET BY OTHERS. 2-3'
REC. DISTANCES CHECKED.
GPS, SV143 (UNDER TREE)
5/3/10, KPM

O.D.O.T. DISTRICT 2 SURVEY OFFICE

PERSONNEL

REFERENCE NO. 147D

SHEET 43 OF 52

NOTES CANTERBURY

H.C. LOEHRKE

R.C. Rousos

DATE 6-1-95

WEATHER CLOUDY

TEMP. +70°F

ROUTE S.R. 163

COUNTY OTTAWA

TOWNSHIP MARBLEHEAD

SECTION _____

T _____ R _____


TYPE MONUMENT IRON ROD

ON SURFACE - BELOW 3" BELOW

LEFT- ϕ PAV'T. - RIGHT ± 19.7

^{OF}
9' LT TO LT EDGE PAVEMENT


S.L.M. _____

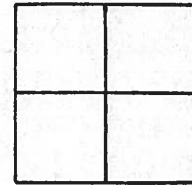

RECORD: $\Delta = 33^{\circ} 31' RT.$

STA 587 + 72.19

DID NOT FIND, POSSIBLY DESTROYED IN CONST. OF NEW SIDEWALK. ALL RECORD DISTANCES

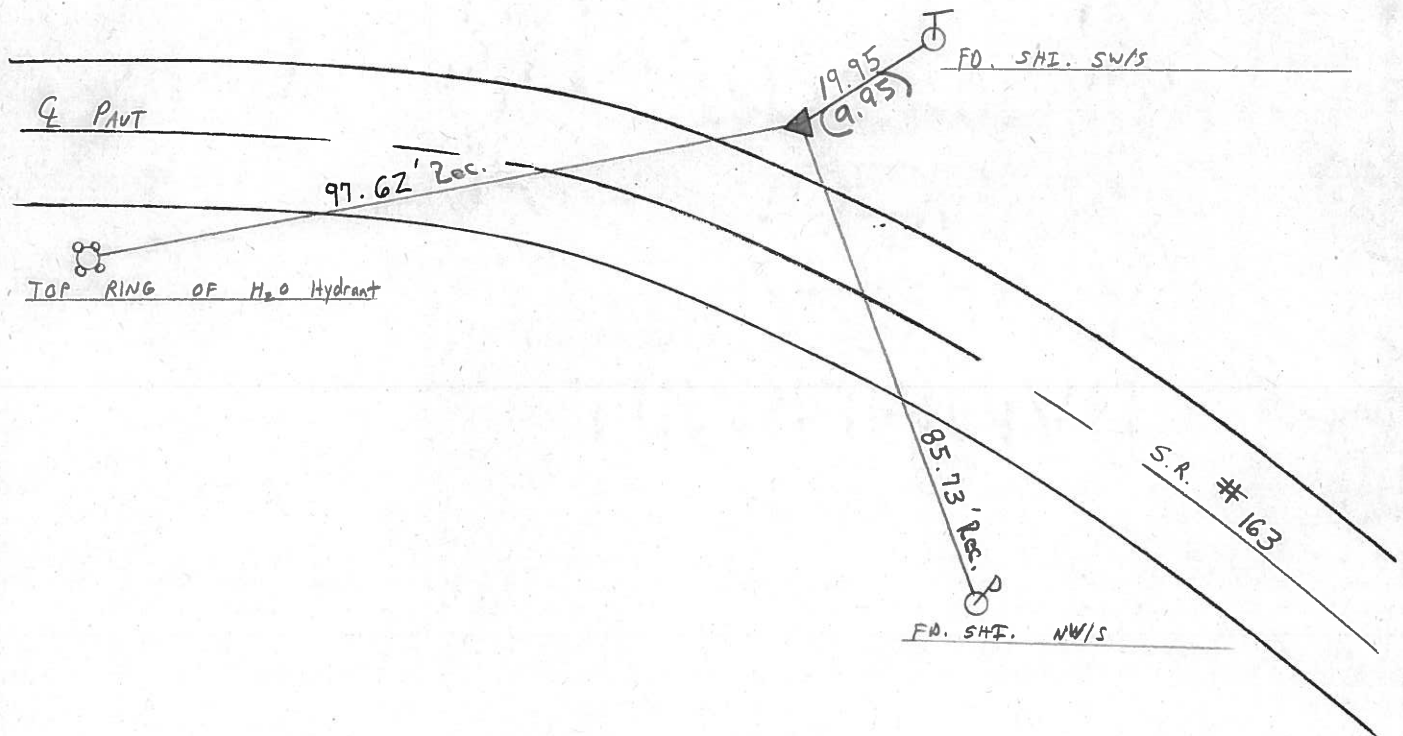

County Ottawa S.R. # 163

Township Marblehead

Section

T-N, R-E

Personnel Cronin

Ripple


Geyman

Barbour

Date 12/14/83

Weather overcast

Temp. 40°

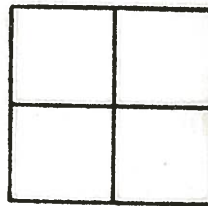

147D

Plan
P.I. A = 33° 31' Rt.
587 + 72.19
Fd. I. Rod 3" below
ground 9' Lt.-Lt. E.P.

9.95'
Plumb

85.73'

97.62'

Top ring of H₂O hydrant

S.R. # 163



PERSONNEL TITLE PERSONNEL TITLE


COUNTY Ottawa DATE 6-14-71

S. R. 163 WEATHER


SEC. 1 TEMP.

DESCRIPTION Marblehead LEFT CENTER LINE RIGHT JOB NO.

P.I. 148A
604+ 95.56
P.K. Nail

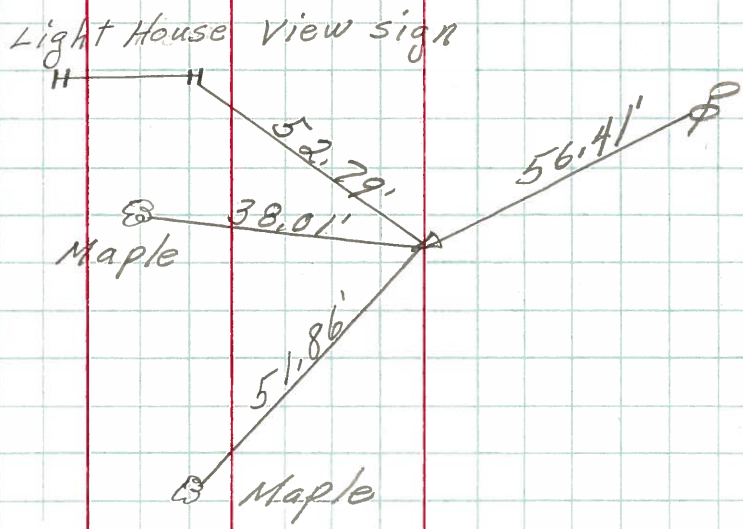

P.I. 148
601+ 75.89
Small spk.

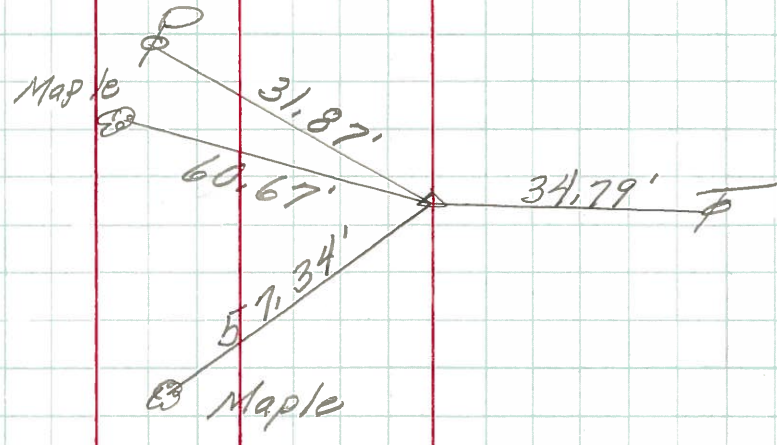

P.I. 147D
587+ 72.19
Iron Pin
2" down

