

O.D.O.T. DISTRICT 2 SURVEY OFFICE (USE ONLY)

PERSONNEL

REFERENCE NO. 148 A

SHEET 52 OF 66

NOTES CODER DATE 9/4/12
 H.C. CODER WEATHER FAIR
 R.C. RHOADES TEMP. 75°

ROUTE SR 163
 COUNTY OTTAWA
 TOWNSHIP DANBURY
 SECTION 1-1

DWG BY NIESE PID PVTRAIN

TYPE MONUMENT P.K./WASHER

ON SURFACE - ~~BELOW~~ ON

OFFSET CL PAVEMENT 7.2' LT : ~~RT~~

4.7' TO RT EDGE PAVEMENT

STATION: 2008+49



HORZ. DATUM: NAD83 (2011)

GEOID: NAVD88 2018

GRID: NORTHING: 680041.454

EASTING: 1909916.635

NOTE:
THIS MAP IS FOR ODOT PURPOSES ONLY
TO INDEX REFERENCE TIES, AND DOES NOT
REPRESENT TRUE LAND SUBDIVISION.

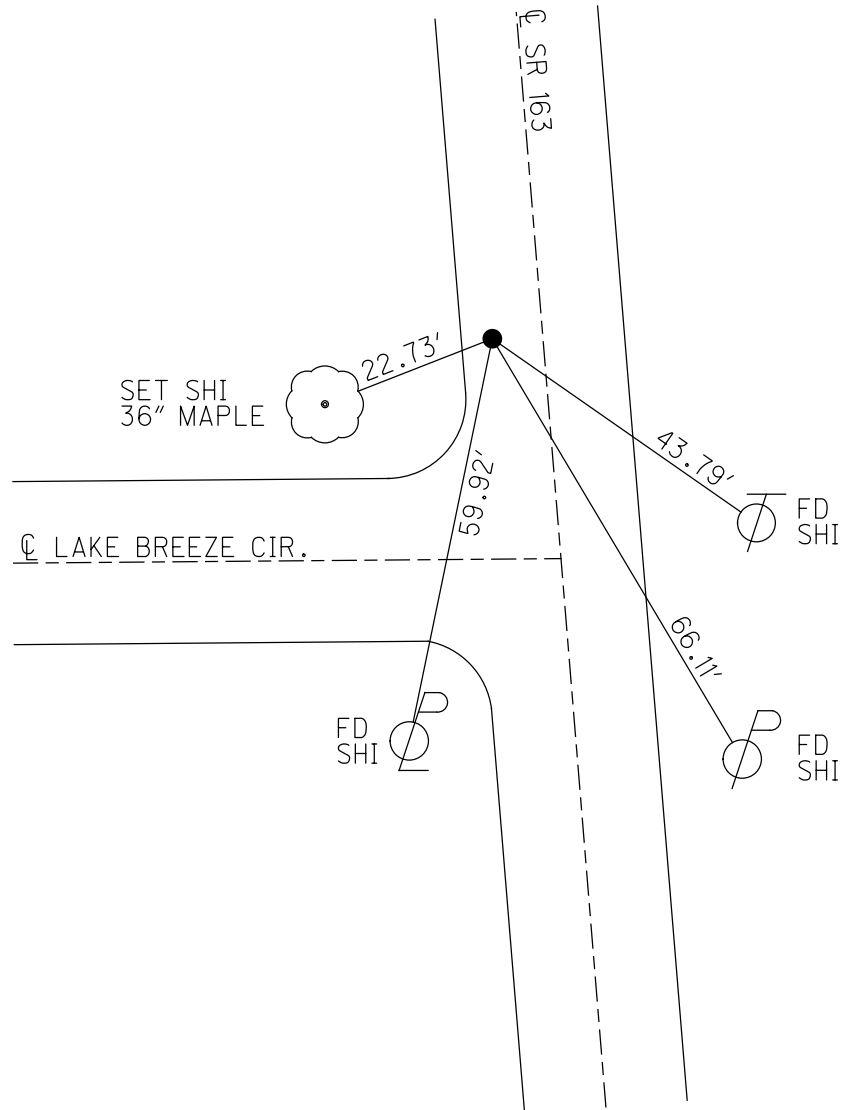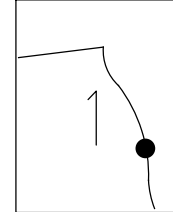


RECORD: P.I.
 $\Delta = 11^{\circ}58'$ RT
 STA 604+95.56
 SET P.K./WASHER
 6/10/96, MRC
 FD P.K./WASHER
 5/4/10, KPM
 9/4/12, SDC
 SET MAG/WASHER
 11/6/12, SDC
 FD MAG/WASHER
 11/8/12, SDC
 FD P.K./WASHER
 REFA148
 6/11/21, TDN
 2/4/22, JFO

O.D.O.T. DISTRICT 2 SURVEY OFFICE (USE ONLY)

PERSONNEL	REFERENCE NO. <u>148 A</u>	SHEET <u>52</u> OF <u>63</u>
NOTES	DATE <u>9/4/12</u>	ROUTE <u>SR 163</u>
H.C. <u>CODER</u>	WEATHER <u>FAIR</u>	COUNTY <u>OTTAWA</u>
R.C. <u>RHOADES</u>	TEMP. <u>75°</u>	TOWNSHIP <u>DANBURY</u>
		SECTION <u>1-1</u>

TYPE MONUMENT P.K./WASHER
 ON SURFACE - ~~BELOW~~ ON
~~LEFT~~ - CL PAV'T - RIGHT 7.2'
4.7' TO RT EDGE PAVEMENT
 S.L.M. 2008+49
 Grid: Northing: 680041.511 Easting: 1909916.625

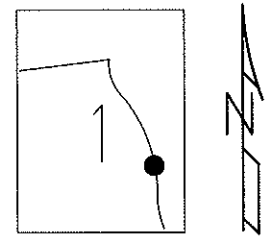


RECORD
 P.I. Δ = 11° 58' RT.
 604+95.56

RESET P.K./WASHER
 6/10/96, MRC
 FD P.K./WASHER
 GPS, SV145
 5/4/10, KPM

 SET MAG/WASHER
 11/6/12, SDC

 GPS, FINREFA148
 11/8/12, SDC

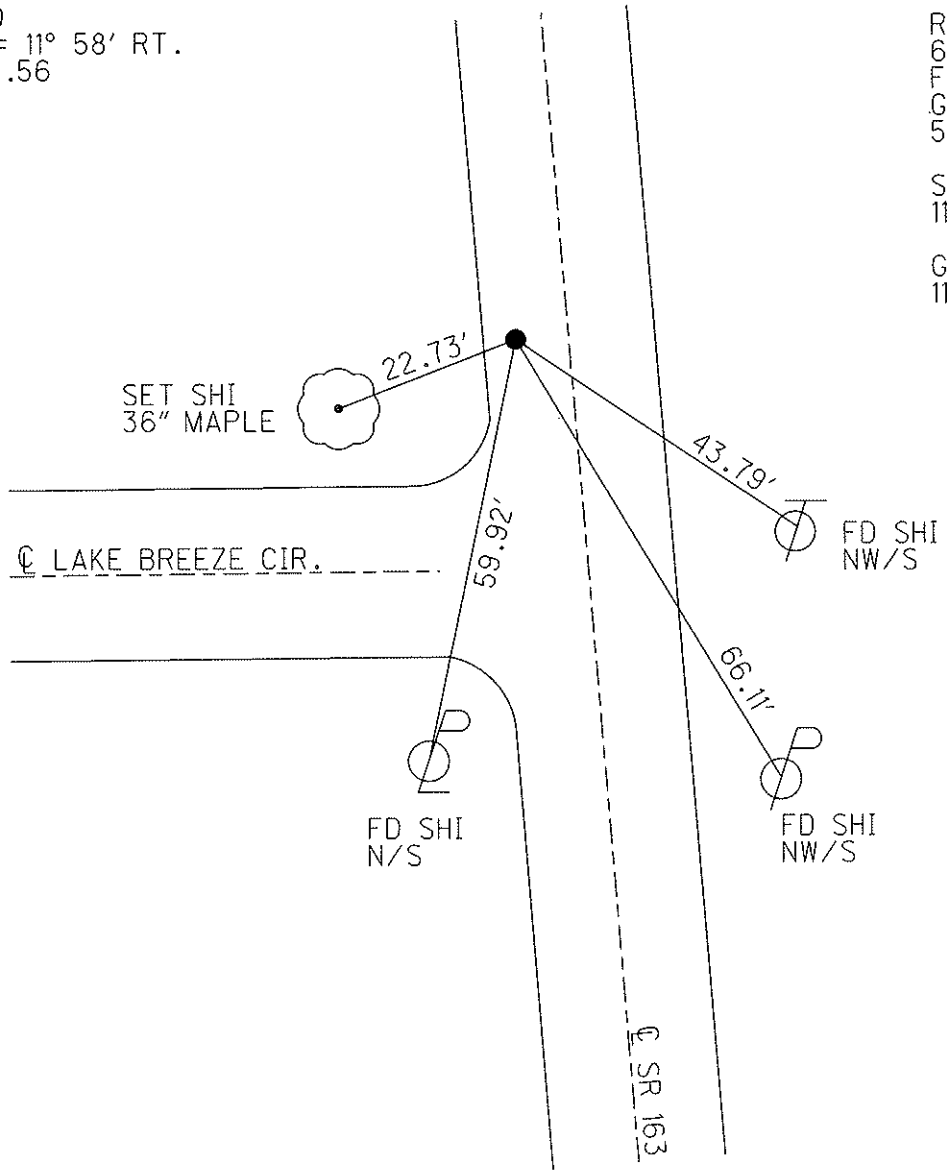

O.D.O.T. DISTRICT 2 SURVEY OFFICE

PERSONNEL _____

REFERENCE NO. 148A

SHEET 45 OF 52

NOTES CANTERBURY

H.C. LOHRKE

R.C. ROUSOS

DATE 6-5-95

WEATHER FAIR

TEMP. +75° F

ROUTE S.R. 163

COUNTY OTTAWA

TOWNSHIP MARBLEHEAD

SECTION _____

T _____ R _____

TYPE MONUMENT PK NAIL / WASHER


ON SURFACE - ~~BELOW~~ YES

~~LEFT - C~~ PAV'T. - RIGHT 7.2' RT &


4.7' TO RT EDGE PAVEMENT

S.L.M. 2008 + 49

SET PK/WASHER
6/10/96
M.R.C.

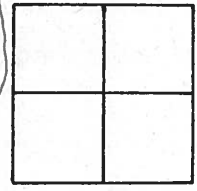

RECORD: P.I. $\Delta = 11^\circ 58'$ LT.
STA 604 + 95.56

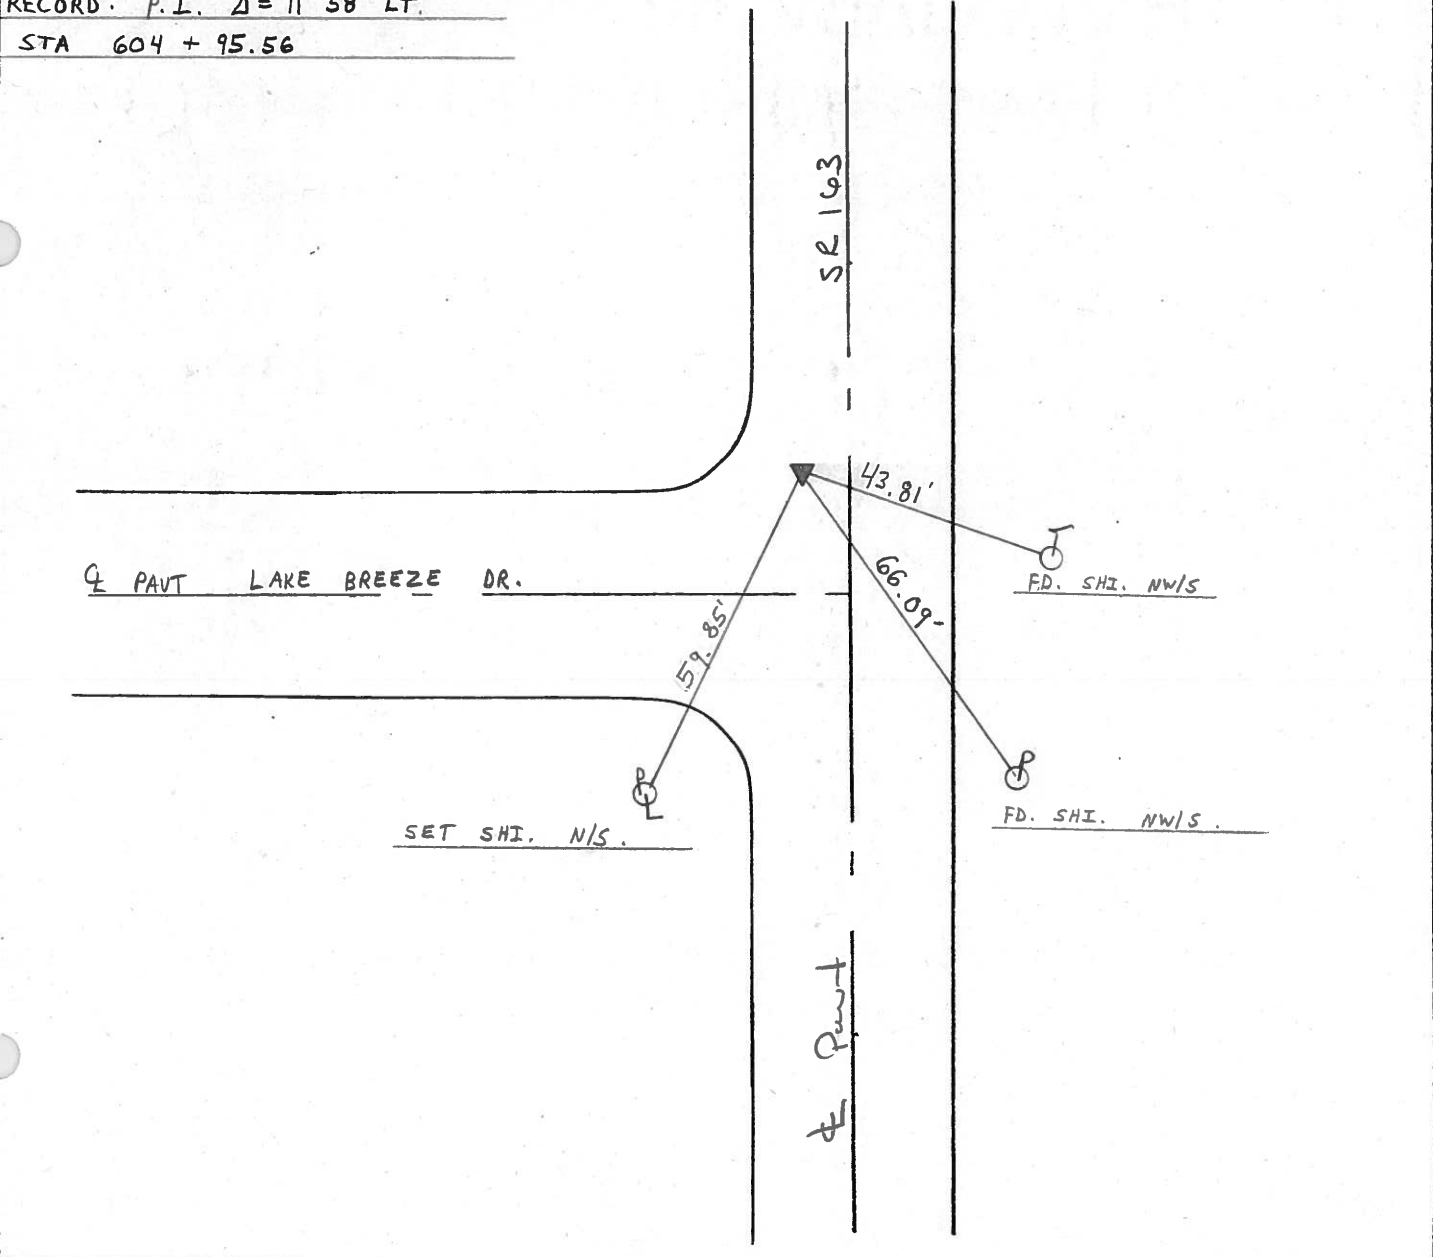

Q.D.O.T. DISTRICT 2 SURVEY OFFICE

SHEET 44 OF _____

County Ottawa S.R. #163

Date 12/14/83

Township Marblehead

Weather overcast

Section _____

Temp. 41°


T-N, R-E

Personnel Cronin



Ripple

Geyman

Barbour

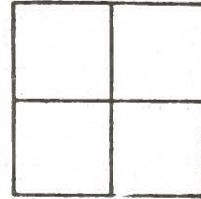


148A

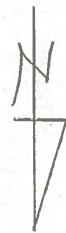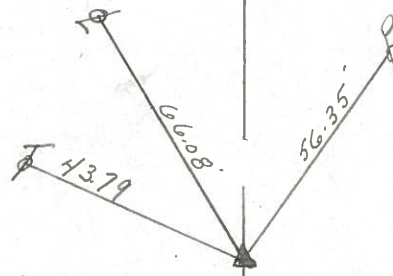

Plan
P.I. Δ = 11° 58' Lt.
604 + 95.56
Set P.K. E washer atop
P.K. 7' Rt. & Permit

* S.R. # 163 *

PERSONNEL	TITLE	PERSONNEL	TITLE	COUNTY	DATE
				Ottawa	6-14-71
				S. R. 163	WEATHER
				SEC. 1	TEMP.
DESCRIPTION				Marblehead	JOB NO.

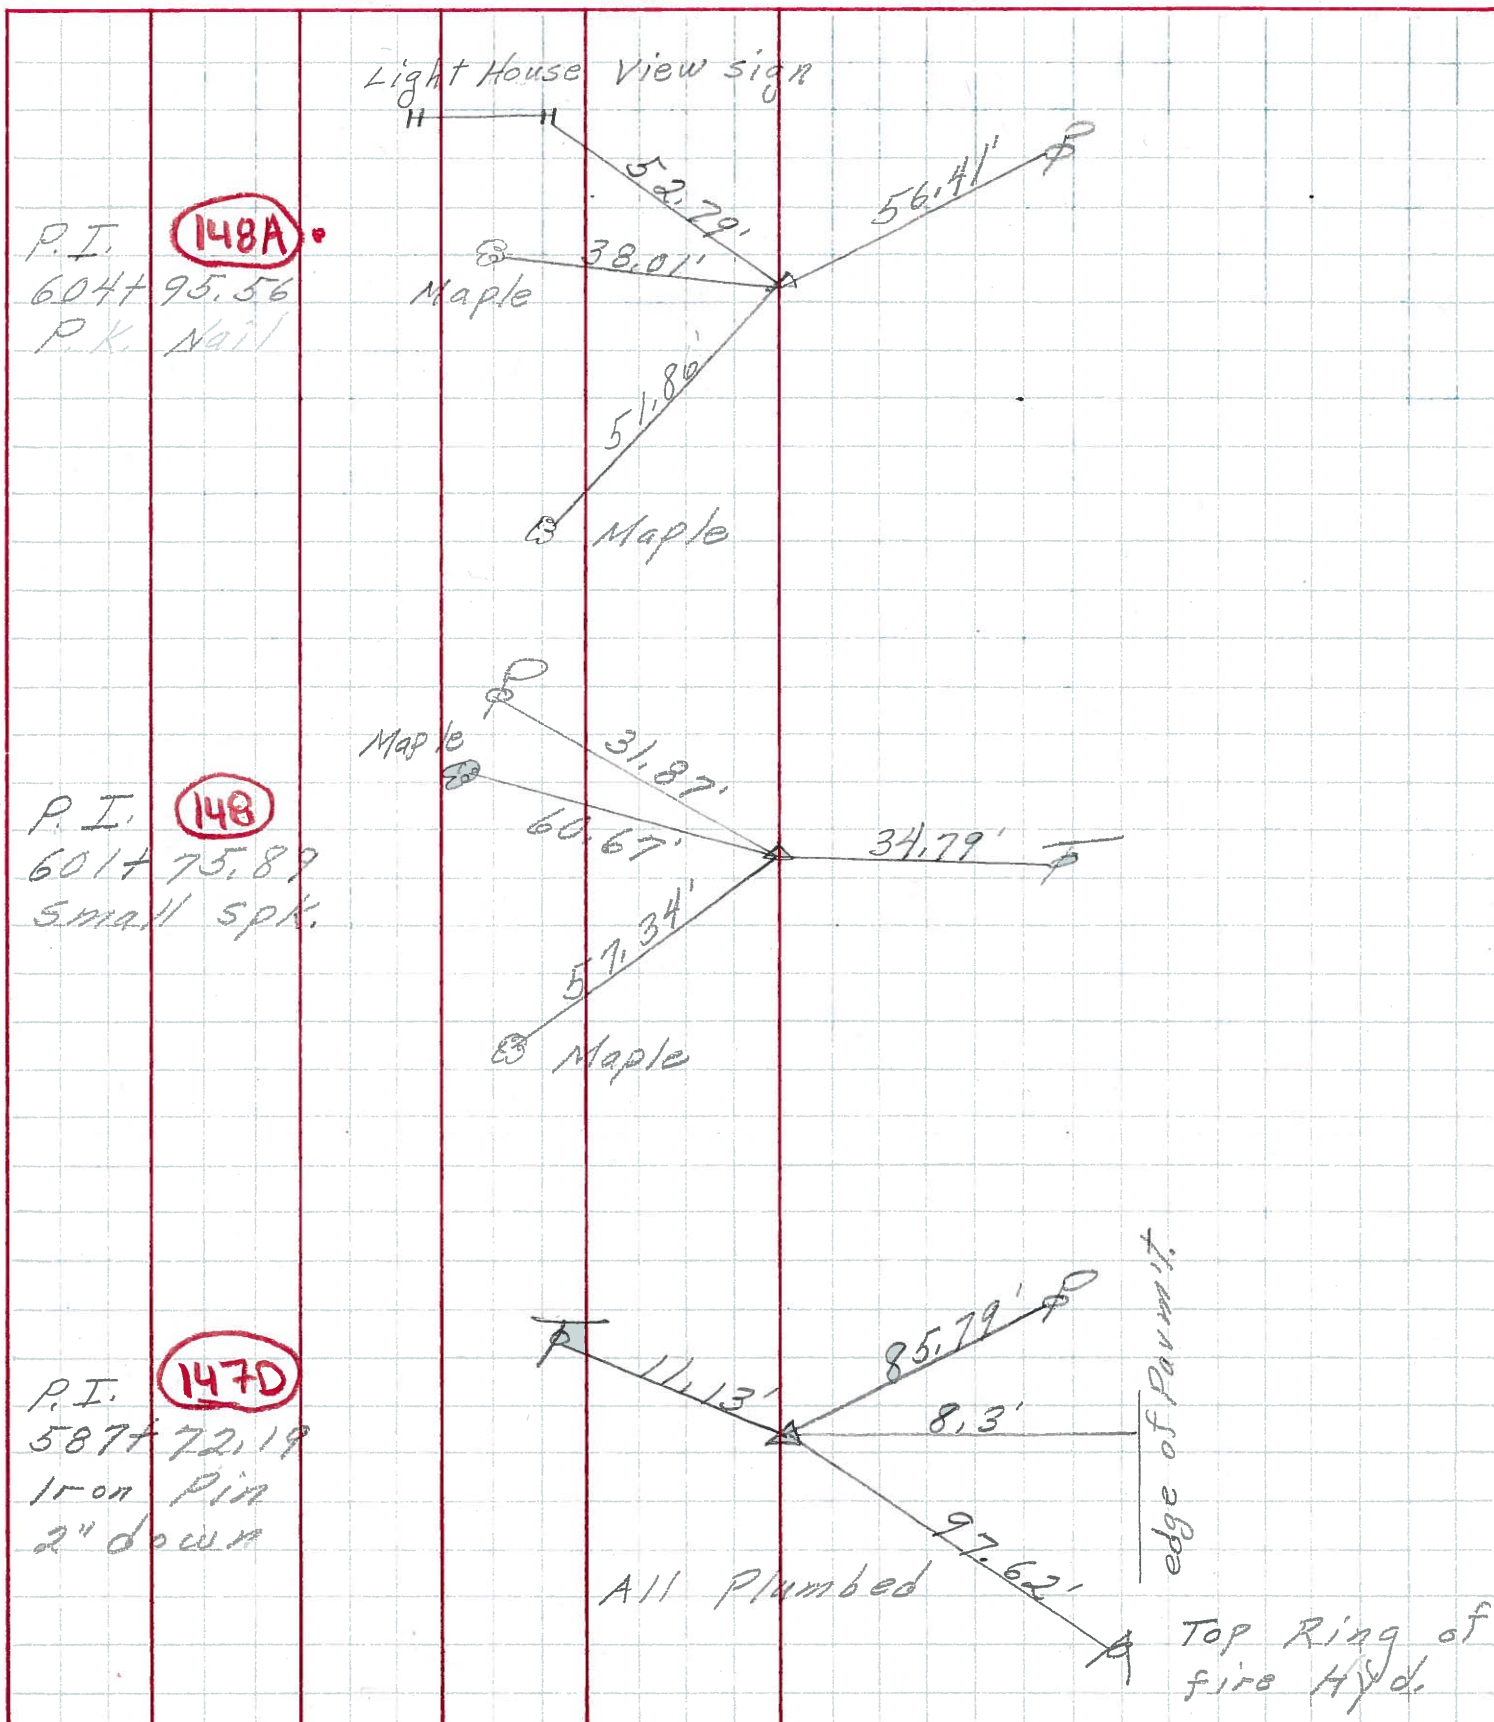

PERSONNEL TITLE PERSONNEL TITLE

Schneider

COUNTY H W

DATE 9-13-68

Barbour

S. R. 16

WEATHER Fair

Redding

SEC.

TEMP. 60°

Potts J

DESCRIPTION

Ties for Control P 1

JOB NO.

