

O.D.O.T. DISTRICT 2 SURVEY OFFICE (USE ONLY)

PERSONNEL _____

REFERENCE NO. 149

SHEET 54 OF 66

NOTES CANTERBURY

DATE 6/5/95

ROUTE SR 163

H.C. LOEHRKE

WEATHER FAIR

COUNTY OTTAWA

R.C. ROUSOS

TEMP. 75°

TOWNSHIP DANBURY

SECTION 1-1

DWG BY NIESE

PID PVTRAIN

TYPE MONUMENT P.K. NAIL IN STONE HEADWALL

ON SURFACE - ~~BELOW~~ ON

OFFSET ϕ PAVEMENT 20.7' ~~LT~~ : RT

9.0' RT OF RT EDGE PAVEMENT

STATION: 2017+86


HORZ.DATUM: _____

GEOID: _____


GRID: NORTHING: 679117.1311

EASTING: 1909917.2209

NOTE:
THIS MAP IS FOR ODOT PURPOSES ONLY.
TO INDEX REFERENCE TIES, AND DOES NOT
REPRESENT TRUE LAND SUBDIVISION.

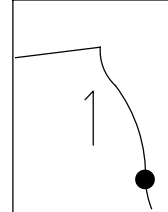

RECORD: P.I.
 $\Delta = 36^{\circ}00'$ LT
 STA 614+33.50
 FD P.K. NAIL IN
 STONE HEADWALL
 6/5/95, MRC
 LOCATED SITE
 SHOT PAINT HOLE IN
 ROCK HEADWALL.
 PAINT PLACED BY OTHERS.
 ALL TIES GONE.
 SV147
 5/4/10, KPM

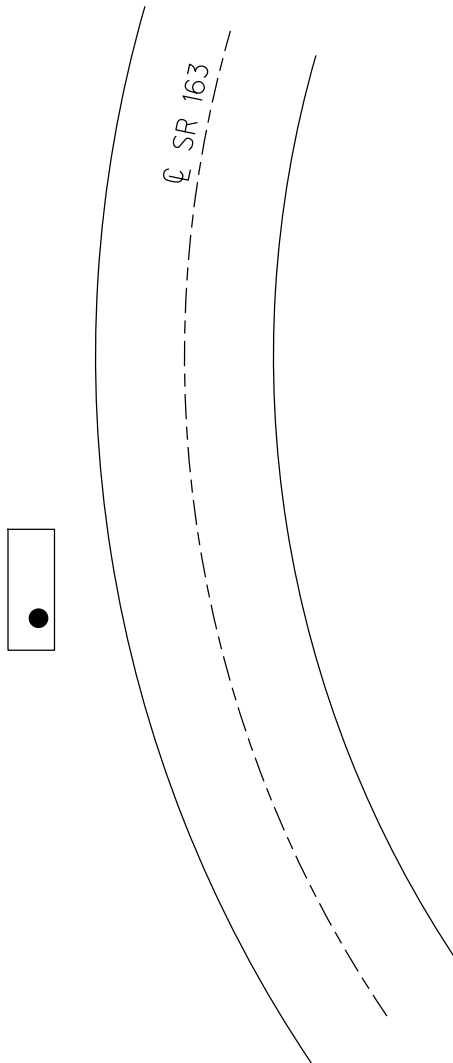

O.D.O.T. DISTRICT 2 SURVEY OFFICE (USE ONLY)

PERSONNEL

REFERENCE NO. 149

SHEET 54 OF 63

NOTES CANTERBURY

DATE 6/5/95

ROUTE SR 163

H.C. LOEHRKE

WEATHER FAIR

COUNTY OTTAWA

R.C. ROUSOS

TEMP. 75°

TOWNSHIP DANBURY

SECTION 1-1

TYPE MONUMENT P.K. NAIL IN STONE HEADWALL


ON SURFACE - ~~BELOW~~ ON

~~LEFT~~ - Q PAV'T - RIGHT 20.7'

9' RT TO RT EDGE PAVEMENT


S.L.M. 2017+86

Grid: Northing: 679117.1311 Easting: 1909917.2209

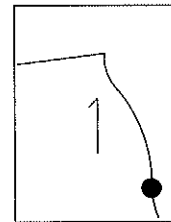

RECORD
P.I. $\Delta = 36^\circ 00'$ LT.
614+33.50

LOCATED SITE.
SHOT PAINT HOLE IN
ROCK HEADWALL.
PAINT PLACED BY OTHERS.
ALL TIES GONE.
GPS, SV147
5/4/10, KPM

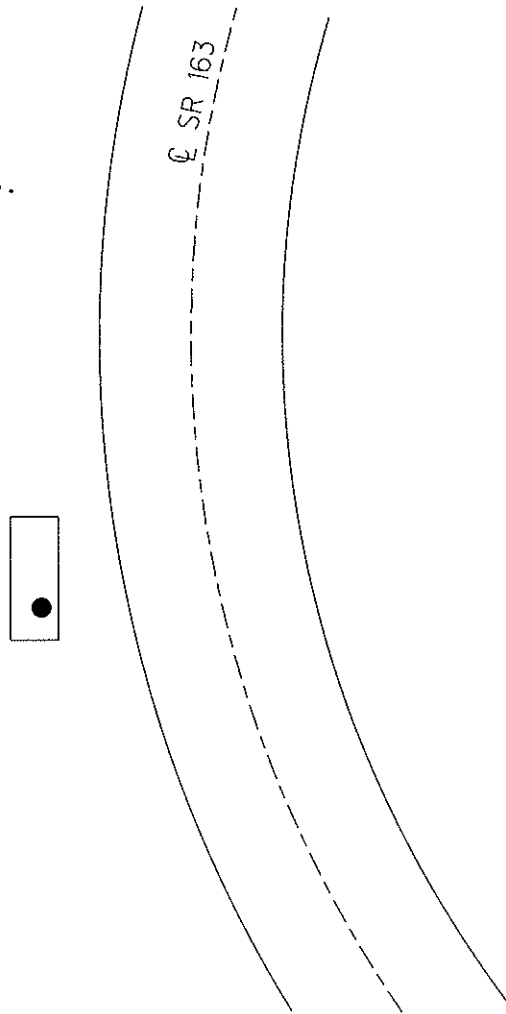

O.D.O.T. DISTRICT 2 SURVEY OFFICE

PERSONNEL _____

REFERENCE NO. 149

SHEET 47 OF 52

NOTES CANTERBURY

H.C. LOEHRKE

R.C. ROUSOS

DATE 6-5-95

WEATHER FAIR

TEMP. +75°F

ROUTE S.R. #163

COUNTY OTTAWA


TOWNSHIP MARBLEHEAD

SECTION _____


T. _____ R. _____

TYPE MONUMENT PK NAIL IN STONE HEADWALL
 ON SURFACE - ~~BELOW~~ YES
~~LEFT - & PAV'T. - RIGHT~~ 20.7' RT &
9' RT OF RT EDGE PAVEMENT
 S.L.M. 2017 + 86

NOT COVERED
6/10/96
M.R.C.

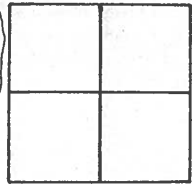

RECORD: P.I. $\Delta = 36^\circ 00'$ LT.
 STA 614 + 33.50

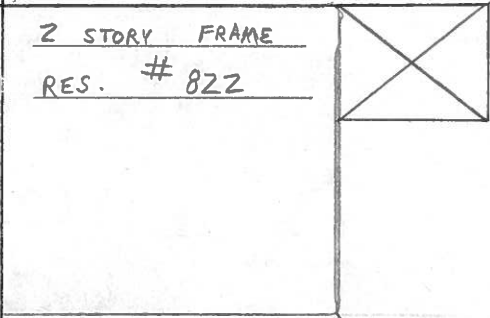

Block Just Below
SIDING.

42.81' RECORD



SET SHI. N/S.

50.25'



SET SHI. E/S 28" BUCKEYE

& PAVT

S.R. #163

County Ottawa S.R. #163

Township Marblehead

Section —


T N, R E

Personnel Cronin
Ripple
Geyman
Barbour

Date 12/14/83

Weather overcast


Temp. 41°

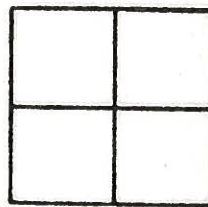

149




Plan
P.I. Δ = 36°00' Lt.
614 + 33.50
Fd. P.K. in stone
headwall - 9' Rt. - Rt. E.P.

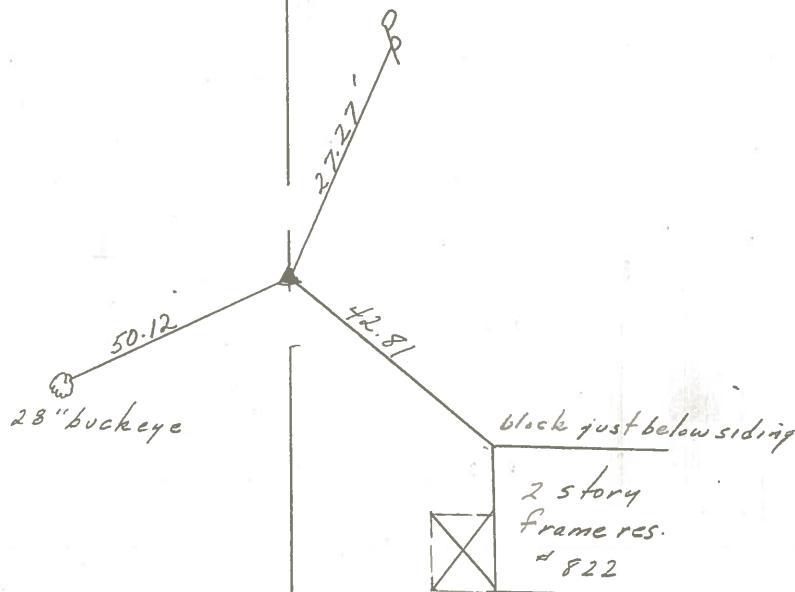


S.R. #163

PERSONNEL	TITLE	PERSONNEL	TITLE
COUNTY <u>Ottawa</u> DATE <u>6-15-71</u>			
S. R. <u>163</u> WEATHER _____			
SEC. <u>1</u> TEMP. _____			
DESCRIPTION <u>Marble head</u>			JOB NO. _____
	LEFT	CENTER LINE	RIGHT

P.I. **149**
 614 + 33.50
 P.K. Nail
 on Howl.

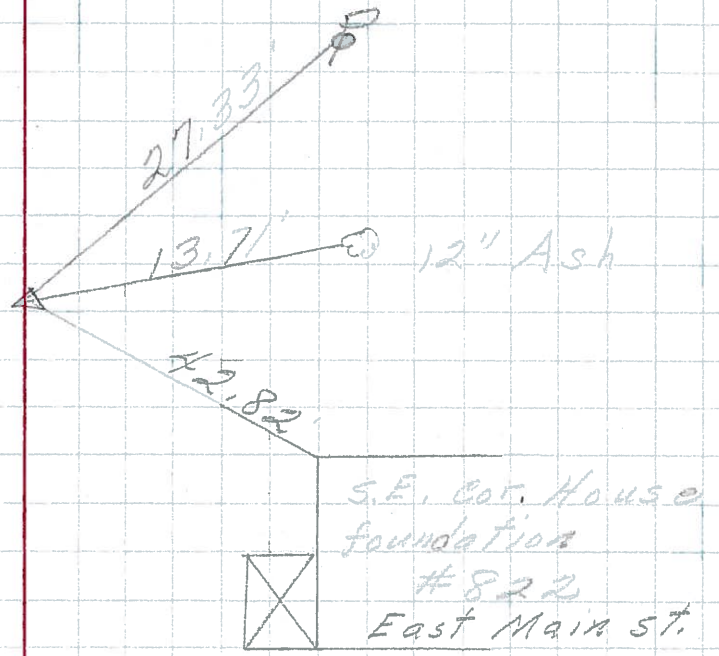

P.I. **148B**
 609 + 38.22
 P.K. Nail

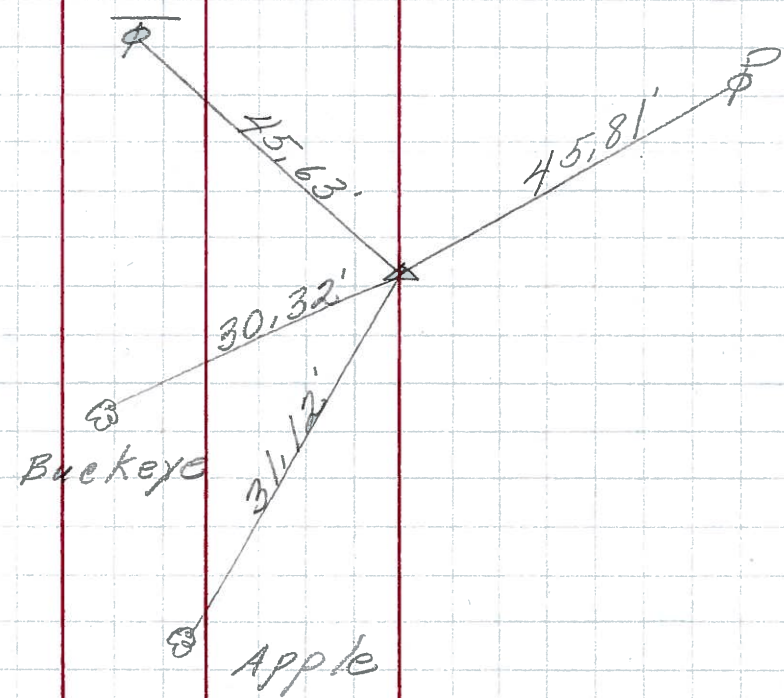

PERSONNEL	TITLE	PERSONNEL	TITLE	COUNTY	DATE
<u>Schneider</u>				<u>Ottawa</u>	<u>9-13-68</u>
<u>Barbour</u>				S. R.	WEATHER
<u>Redding</u>				<u>163</u>	<u>Fair</u>
<u>Polts J</u>				SEC.	TEMP.
					<u>60°</u>

DESCRIPTION Ties for Control Points JOB NO. _____

LEFT	CENTER LINE	RIGHT
P.I. 623+8706 R.R. spt. - down 1/2" steel wire 6407	18" Hackberry 24.60 21.90 77.03 Conc. drive	39.22'
P.I. 620+51.12 P.K. Nail on surface 6406	18.80 66.70 24" Twin Ash	33.98 A Face of Fire Hyd. 34.15'
P.I. P.K. Nail on Hdwt 6405	27.33 13.71 42.84'	12" Ash S.E. Cor. to House # 822 East Main St
P.I. 608+ P.K. Nail on top 6404	10" Buckeye 11" Apple Light House View sign 44.62 30.41 31.12'	45.81'
P.I. 604+ 95.56 P.K. Nail on Top 6403	2-28" Cotton wood 52.65 38.26 51.86	56.41'