


**O.D.O.T. DISTRICT 2 SURVEY OFFICE (USE ONLY)**

PERSONNEL \_\_\_\_\_ REFERENCE NO. 151 SHEET 60 OF 66  
 NOTES MOSER DATE 5/4/11 ROUTE SR 163  
 H.C. MOSER WEATHER CLOUDY COUNTY OTTAWA  
 R.C. HARBAUGH TEMP. 60° TOWNSHIP DANBURY  
 \_\_\_\_\_ SECTION 1-2  
 \_\_\_\_\_

TYPE MONUMENT SET P.K. IN STONE/DIRT  
 ON SURFACE - ~~BELOW~~ ON  
 LEFT - Q PAV'T - ~~RIGHT~~ 51.8'  
41.1' LT TO LT EDGE PAVEMENT  
 S.L.M. 2032+00  
 GRID: NORTHING: 677753.3945 EASTING: 1910265.5768


NOTE: THIS MAP IS FOR ODOT PURPOSES ONLY TO INDEX REFERENCE TIES, AND DOES NOT REPRESENT TRUE LAND SUBDIVISION.

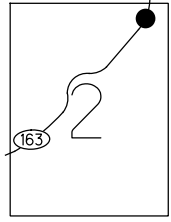

NOTE: P.I. ESTABLISHED BY INTERSECTING FORWARD AND REAR TANGENTS. NO SET MONUMENTATION, 1995  
 STA: 2028+40.25

SET POINT WITH 2 RECORD DISTANCE. GPS, SV151 5/4/10, KPM

PARK


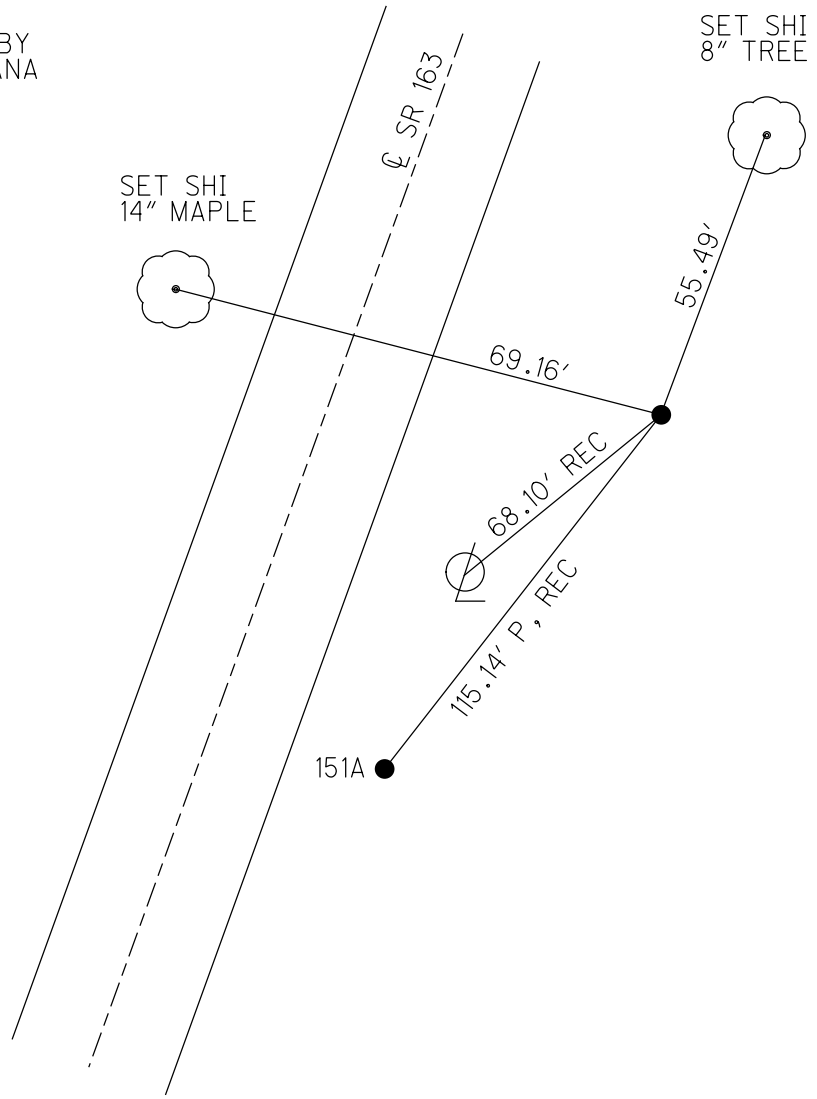


O.D.O.T. DISTRICT 2 SURVEY OFFICE (USE ONLY)

PERSONNEL	REFERENCE NO. <u>151</u>	SHEET <u>57</u> OF <u>63</u>
NOTES <u>MOSER</u>	DATE <u>5/4/11</u>	ROUTE <u>SR 163</u>
H.C. <u>MOSER</u>	WEATHER <u>CLOUDY</u>	COUNTY <u>OTTAWA</u>
R.C. <u>HARBAUGH</u>	TEMP. <u>60°</u>	TOWNSHIP <u>DANBURY</u>
		SECTION <u>1-2</u>

TYPE MONUMENT SET P.K. IN STONE/DIRT  
 ON SURFACE - ~~BELOW~~ ON  
 LEFT - Q PAV'T - ~~RIGHT~~ 51.8'  
41.1' LT TO LT EDGE PAVEMENT  
 S.L.M. 2032+00


Grid: Northing: 677753.3945 Easting: 1910265.5768

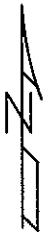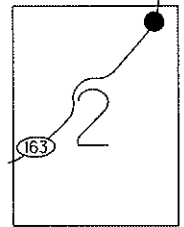

NOTE: P.I. ESTABLISHED BY  
 INTERSECTING FORWARD ANA  
 REAR TANGENTS. NO SET  
 MONUMENTATION. 1995  
 STA: 2028+40.25

SET POINT WITH  
 2 RECORD DISTANCE.  
 GPS, SV151  
 5/4/10, KPM

PARK

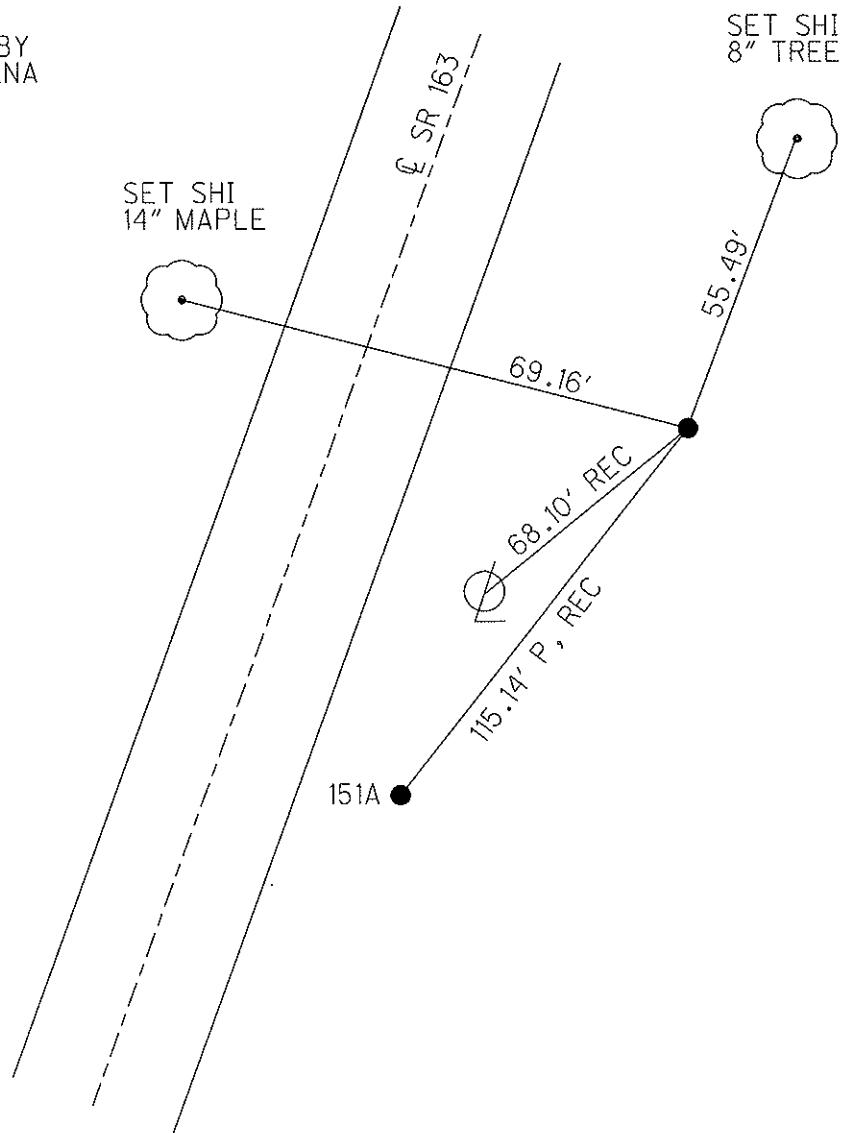

# O.D.O.T. DISTRICT 2 SURVEY OFFICE

PERSONNEL

REFERENCE NO. 151

SHEET 49A OF 52

NOTES LOEHARKE

H.C. VAN DUSEN

DATE 6-15-95

ROUTE S.R. 163

R.C. ROUSSOS

WEATHER FAIR

COUNTY OTTAWA

HUSS

TEMP. +80

TOWNSHIP MARBLE HEAD

SECTION \_\_\_\_\_

T \_\_\_\_\_ R \_\_\_\_\_

TYPE MONUMENT None Set


NOT COVERED

ON SURFACE - BELOW \_\_\_\_\_


LEFT- & PAVT. - RIGHT 51.6 Lt

41.0 TO Lt EDGE PAVEMENT

S.L.M. 2032+00

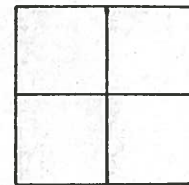

NOTE: P.I. Established by  
Intersecting Forward & Rear TANGENTS  
No Monumentation Set

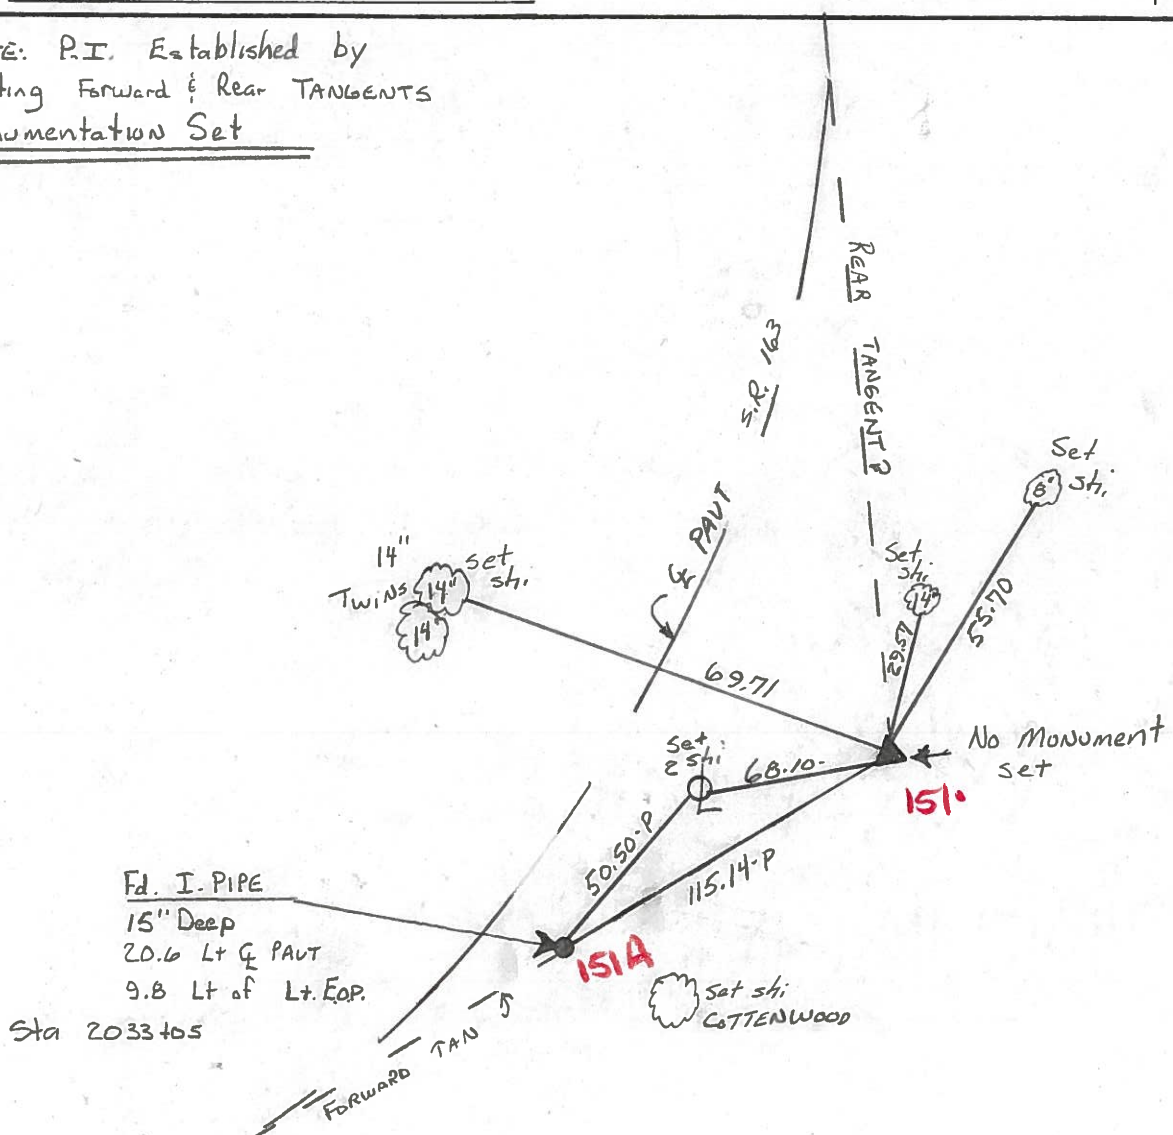

O.D.O.T. DISTRICT 2 SURVEY OFFICE

PERSONNEL \_\_\_\_\_

REFERENCE NO. 151

SHEET \_\_\_\_\_ OF \_\_\_\_\_

NOTES Ripple

H.C. BARBOUR

DATE 11/01/90 DRAWN 11/07/90

ROUTE SR# 163

R.C. Geyman

WEATHER SUNNY

COUNTY OTTAWA

TEMP. 65°

TOWNSHIP \_\_\_\_\_

SECTION \_\_\_\_\_

T \_\_\_\_\_ R \_\_\_\_\_


TYPE MONUMENT \_\_\_\_\_

ON SURFACE - BELOW Found 1" Iron Pipe 13" down

LEFT - ¢ PAV'T. - RIGHT 20.8' LT. of Pavm't.

9' FROM TO LT. EDGE PAVEMENT

S.L.M. \_\_\_\_\_

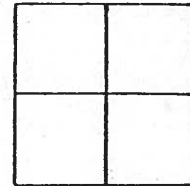

151

