


O.D.O.T. DISTRICT 2 SURVEY OFFICE (USE ONLY)


PERSONNEL _____ REFERENCE NO. 151 A SHEET 61 OF 66
 NOTES MOSE DATE 5/4/11 ROUTE SR 163
 H.C. MOSE WEATHER CLOUDY COUNTY OTTAWA
 R.C. HARBAUGH TEMP. 60° TOWNSHIP DANBURY
 _____ SECTION 1-2

TYPE MONUMENT 1" IPIPE
~~ON SURFACE~~ - BELOW 15"
 LEFT - CL PAV'T - ~~RIGHT~~ 21.2'
10.6' LT TO LT EDGE PAVEMENT
 S.L.M. 2033+15.14
 GRID: NORTHING: 677659.2026 EASTING: 1910199.6191

NOTE:
THIS MAP IS FOR ODOT PURPOSES ONLY.
TO INDEX REFERENCE TIES, AND DOES NOT
REPRESENT TRUE LAND SUBDIVISION.

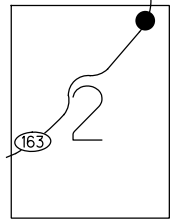

FD IPIPE
 GPS, SV150
 5/4/10, KPM

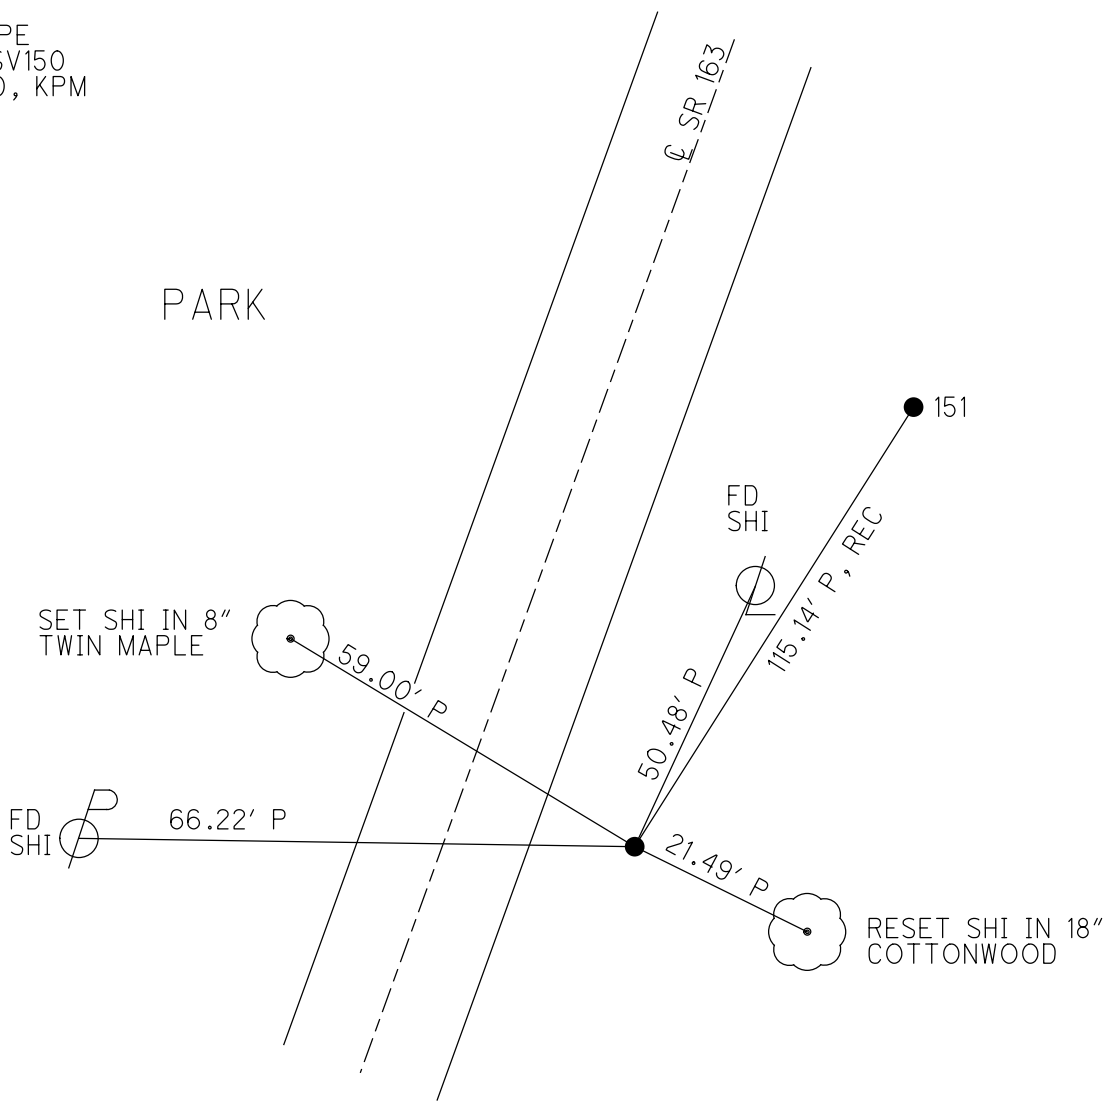

O.D.O.T. DISTRICT 2 SURVEY OFFICE (USE ONLY)

PERSONNEL

REFERENCE NO. 151 A

SHEET 58 OF 63

NOTES MOSER

DATE 5/4/11

ROUTE SR 163

H.C. MOSER

WEATHER CLOUDY

COUNTY OTTAWA

R.C. HARBAUGH

TEMP. 60°

TOWNSHIP DANBURY

SECTION 1-2

TYPE MONUMENT 1" IPIPE


~~ON SURFACE~~ - BELOW 15"

LEFT - ℄ PAV'T - ~~RIGHT~~ 21.2'

10.6' LT TO LT EDGE PAVEMENT


S.L.M. 2033+15.14

Grid: Northing: 677659.2026 Easting: 1910199.6191

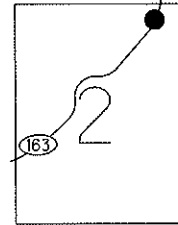

FD IPIPE
GPS, SV150
5/4/10, KPM

PARK

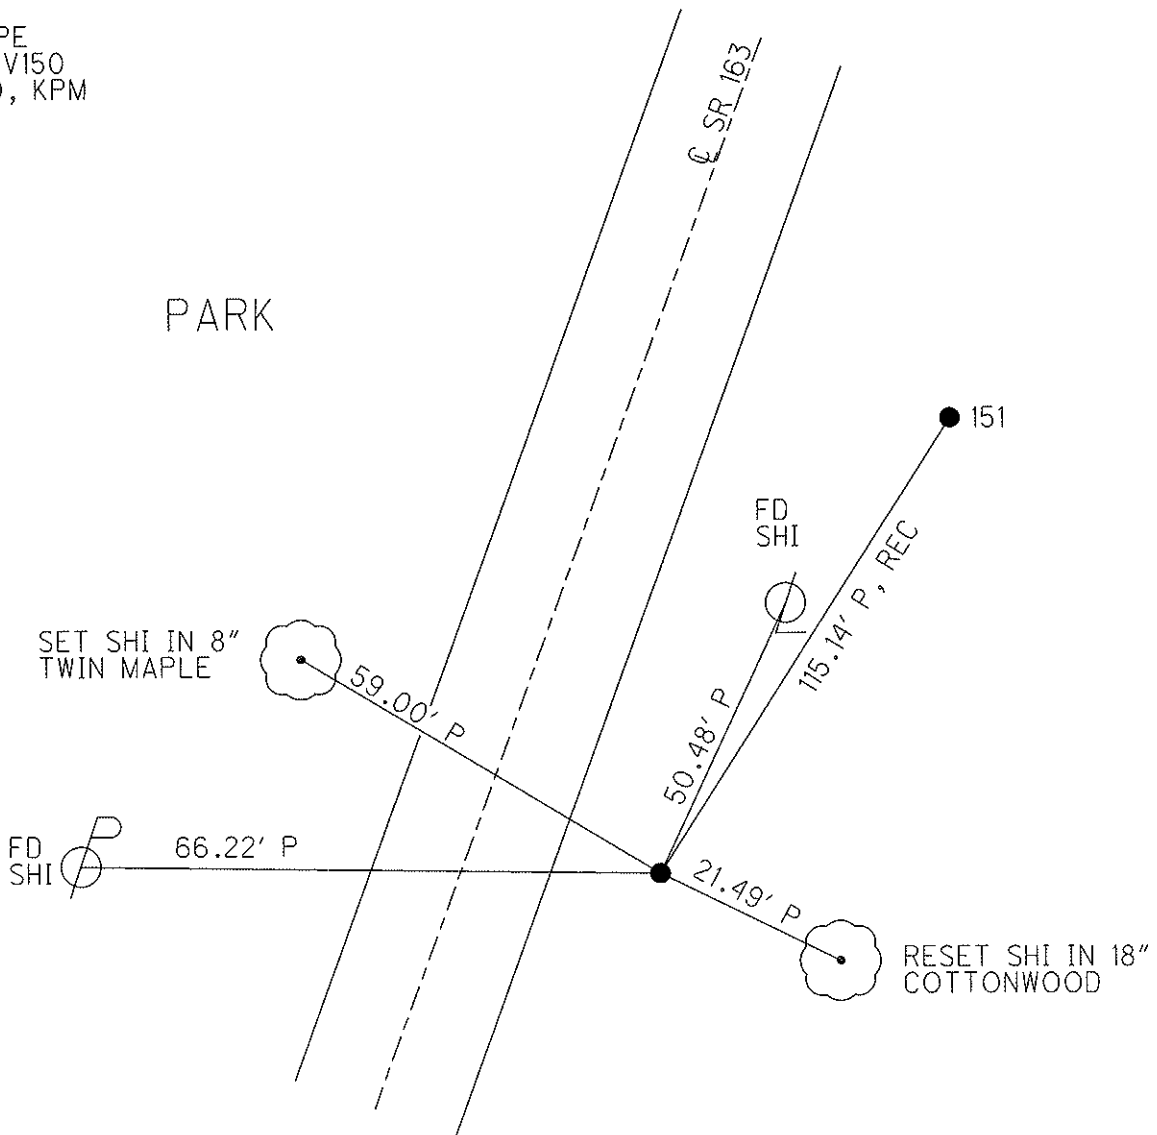

O.D.O.T. DISTRICT 2 SURVEY OFFICE

PERSONNEL

REFERENCE NO. 151

SHEET 49A OF 52

NOTES LOEHRKE

H.C. VAN DUSEN

DATE 6-15-95

ROUTE S.R. 163

R.C. Rousos

WEATHER FAIR

COUNTY OTTAWA

Huss

TEMP. +80

TOWNSHIP MARBLE HEAD

SECTION _____

T _____ R _____

TYPE MONUMENT NONE Set


NOT COVERED

ON SURFACE - BELOW _____

LEFT- & PAVT. - RIGHT 51.6 Lt

41.6 TO Lt EDGE PAVEMENT

S.L.M. 2032+00

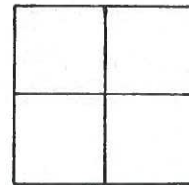

NOTE: P.I. Established by
Intersecting Forward & Rear TANGENTS
No Monumentation Set

