


O.D.O.T. DISTRICT 2 SURVEY OFFICE (USE ONLY)

PERSONNEL	REFERENCE NO.	<u>153</u>	SHEET	<u>63</u>	OF	<u>66</u>
NOTES	<u>CANTERBURY</u>	DATE	<u>6/5/95</u>	ROUTE	<u>SR 163</u>	
H.C.	<u>LOEHRKE</u>	WEATHER	<u>FAIR</u>	COUNTY	<u>OTTAWA</u>	
R.C.	<u>ROUSOS</u>	TEMP.	<u>75°</u>	TOWNSHIP	<u>DANBURY</u>	
				SECTION	<u>1-2</u>	


NOTE:  
THIS MAP IS FOR ODOT PURPOSES ONLY.  
TO INDEX REFERENCE TIES, AND DOES NOT  
REPRESENT TRUE LAND SUBDIVISION.

TYPE MONUMENT 1" IPIN  
~~ON SURFACE~~ - BELOW 2"  
 LEFT - CL PAV'T - ~~RIGHT~~ 45'  
34.7' LT TO LT EDGE PAVEMENT  
 S.L.M. 2049+62  
 GRID: NORTHING: 676462.4495    EASTING: 1909059.4456

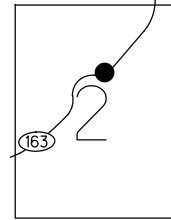

NOTE: POINT IS APPROX.  
90' WEST OF DRIVEWAY.

FD IPIN  
GPS, SV153  
5/4/10, KPM

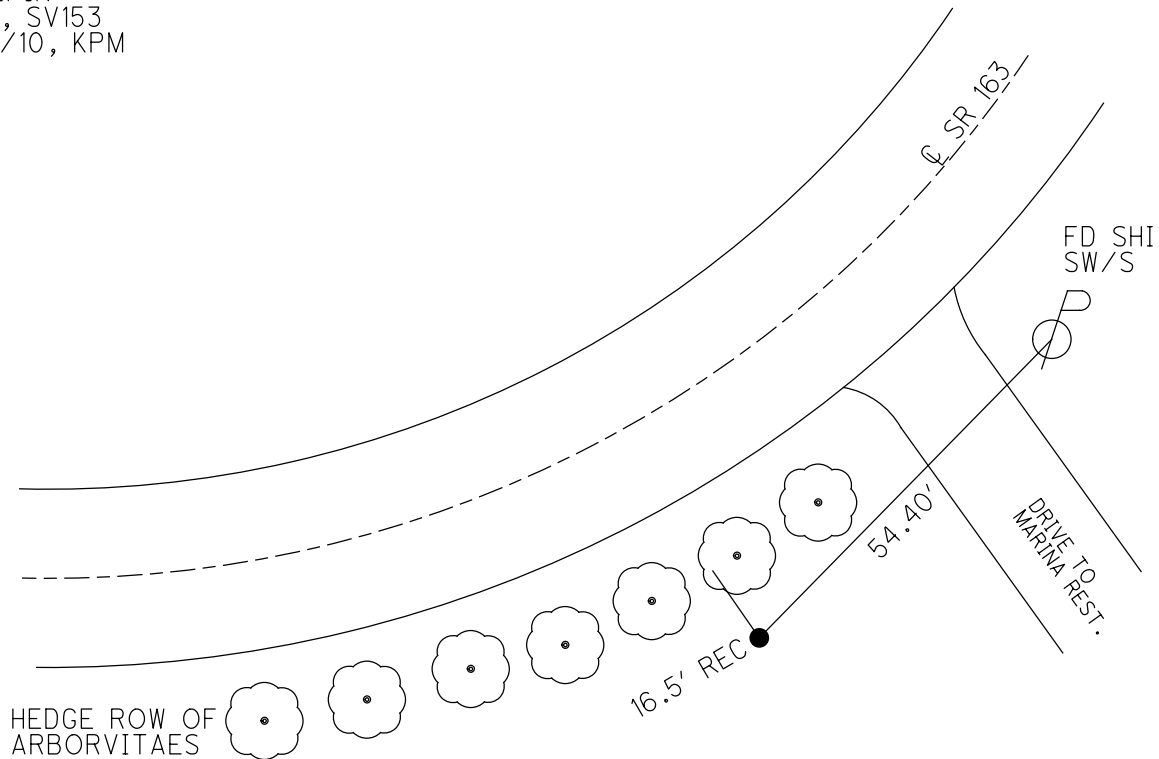

O.D.O.T. DISTRICT 2 SURVEY OFFICE (USE ONLY)

PERSONNEL \_\_\_\_\_

REFERENCE NO. 153

SHEET 60 OF 63

NOTES CANTERBURY

DATE 6/5/95

ROUTE SR 163

H.C. LOEHRKE

WEATHER FAIR

COUNTY OTTAWA

R.C. ROUSOS

TEMP. 75°

TOWNSHIP DANBURY

SECTION 1-2

TYPE MONUMENT 1" IPIN


~~ON SURFACE~~ - BELOW 2"

LEFT - Q PAV'T - ~~RIGHT~~ 45'

34.7' LT TO LT EDGE PAVEMENT


S.L.M. 2049+62

Grid: Northing: 676462.4495 Easting: 1909059.4456

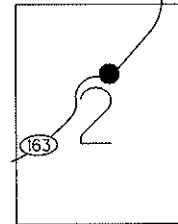

NOTE: POINT IS APPROX.  
90' WEST OF DRIVEWAY.

FD IPIN  
GPS, SV153  
5/4/10, KPM

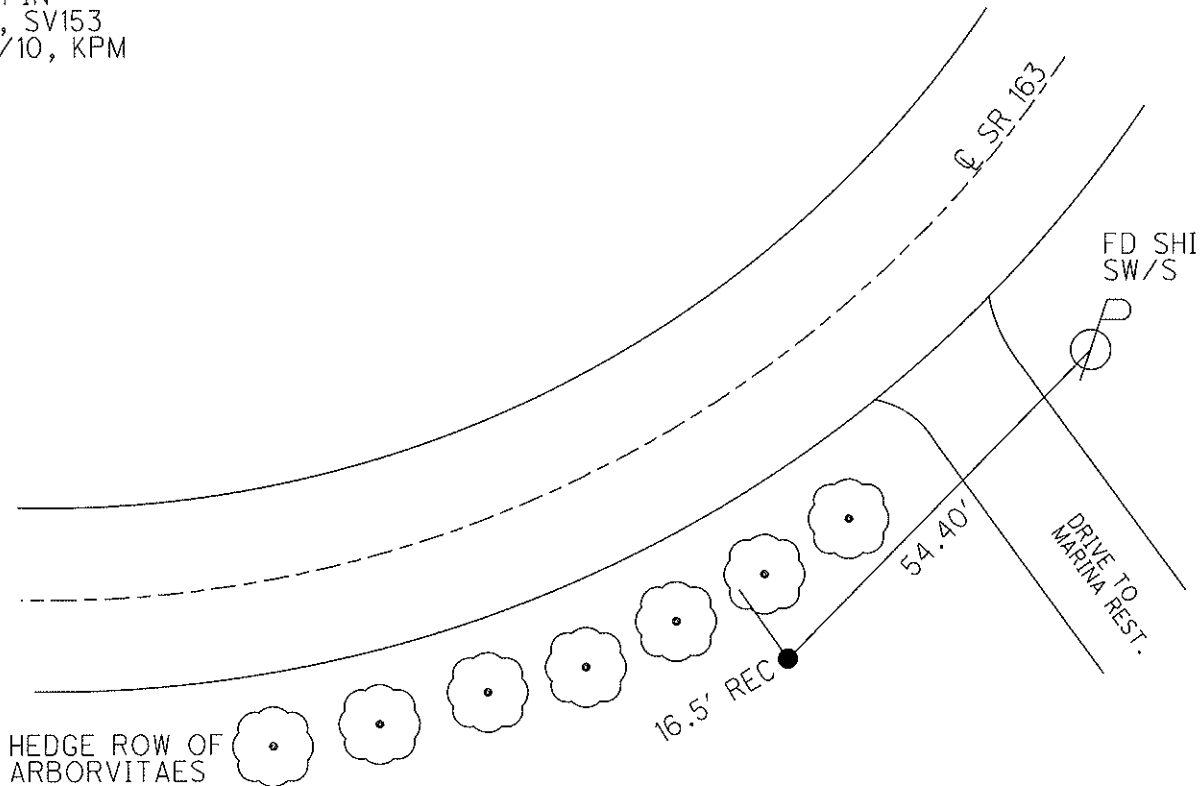

# O.D.O.T. DISTRICT 2 SURVEY OFFICE

PERSONNEL \_\_\_\_\_

REFERENCE NO. 153

SHEET 51 OF 52

NOTES CANTERBURY

H.C. LOEHRKE

R.C. ROUSOS

DATE 6-5-95

WEATHER FAIR

TEMP. +75° F

ROUTE S.R. #163

COUNTY OTTAWA

TOWNSHIP MARBLEHEAD

SECTION \_\_\_\_\_

T \_\_\_\_\_ R \_\_\_\_\_

TYPE MONUMENT 1" IRON ROD


ON SURFACE - BELOW 2" BELOW

LEFT-~~☉~~ PAV'T. - RIGHT 45' LT ☉


<sup>FROM</sup> 34.7' TO LT EDGE PAVEMENT

S.L.M. 2049 + 62

NOT COVERED  
6/10/96  
M.R.C.

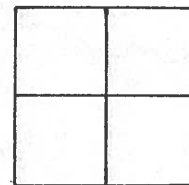

NOTE: POINT IS ± 90' WEST OF DRIVE TO THE MARINA RESTAURANT,

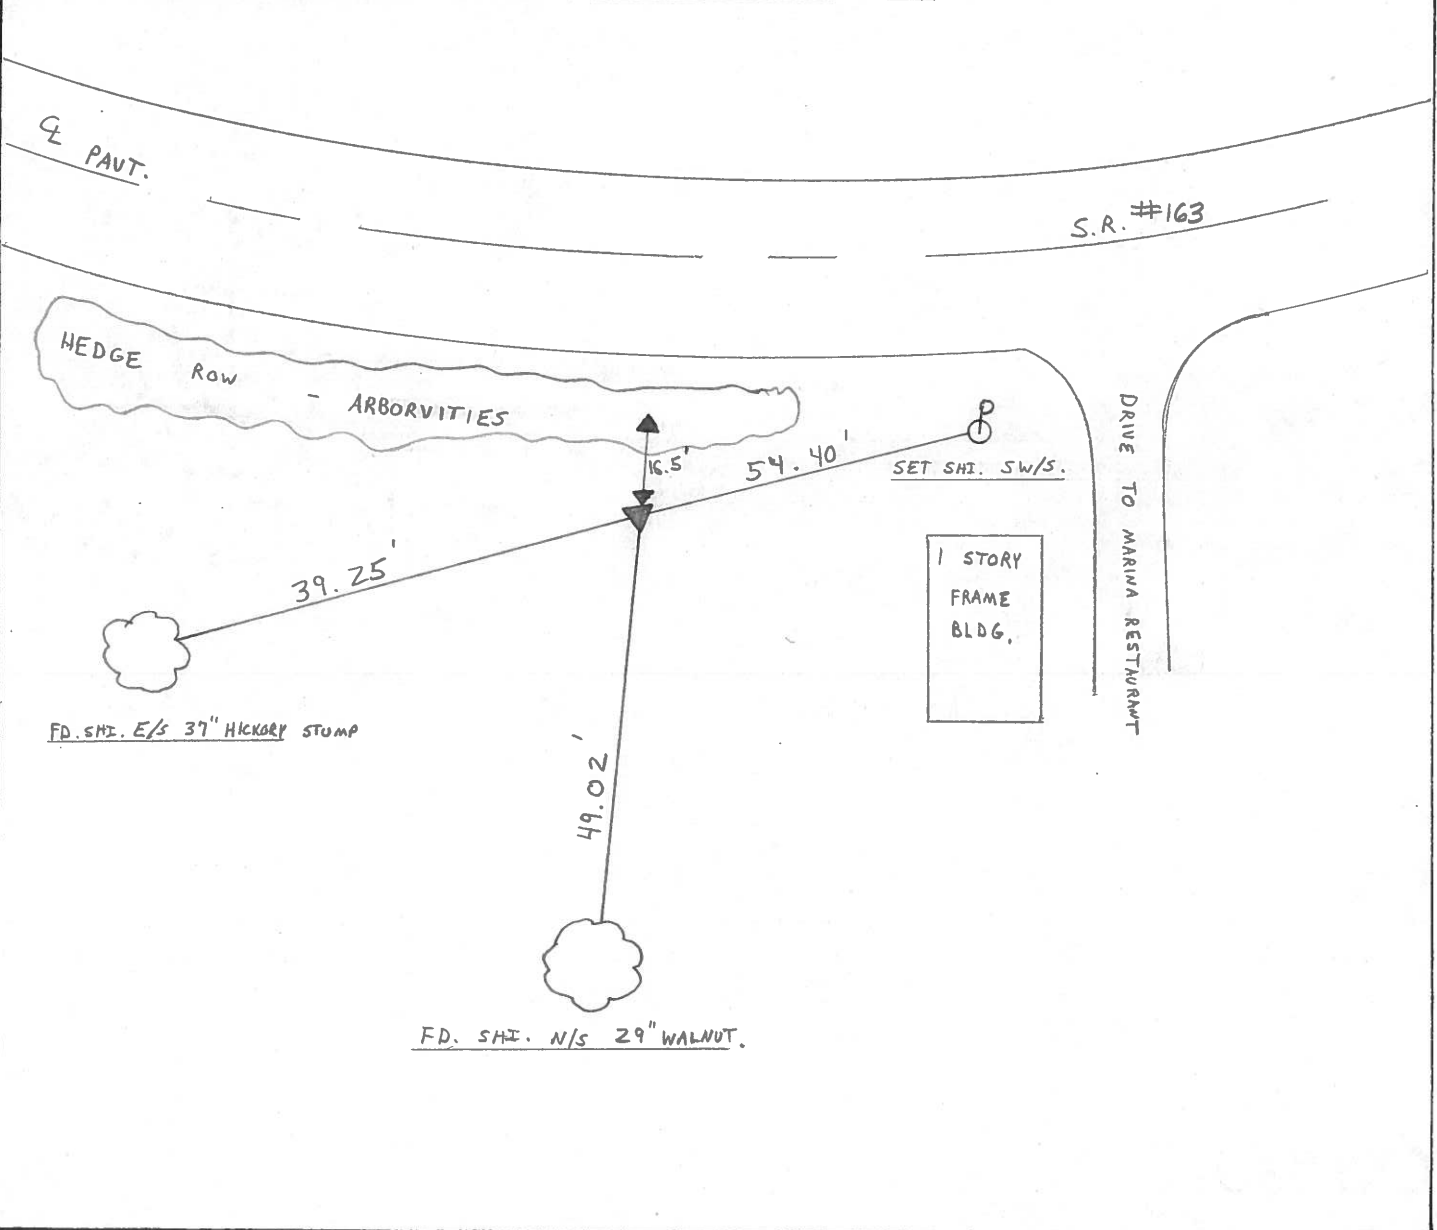

O.D.O.T. DISTRICT 2 SURVEY OFFICE

PERSONNEL

REFERENCE NO. 153

SHEET \_\_\_\_\_ OF \_\_\_\_\_

NOTES Ripple

H.C. BARBOUR

DATE 10/31/90 DRAWN 11/7/90

ROUTE SR#163

R.C. Geyman

WEATHER Sunny

COUNTY OTTAWA

TEMP. 72°

TOWNSHIP \_\_\_\_\_

SECTION \_\_\_\_\_

T \_\_\_\_\_ R \_\_\_\_\_

TYPE MONUMENT 1" IRON Rod 2" below surface

ON SURFACE - BELOW \_\_\_\_\_

LEFT - ¢ PAV'T. - RIGHT 45' LT. & Pavm't.

34.7' <sup>FROM</sup> LT. EDGE PAVEMENT

S.L.M. \_\_\_\_\_

