
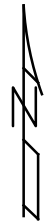



O.D.O.T. DISTRICT 2 SURVEY OFFICE (USE ONLY)

PERSONNEL \_\_\_\_\_ REFERENCE NO. 155 SHEET 1 OF 25  
 NOTES RHOADES DATE 9/18/18 ROUTE SR 163  
 H.C. O'DONNELL WEATHER SUNNY COUNTY OTTAWA  
 R.C. MILLER TEMP. 80° TOWNSHIP DANBURY  
 DWG BY NIESE PID PVTRAIN SECTION 6  
 T 6 N R 18 E

TYPE MONUMENT P.K./WASHER  
 ON SURFACE - ~~BELOW~~ ON  
 OFFSET Q PAVEMENT 8.5' LT : ~~RT~~  
2.0' TO LT EDGE PAVEMENT  
 STATION: 2101+93  
 HORZ.DATUM: NAD83 2011 GEOID: NAVD88 2012A  
 GRID: NORTHING: 673414.096 EASTING: 1905349.783

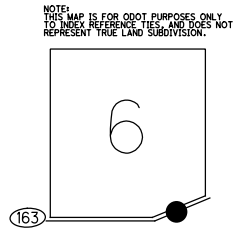

RECORD:  
 FD P.K.NAIL  
 8/14/00, BVD  
 SET P.K./WASHER  
 4/3/01, BVD  
 FD P.K./WASHER  
 REF155  
 9/18/18, JFO  
 2/8/19, JFO  
 2/7/22, JFO


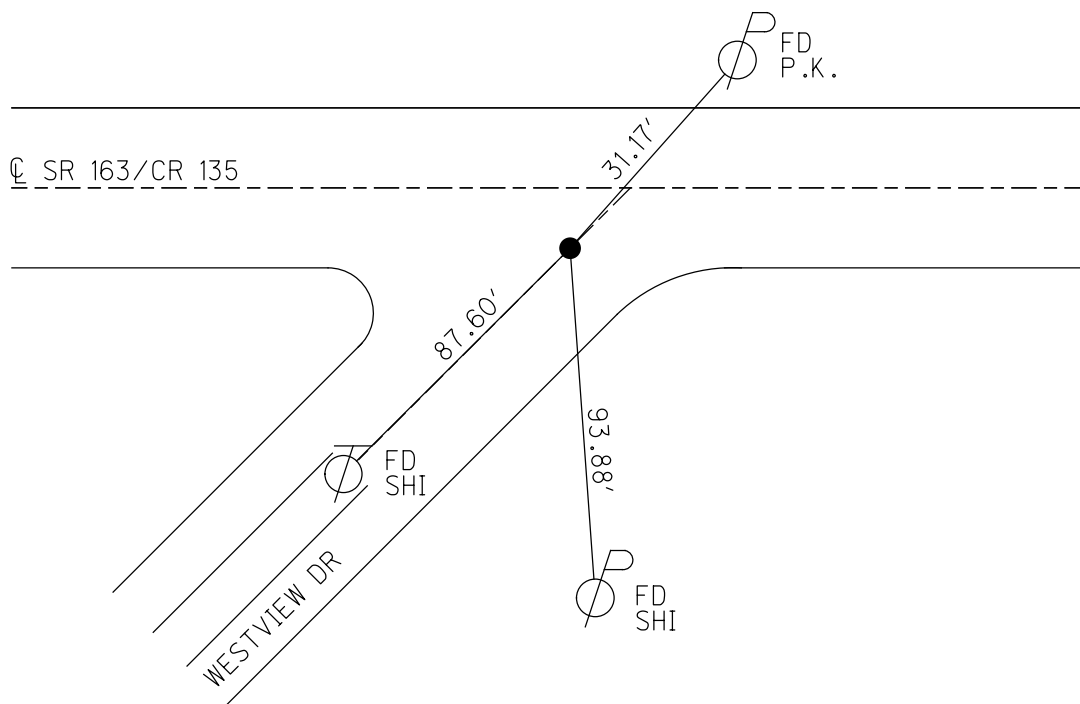


O.D.O.T. DISTRICT 2 SURVEY OFFICE (USE ONLY)

PERSONNEL \_\_\_\_\_ REFERENCE NO. 155 SHEET 1 OF 25  
 NOTES RHOADES DATE 9/18/18 ROUTE SR 163  
 H.C. O'DONNELL WEATHER SUNNY COUNTY OTTAWA  
 R.C. MILLER TEMP. 80° TOWNSHIP DANBURY  
 DWG BY MILLER PID NO PID SECTION 6  
 T 6 N R 18 E


TYPE MONUMENT P.K./WASHER  
 ON SURFACE - ~~BELOW~~ ON  
 OFFSET Q PAVEMENT 8.5' LT : ~~RT~~  
2.0' TO LT EDGE PAVEMENT  
 STATION: 2080+00

NOTE:  
THIS MAP IS FOR ODOT PURPOSES ONLY.  
TO INDEX REFERENCE TIES, AND DOES NOT  
REPRESENT TRUE LAND SUBDIVISION.

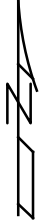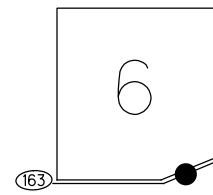

HORIZ.DATUM: NAD83 2011 GEOID: NAVD88 2012A  
 GRID: NORTHING: 673414.096 EASTING: 1905349.783

RECORD:  
 FD P.K.NAIL  
 8/14/00, BVD  
 SET P.K./WASHER  
 4-3-01, BVD  
 FD P.K./WASHER  
 REF155  
 9-18-18  
 2/8/19, JFO

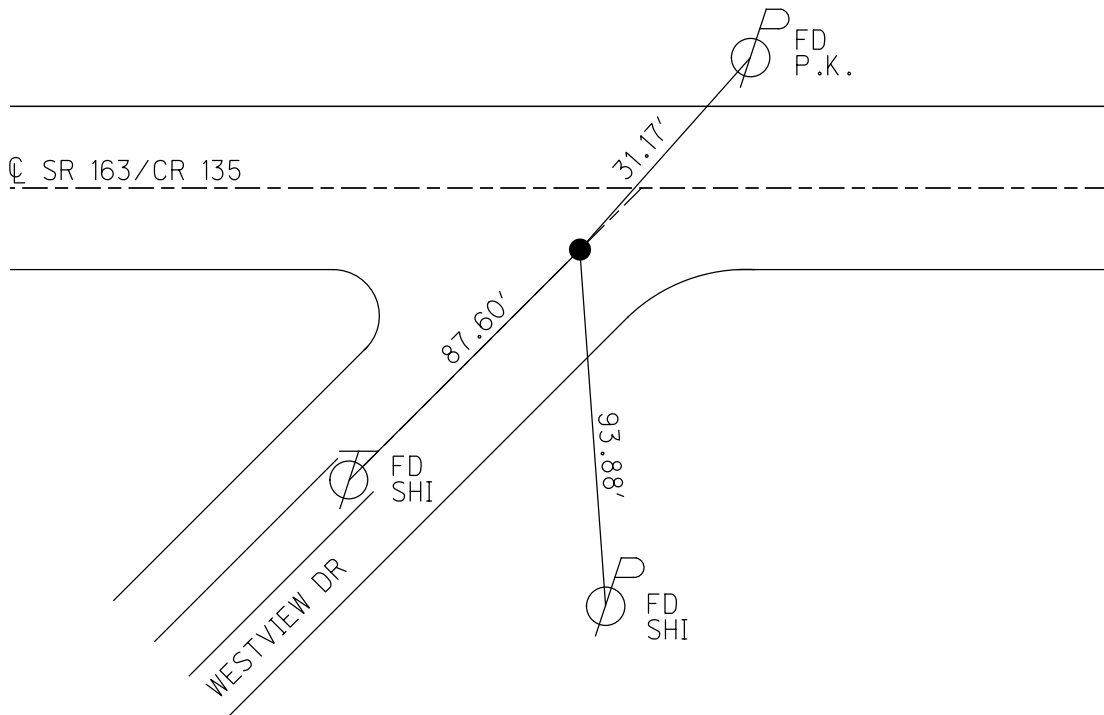

O.D.O.T. DISTRICT 2 SURVEY OFFICE

PERSONNEL

REFERENCE NO. 155 SHEET 1 OF 22

NOTES VAN DUSEN

H.C. ROUSSOS

R.C. ADAM B.

DATE 8-14-00

WEATHER CLOUDY

TEMP. +65°F

ROUTE 163

COUNTY OTTAWA

TOWNSHIP DANBURY

SECTION 1

T. 6 NR 18 E


TYPE MONUMENT P.K. NAIL

ON SURFACE - BELOW YES

LEFT-☉ PAV'T. - RIGHT 8.5

20' TO LT. EDGE PAVEMENT

S.L.M. 2080+00

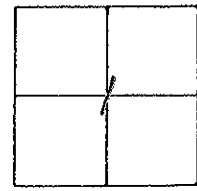

SET PK & WASHER  
4-3-01  
B.V.D.

